



B. N. 130.50 R.R. Spk. S.-Side P.P. on N.E. cor. Taft & Ralstin.

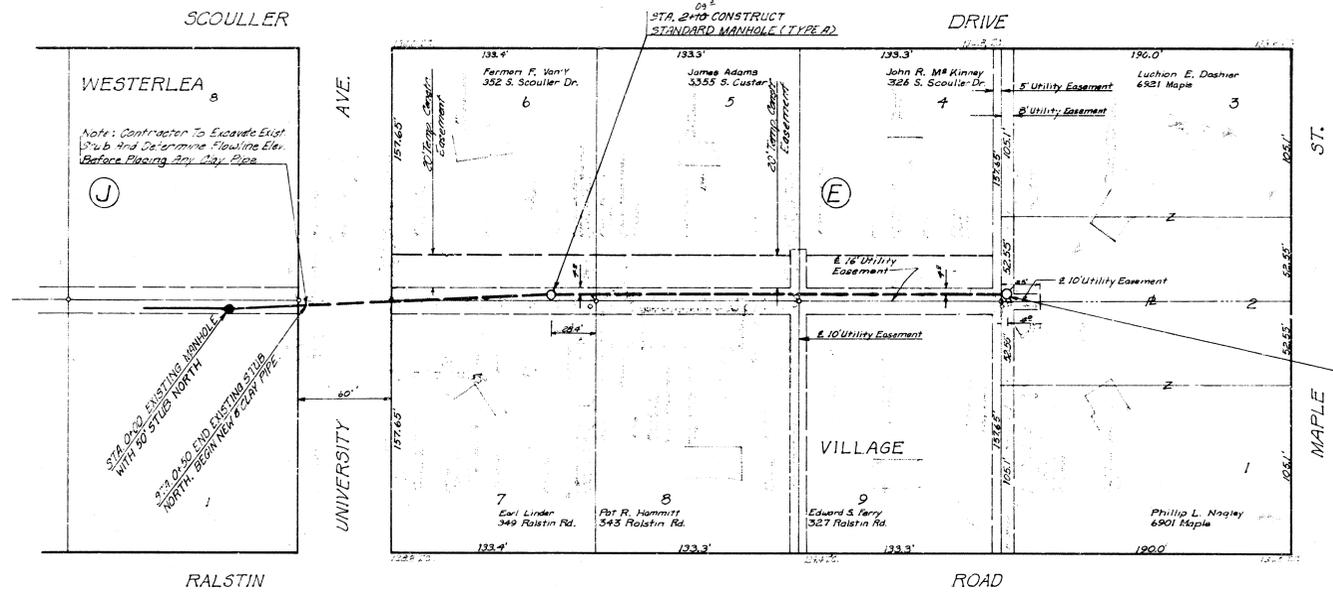

Note: All Property Items That May Be Disturbed Shall Have Tags Taken to Them Where They May Be Replaced If Disturbed

STA 5+09 CONSTRUCT STANDARD MANHOLE (TYPE A). INSTALL STUBS N.E. E.W.

PLAN SCALE: 1"=40'
PROFILE SCALE: 1"=5' VERT.

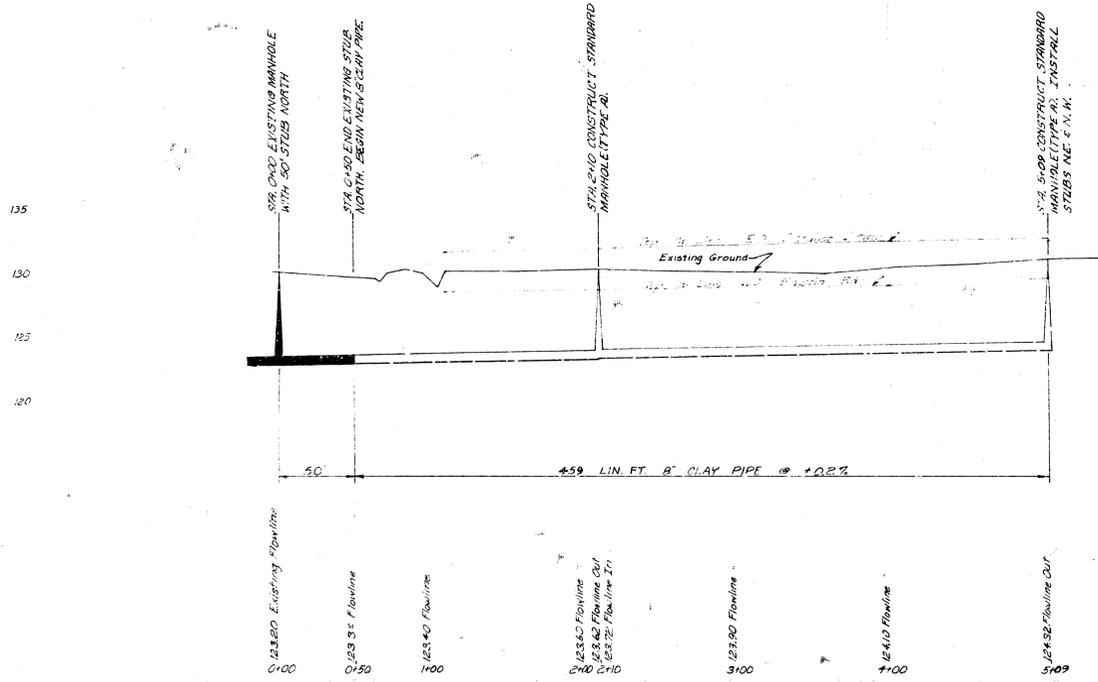

As Built From Measurements 10-10-72
LAT. 5, MAIN 4, S. W. INTERCEPT SEWER
CITY OF WICHITA, KANSAS
R. W. LINN — CITY ENGINEER
 SEPT. 1972 PROJECT NO. DBKL 571028