



PLAN SCALE 1" = 40'
 PROFILE SCALE 1" = 40' HORIZ.
 1" = 5' VERT.

B.M. 141.62 R.R. SNAKE S. SIDE OF P.P. ON N. SIDE MAPLE & WOODHUCK LANE

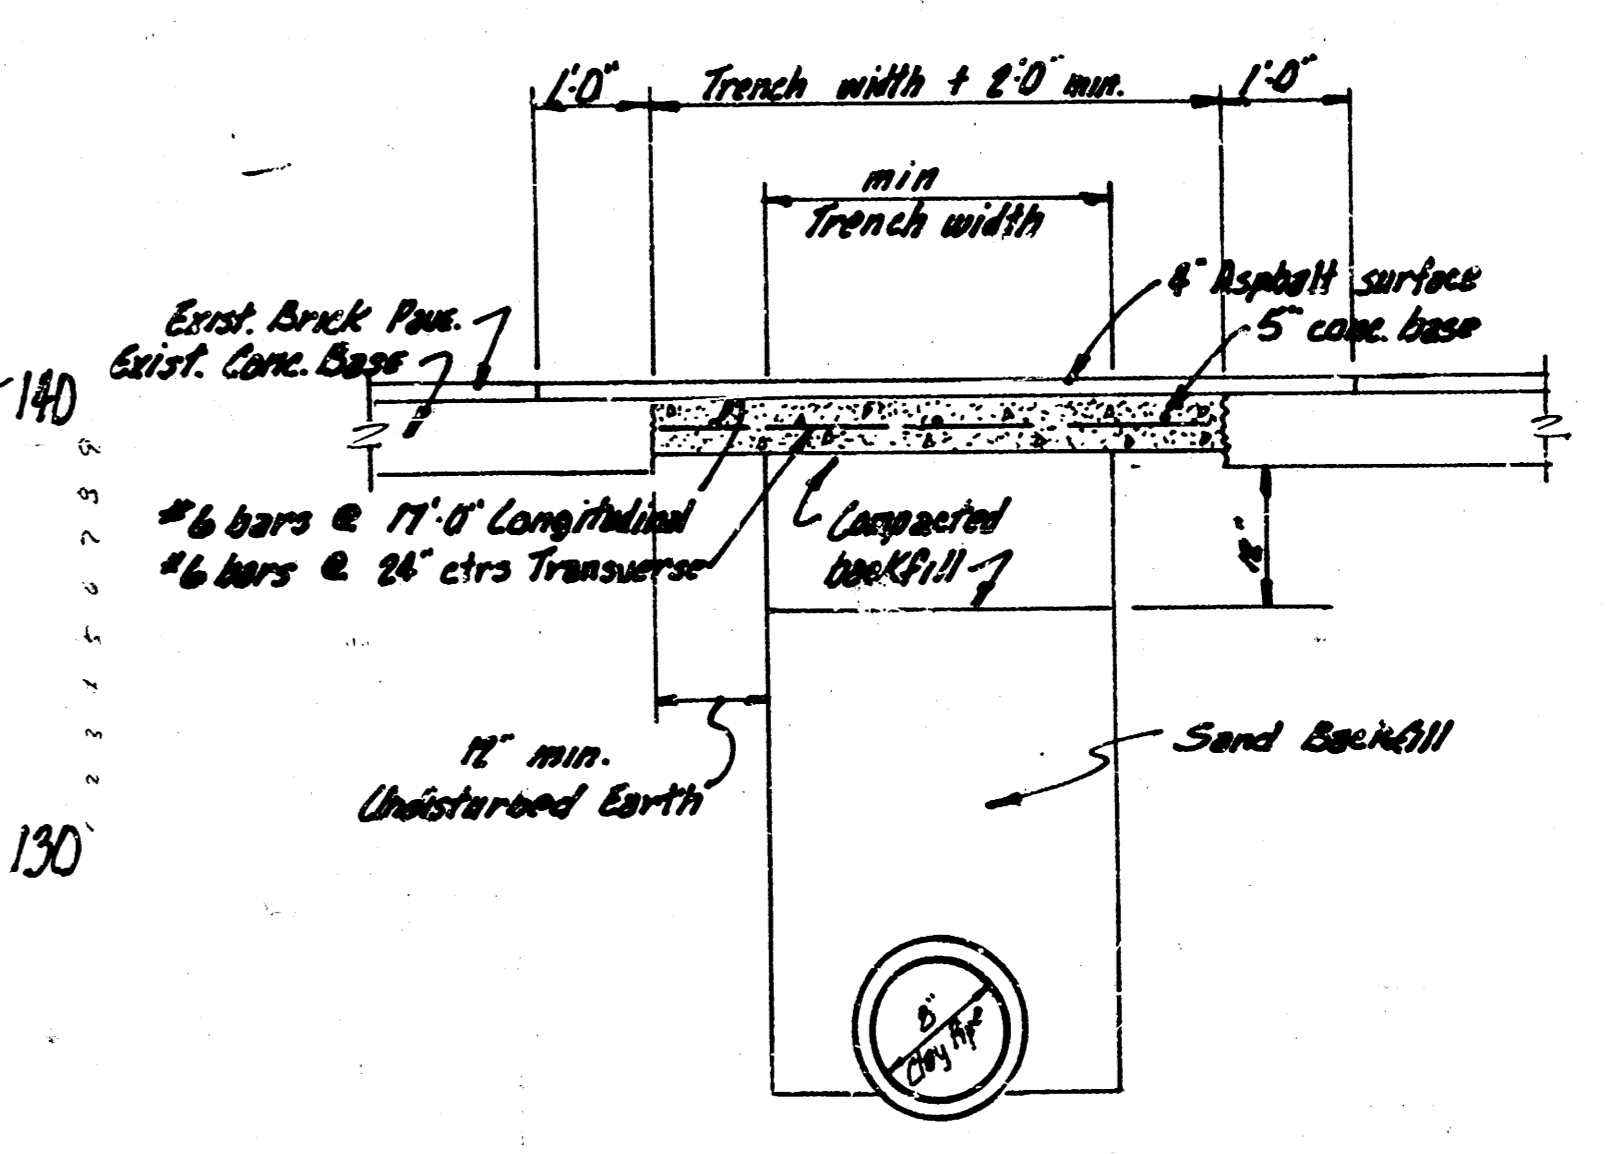

TYPICAL SECTION
 BRICK PAVEMENT STREET CROSSING
 REPAIR ON MAPLE STREET
 & SNAKE

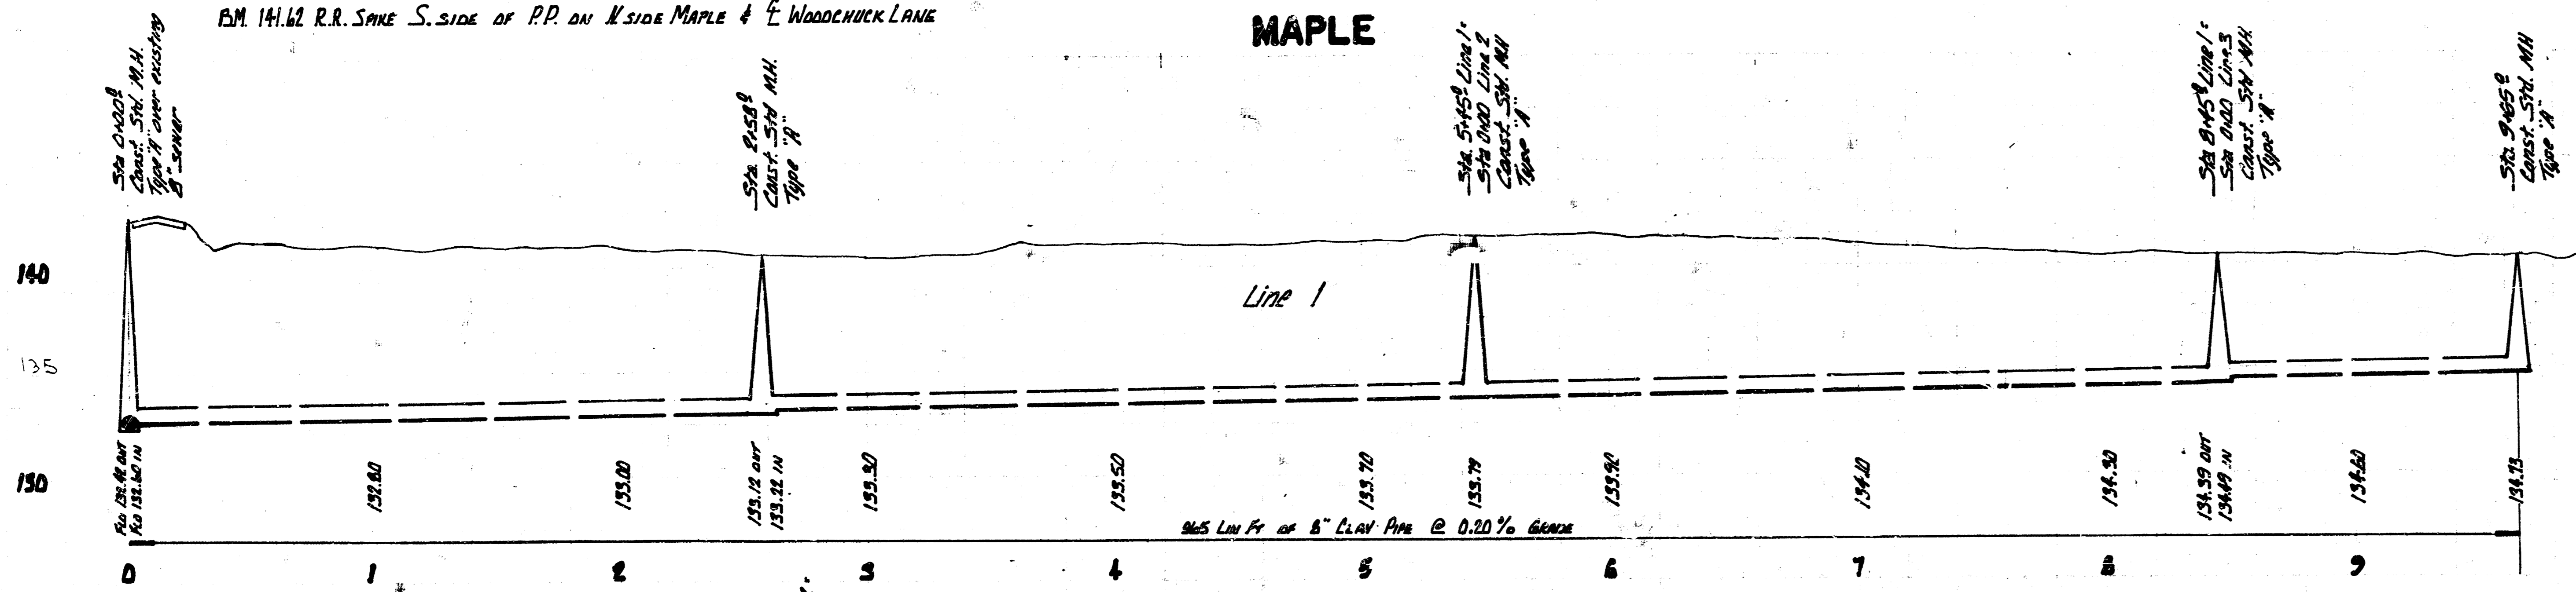

As Built Plan 14 Sept 73 From K-105

LAT. 6, MAIN 4, S.W. INT.
 CITY OF WICHITA, KANSAS
 R. W. LINN, City Engineer
 PROJECT NO. DBKL571036
 Date: July 1973

FILMED FROM THE BEST AVAILABLE COPY....