

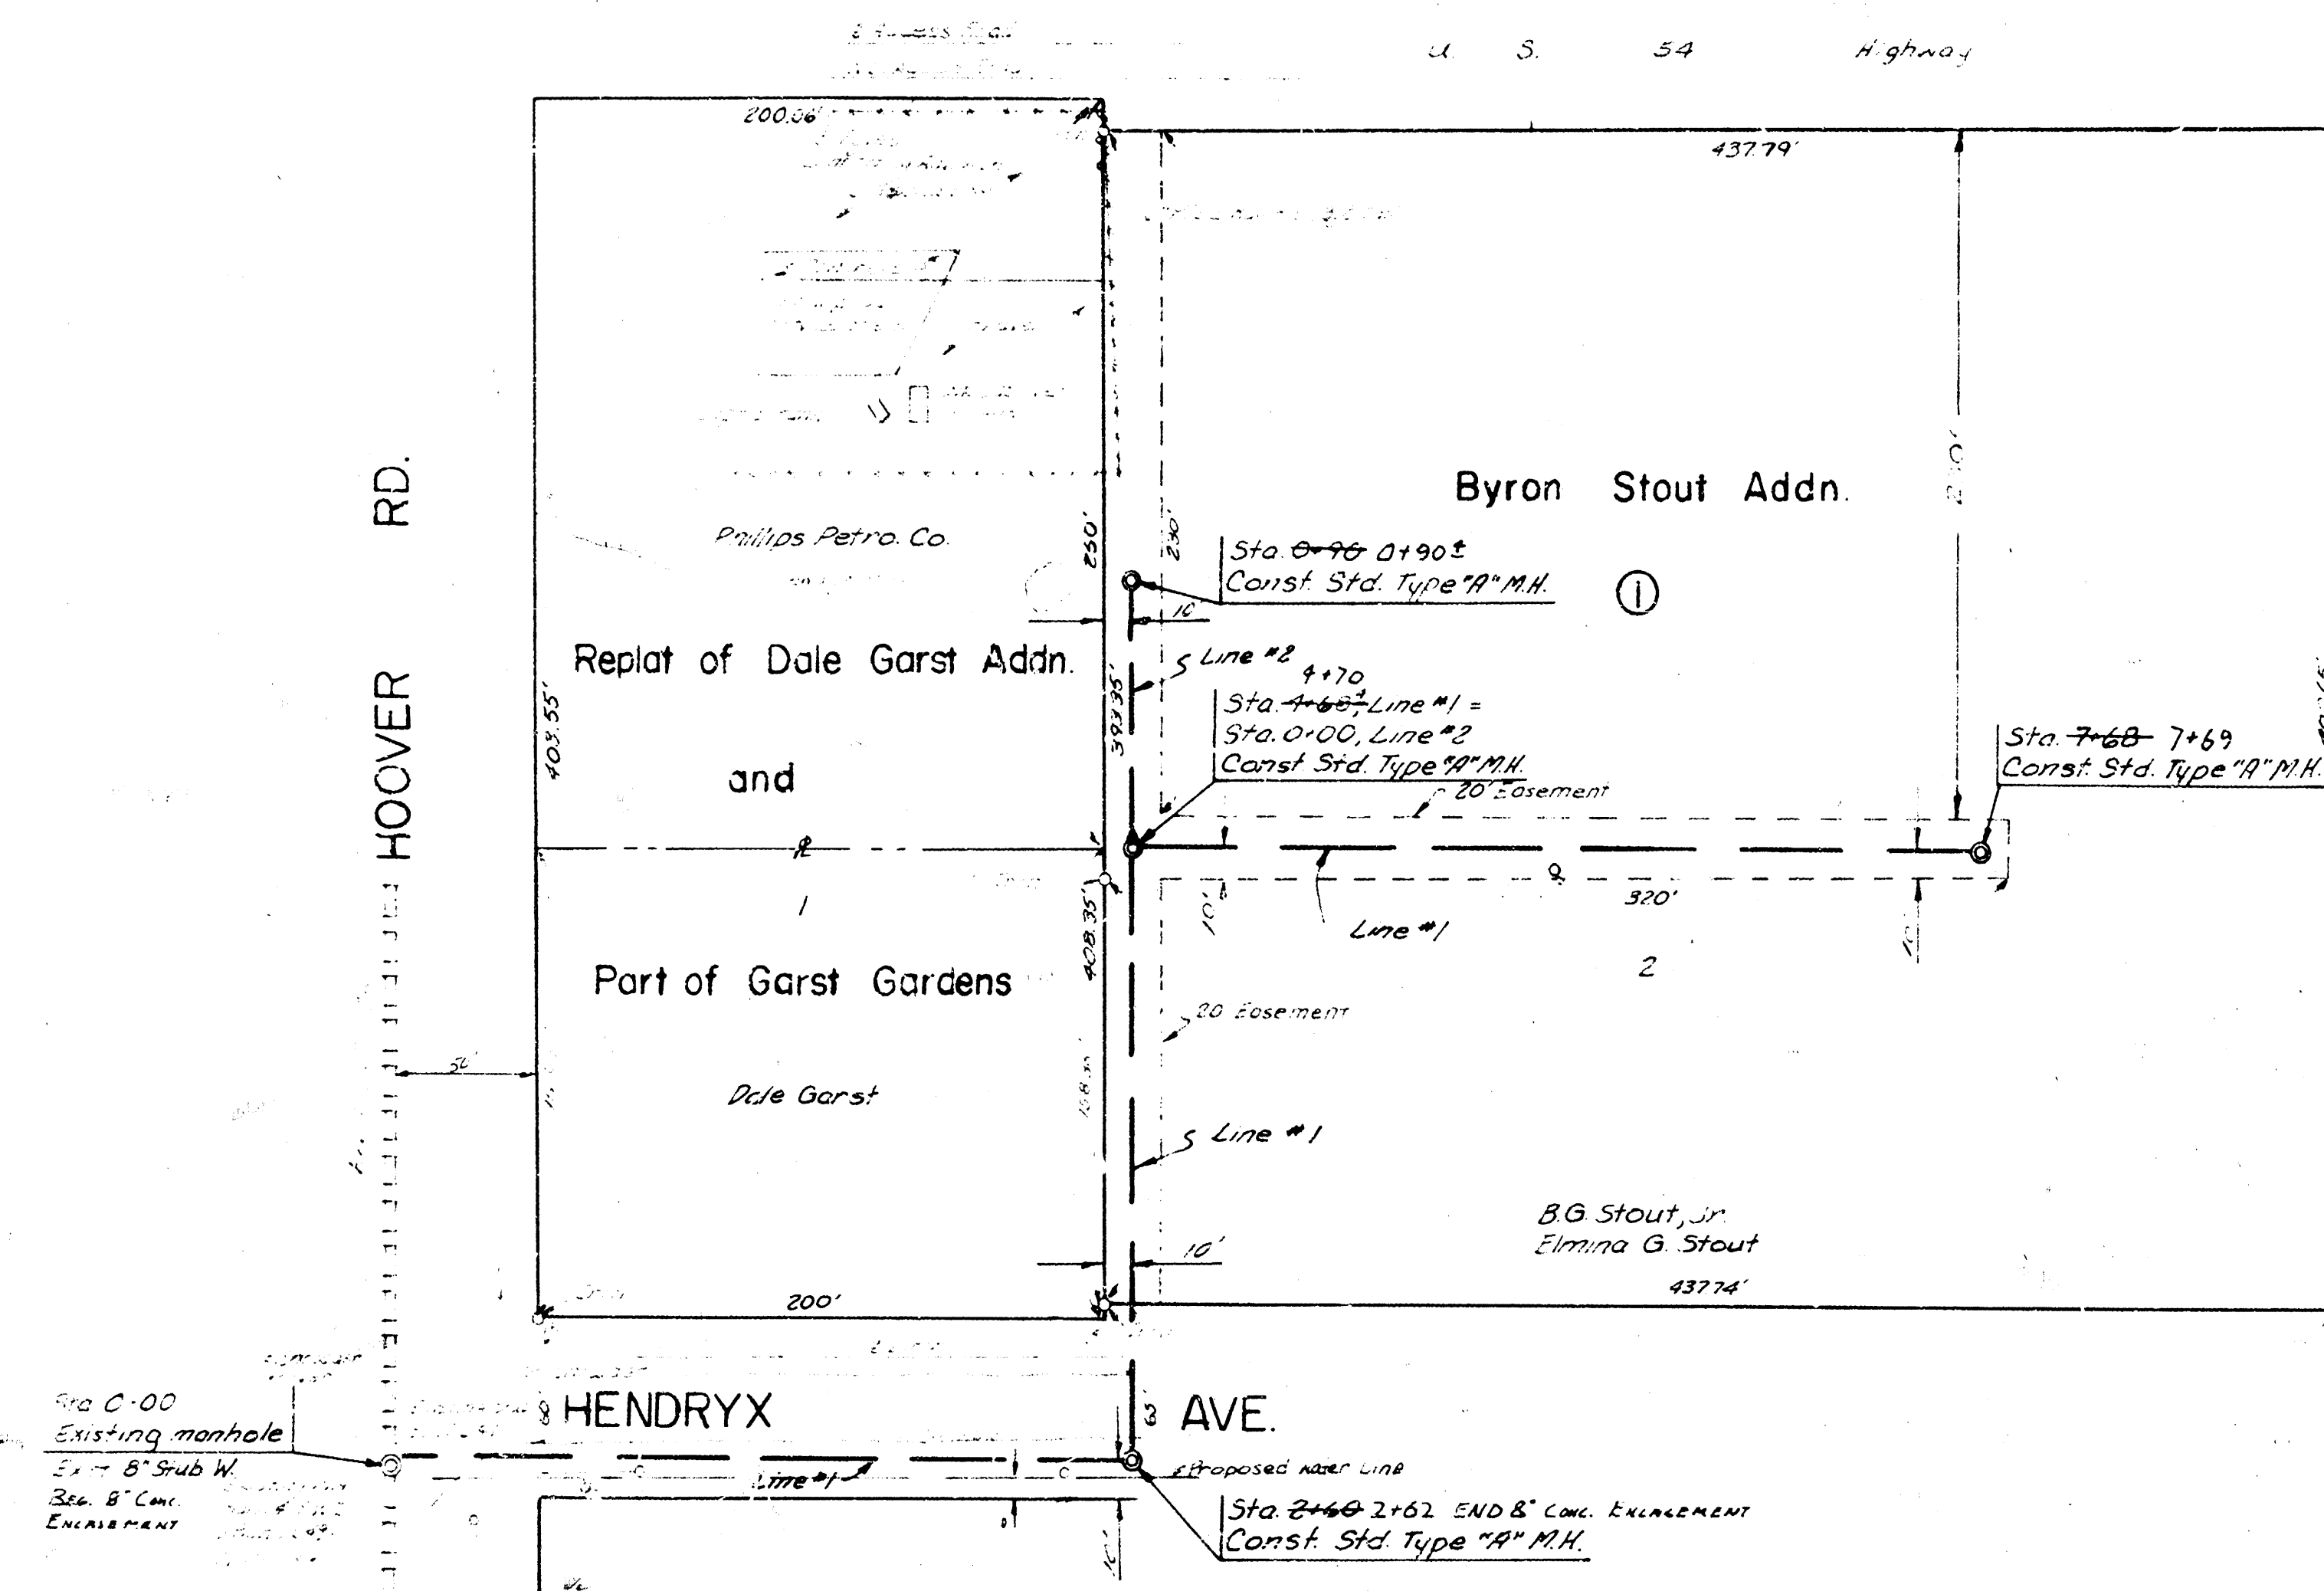


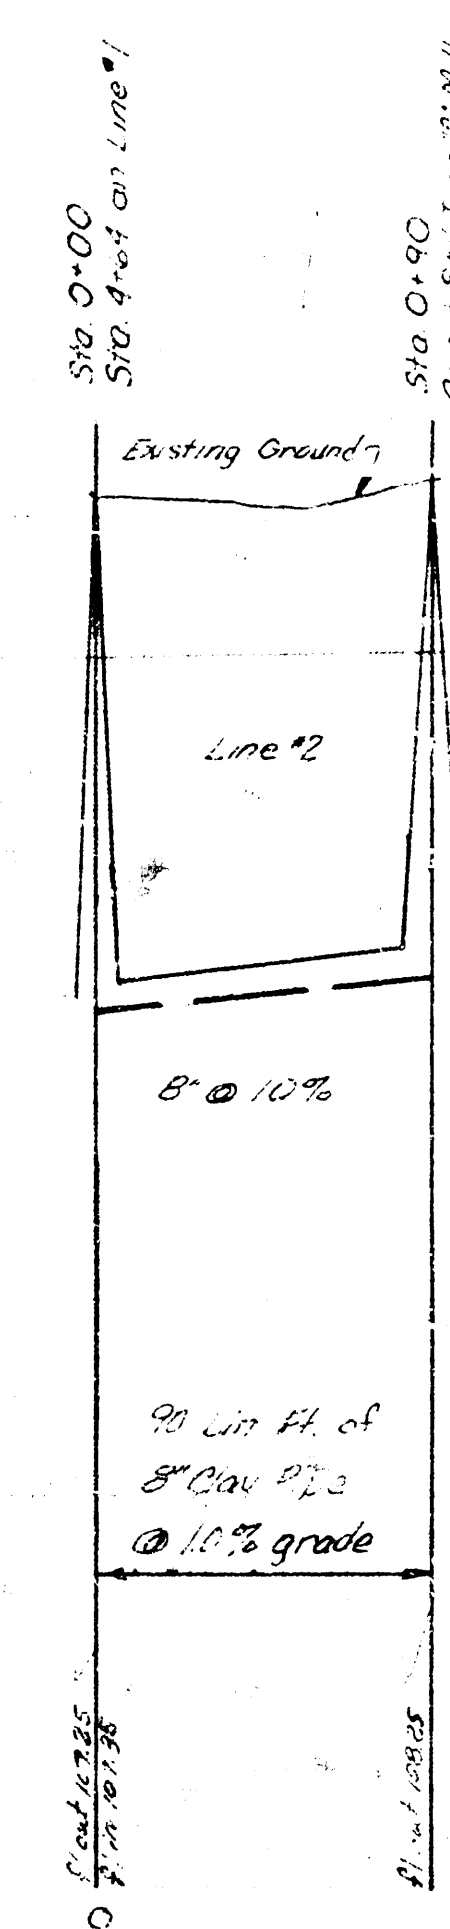

B.M. 116.05 A.R. spike W face PP SE corner Lot 6, Block C, Garst Garden.
B.M. 122.726 7' cut on NW corner concrete flume on SW corner Hoover (US 54).

Note: Field Engineer shall check stubs flow elevation prior to construction of sanitary sewer.

Plan Scale: 1" = 50'
Profile Scale: 1" = 5'
Profile Scale for 1" = 5'

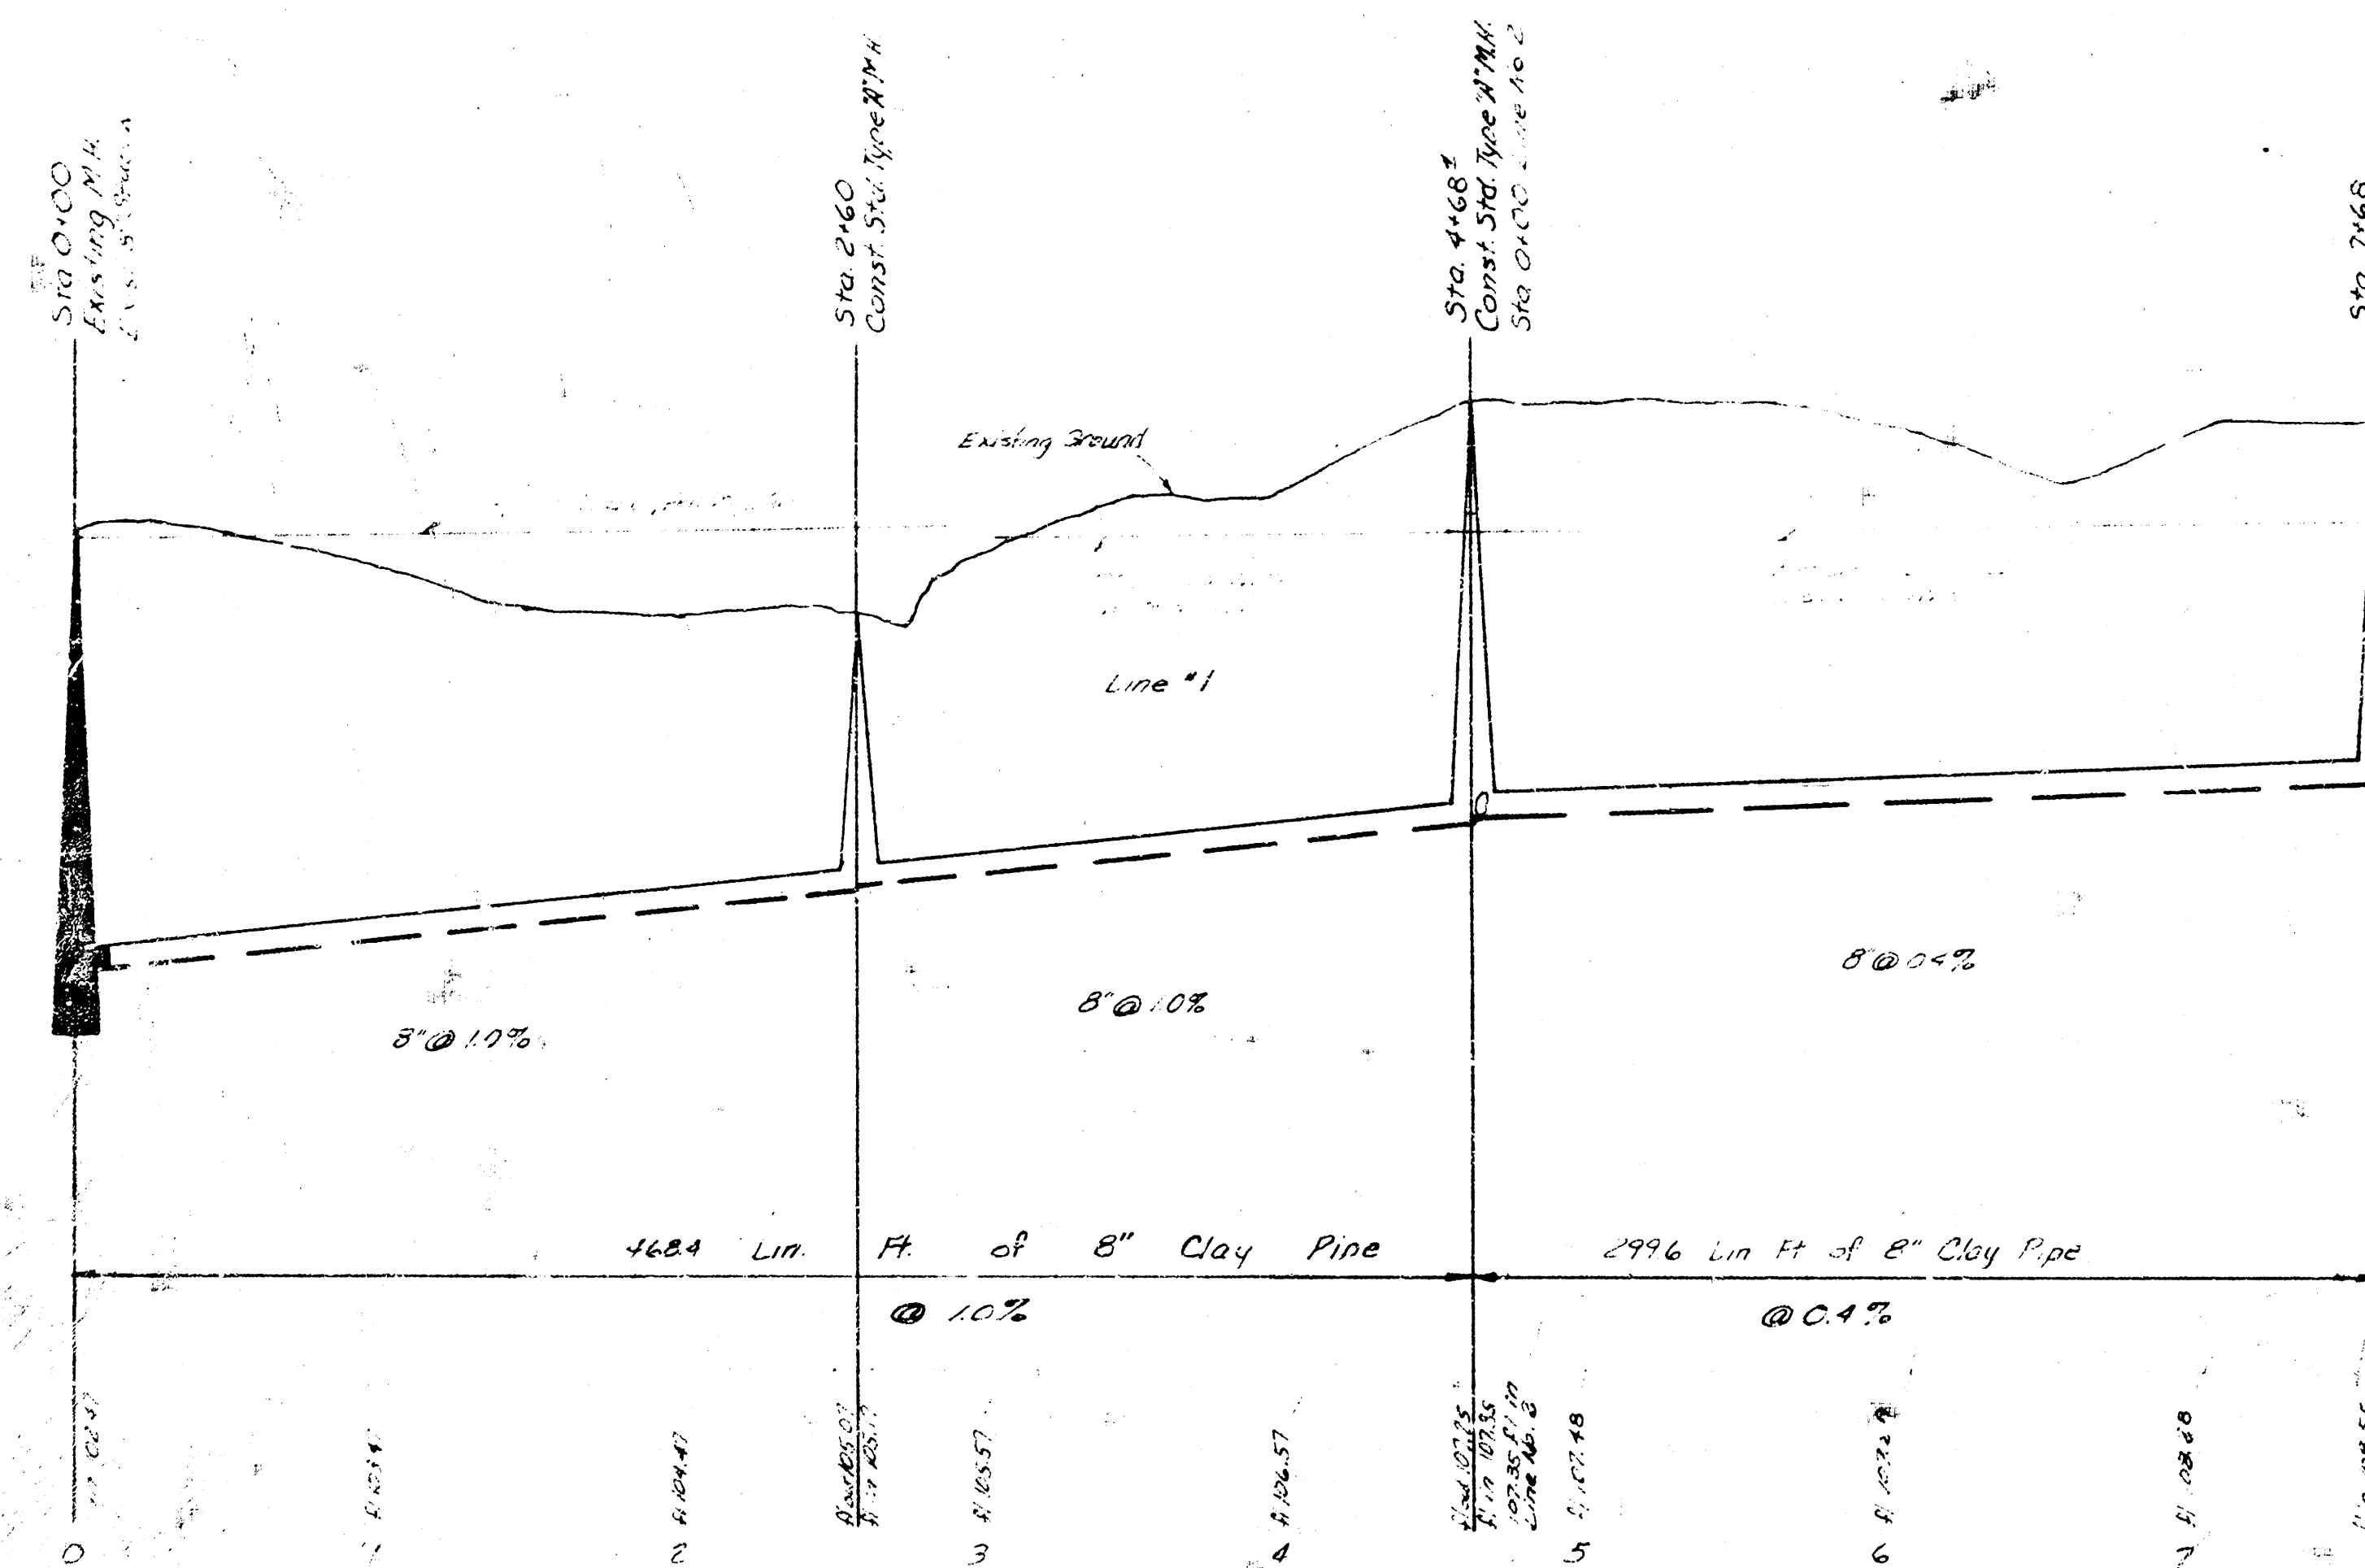

"As Built" Final Measurements K-83
LAT 15, MAIN 4, S.W. INTERCEPTOR
LINES 1 & 2
R. W. LINN CITY ENGINEER
CITY OF WICHITA, KS
PR. NO. DBKL 572025 DATE 7-72