



DL King
S. Spencer


DIVISION

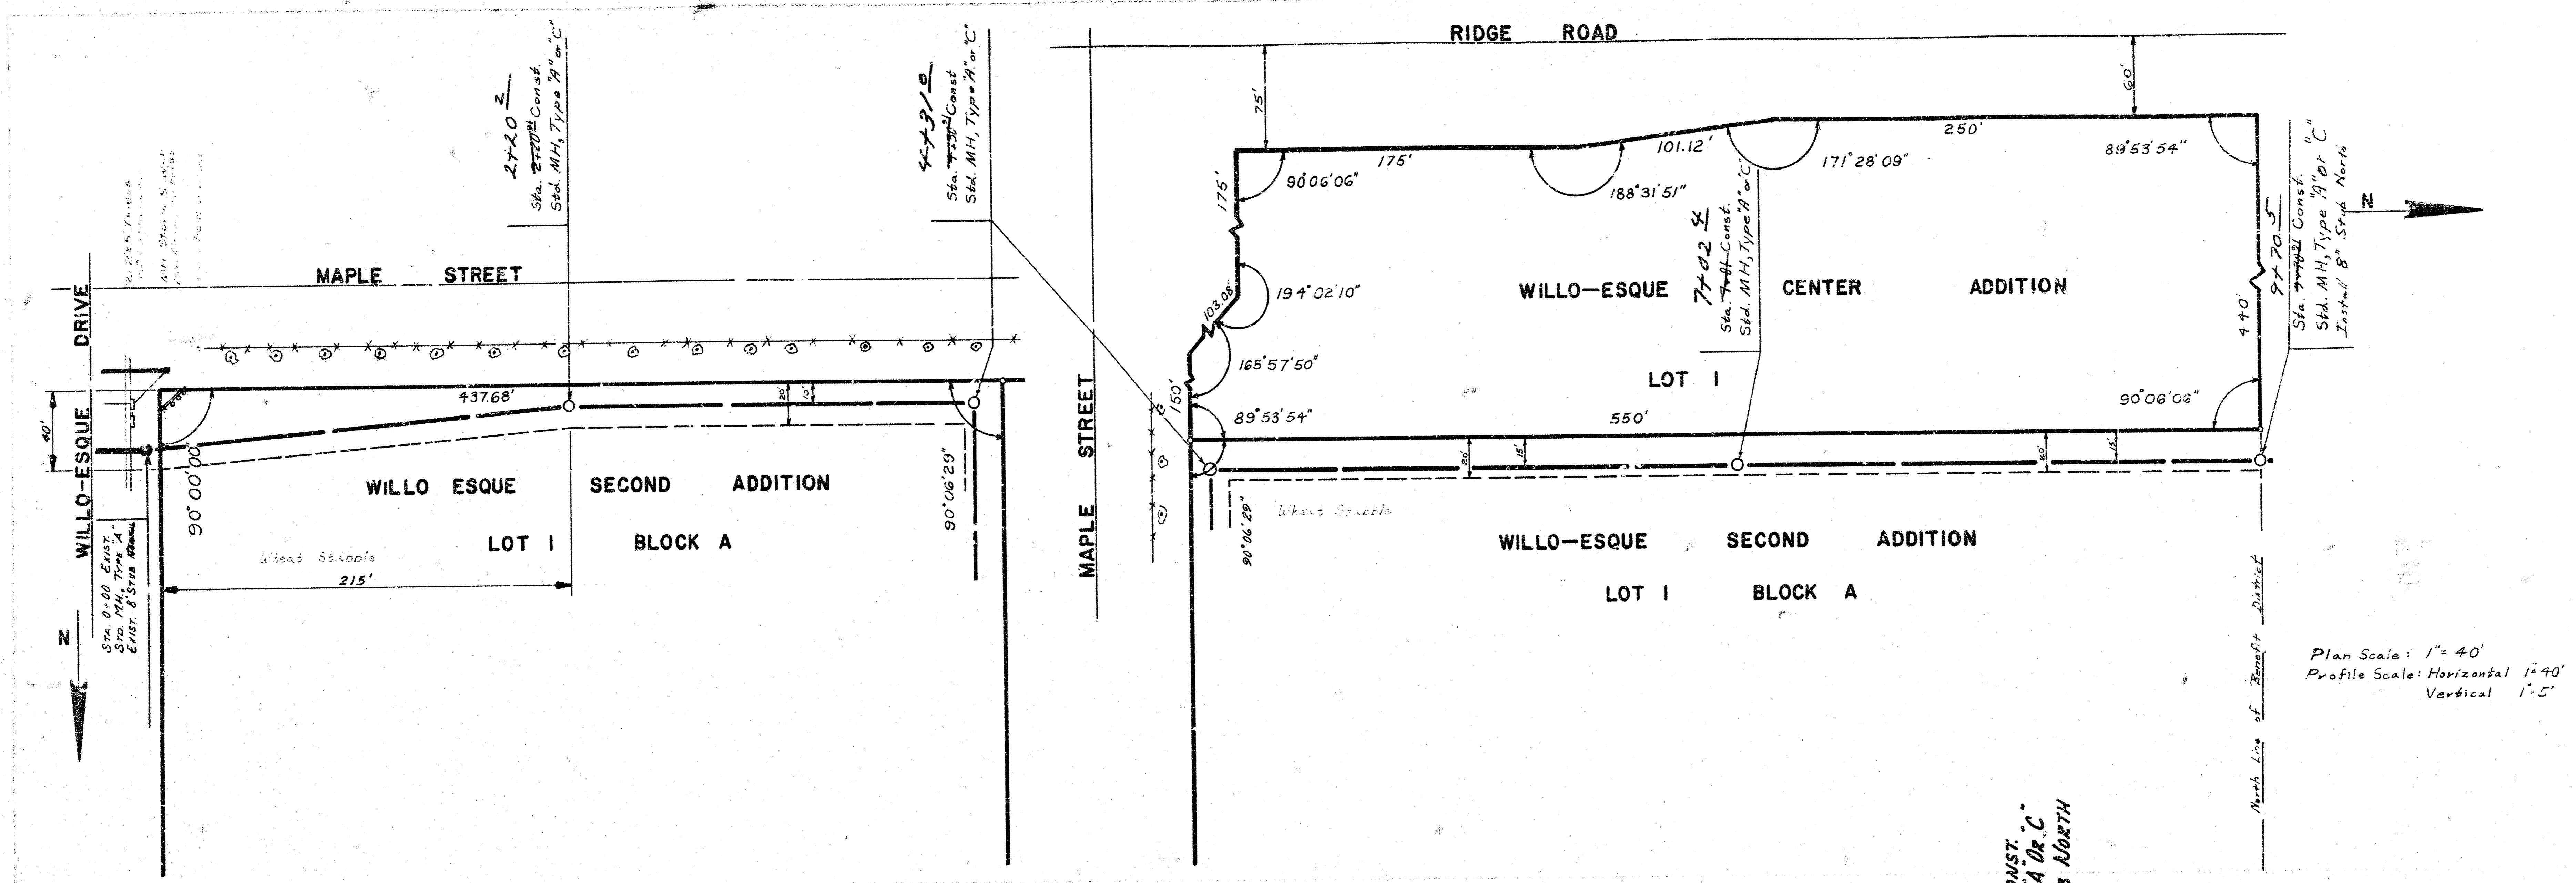

Plan Scale: 1" = 40'
 Profile Scale: Horizontal 1" = 40'
 Vertical 1" = 5'

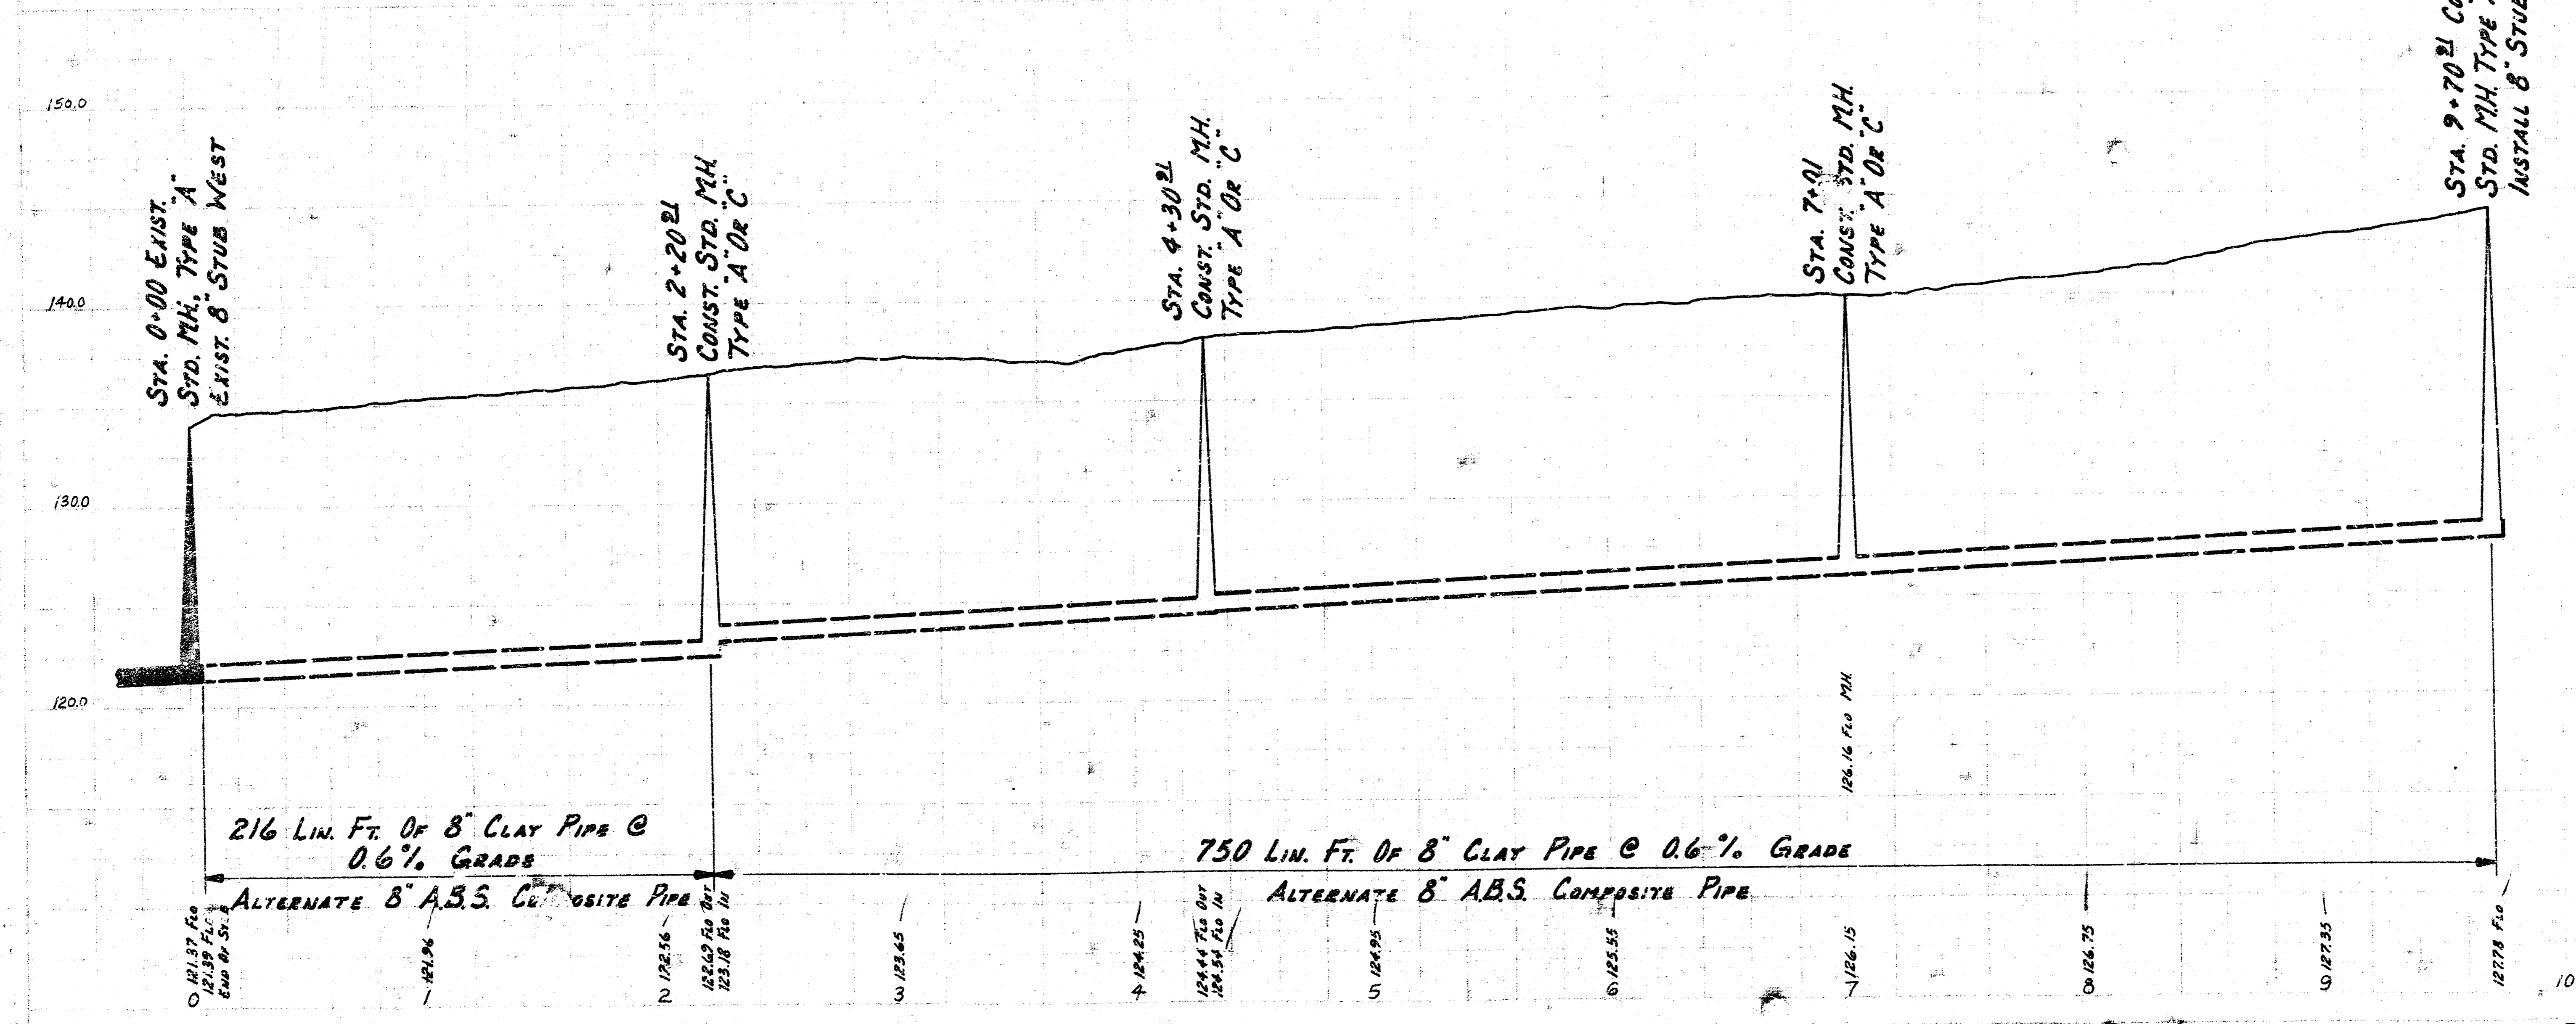

STA. 9+70²¹ CONST.
 STD. MH TYPE A OR C
 INSTALL 8" STUB NORTH

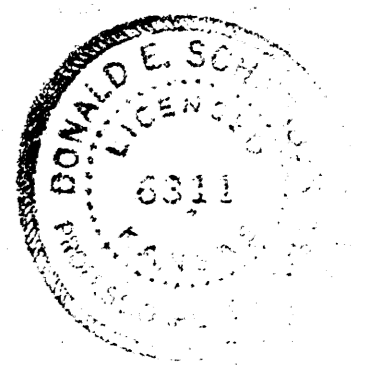

As Built 2-27-76

LATERAL 1 MAIN 6 SOUTHWEST INTERCEPTOR CITY OF WICHITA, KANSAS R.W. LINN CITY ENGINEER DATE: Dec., 1975 SHEET: 1 OF 1 PROJECT NO.: DBKL 573001
--

14 8 4 10