
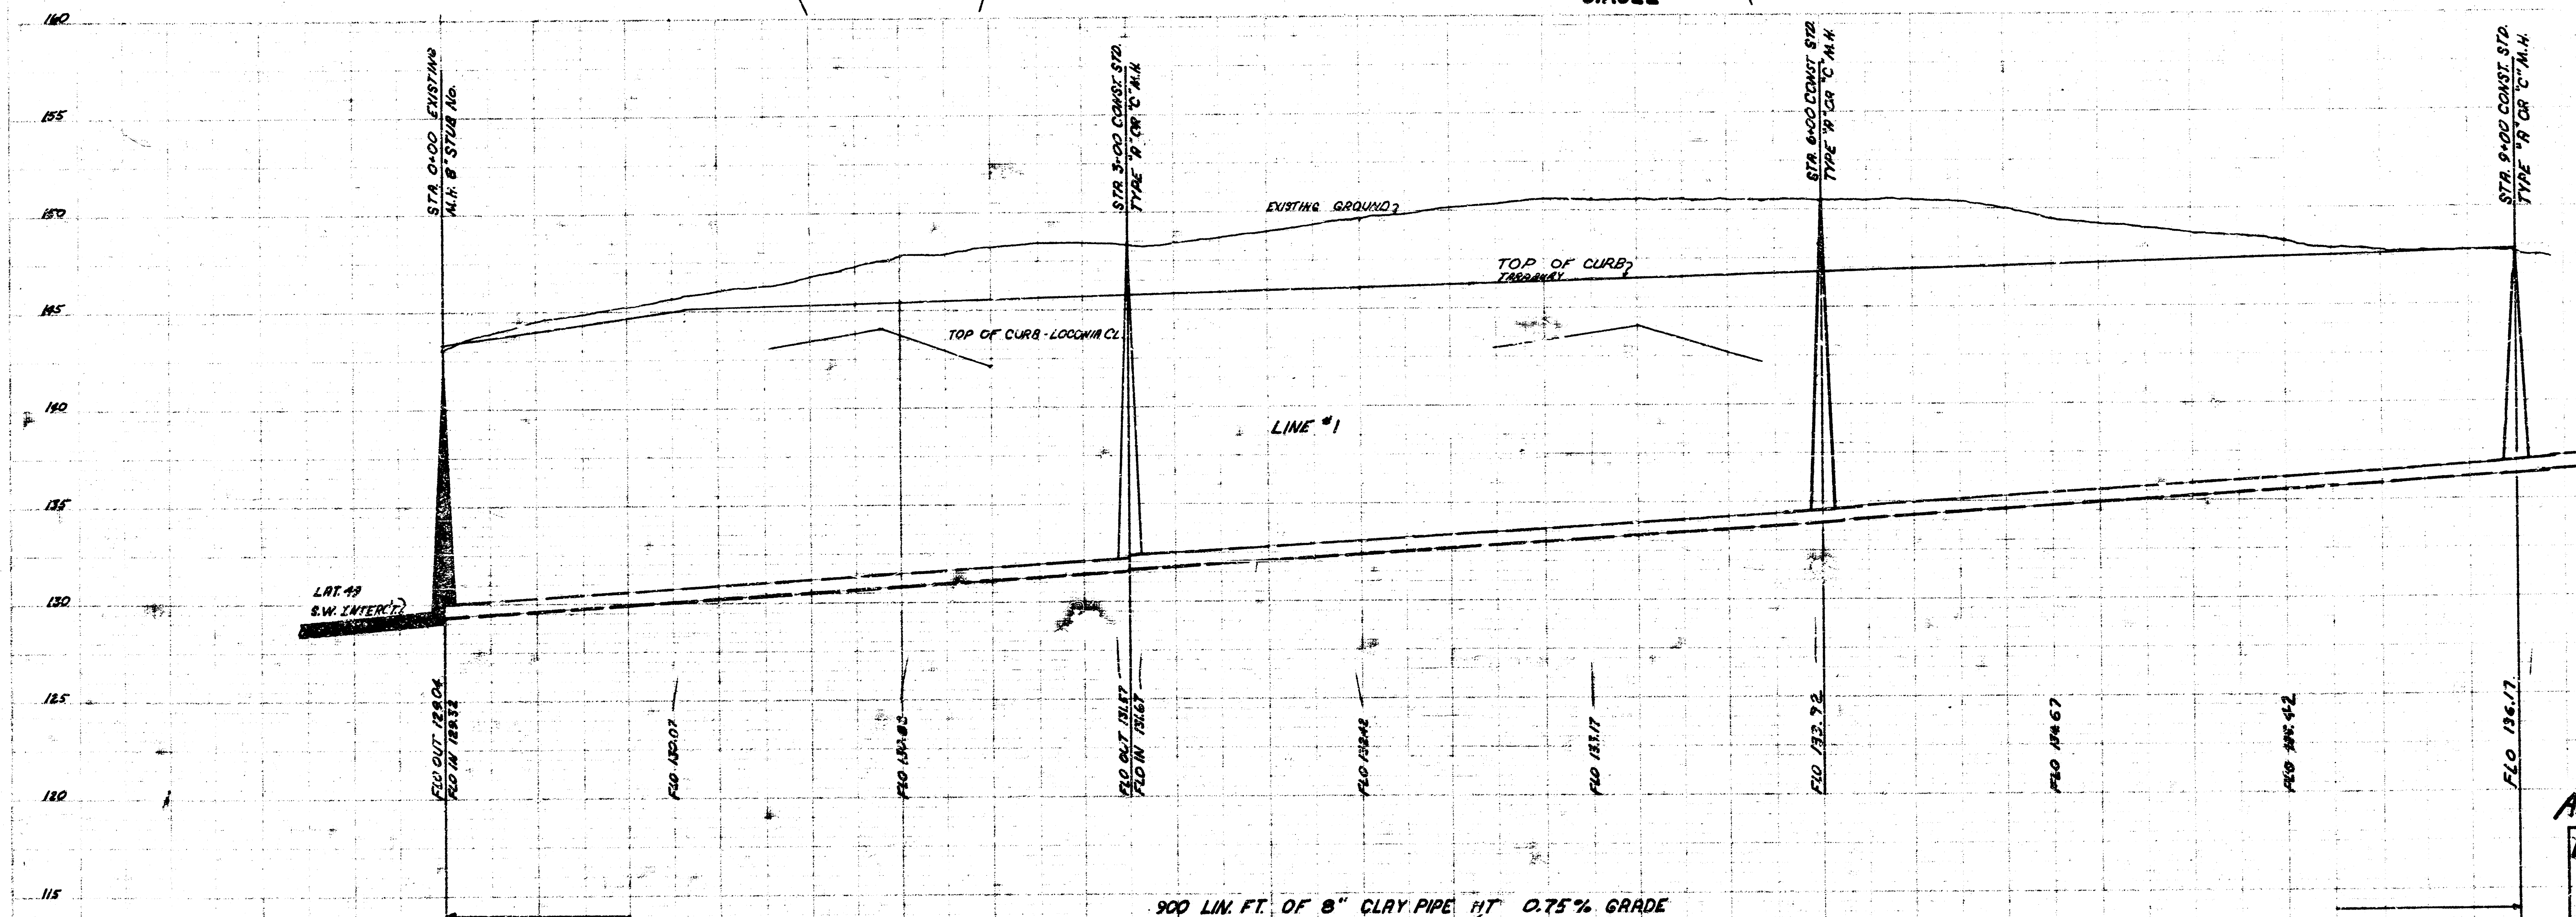


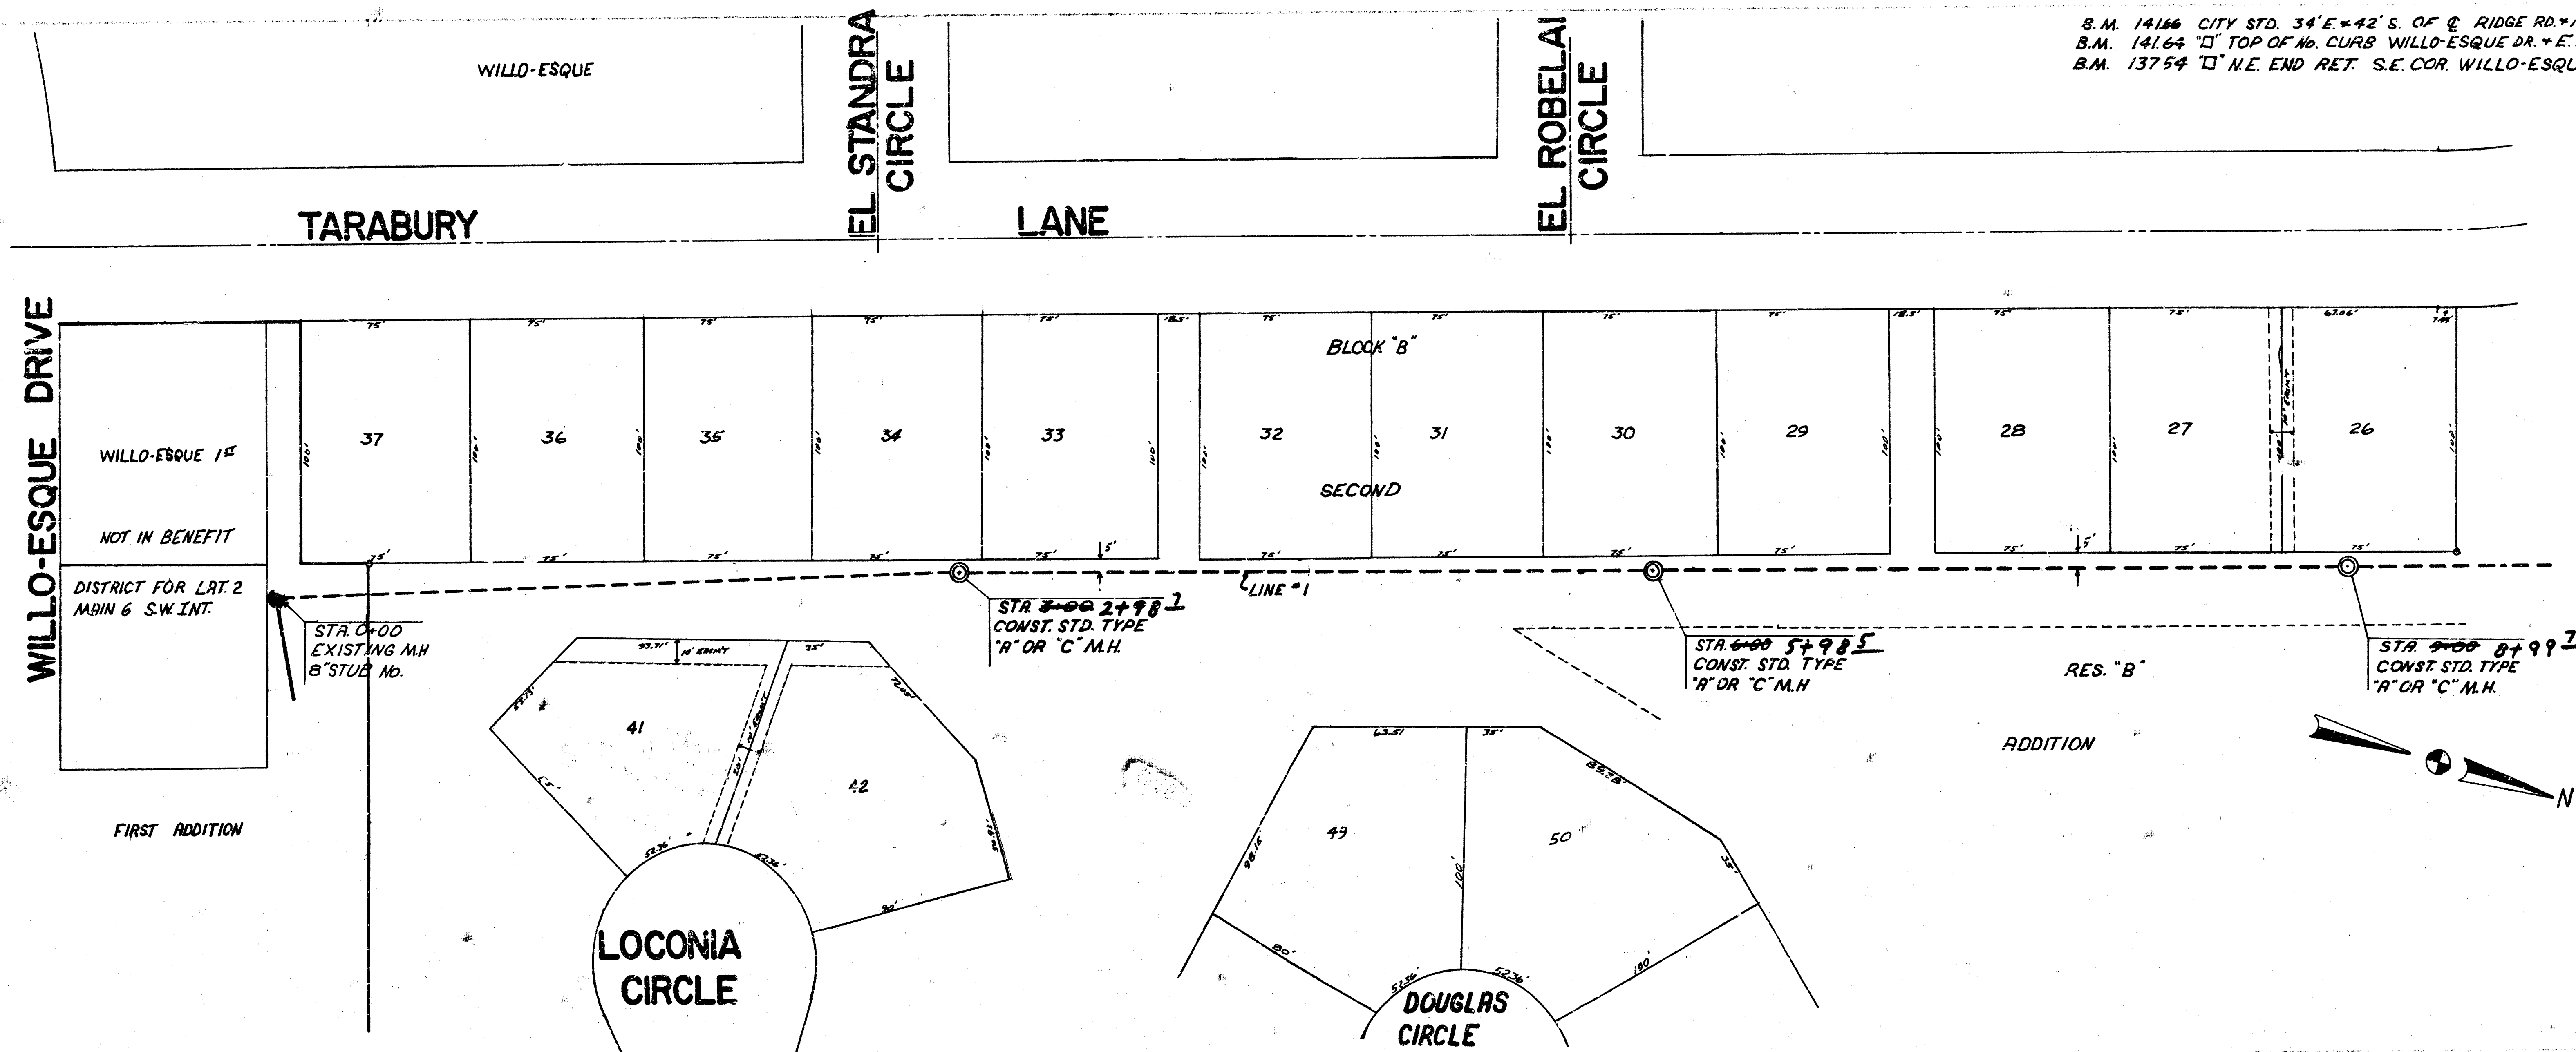

As Built Pk. 6-1



LAT. 2 MAIN 6 S.W. INTERCEPTOR

CITY OF WICHITA, KANSAS

R.W. LINN - CITY ENGINEER

DATE: PROJ. NO. DBKL 573030


SHEET 1 OF 5 LINE "1"

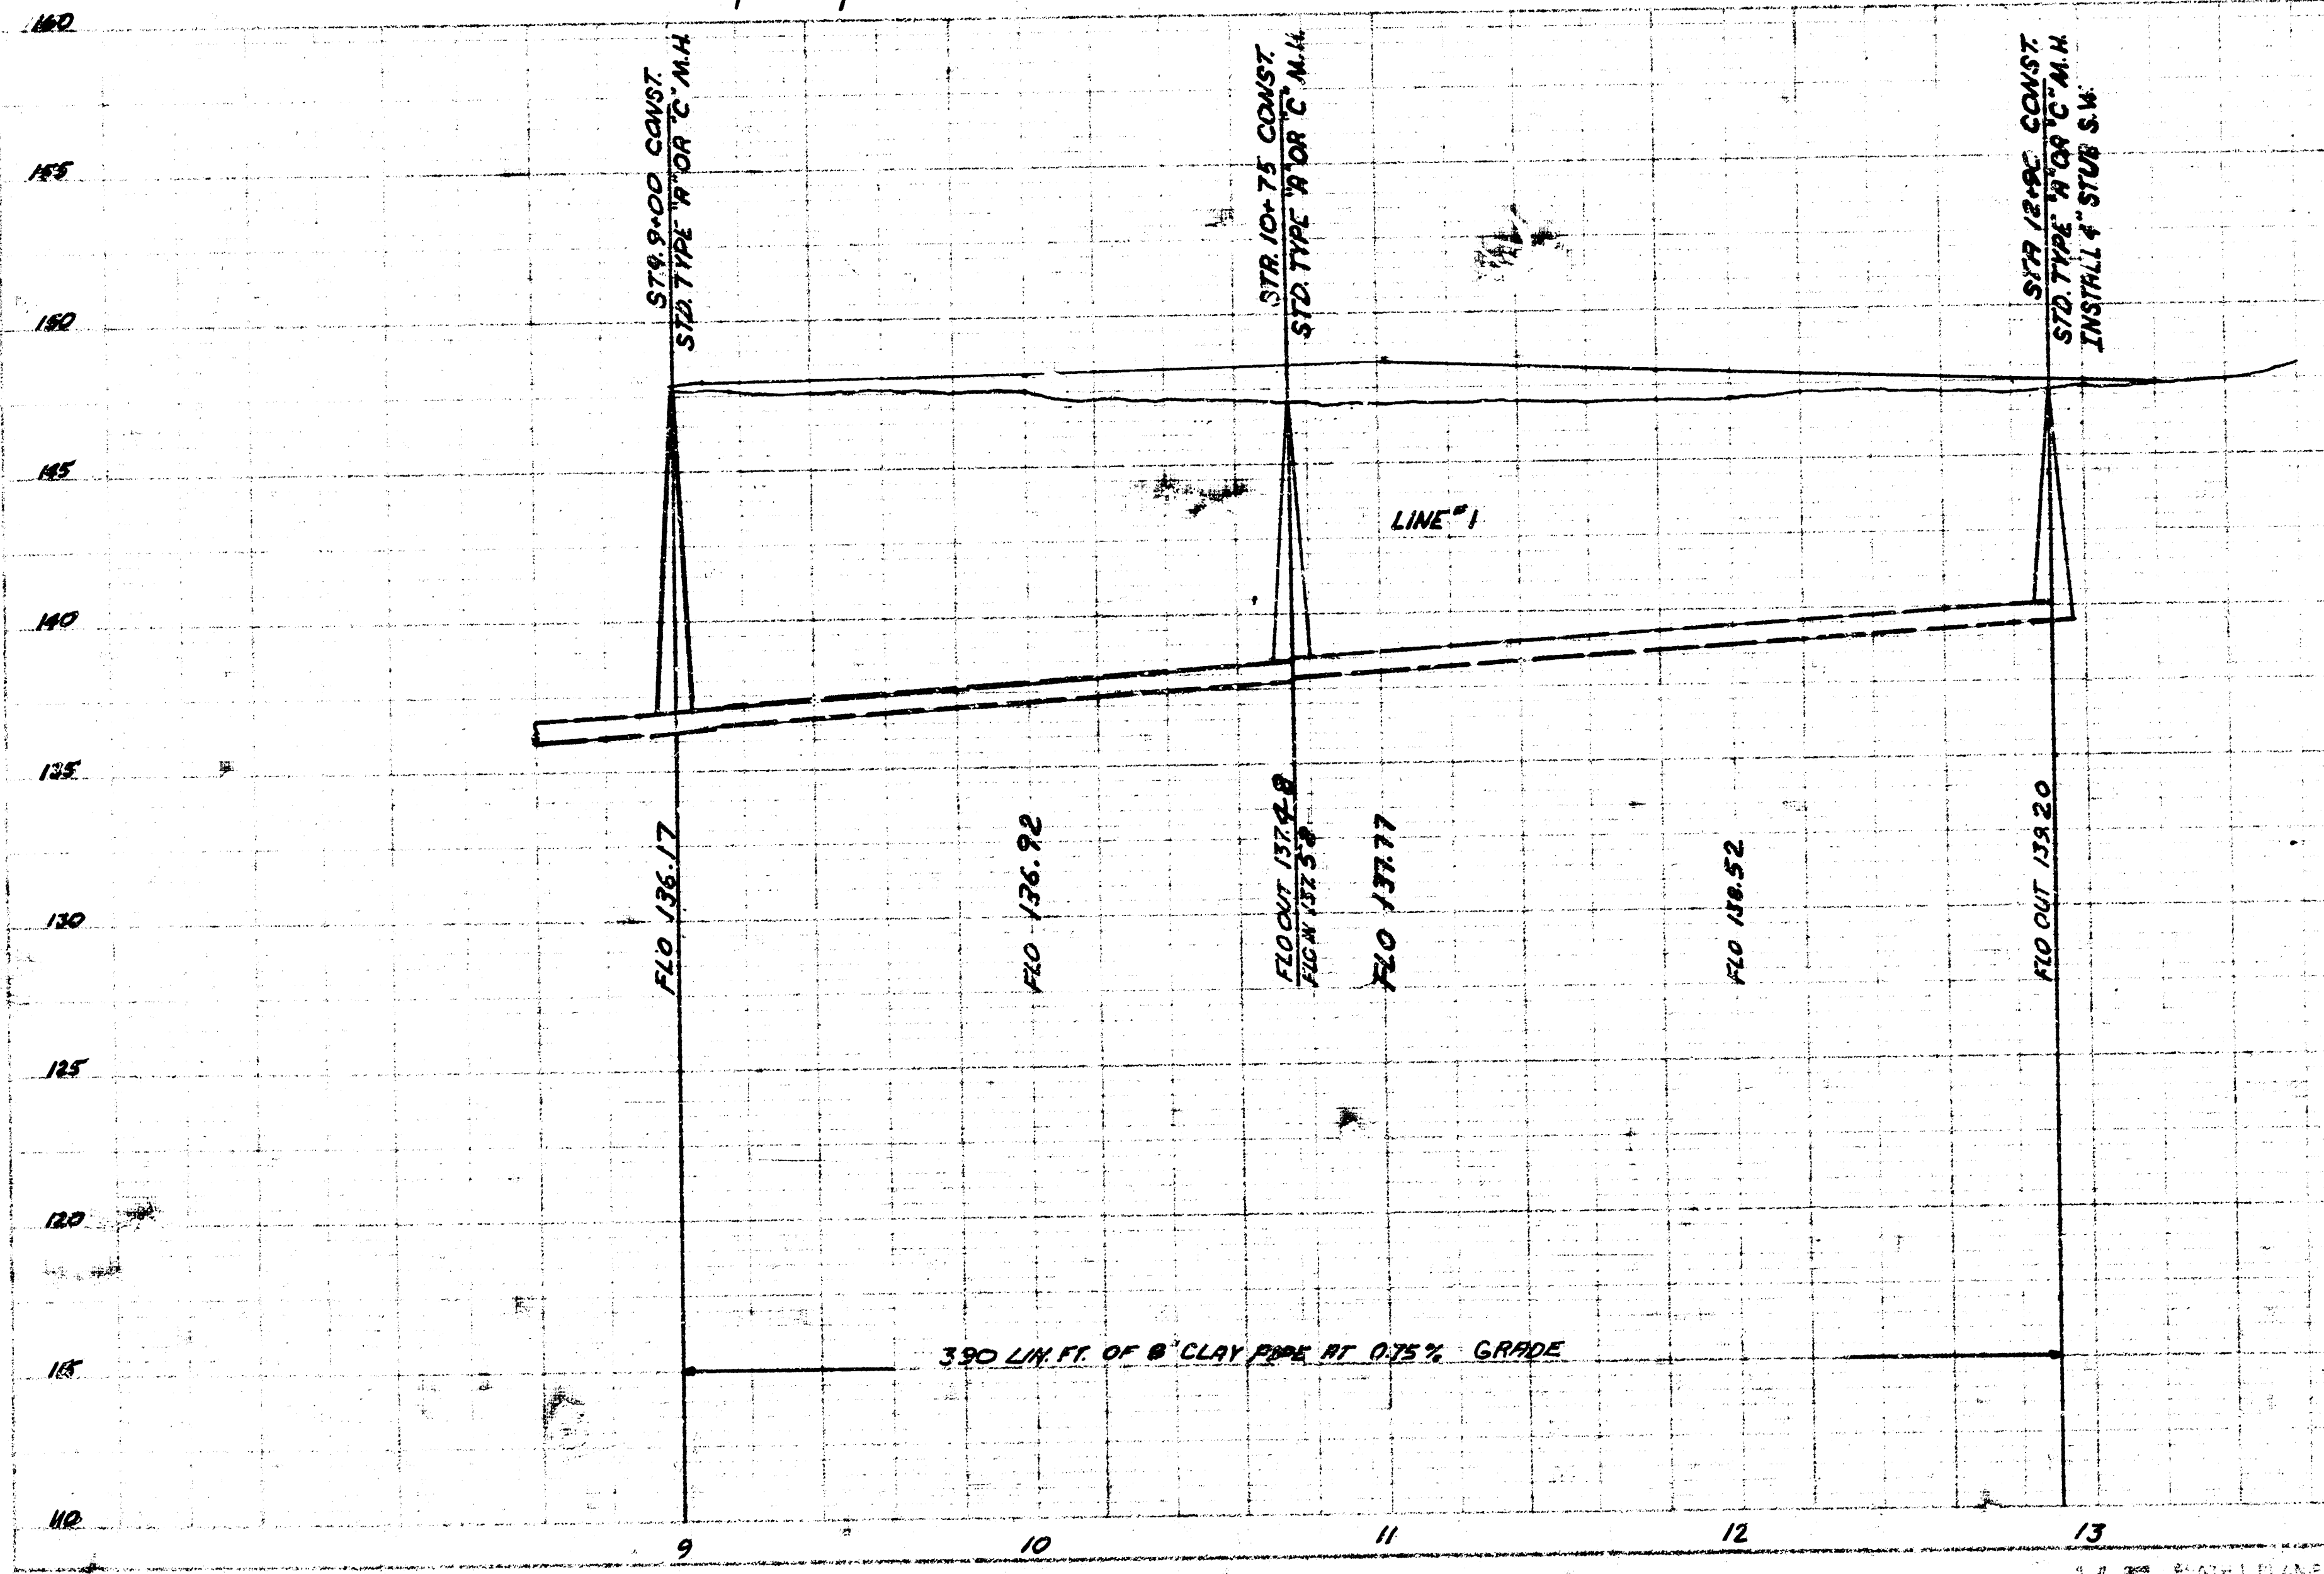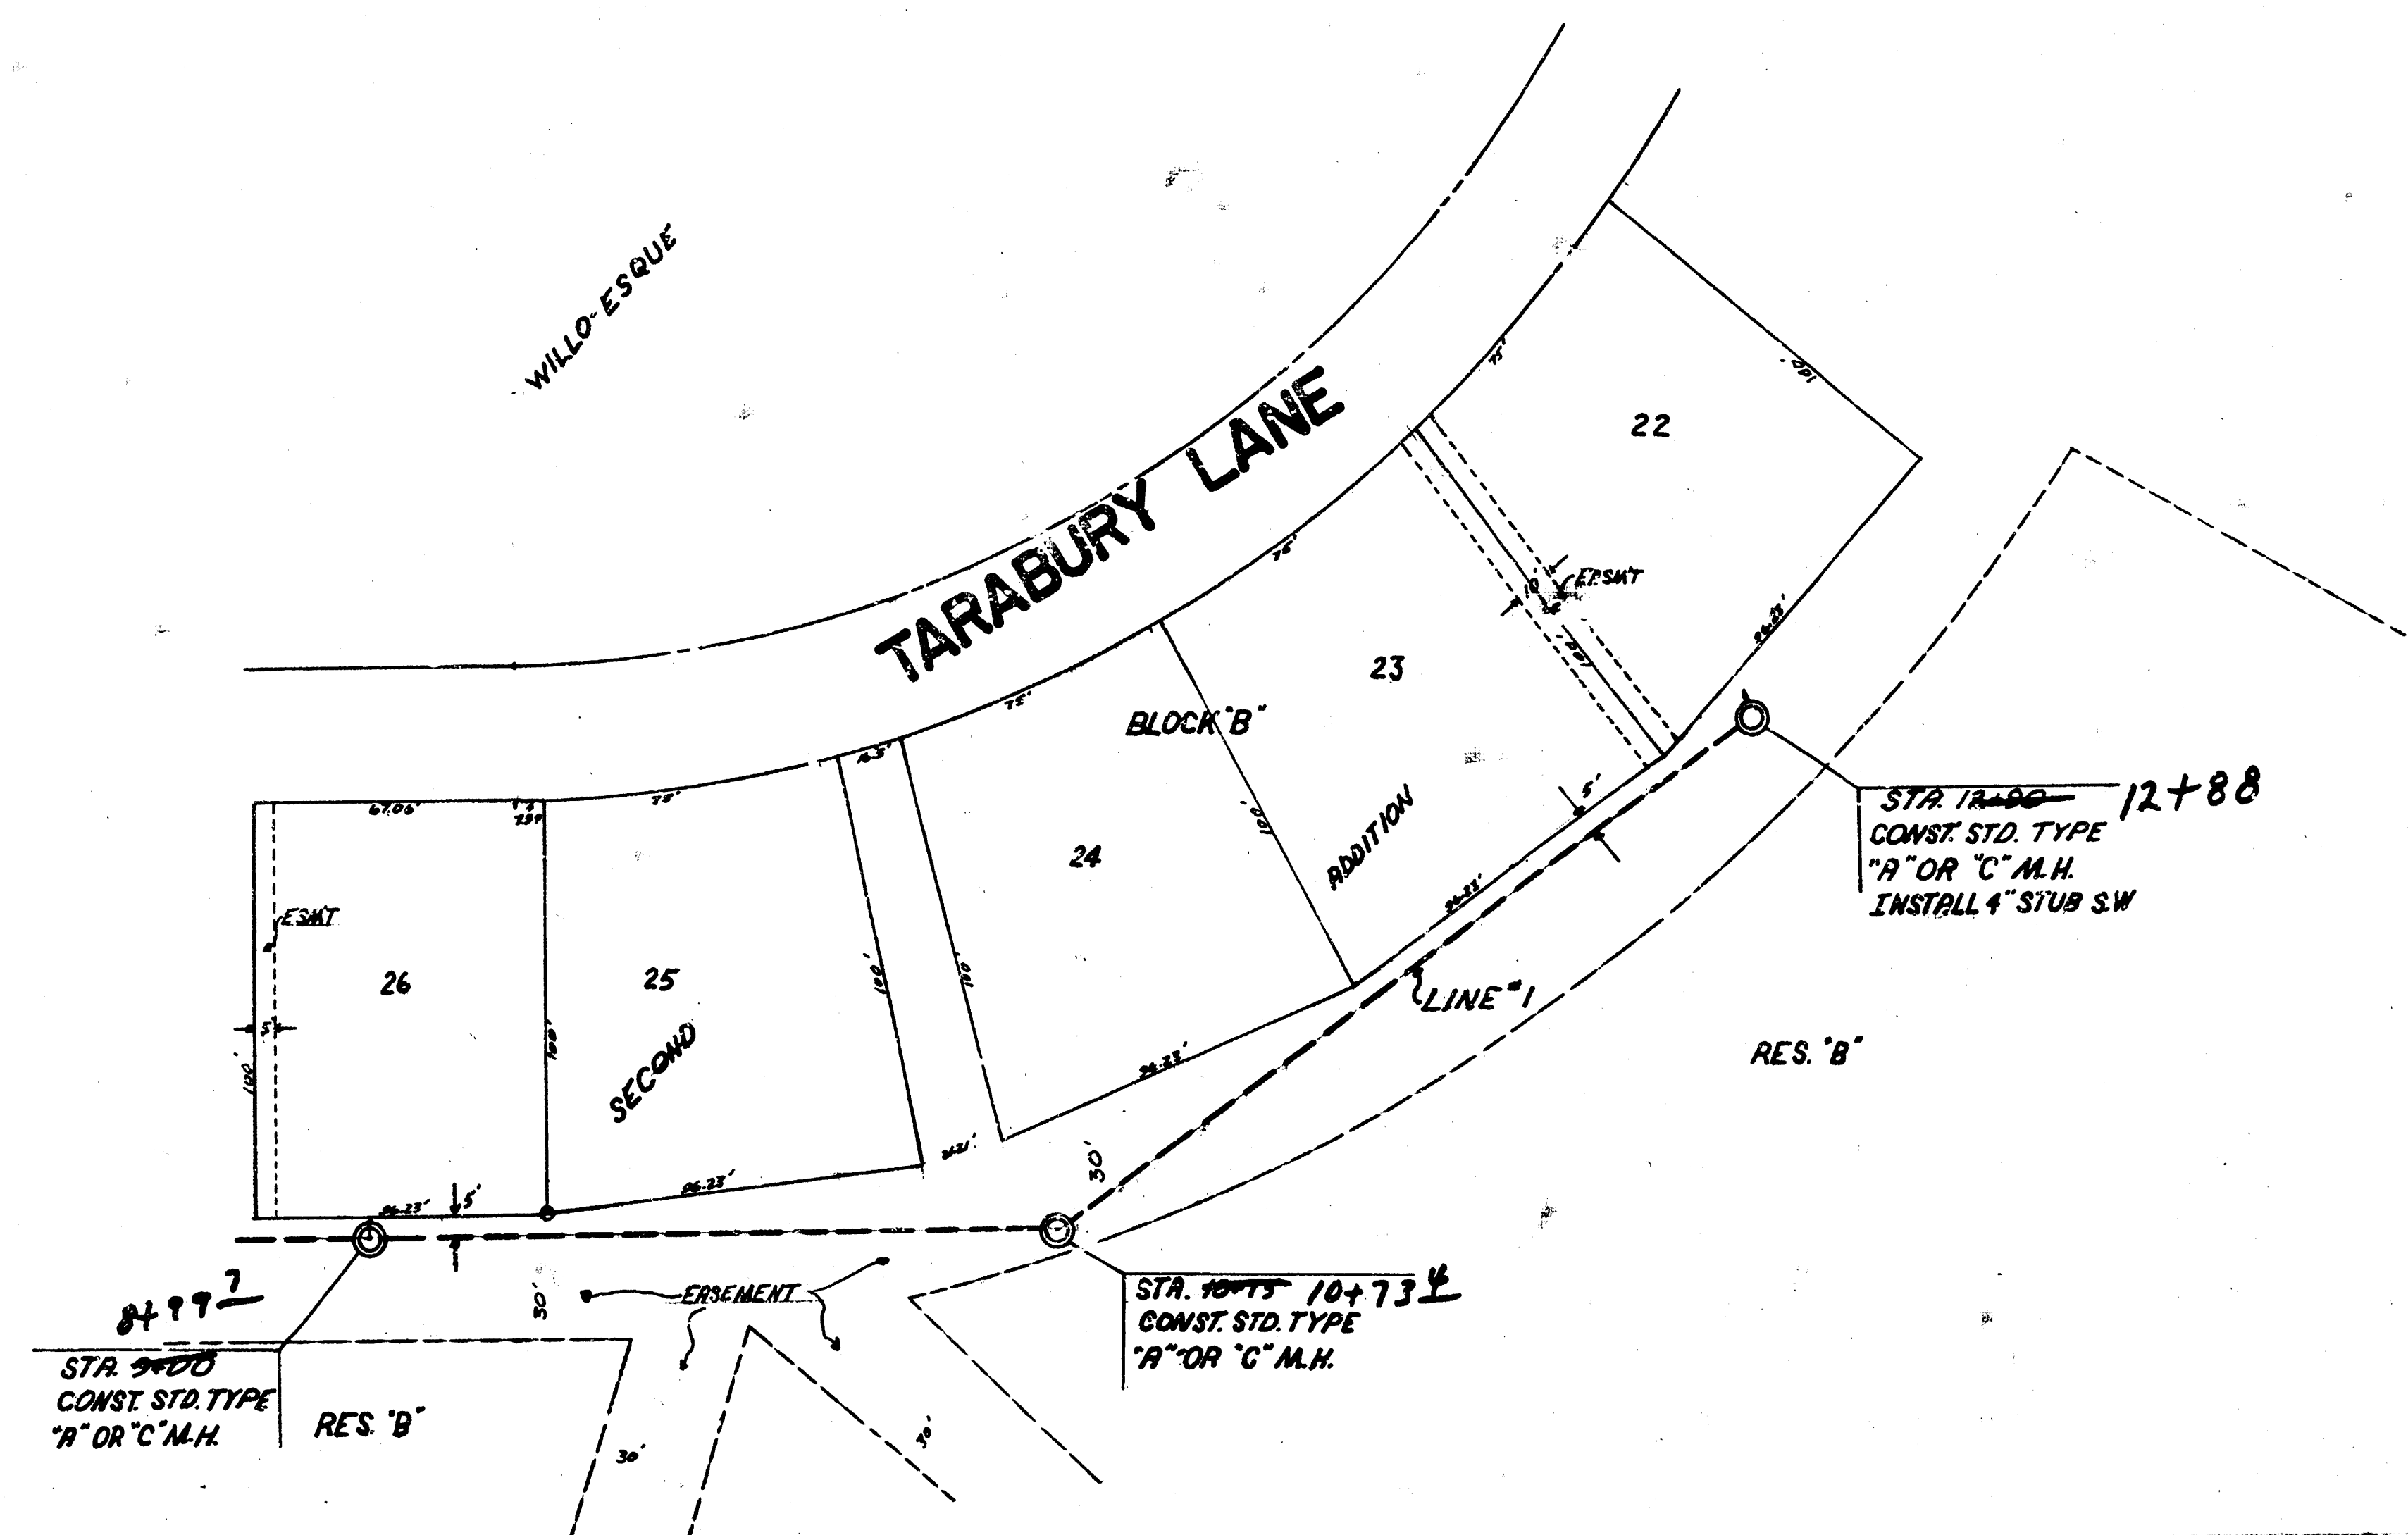


SCALES:
 PLAN: 1"=40'
 PROFILE: 1"=40'
 VERT: 1"=5'

LAT. 2 MAIN 6 S.W. INTERCEPTOR
 PROJ. NO. DBKL 573030
 LINE NO. 1 SHEET 2 OF 5

PREPARED BY: [illegible]
 CHECKED BY: [illegible]
 DATE: [illegible]

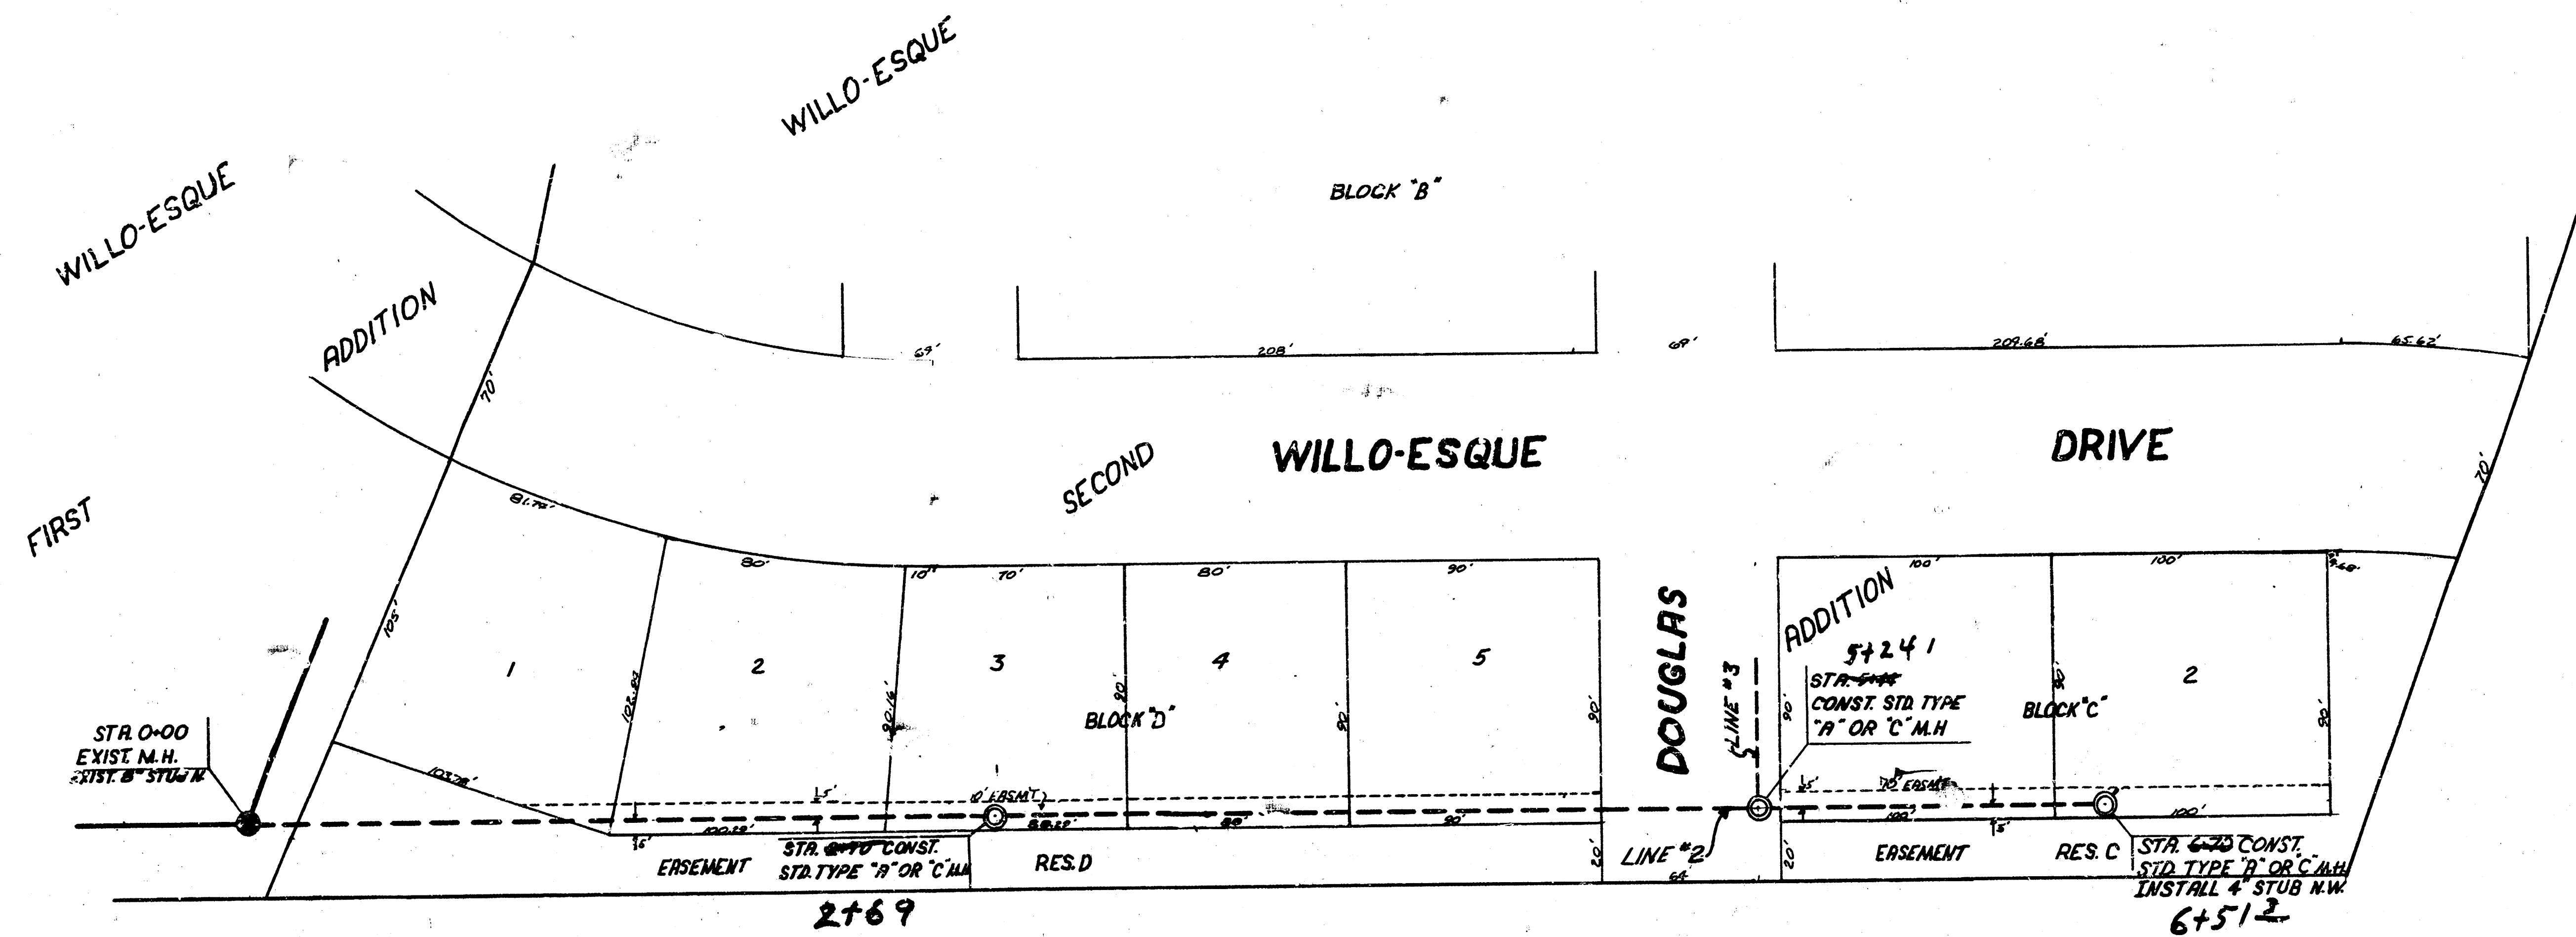


SCALE
PLAN: 1"=40'
PROFILE: HORIZ 1"=40'
VERT: 1"=5'

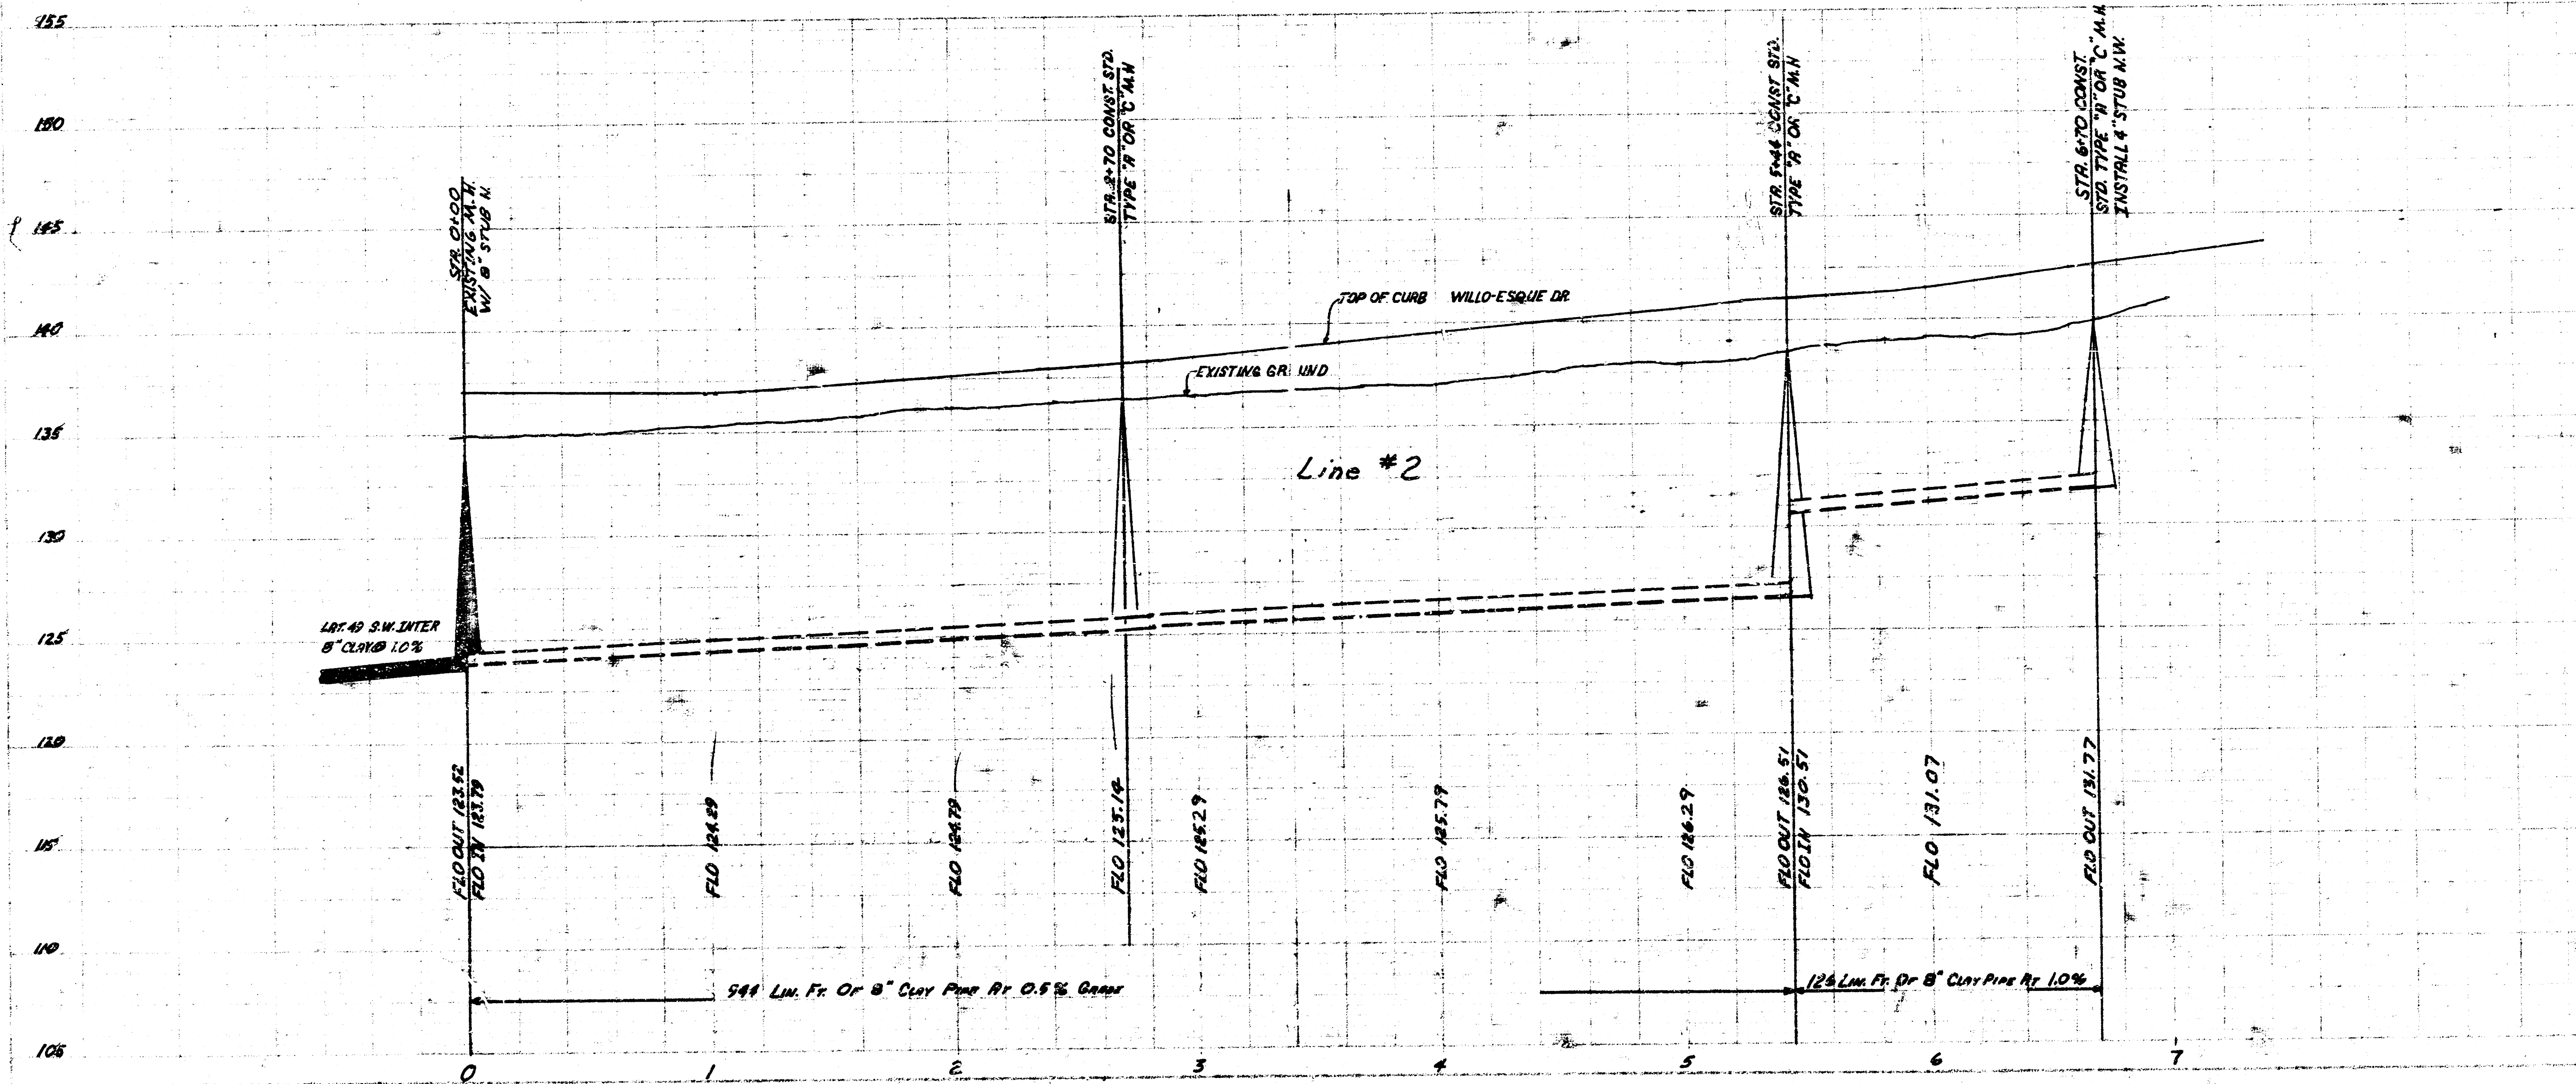


LAT. 2, MAIN 6, S.W. INTERCEPTOR
LINE #2 PROJ. NO. DAKL573030
SHEET 3 OF 5

3/5

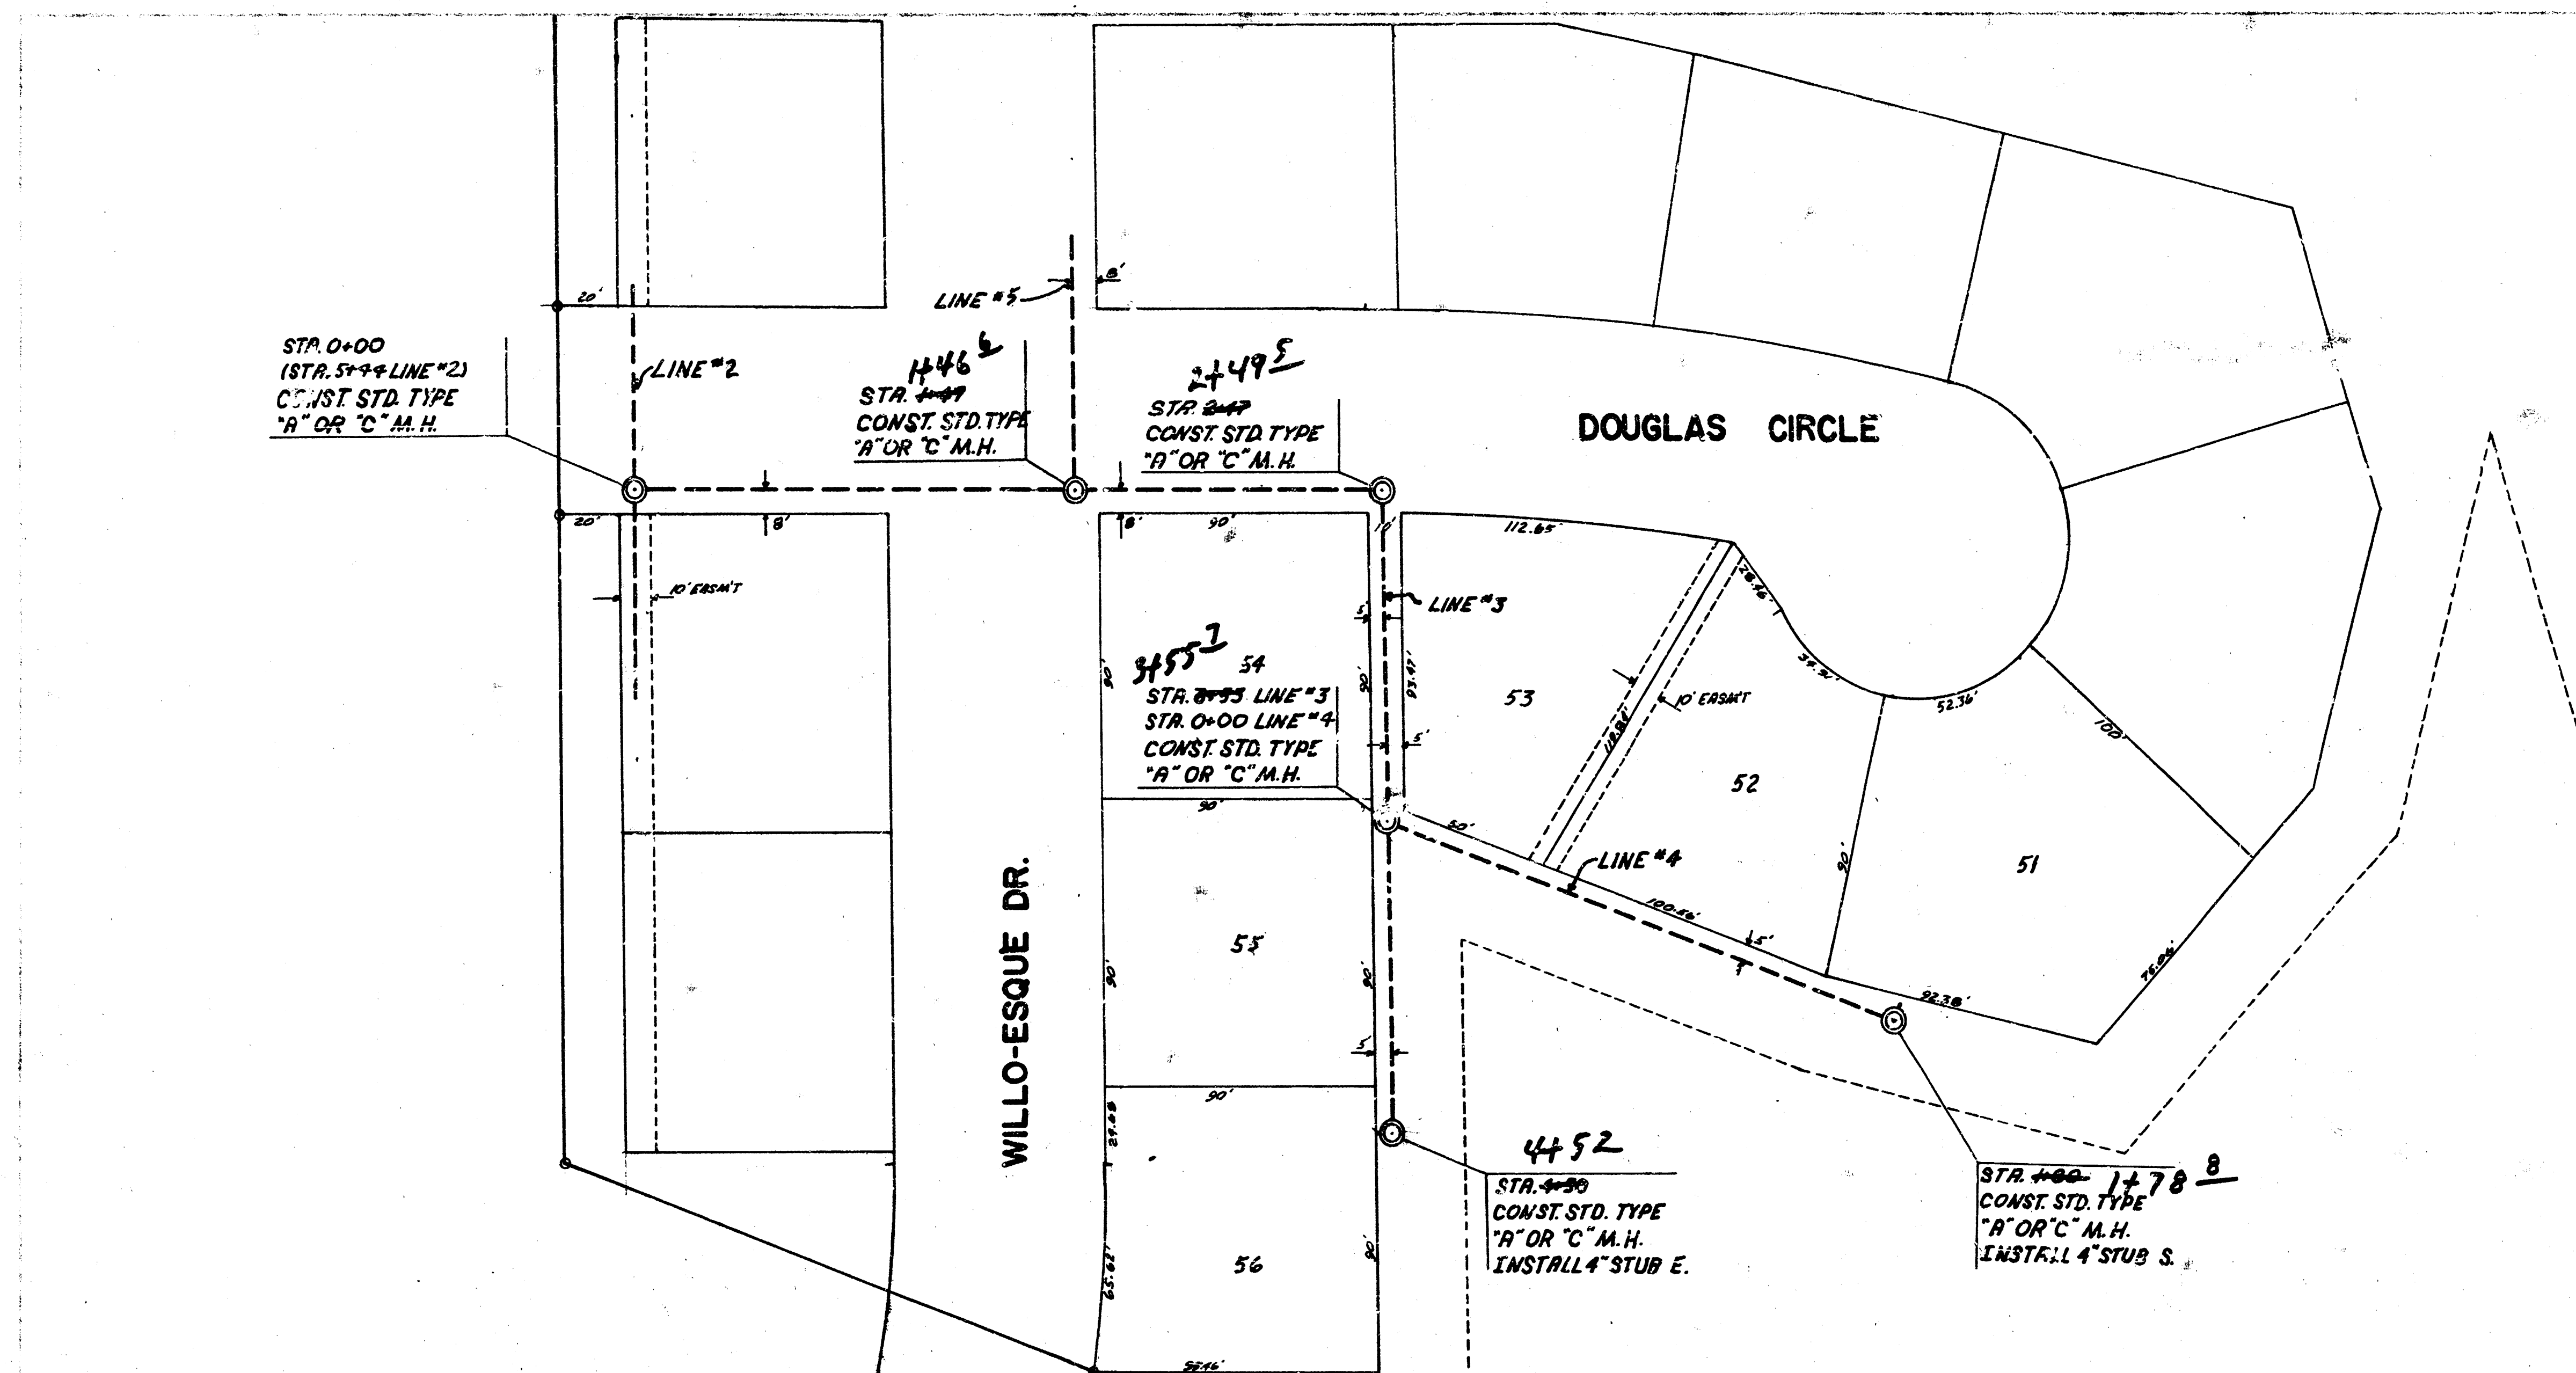

SCALE:
PLAN: 1"=40'
PROFILE: 1"=40'
HOR: 1"=40'
VERT: 1"=5'

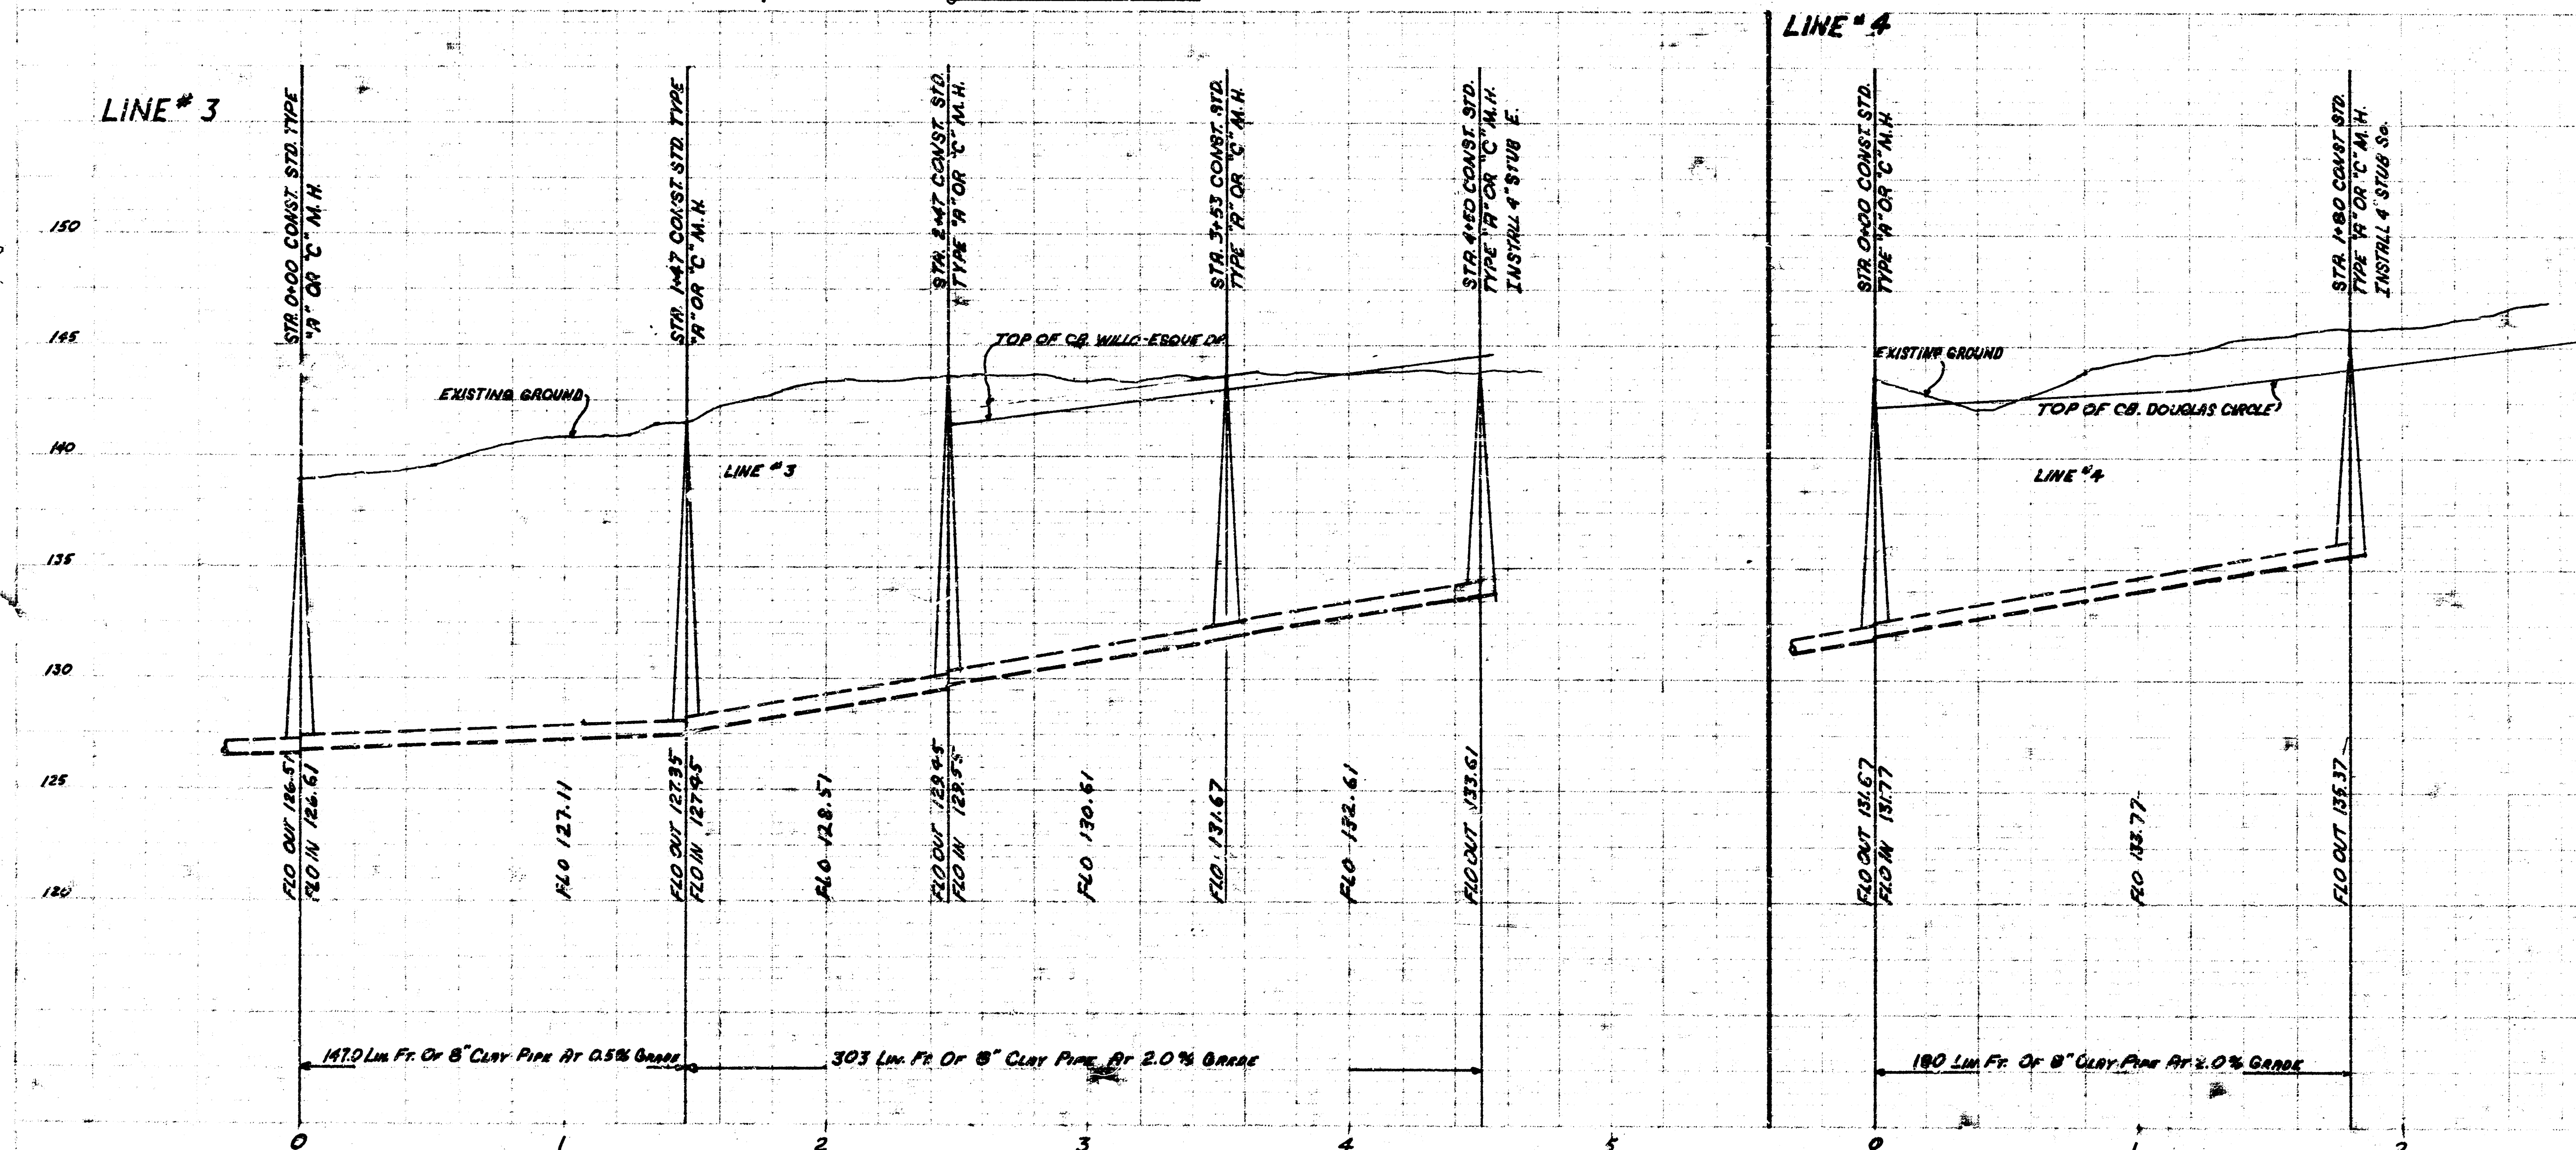

LAT. 2 MAIN 6 S.W. INTERCEPTOR
LINES 3+4 PROJ. NO. DBKL573030
SHEET 4 OF 5

