


LATERAL 6, MAIN 6, SOUTHWEST INTERCEPTOR SEWER

CITY OF WICHITA, KANSAS

R. W. BRUGGEMAN: DIRECTOR OF ENGINEERING / CITY ENGINEER

PROJECT NO. 468-76-245-80892-000-000-001

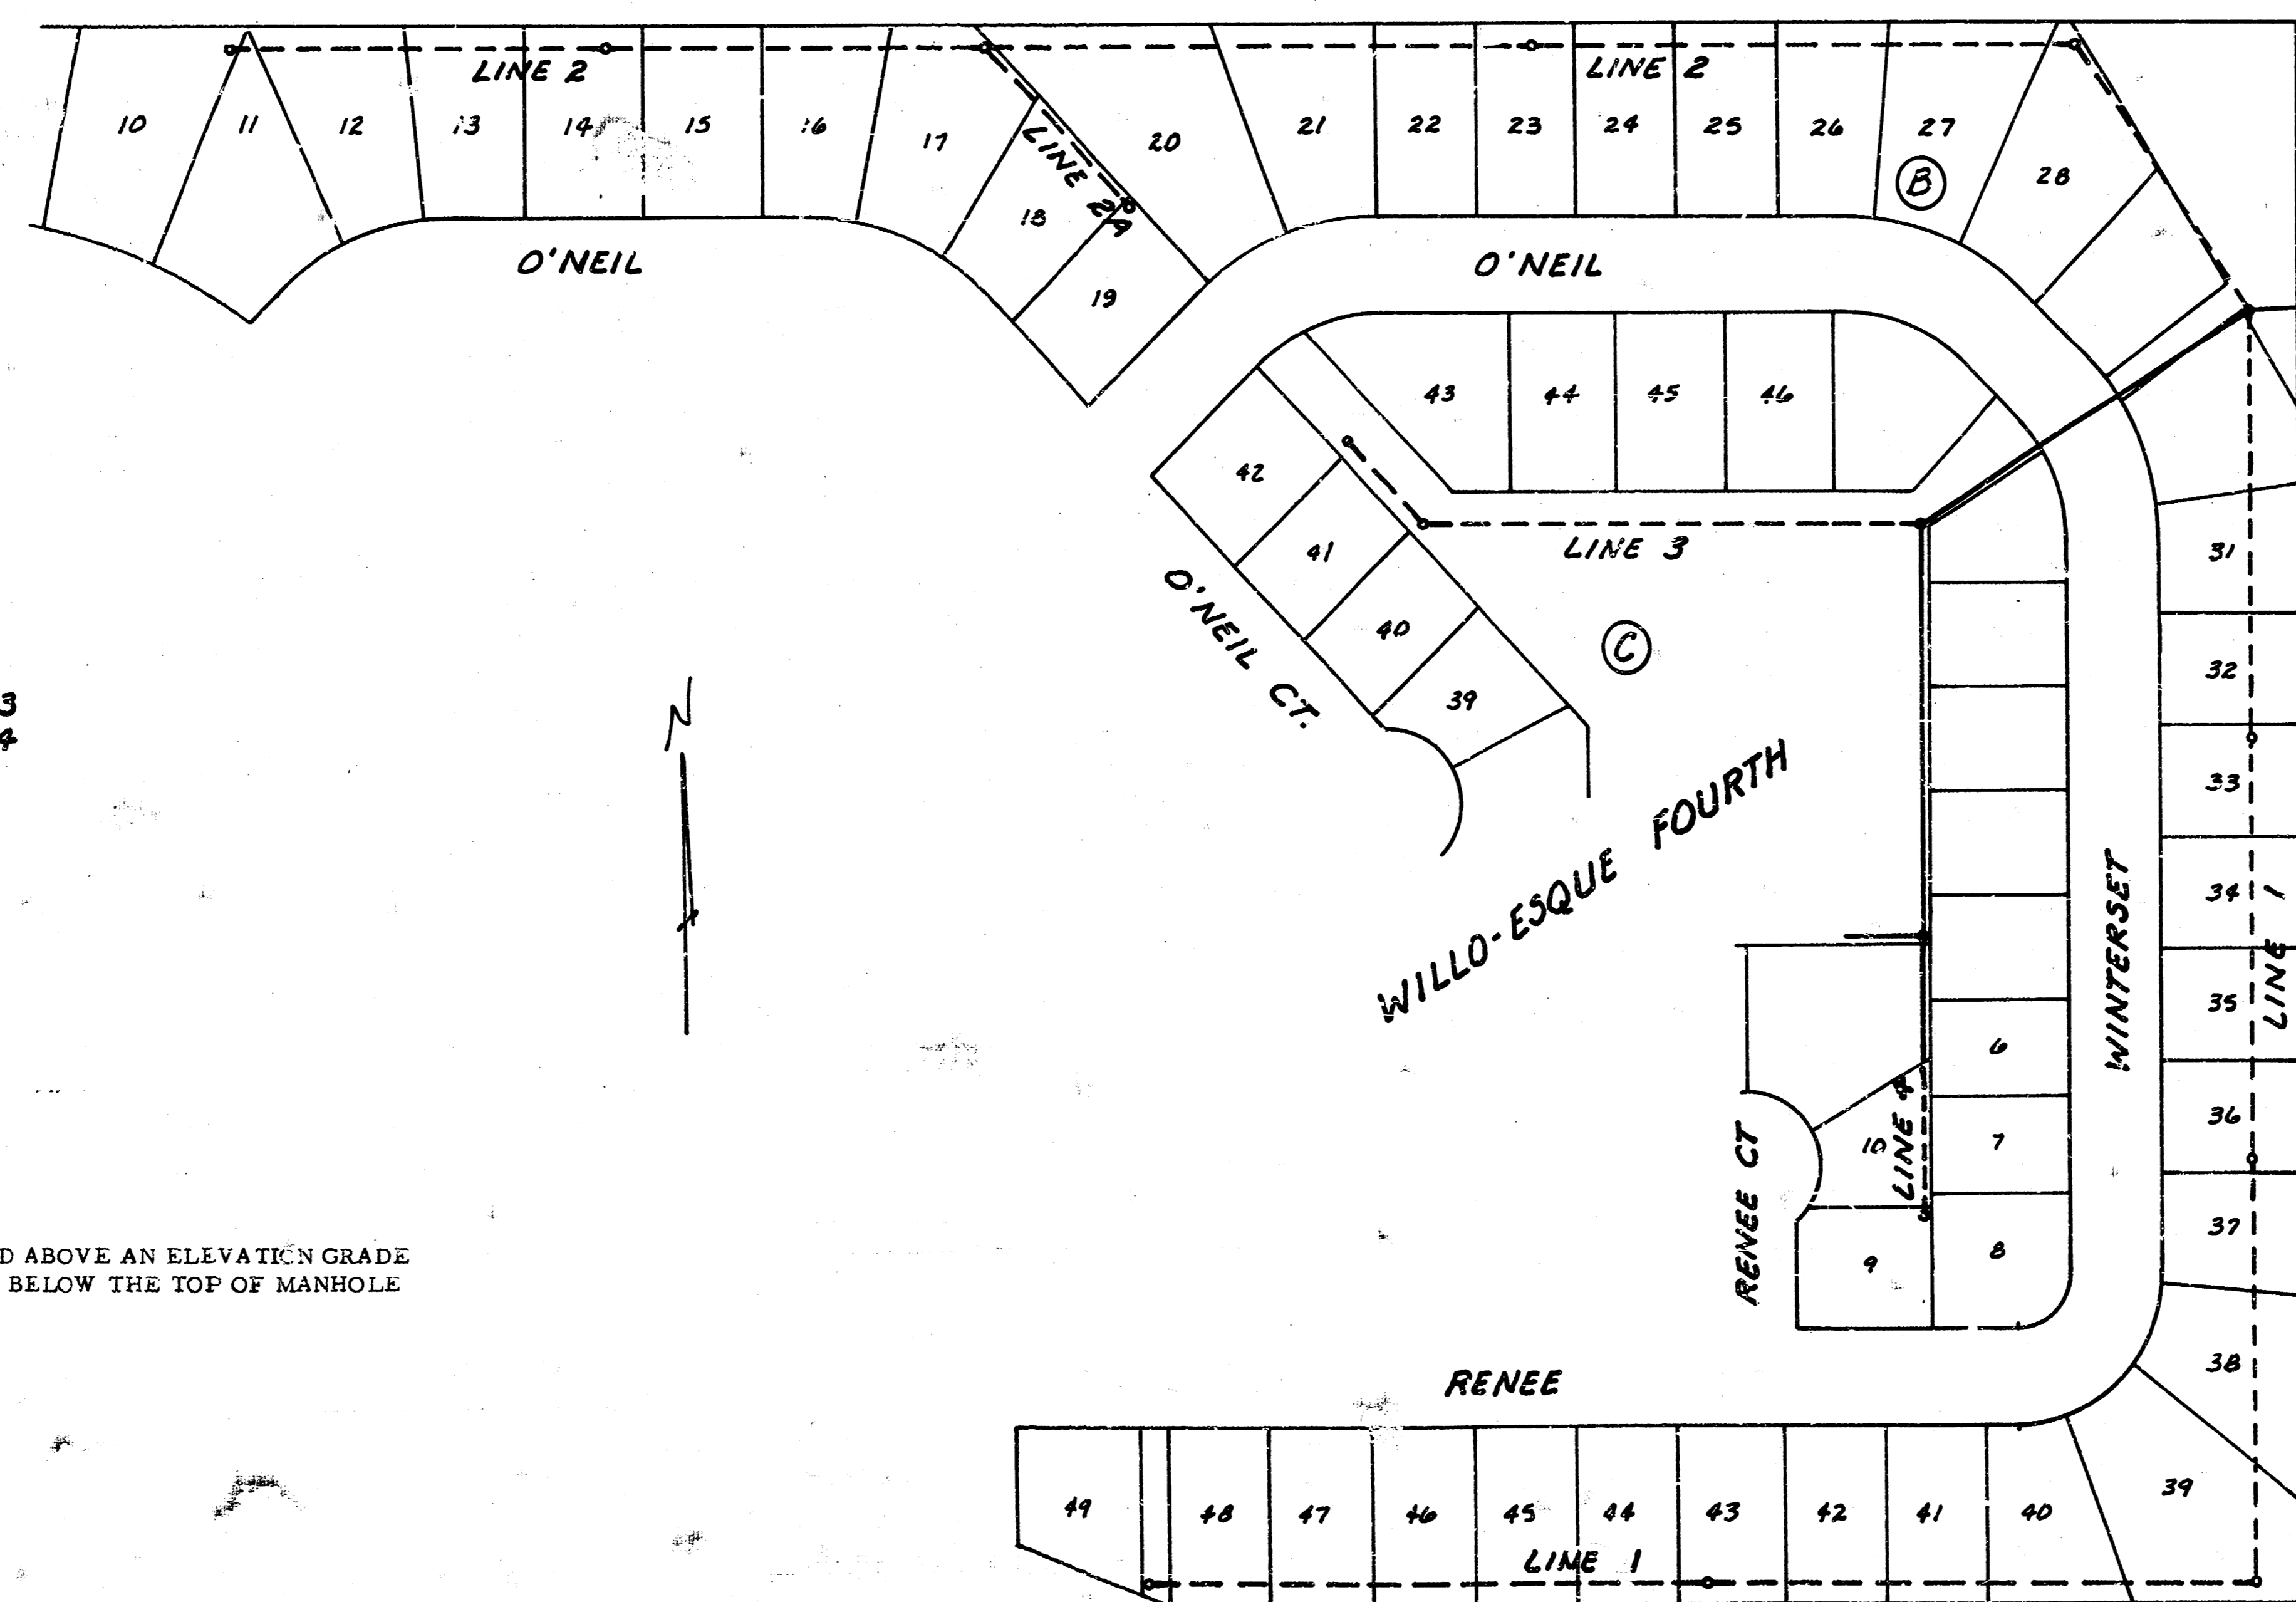


INDEX

- LINE 1 SHEETS 2-3
- LINE 2 SHEETS 3-4
- LINE 2A SHEET 5
- LINE 3 SHEET 5
- LINE 4 SHEET 6


NOTE: TRENCHES SHALL NOT BE BACKFILLED ABOVE AN ELEVATION GRADE LINE ESTABLISHED AS 0.4 OF A FOOT BELOW THE TOP OF MANHOLE ELEVATIONS SHOWN ON THE PLANS.

*As Built
9.8.83
J.L.L.*

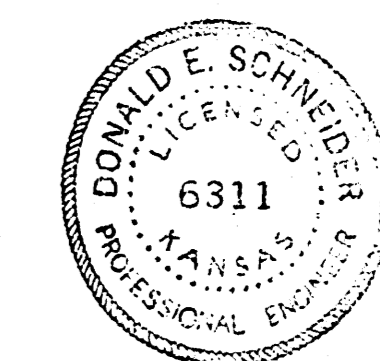

SCALE PLAN 1"=40'
 PROFILE 1"=40' HORIZ.
 1"=5' VERT.


2/26/92
 DCD-217

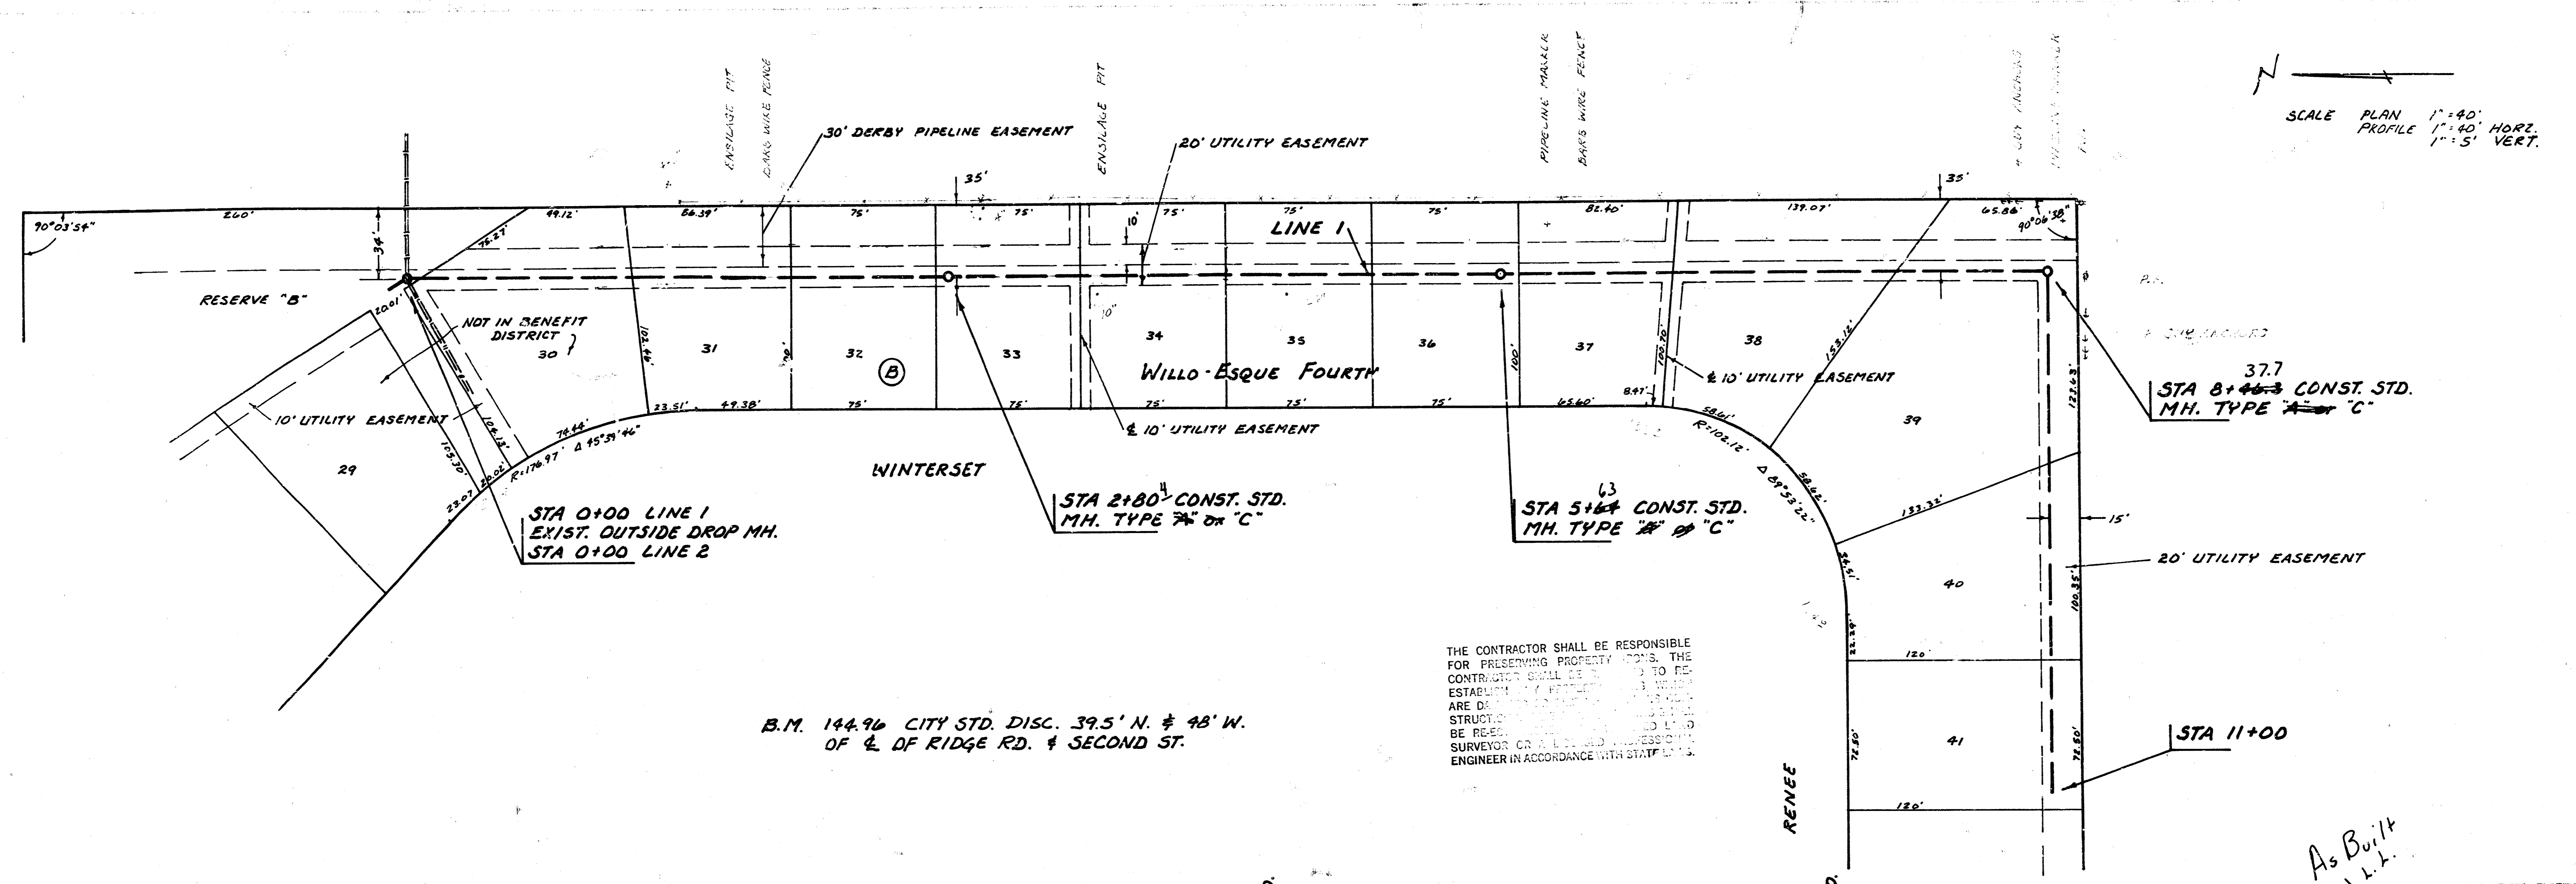


B.M. 144.96 CITY STD. DISC. 39.5' N. & 48' W.
 OF E. OF RIDGE RD. & SECOND ST.

THE CONTRACTOR SHALL BE RESPONSIBLE FOR PRESERVING PROPERTY LINES. THE CONTRACTOR SHALL BE RESPONSIBLE TO RE-ESTABLISH PROPERTY LINES IF ANY ARE DELETED OR CHANGED BY THIS STRUCTURE. THE CONTRACTOR SHALL BE RESPONSIBLE TO RE-ESTABLISH PROPERTY LINES IF ANY ARE DELETED OR CHANGED BY THIS SURVEYOR OR LICENSED PROFESSIONAL ENGINEER IN ACCORDANCE WITH STATE LAWS.




As Built
 J.L.L.
 9-82

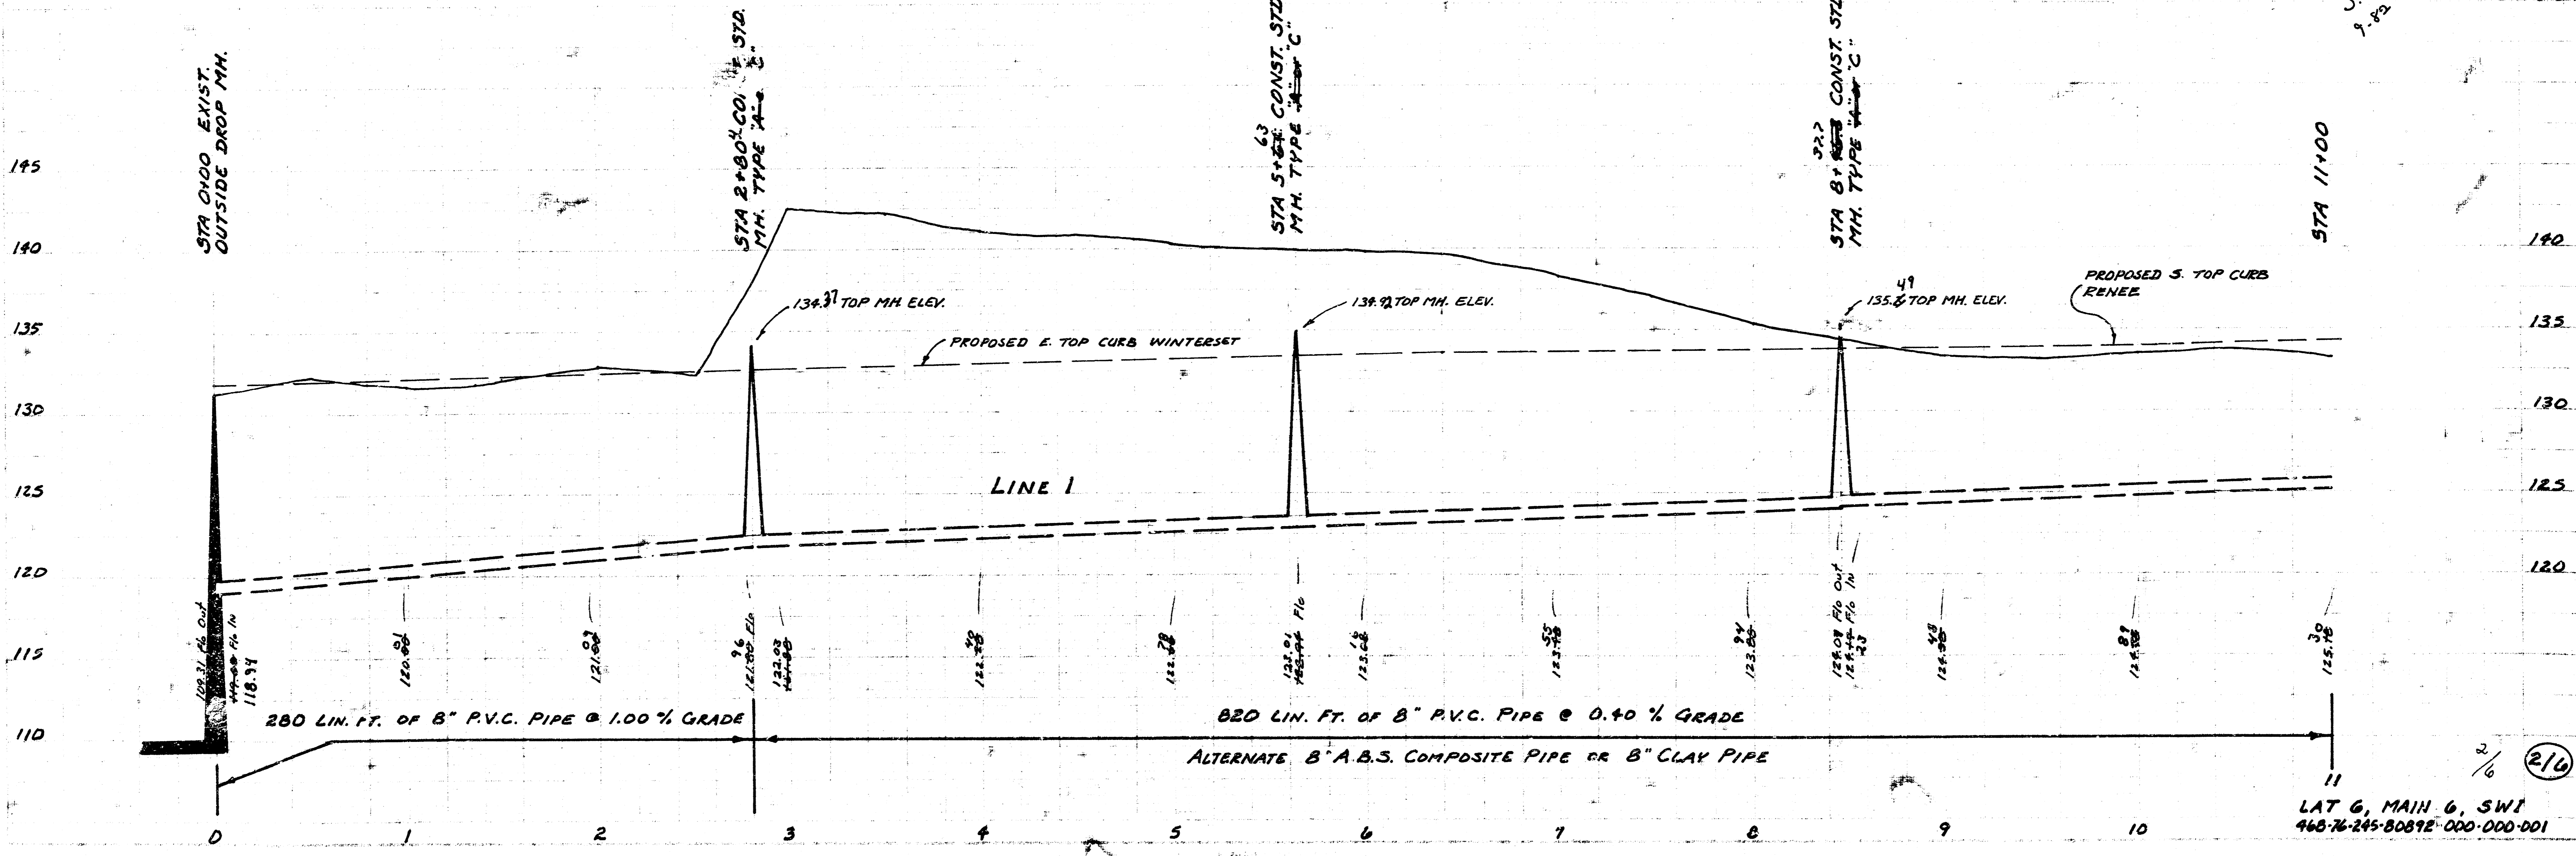

LAT 6, MAIN 6, SW1
 465-76-245-80892-000-000-001


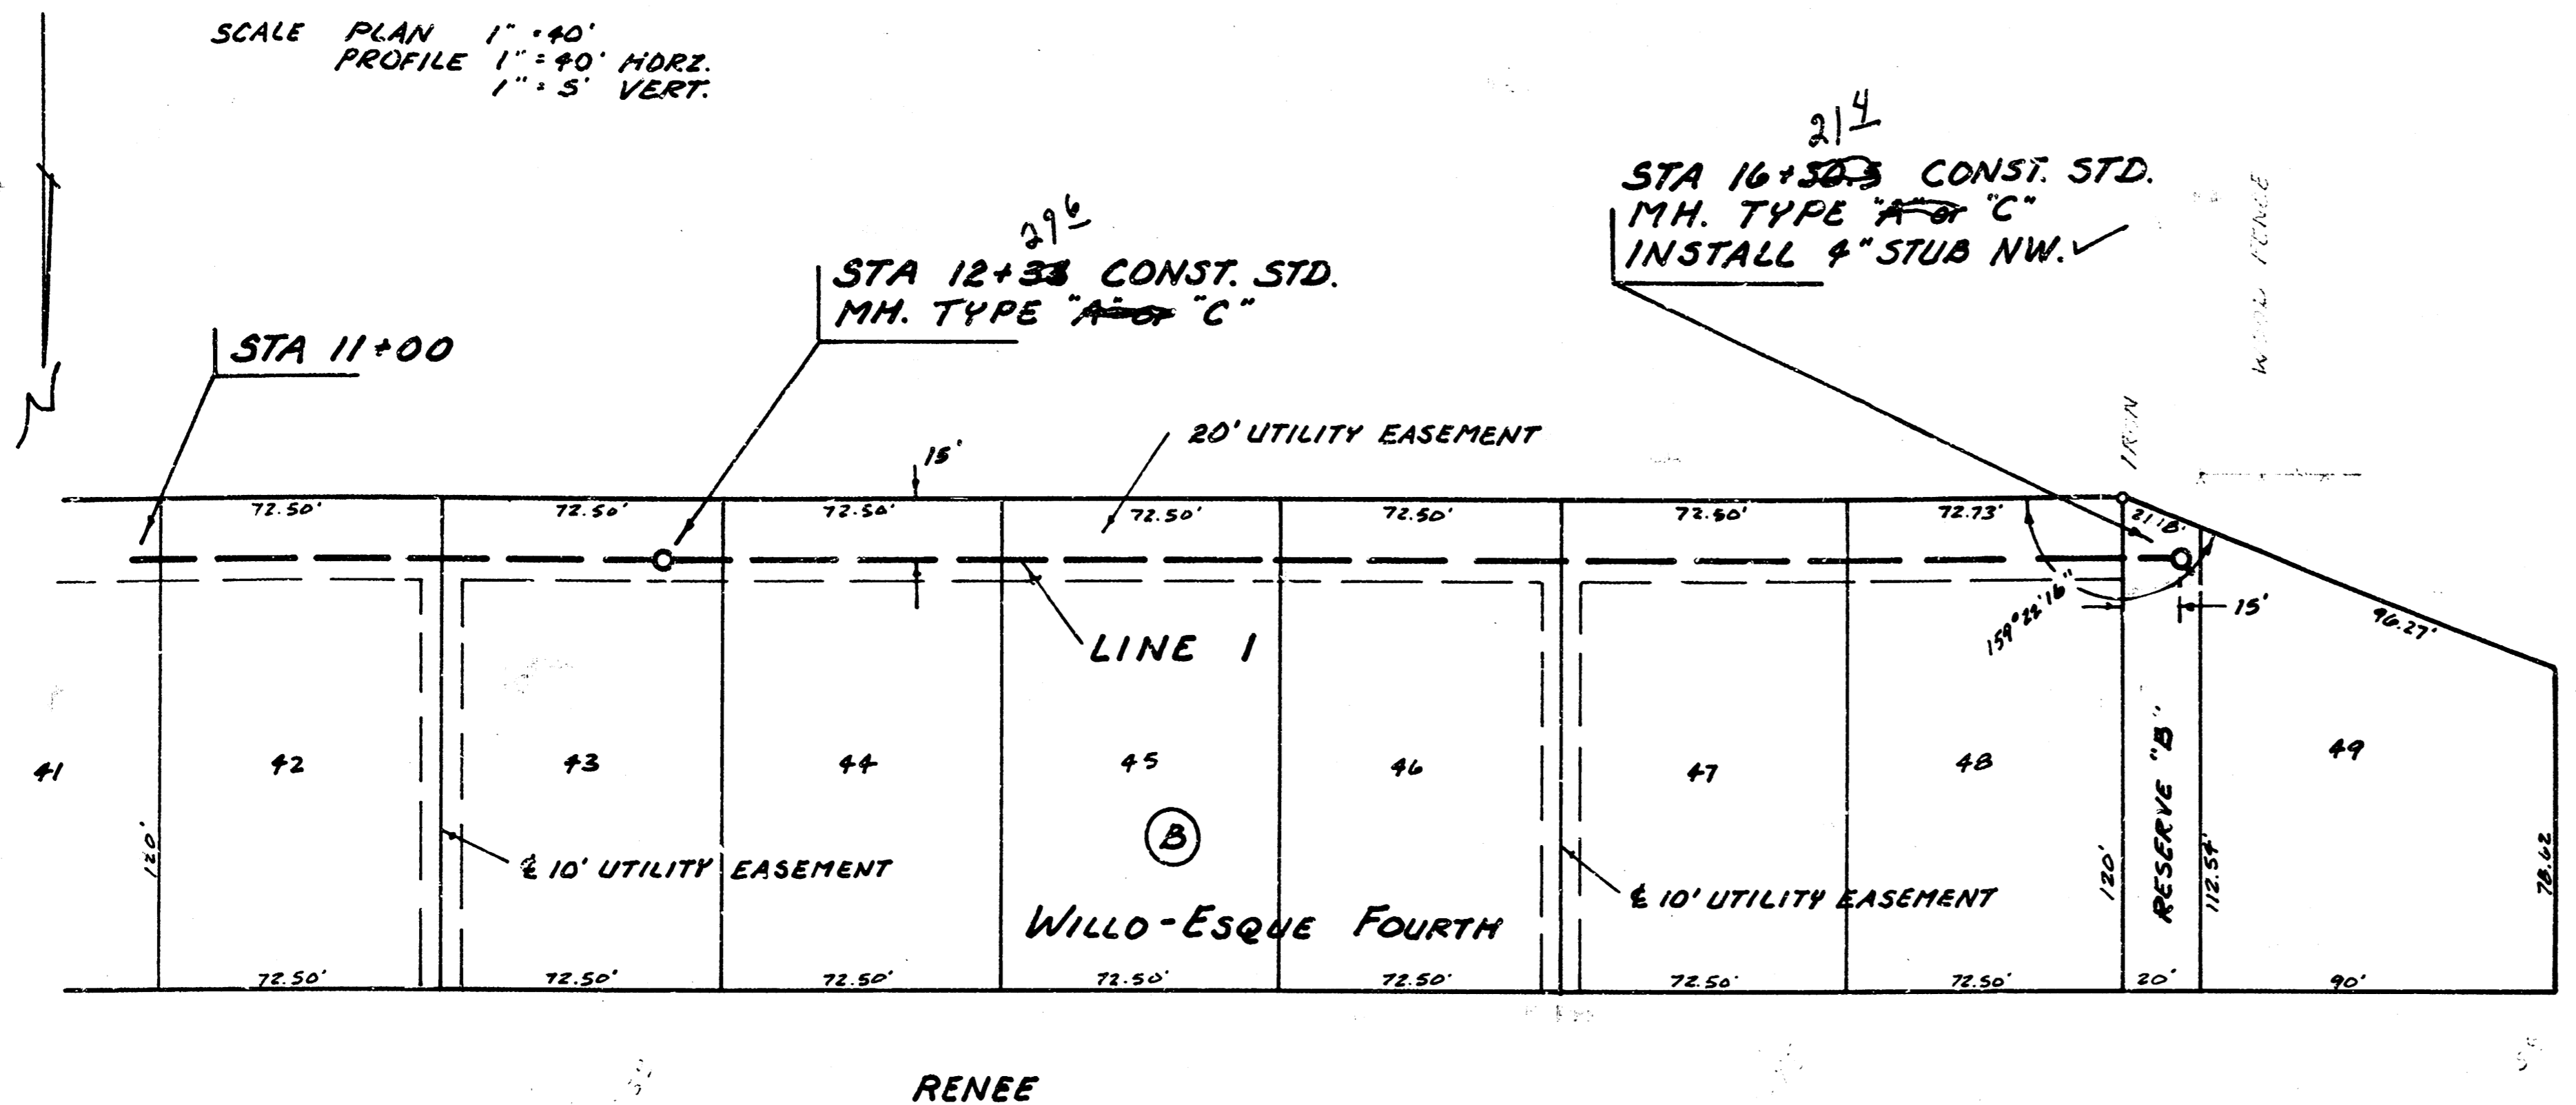


NOTE: COMPACTED FILL IN THE AREA OF MANHOLE LOCATION AT STA. 2+19.6 ON LINE NO. 2, SHALL BE CONSTRUCTED USING EXCESS TRENCH EXCAVATED MATERIAL COMPACTED TO A DENSITY OF 90% OF STANDARD DENSITY. THIS WORK SHALL BE CONSIDERED AS SUBSIDIARY TO THE OTHER PAY ITEMS.

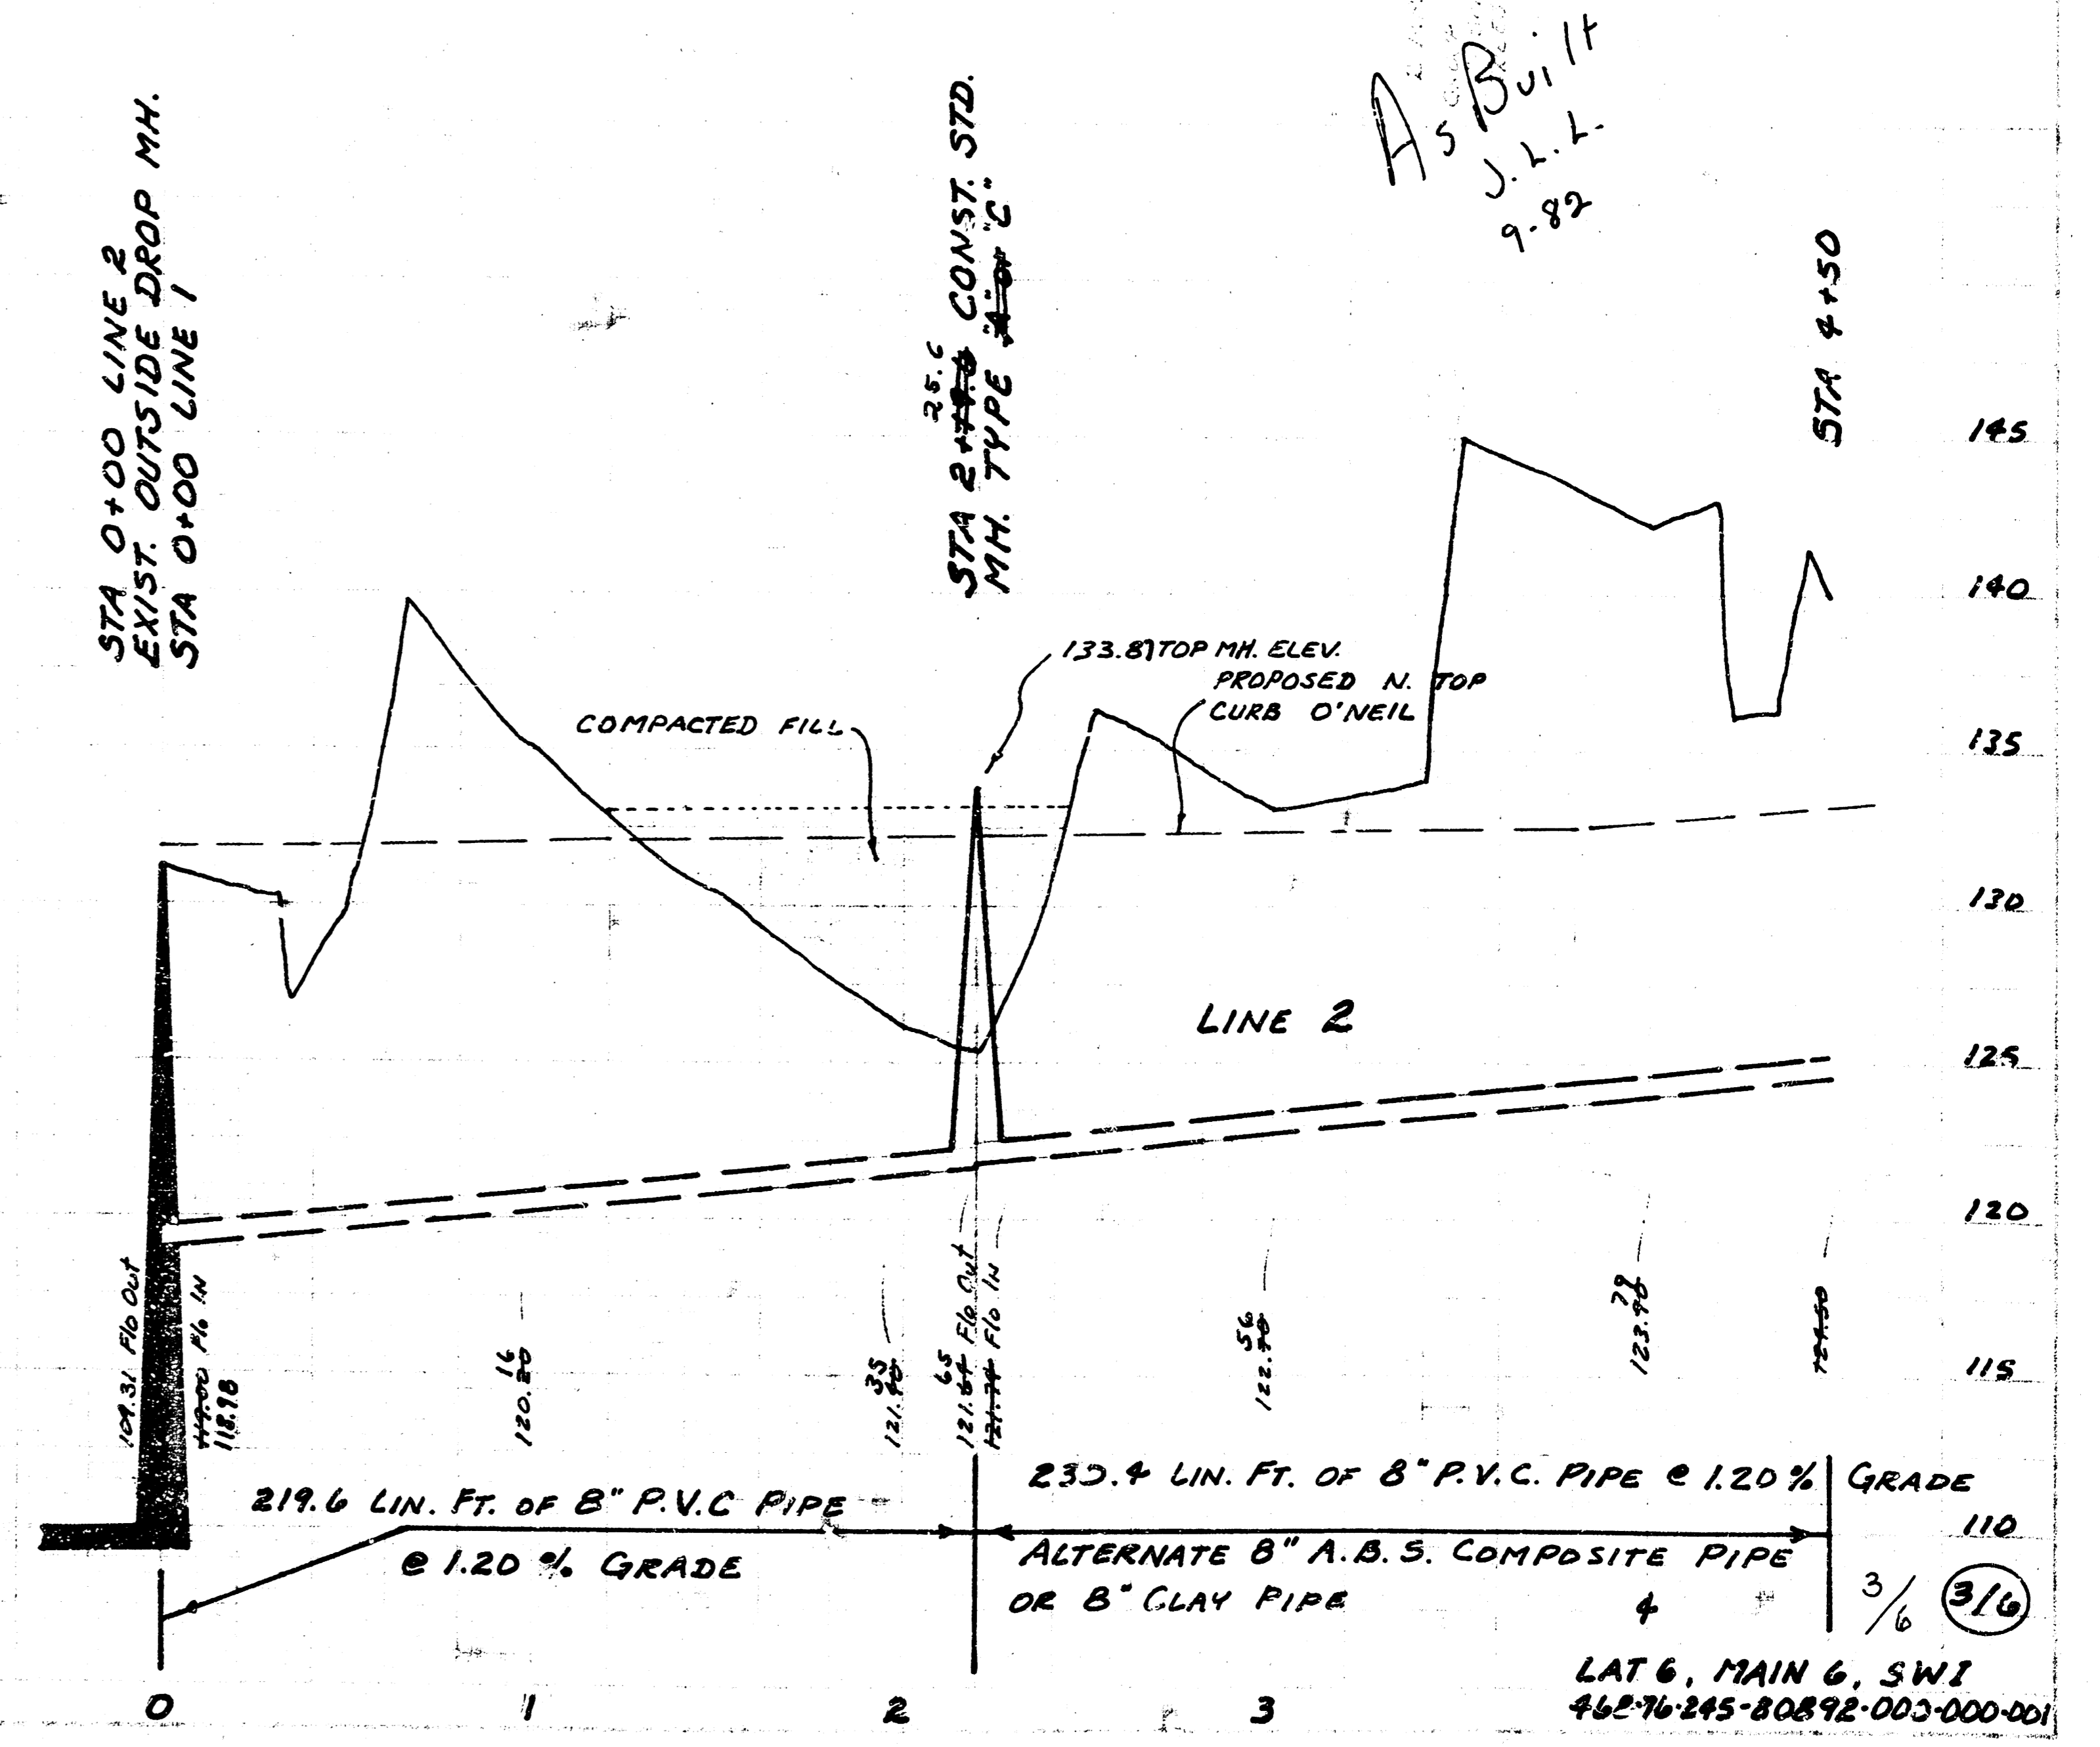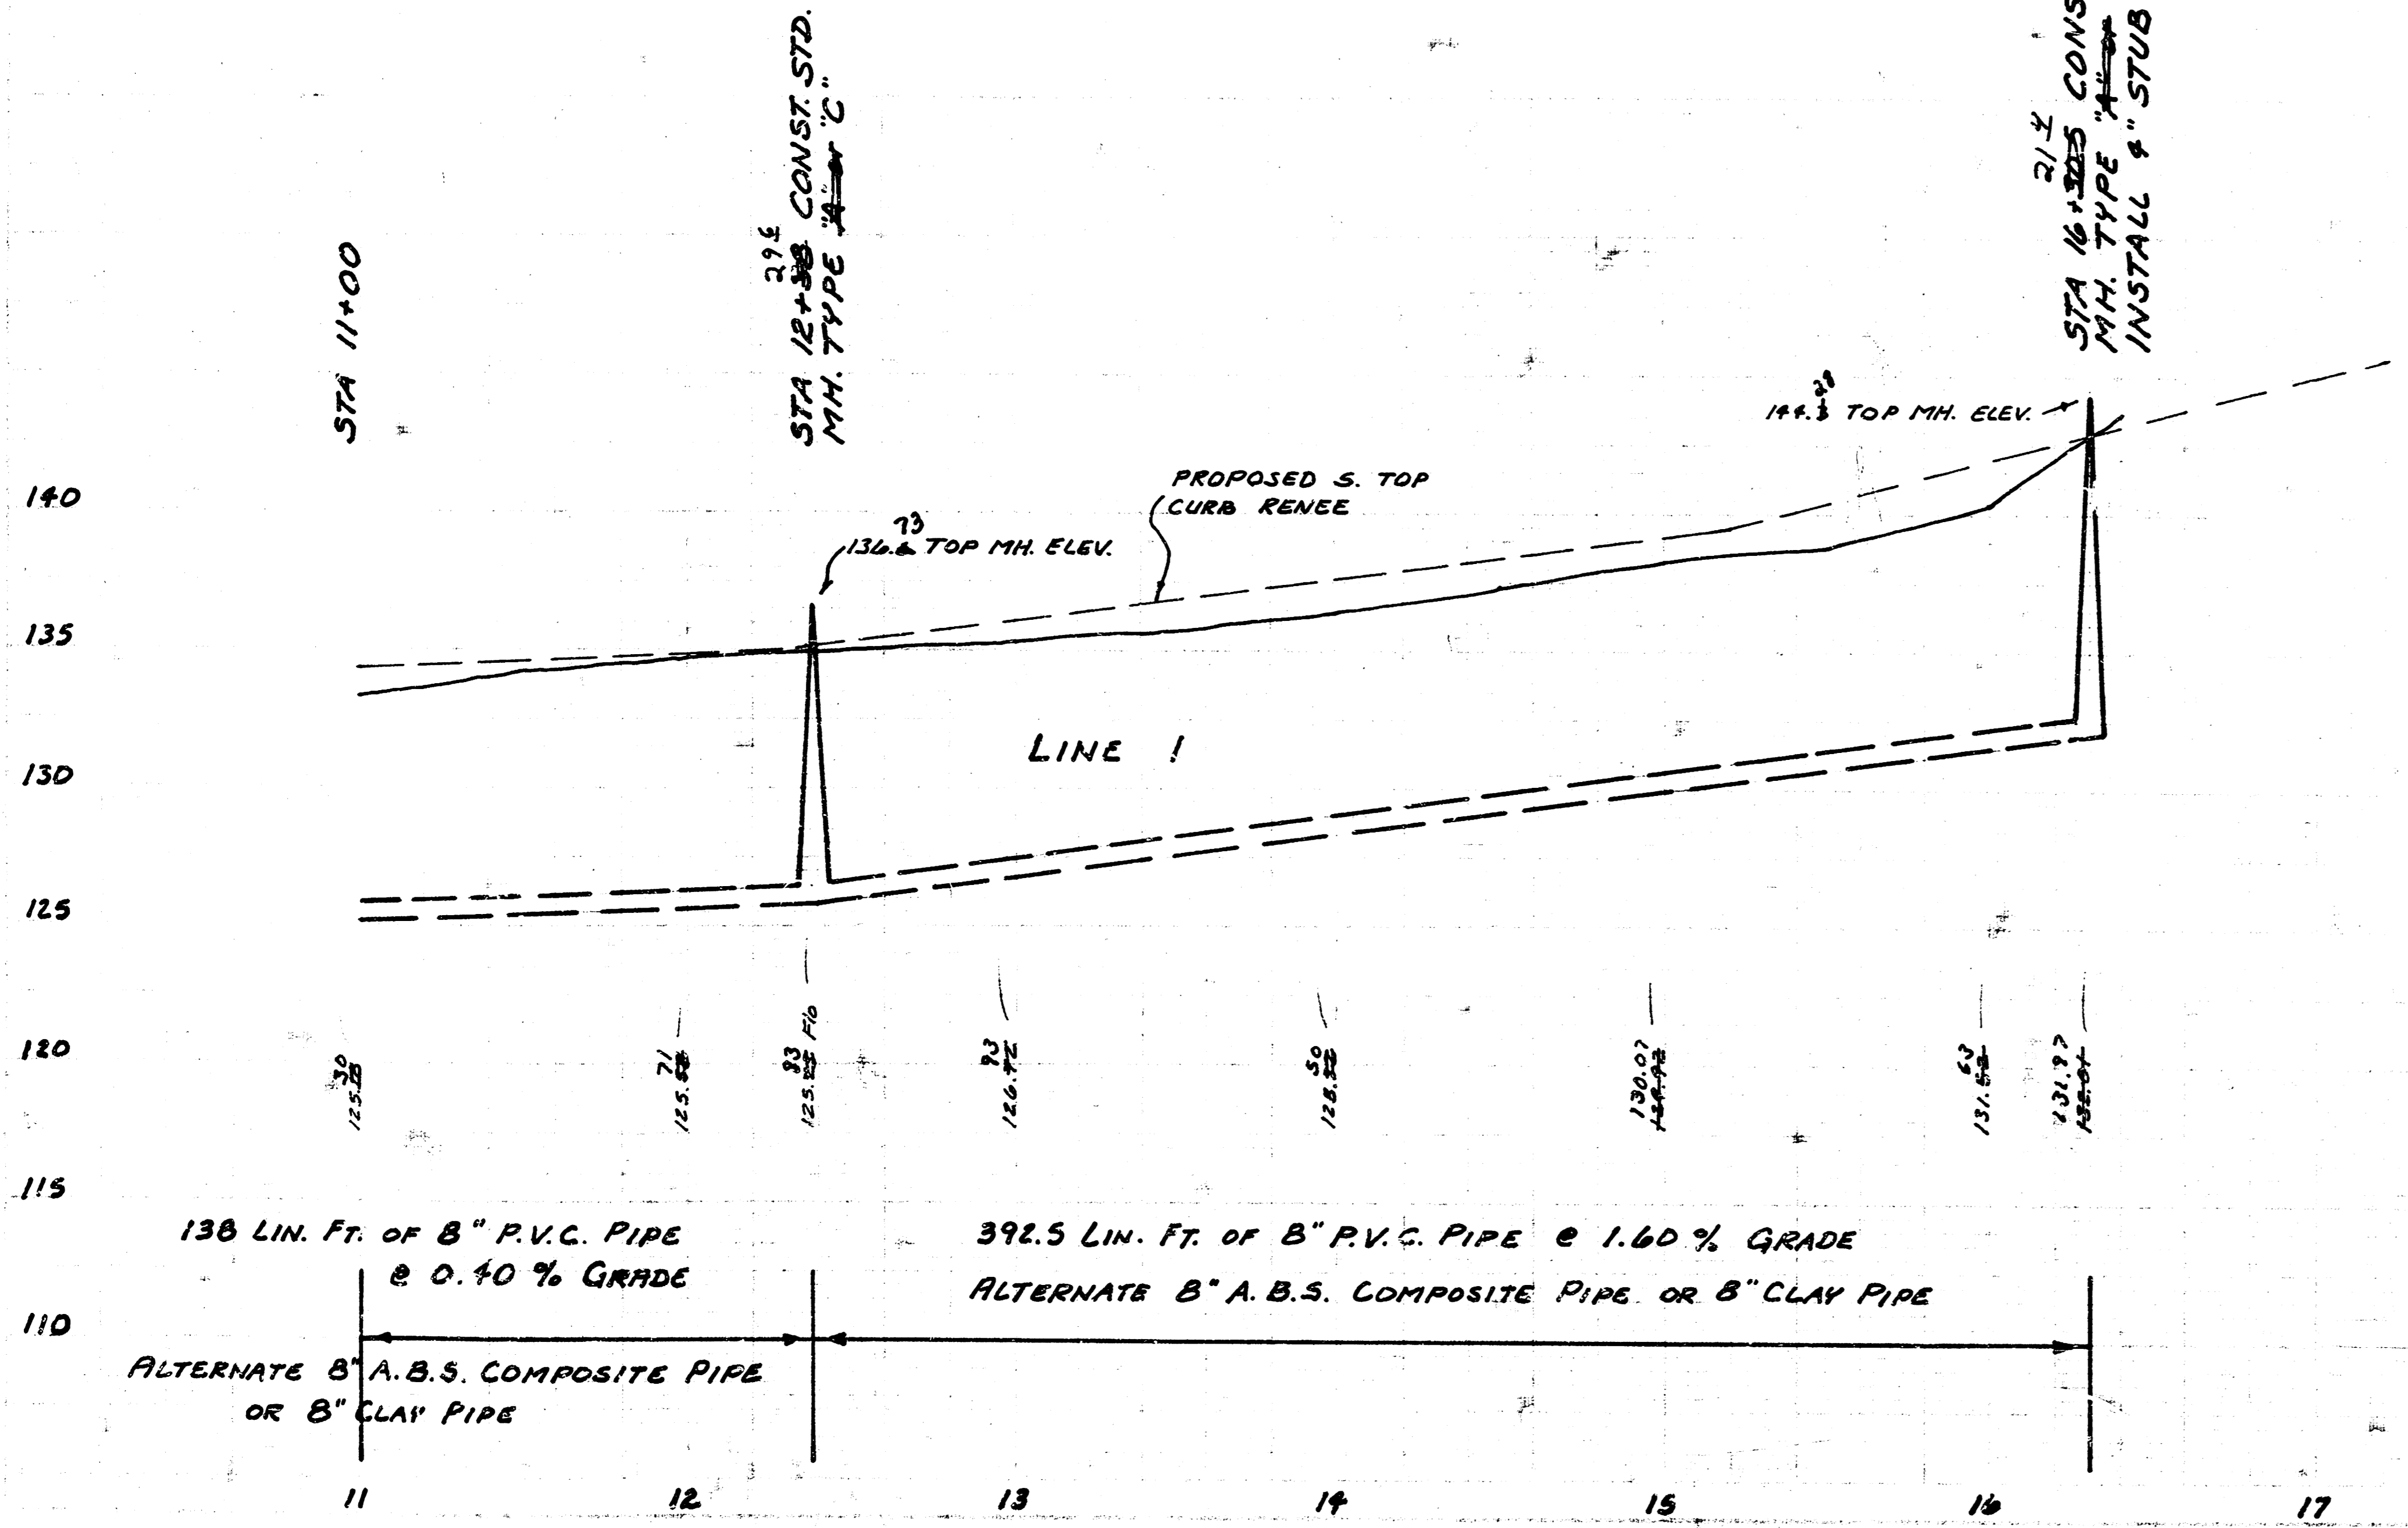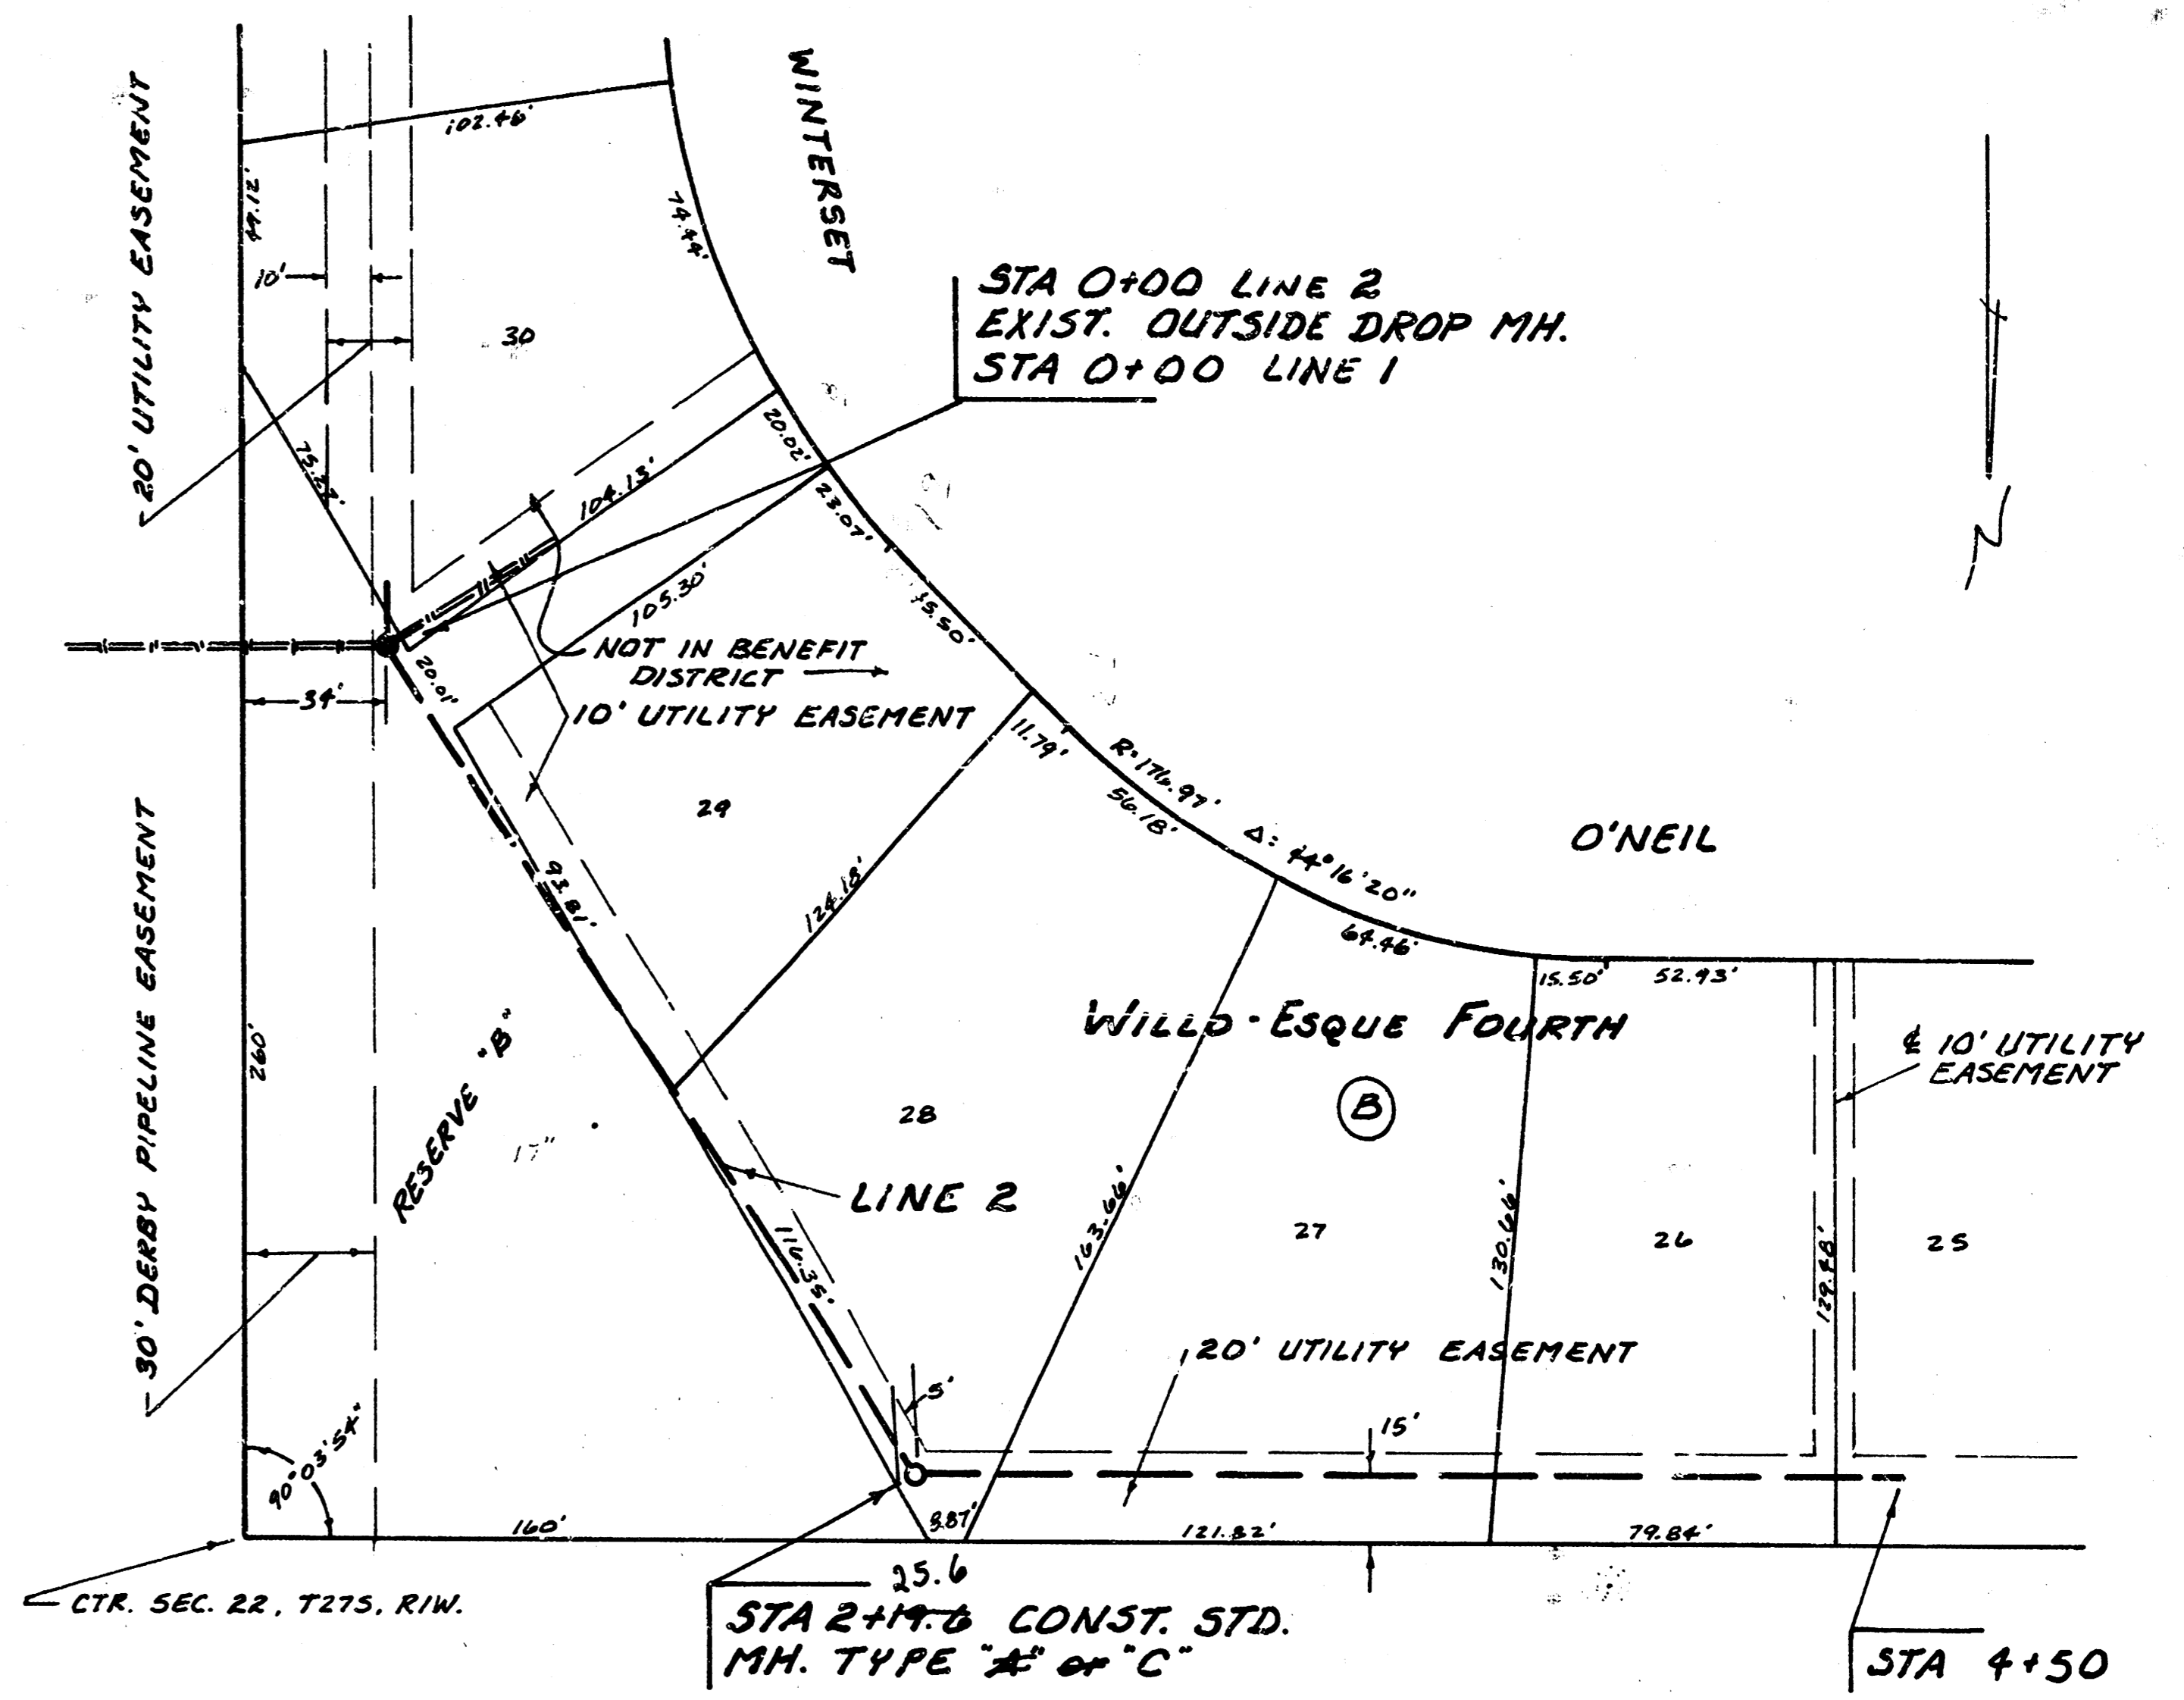

As Built
J.L.L.
9-82



SCALE PLAN 1" = 40'
 PROFILE 1" = 4.0' HORIZ.
 1" = 3' VERT.

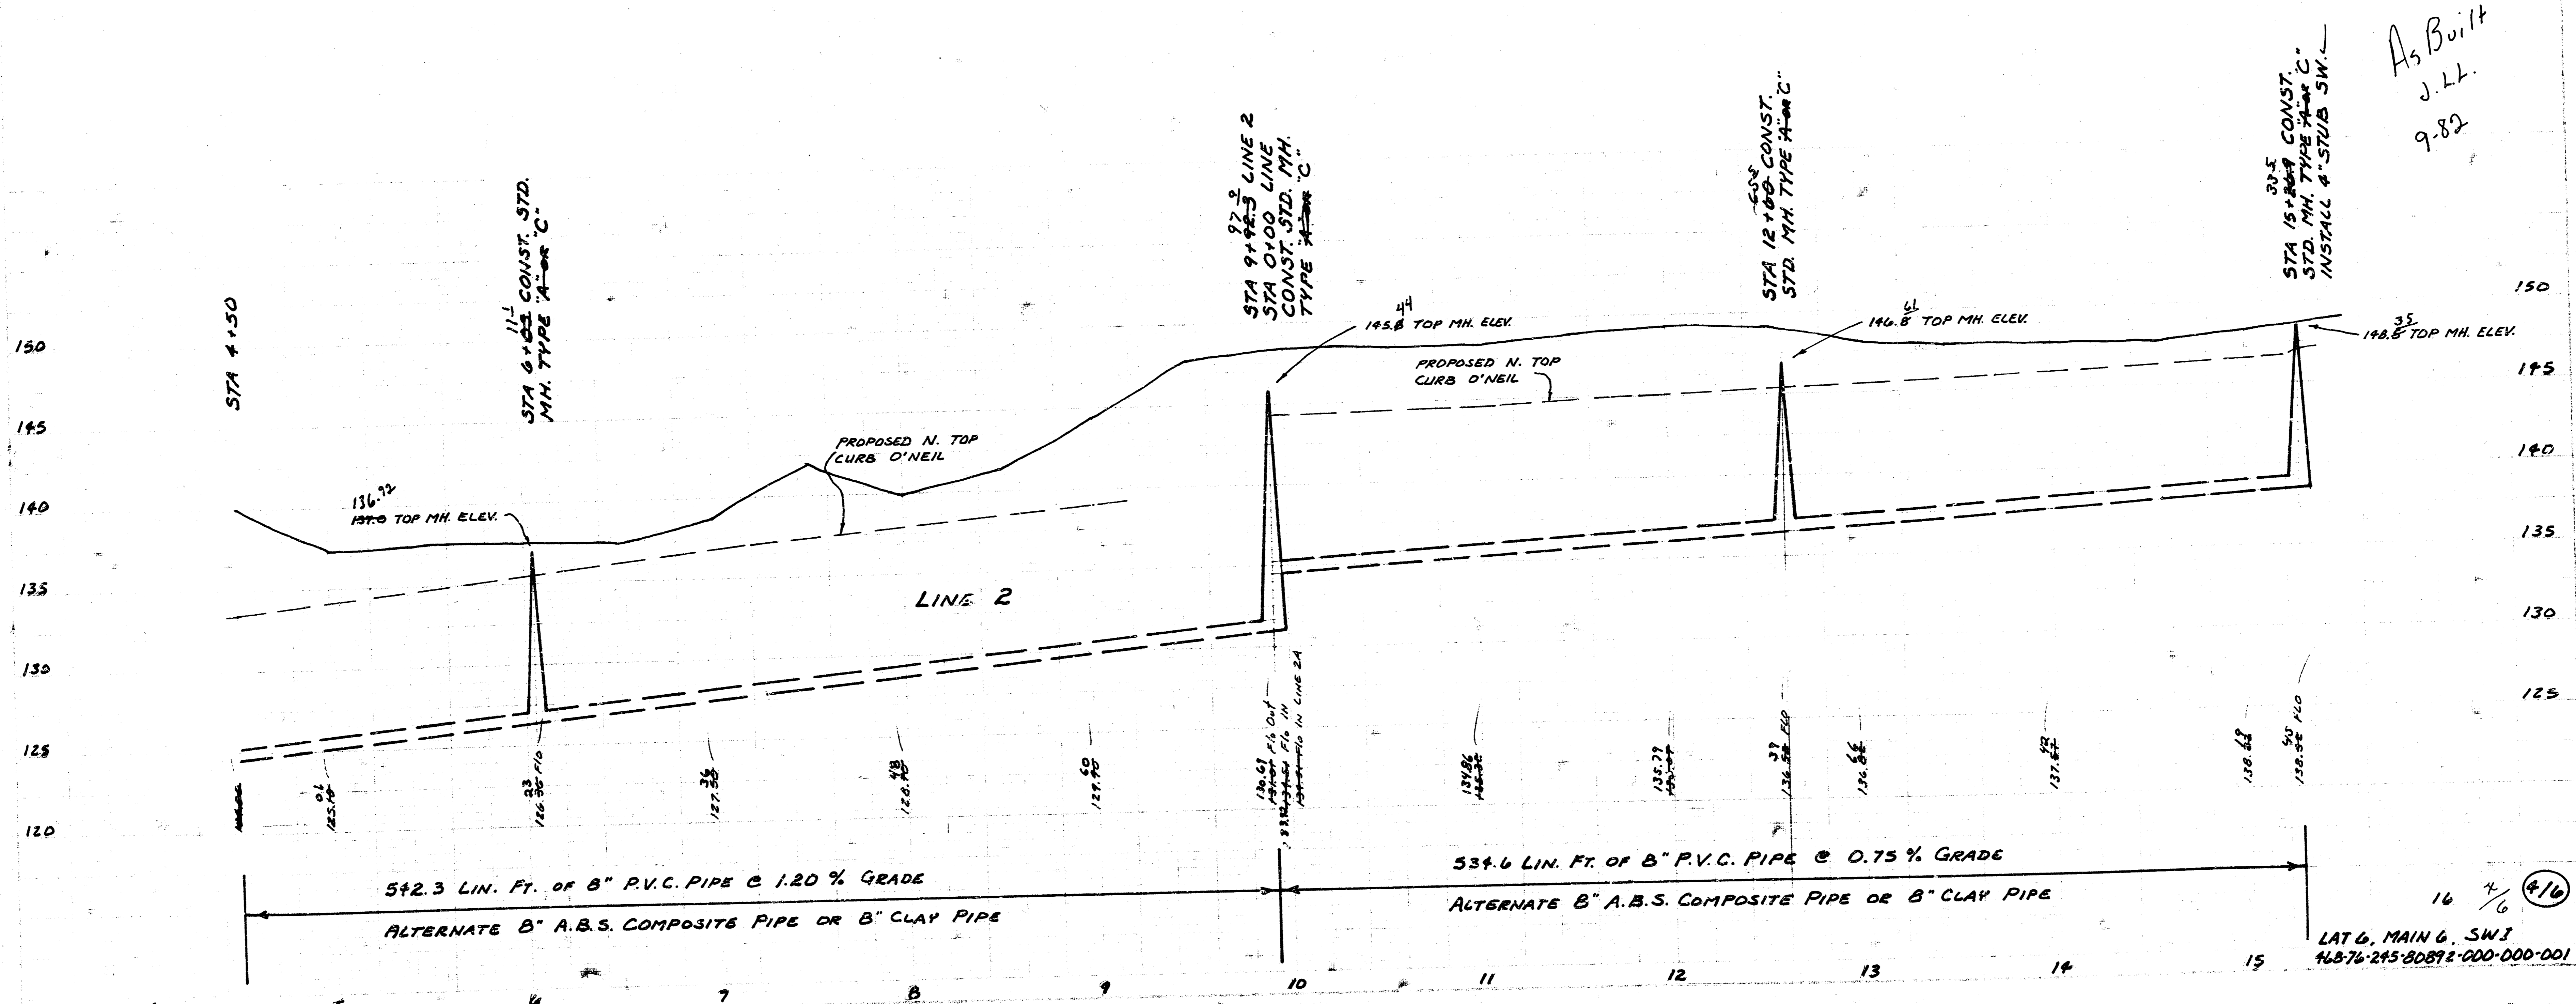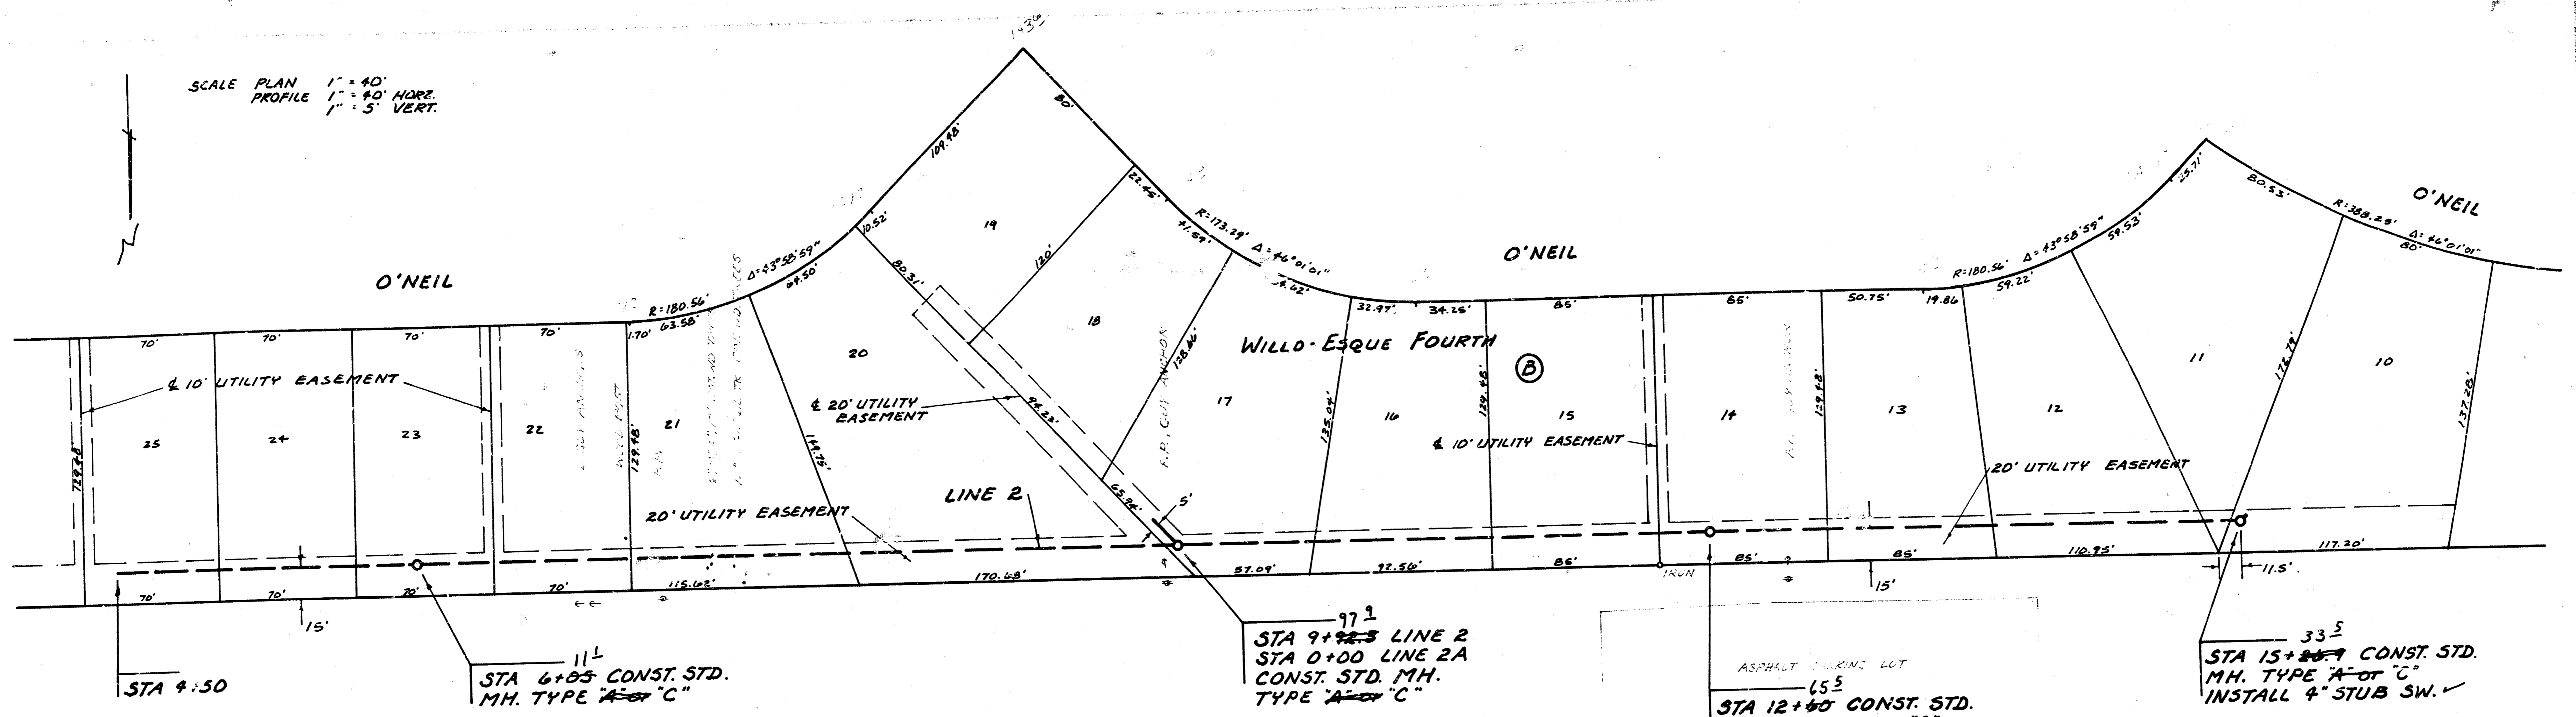

As Built
 J.L.
 9-82

16 4/6 (4/16)
 LAT 6, MAIN 6, SW 3
 46876-245-80872-000-000-001

SCALE PLAN 1" = 40'
 PROFILE 1" = 40' HORIZ.
 1" = 5' VERT.

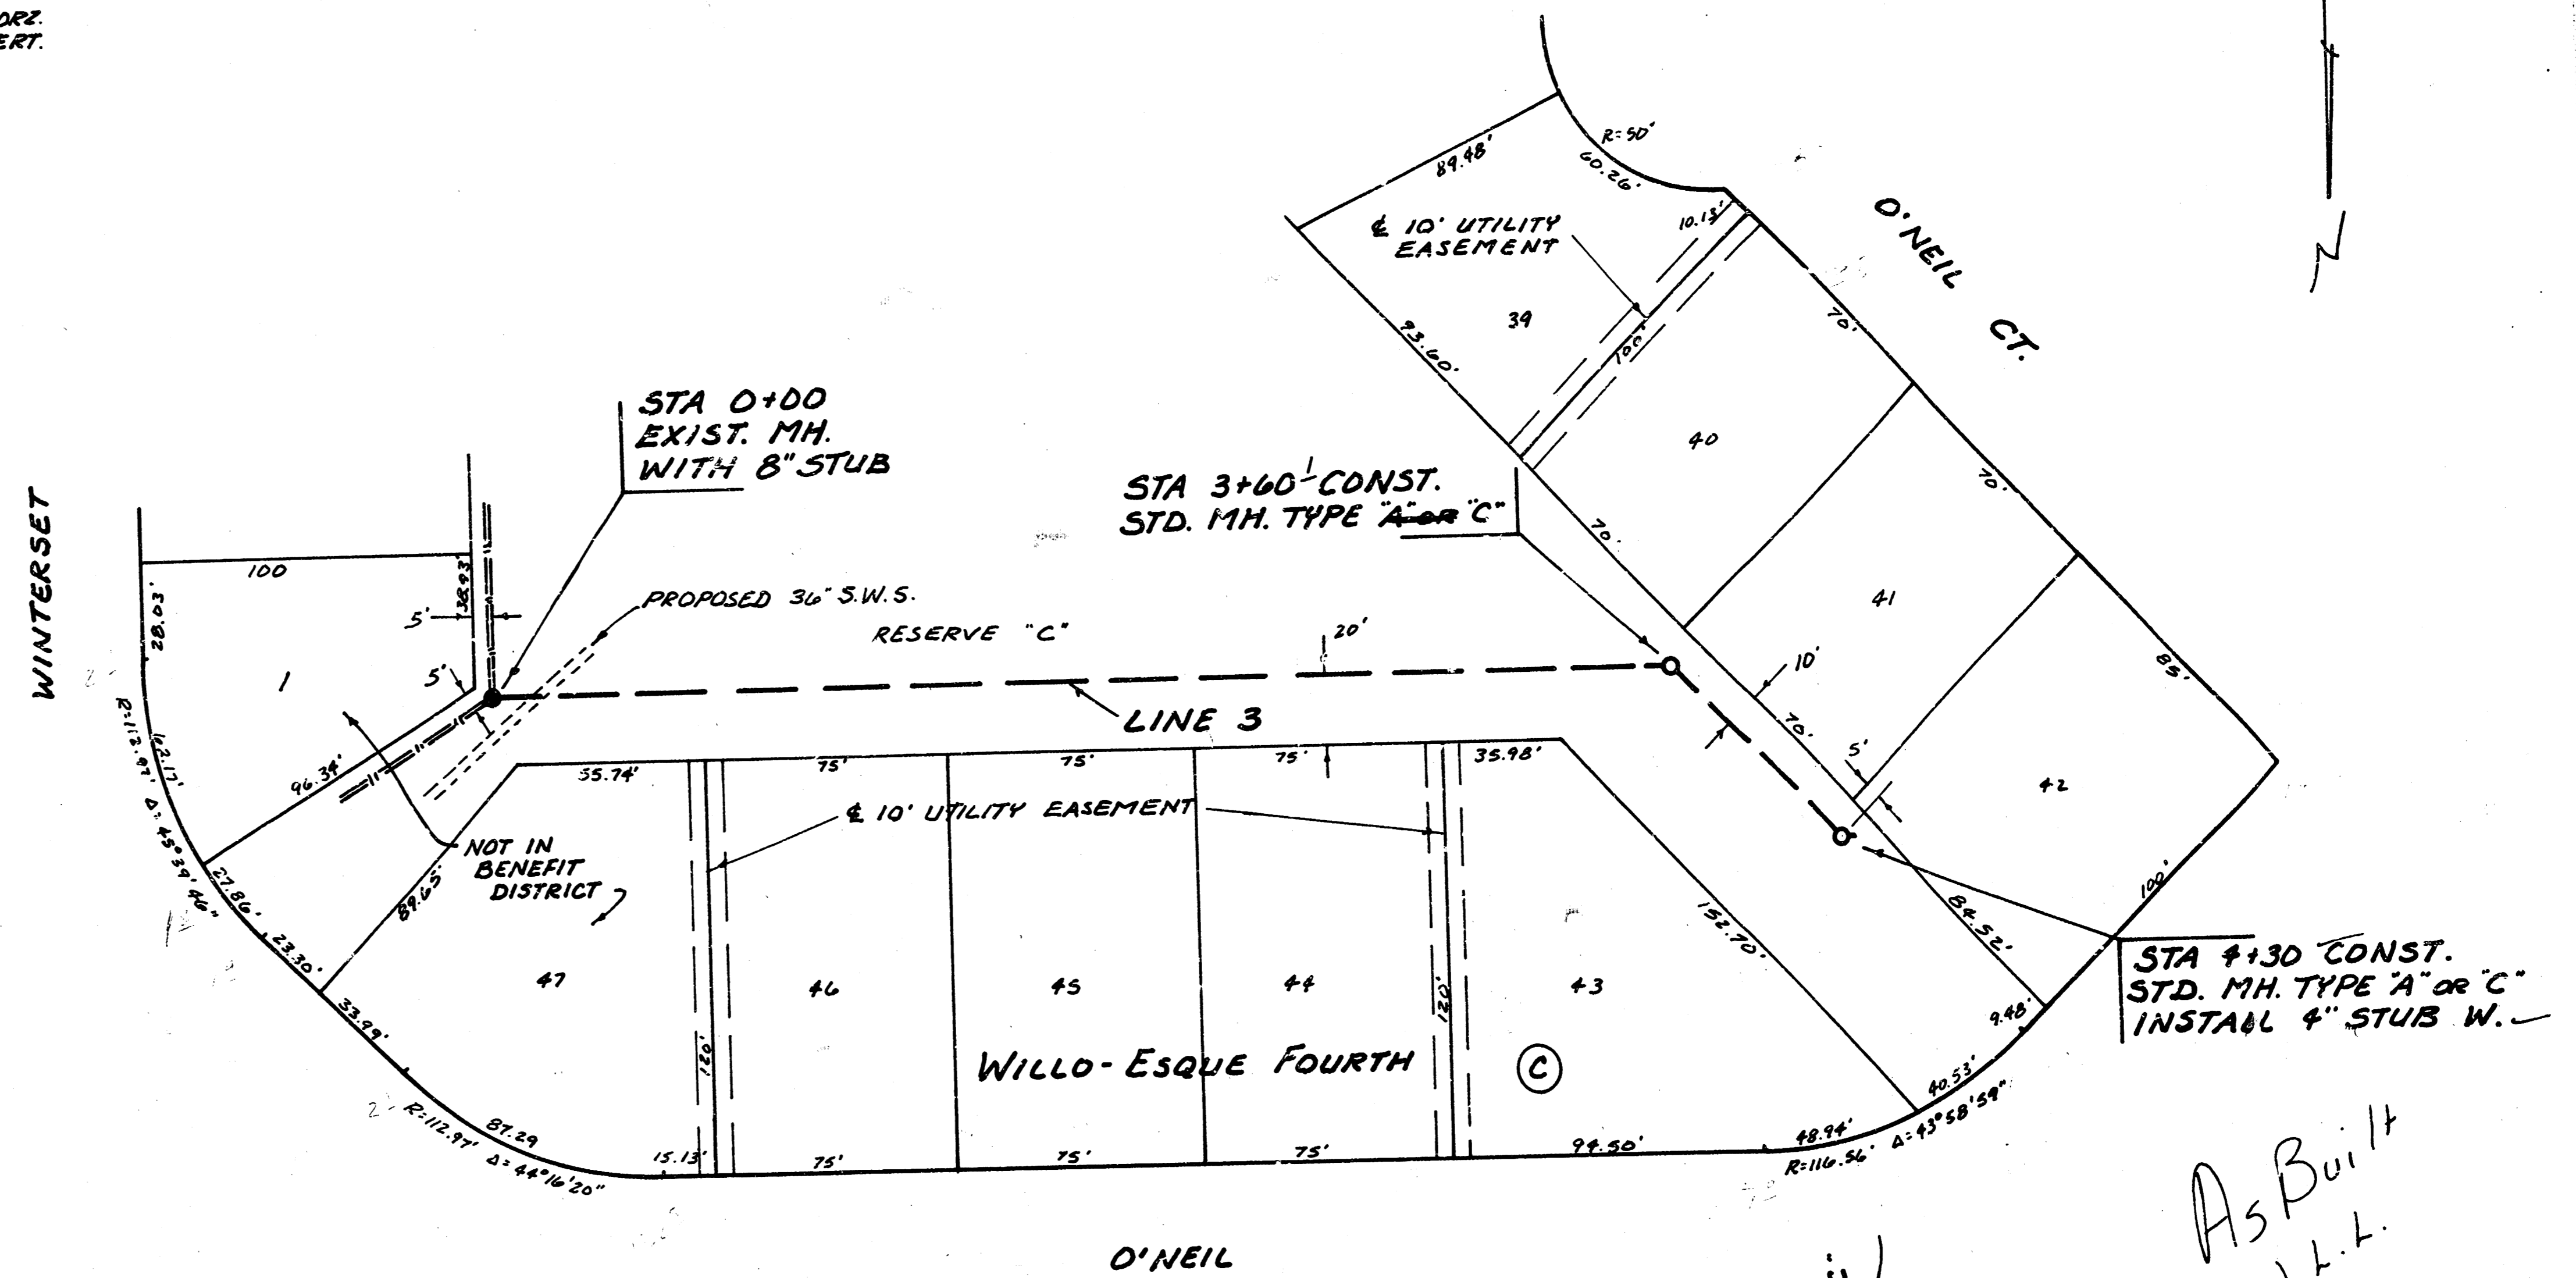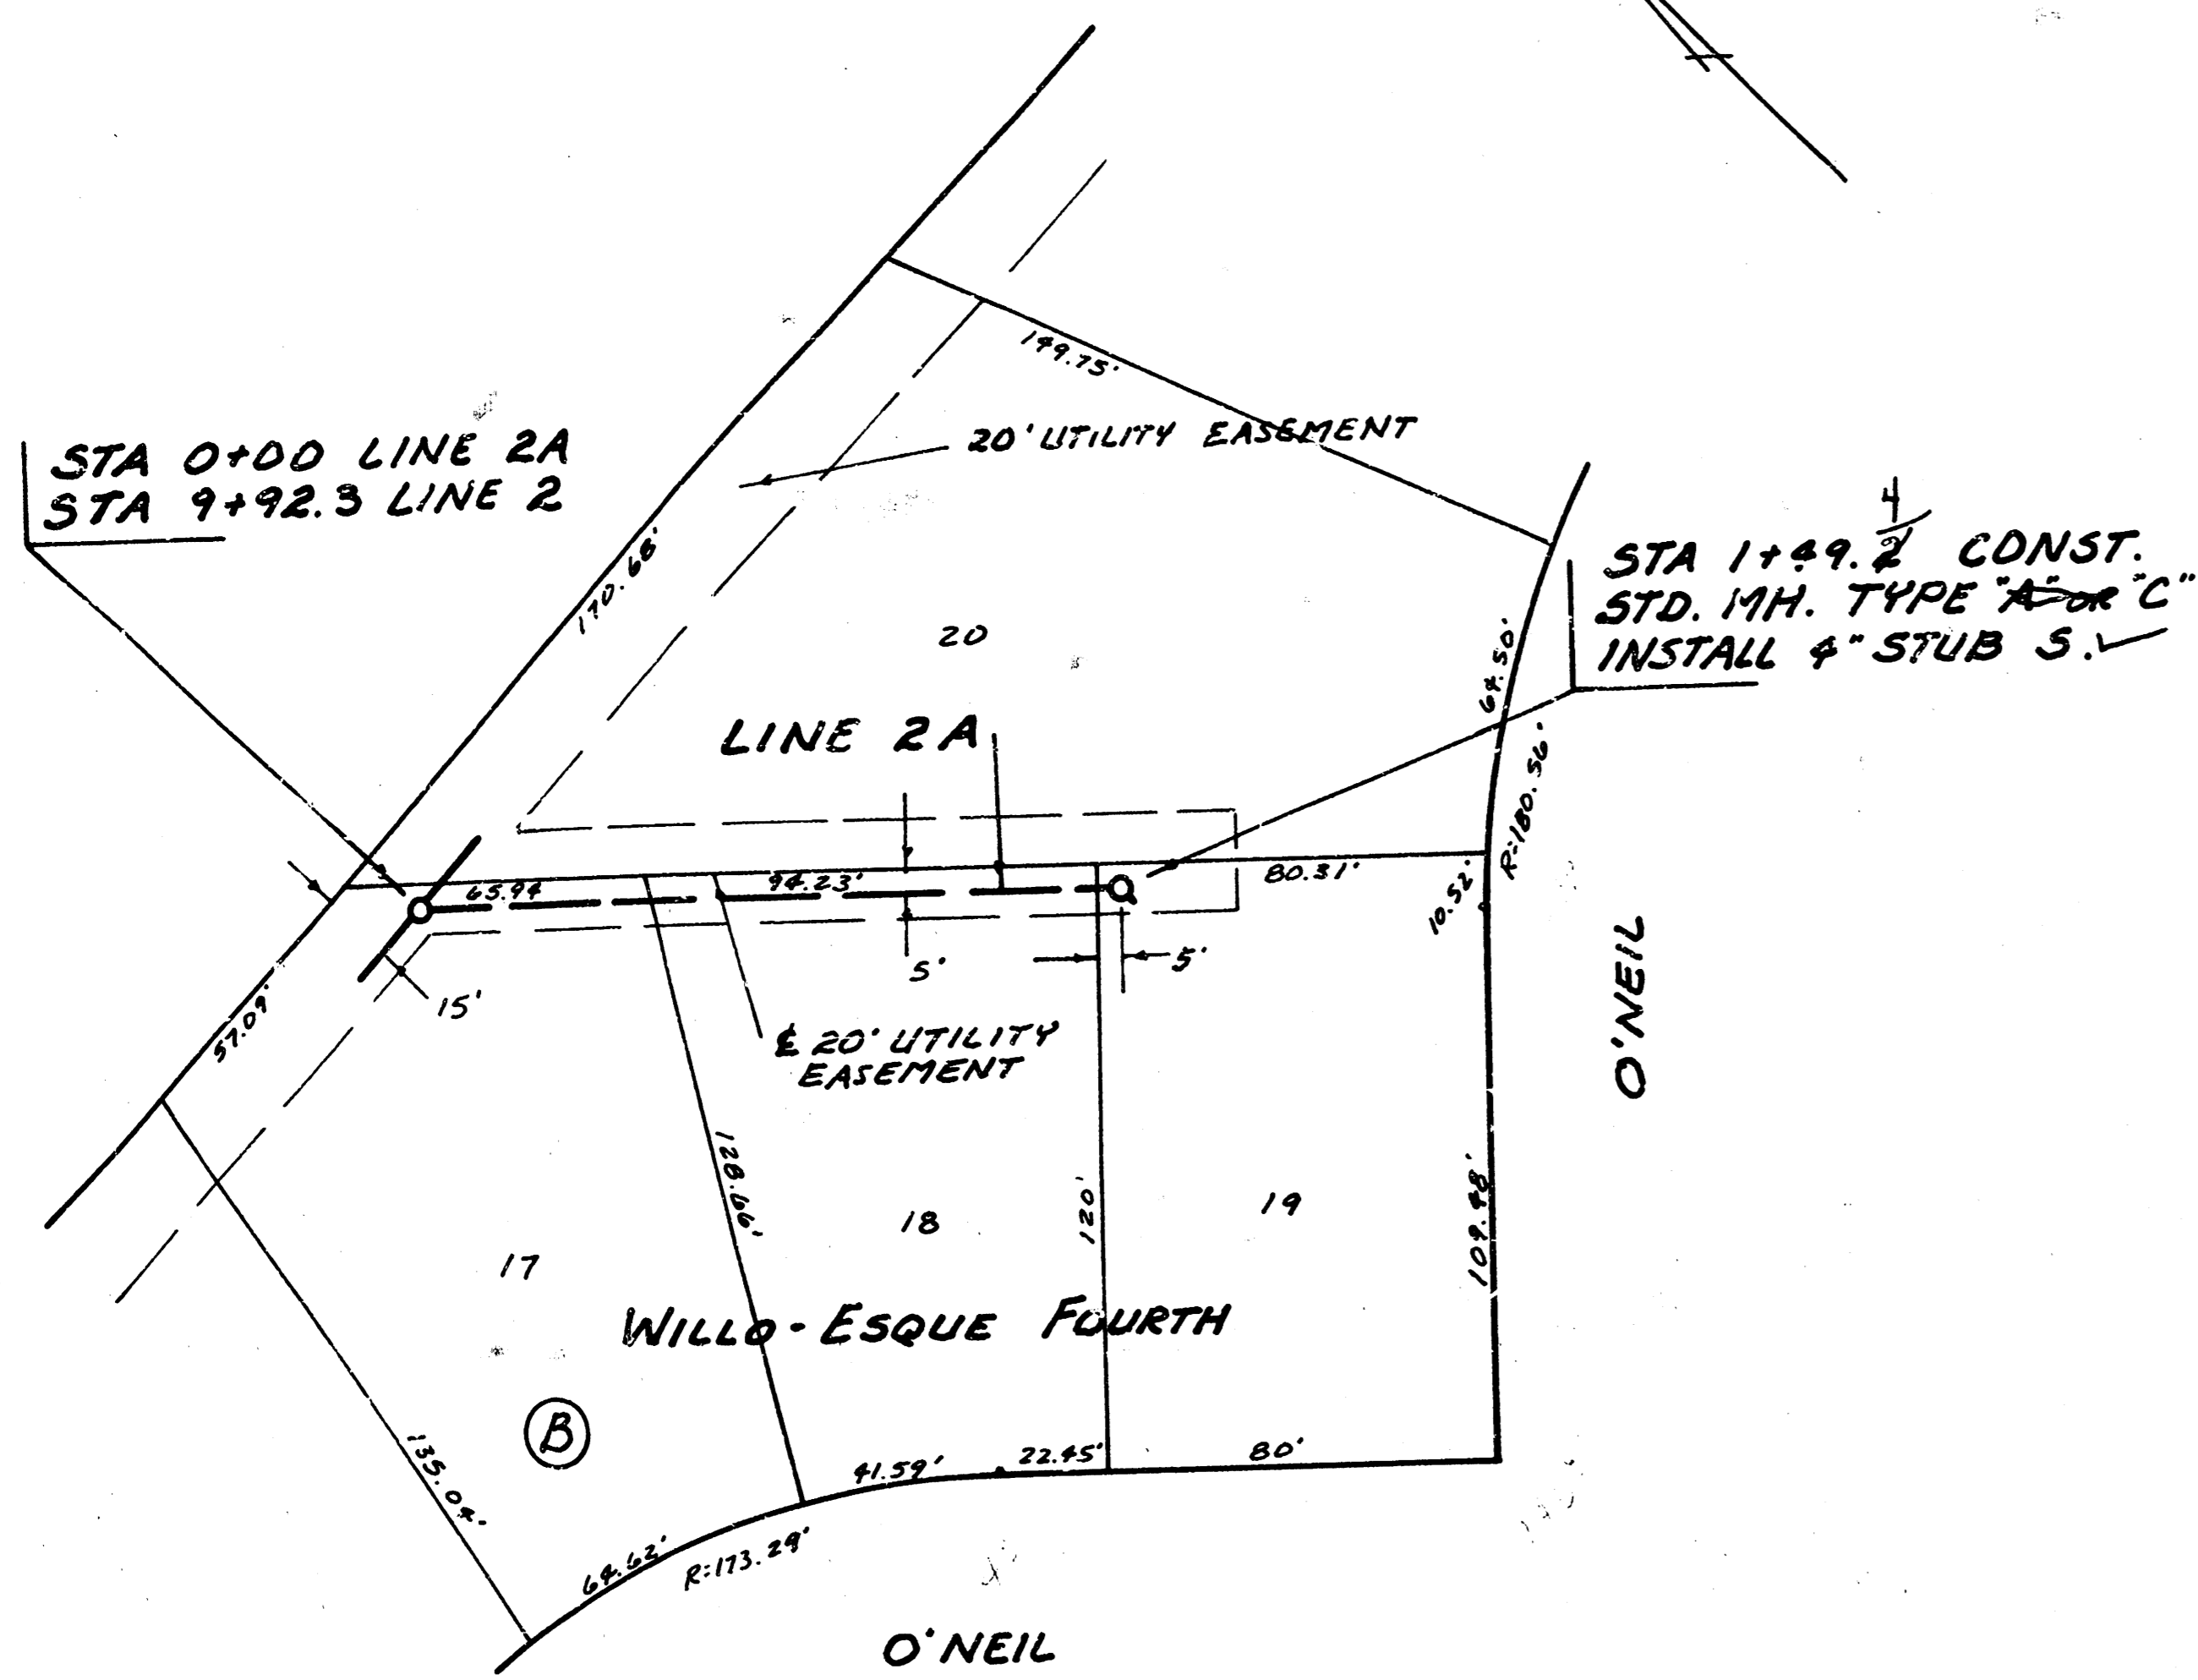

As Built
 J.L.L.
 9.82



STA 0+00 LINE 2A
 STA 9+92.3 LINE 2

STA 1+49.2 CONST.
 STD. MH. TYPE 'A' OR 'C'
 INSTALL 4" STUB S

STA 0+00
 EXIST. MH.
 WITH 8" STUB



STA 3+60 CONST.
 STD. MH. TYPE 'A' OR 'C'

STA 4+30 CONST.
 STD. MH. TYPE 'A' OR 'C'
 INSTALL 4" STUB W.

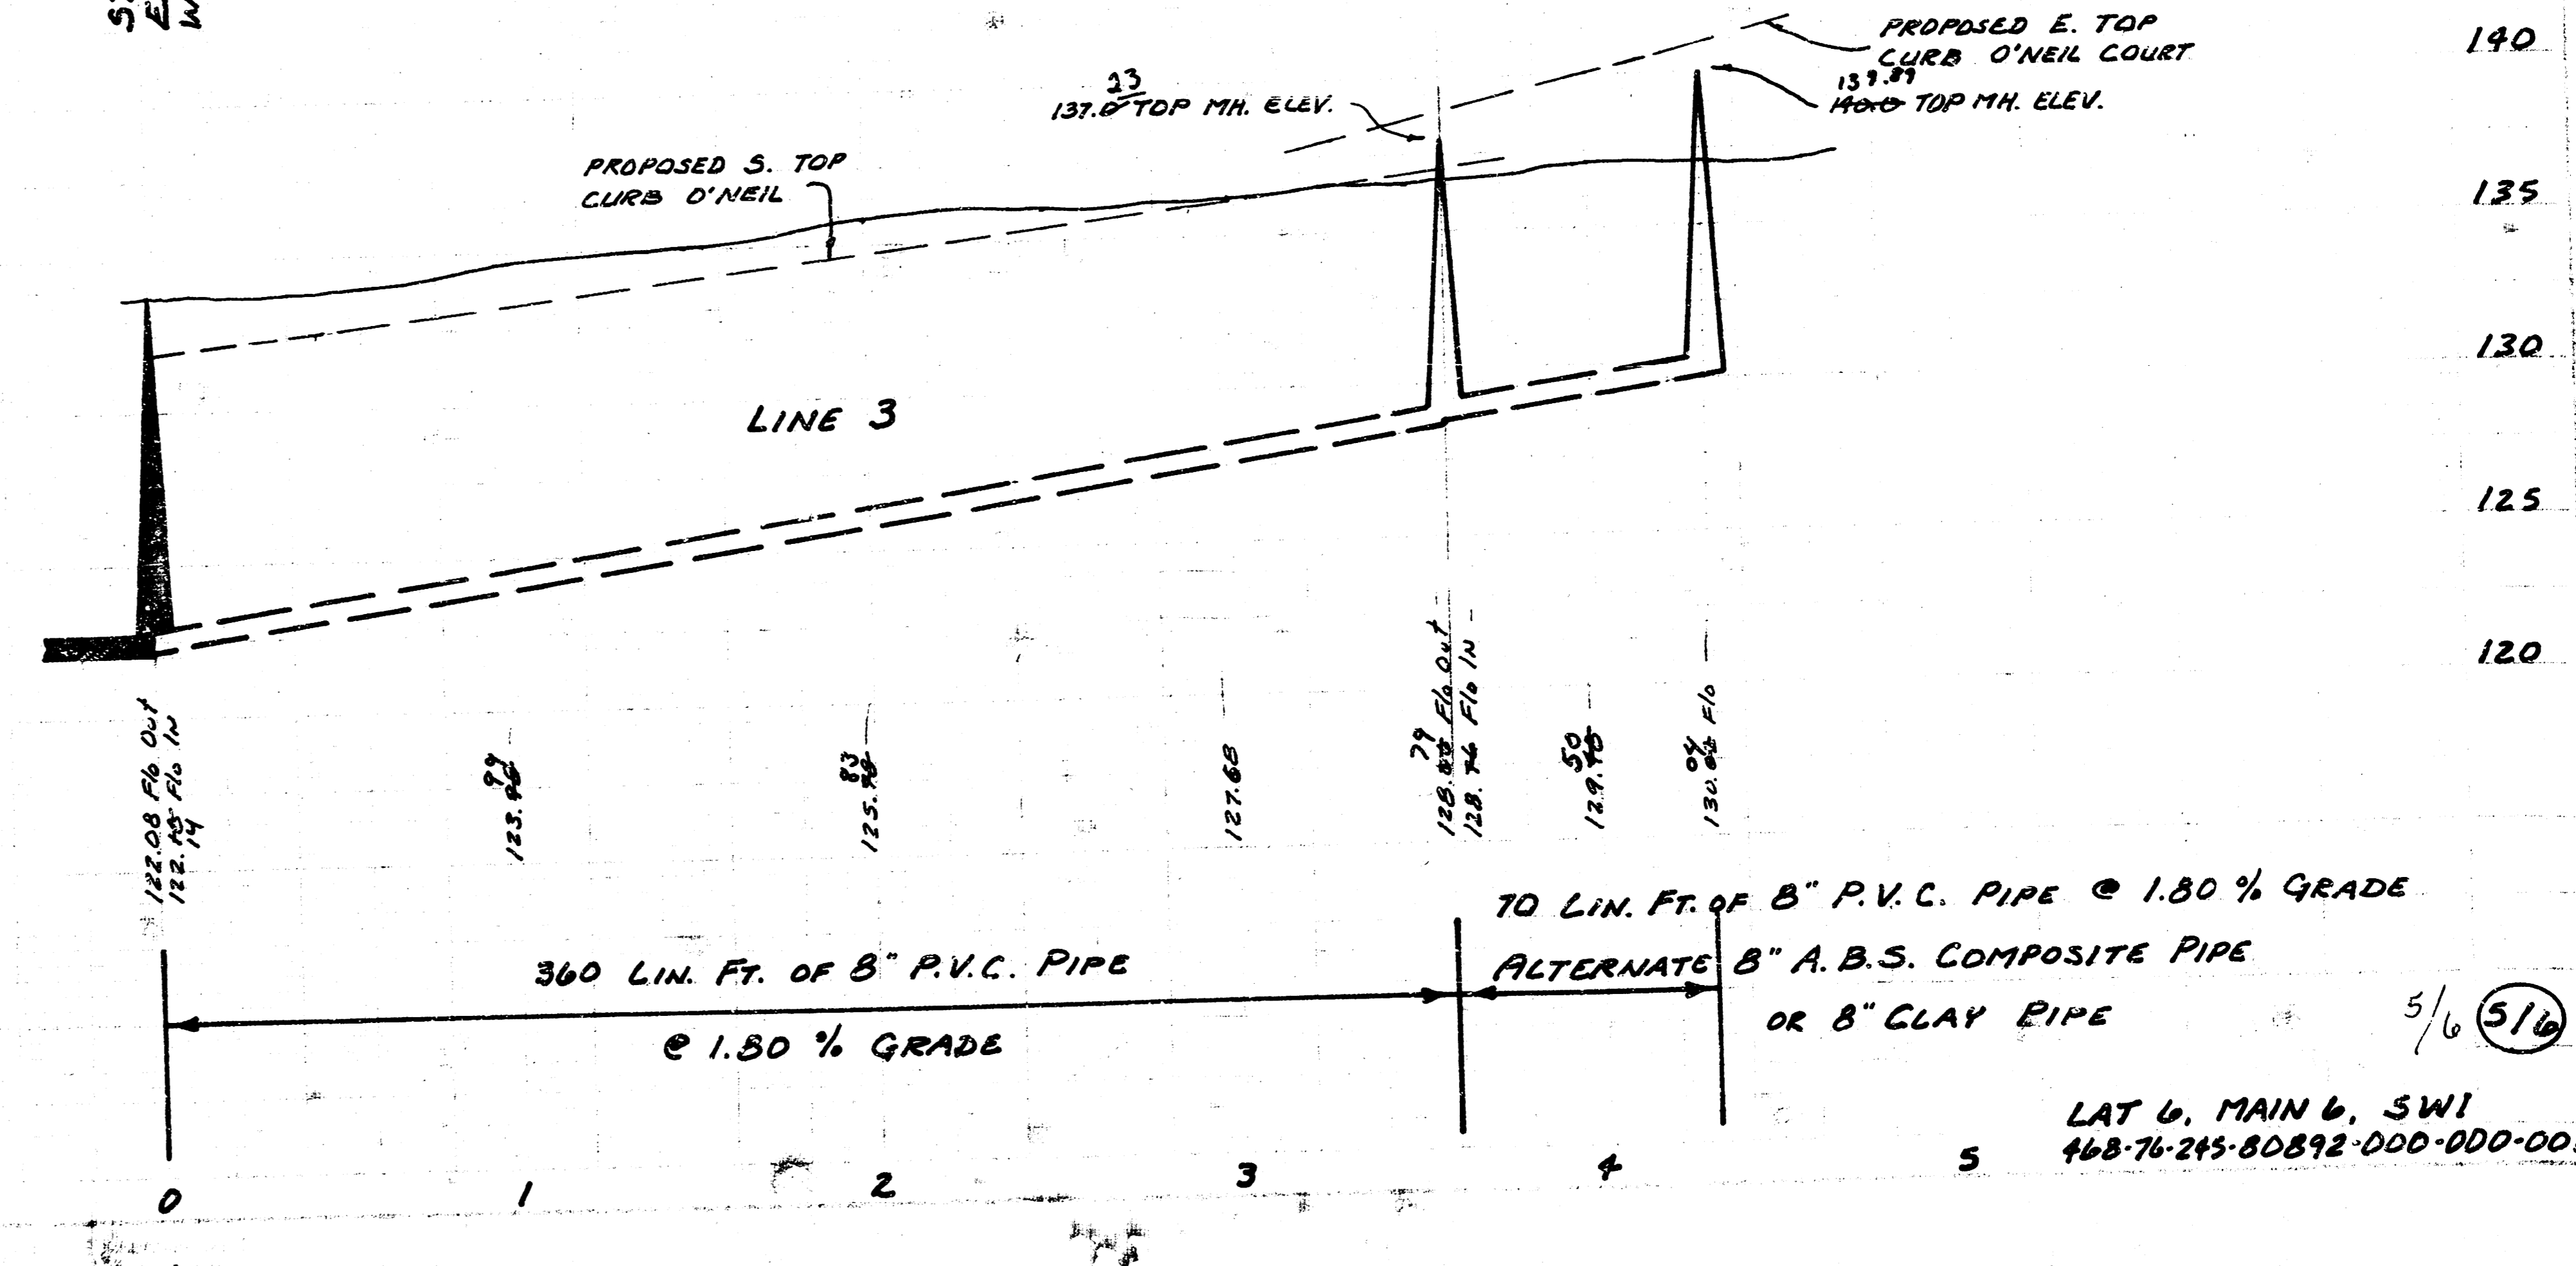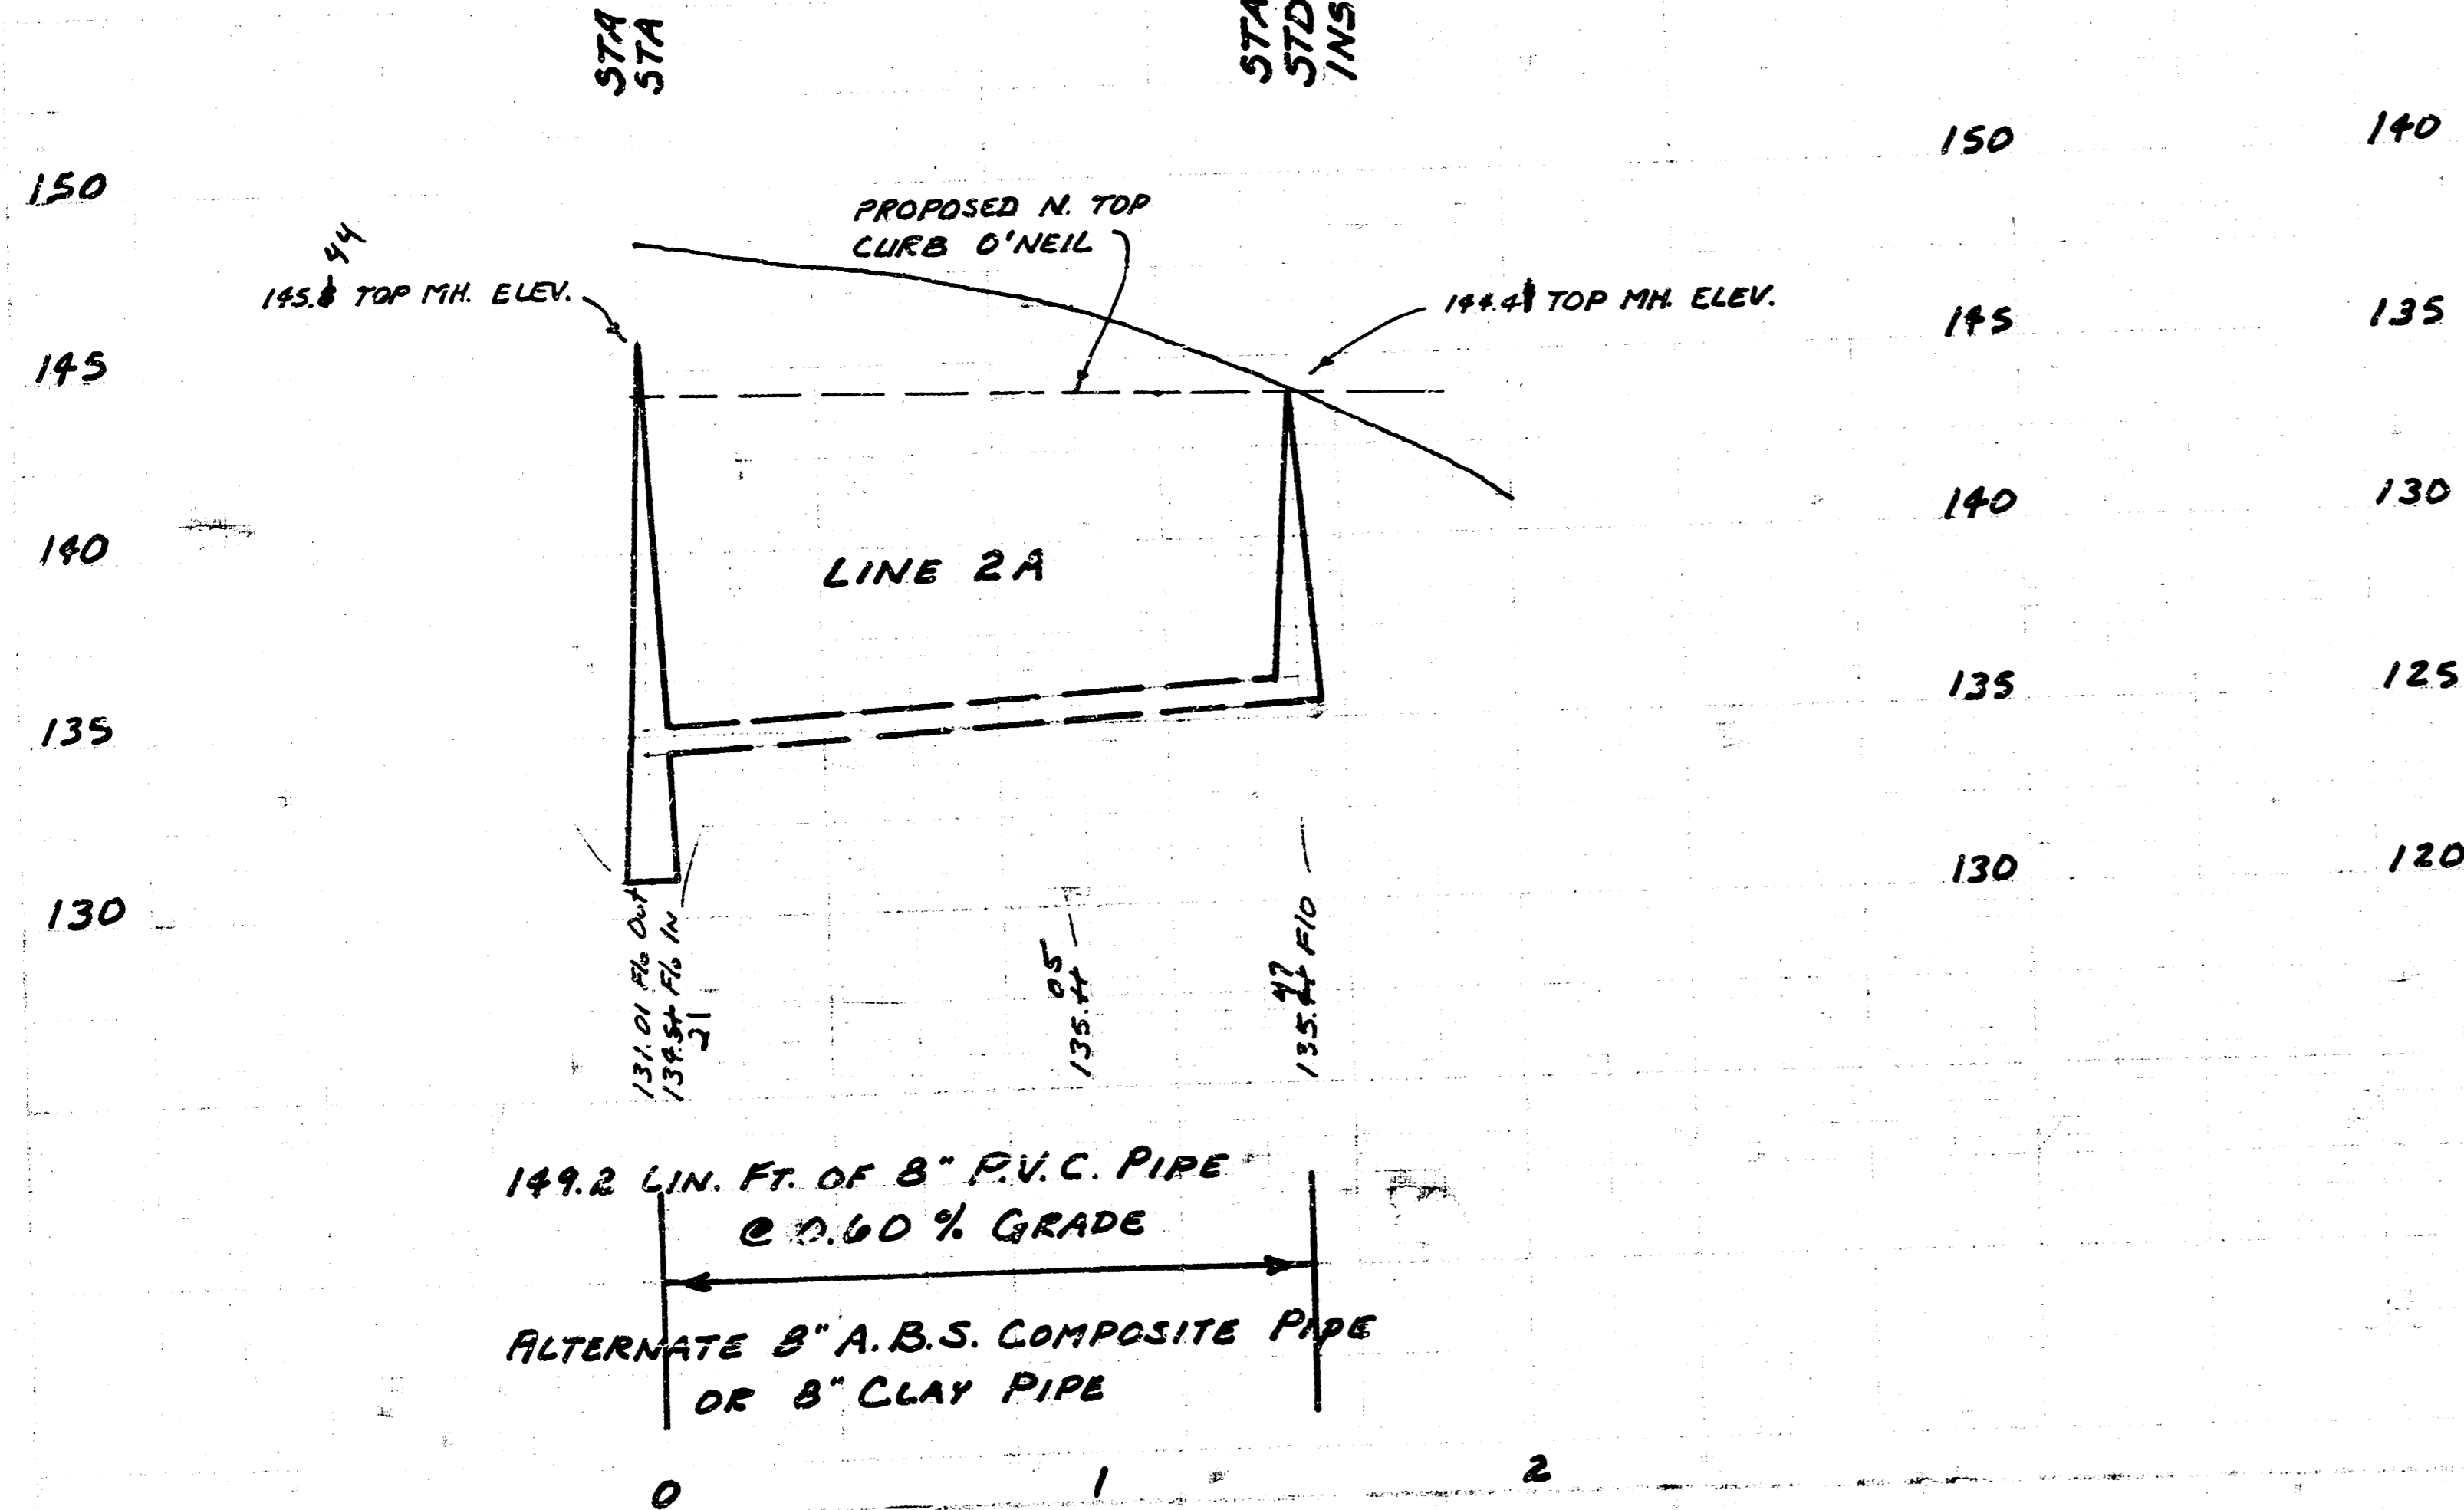


LAT 6, MAIN 6, SW1
 468-76-265-80892-000-000-001

SCALE PLAN 1" = 40'
 PROFILE 1" = 40' HORIZ.
 1" = 5' VERT.

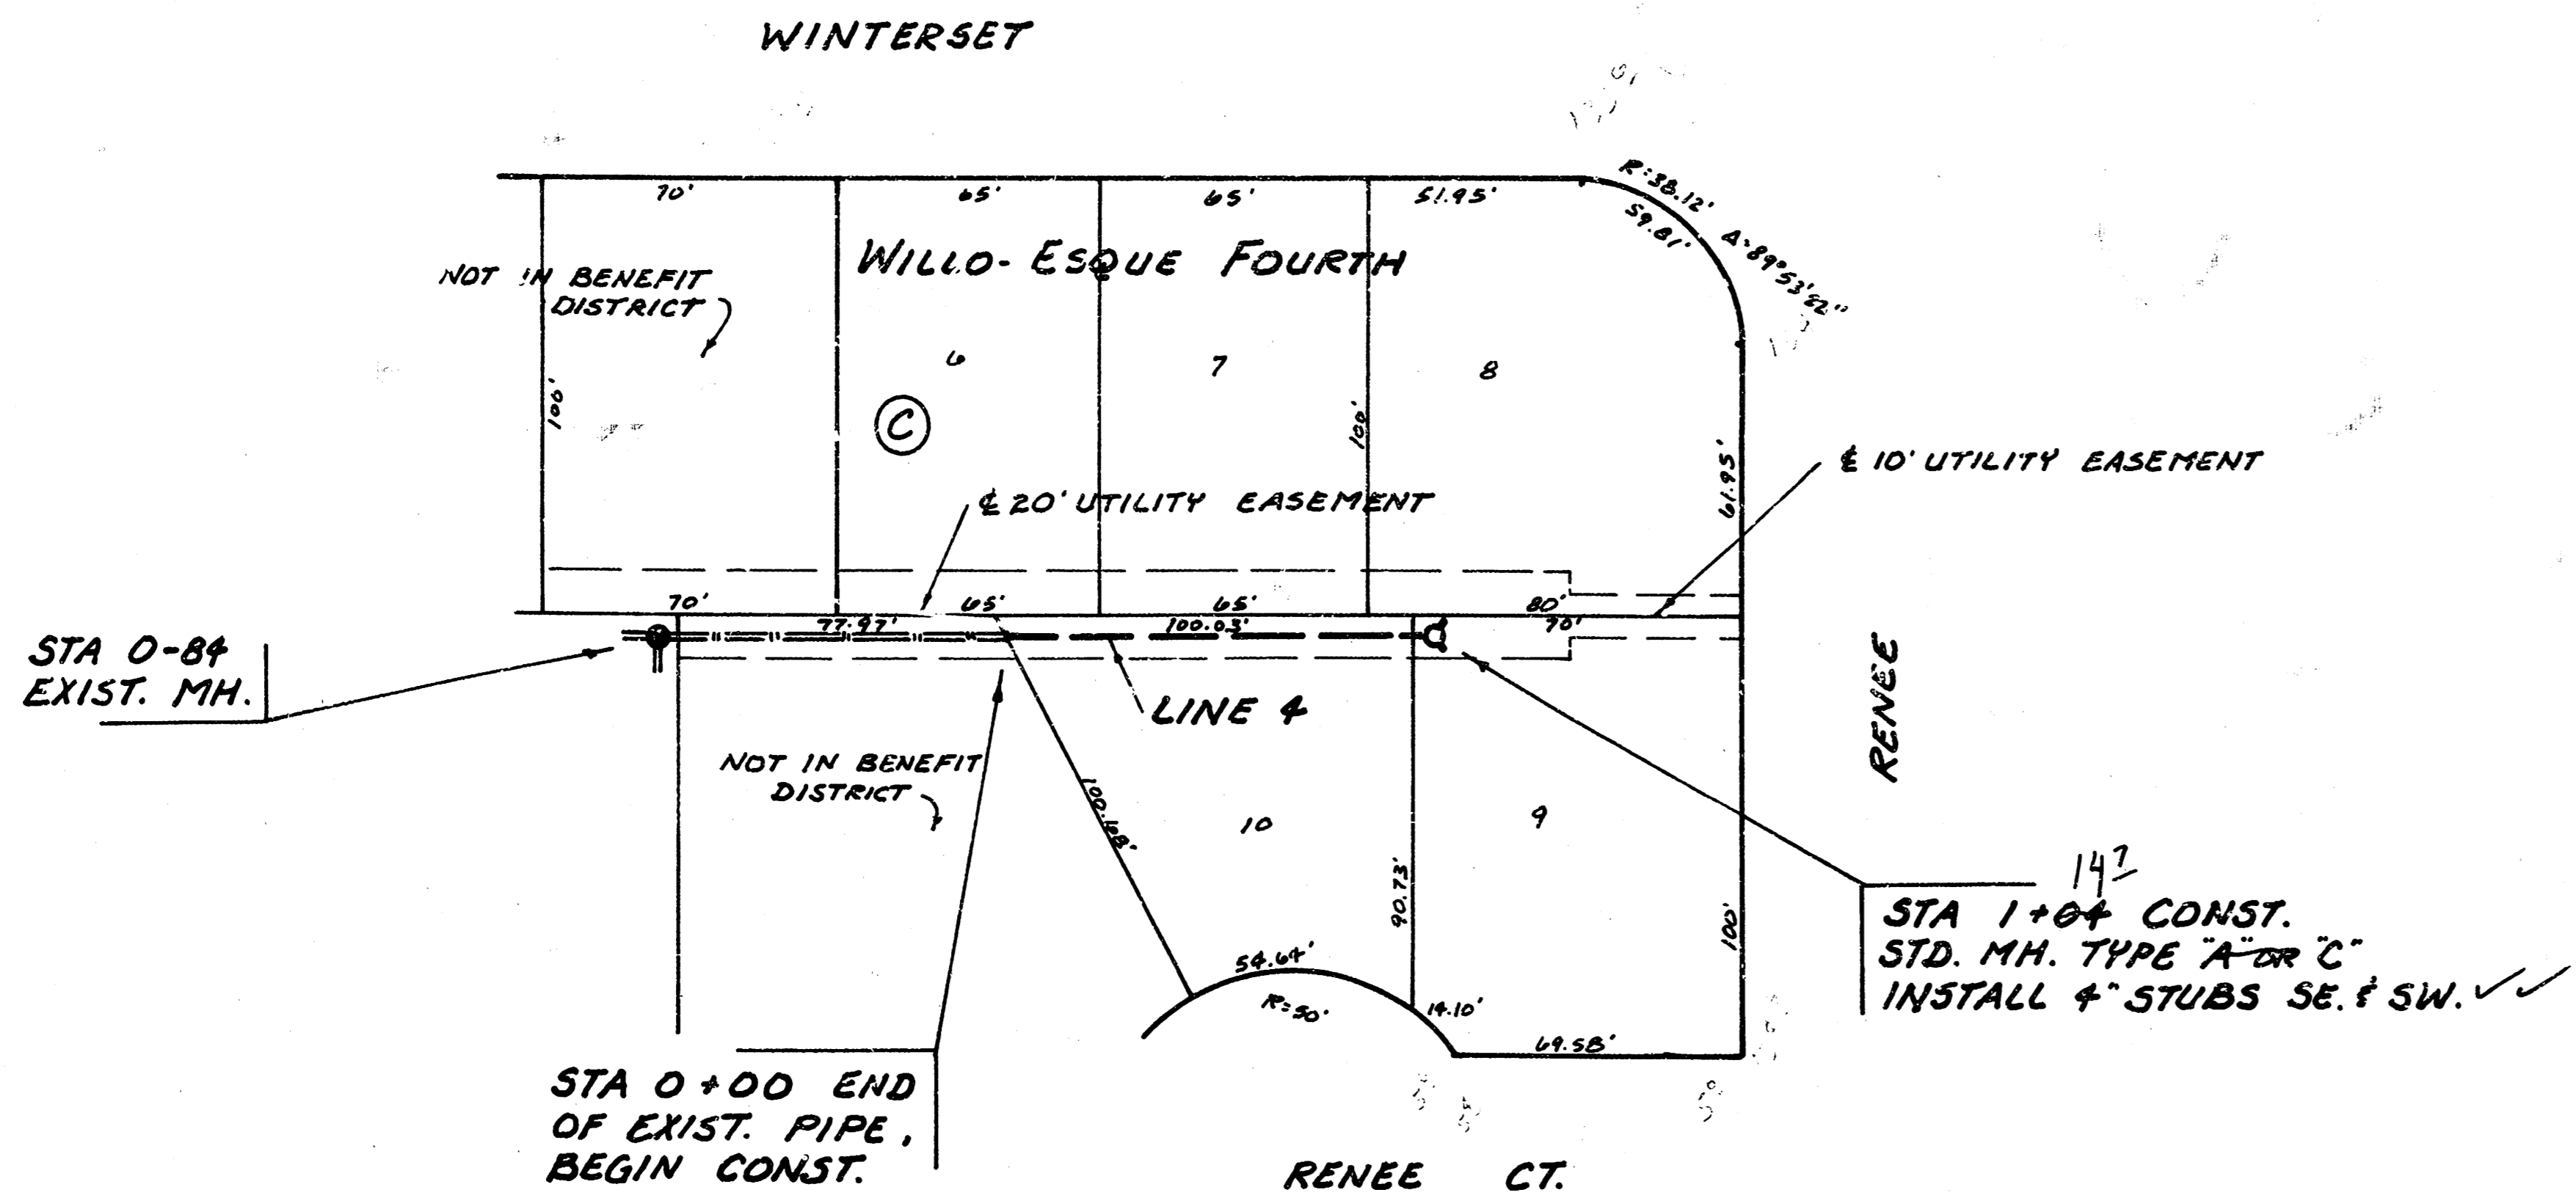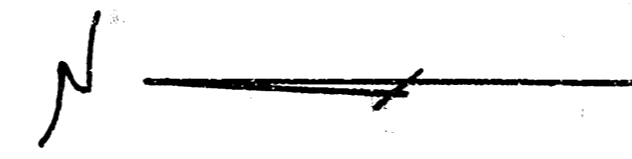

As Built
J.L.L.
9-82

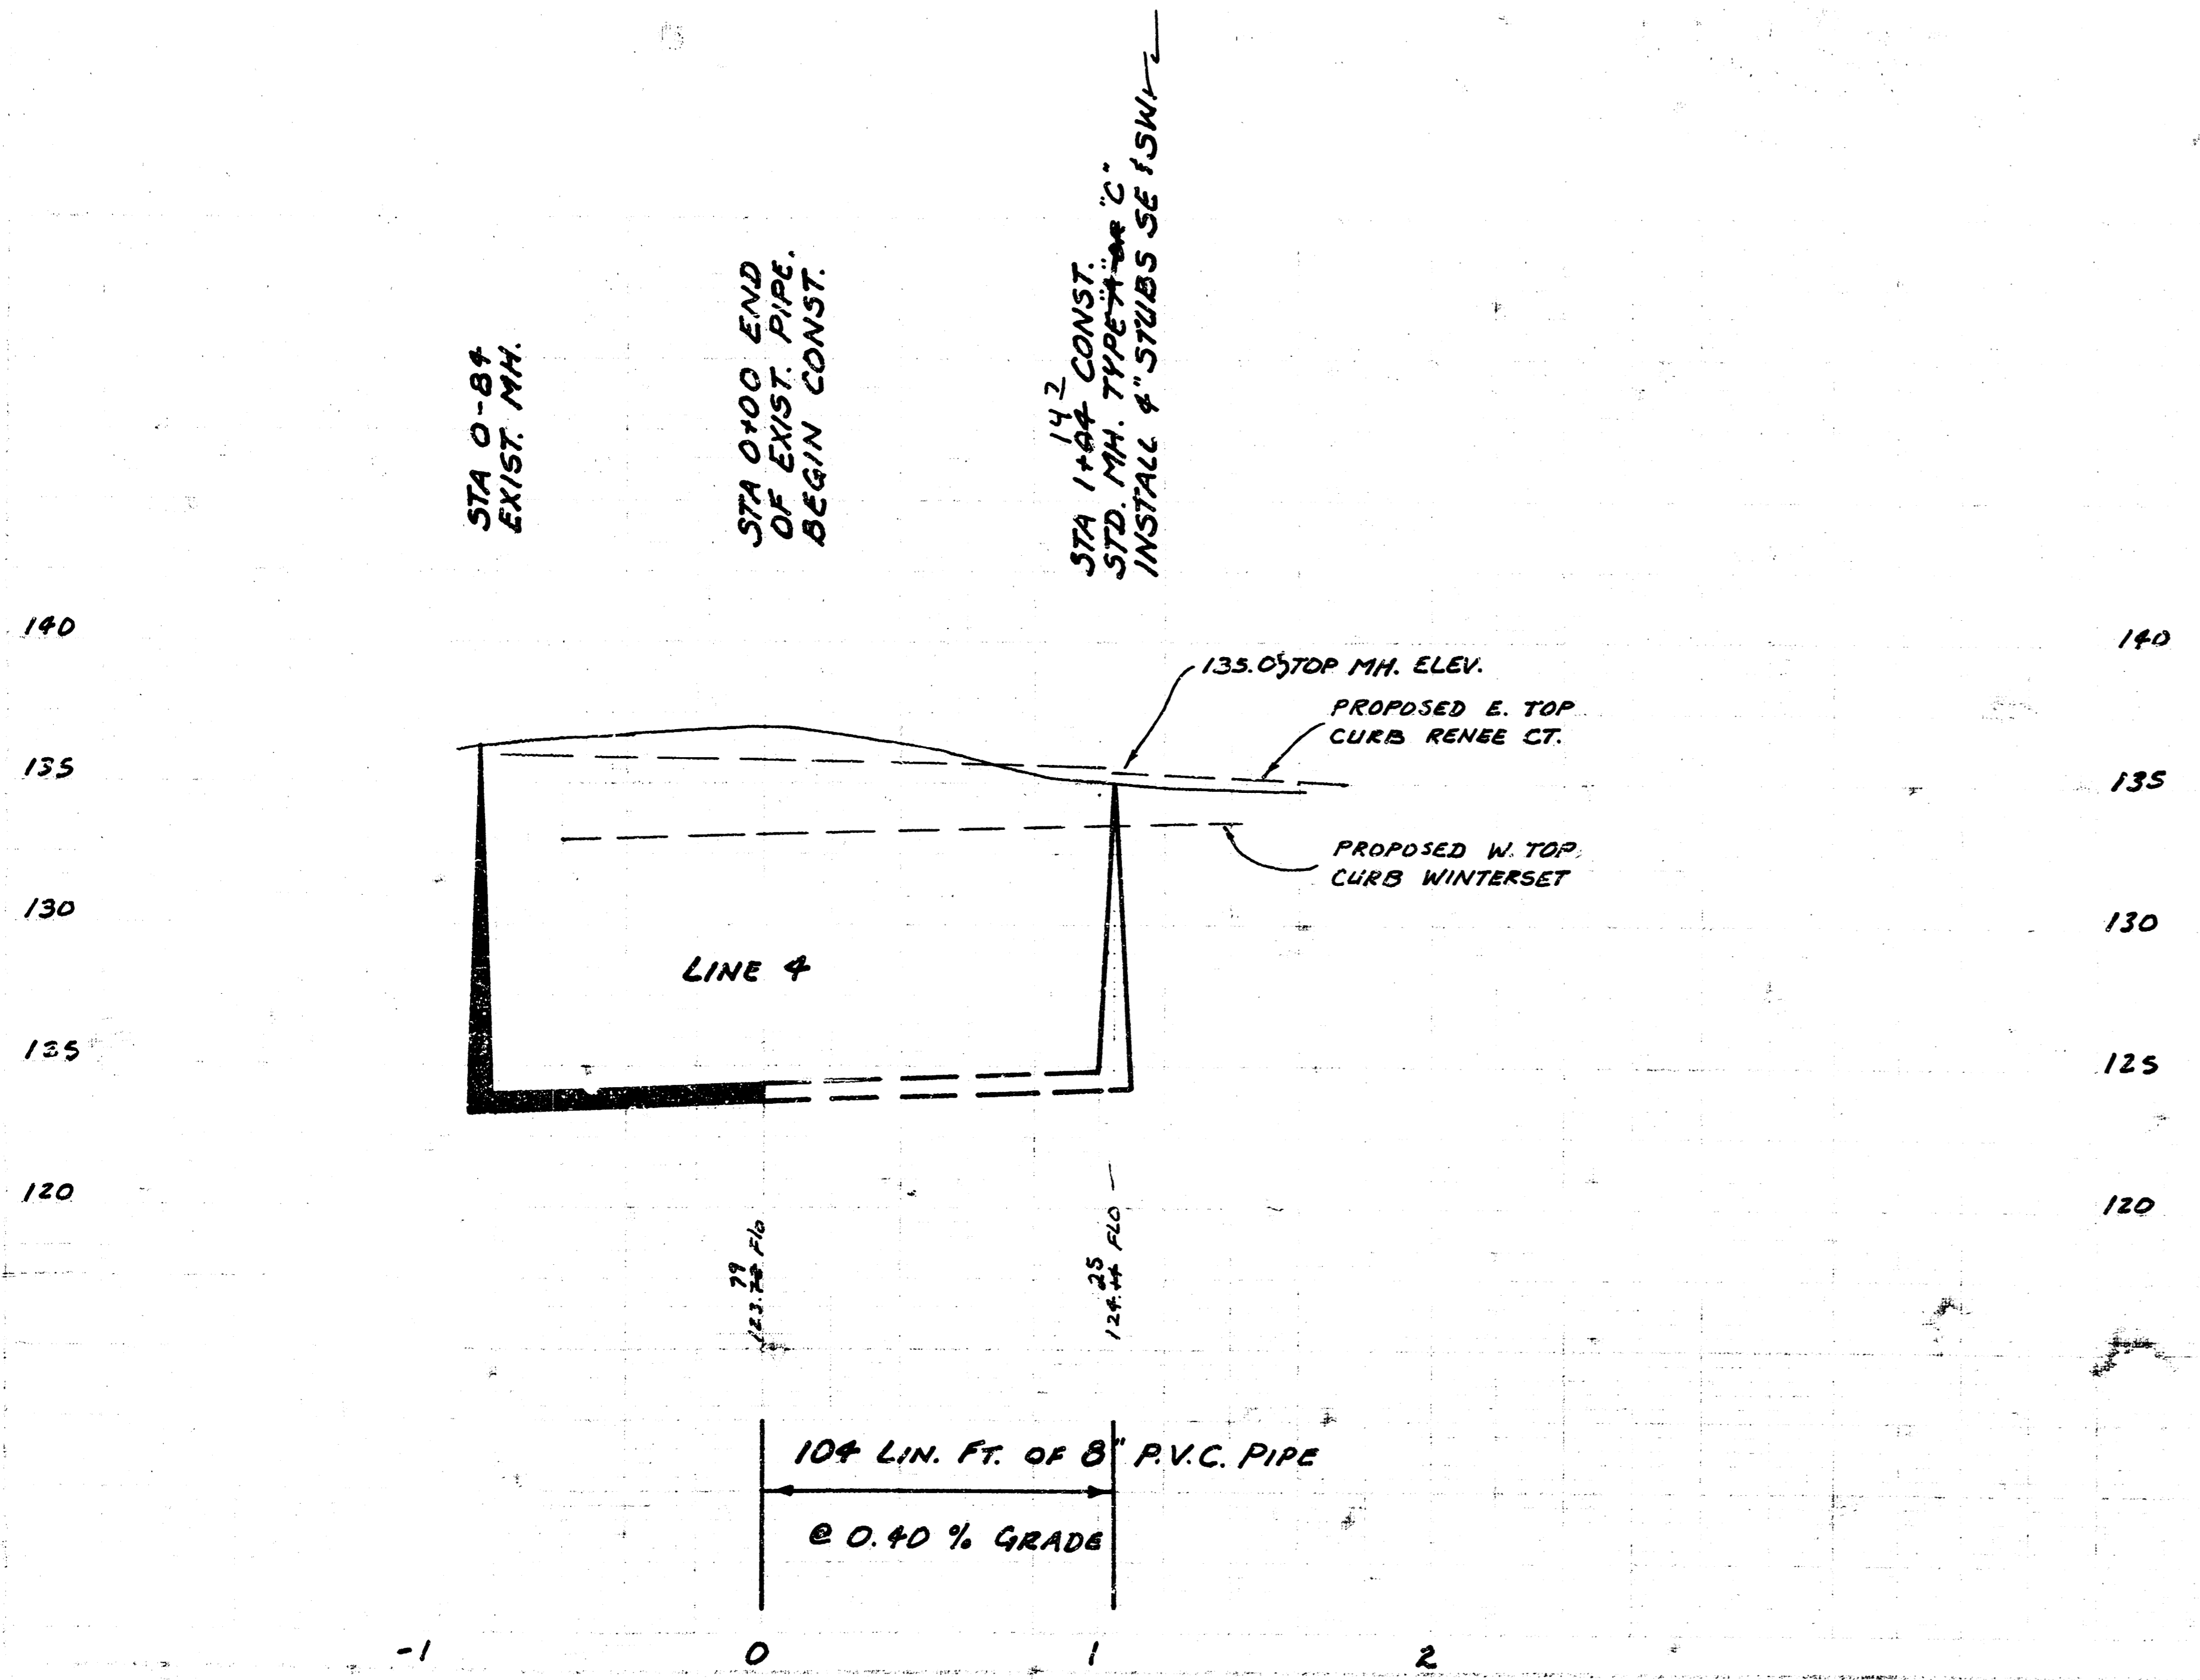

LAT 6, MAIN 6, SW1
 468-76-245-80892-000-000-001

10 0 3 0