

CAUTION
UNDERGROUND
UTILITIES

Please refer to the City of
Wichita Engineering Department
for location of existing utilities.

Sta 0+00 Existing MH
Begin Const. Connect to
8" Stub. Top MH Elev. = 130.67
Adjust to Proposed Elev.
of 131.53

Sta 4+03.5 Const Std
MH, Type C
Prop. Top MH Elev. = 132.2

Sta 6+76.7 Const Std
MH, Type C
Install 8" Stub, 5'
Prop. Top MH Elev. = 132.0

Sta 2+66.2 Const Std.
MH, Type C
Prop. Top MH Elev. = 131.0

Bench Marks:
131.33 - RR Spk on West Face
Elm Tree @ NE Cor. of
Prairie Park 2nd Add'n.
130.63 - "d" @ Base of Chain Lk. fence
post E.L. Carwood and Carr
130.81 - "d" @ Base of Chain Lk. fence approx.
15 ft. South of N.L. Esthiner and
E.L. Carwood
Elev. 130.67 - N. Rim S.S. MH. Located 7.15 ft. West
and 5.1 ft. South of NE. Cor. Lot 39, Blk 5,
Prairie Park 2nd Add'n.

SCALE: 1" = 40' Plan
Horz. 1" = 40' Profile
Vert. 1" = 5'



THE CONTRACTOR SHALL BE RESPONSIBLE
FOR PRESERVING EXISTING UTILITIES.
CONTRACTOR SHALL BE RESPONSIBLE FOR
ESTABLISHING A PROTECTIVE FENCE TO
BE MAINTAINED BY CONTRACTOR
THROUGHOUT THE CONSTRUCTION PERIOD.
CONTRACTOR SHALL BE RESPONSIBLE FOR
OBTAINING A LICENSED PROFESSIONAL
ENGINEER'S SIGNATURE WITHIN THE LAND.

- 135
- 130
- 125
- 120

As Built
11/81

LATERAL 4, MAIN 11, S. W. I.
CITY OF WICHITA, KANSAS
R.W. BRUGGEMAN
DIRECTOR OF ENGINEERING/CITY ENGINEER
PROJ. NO. 468-76-245 81093-000-000-001

SHEET 1 of 2

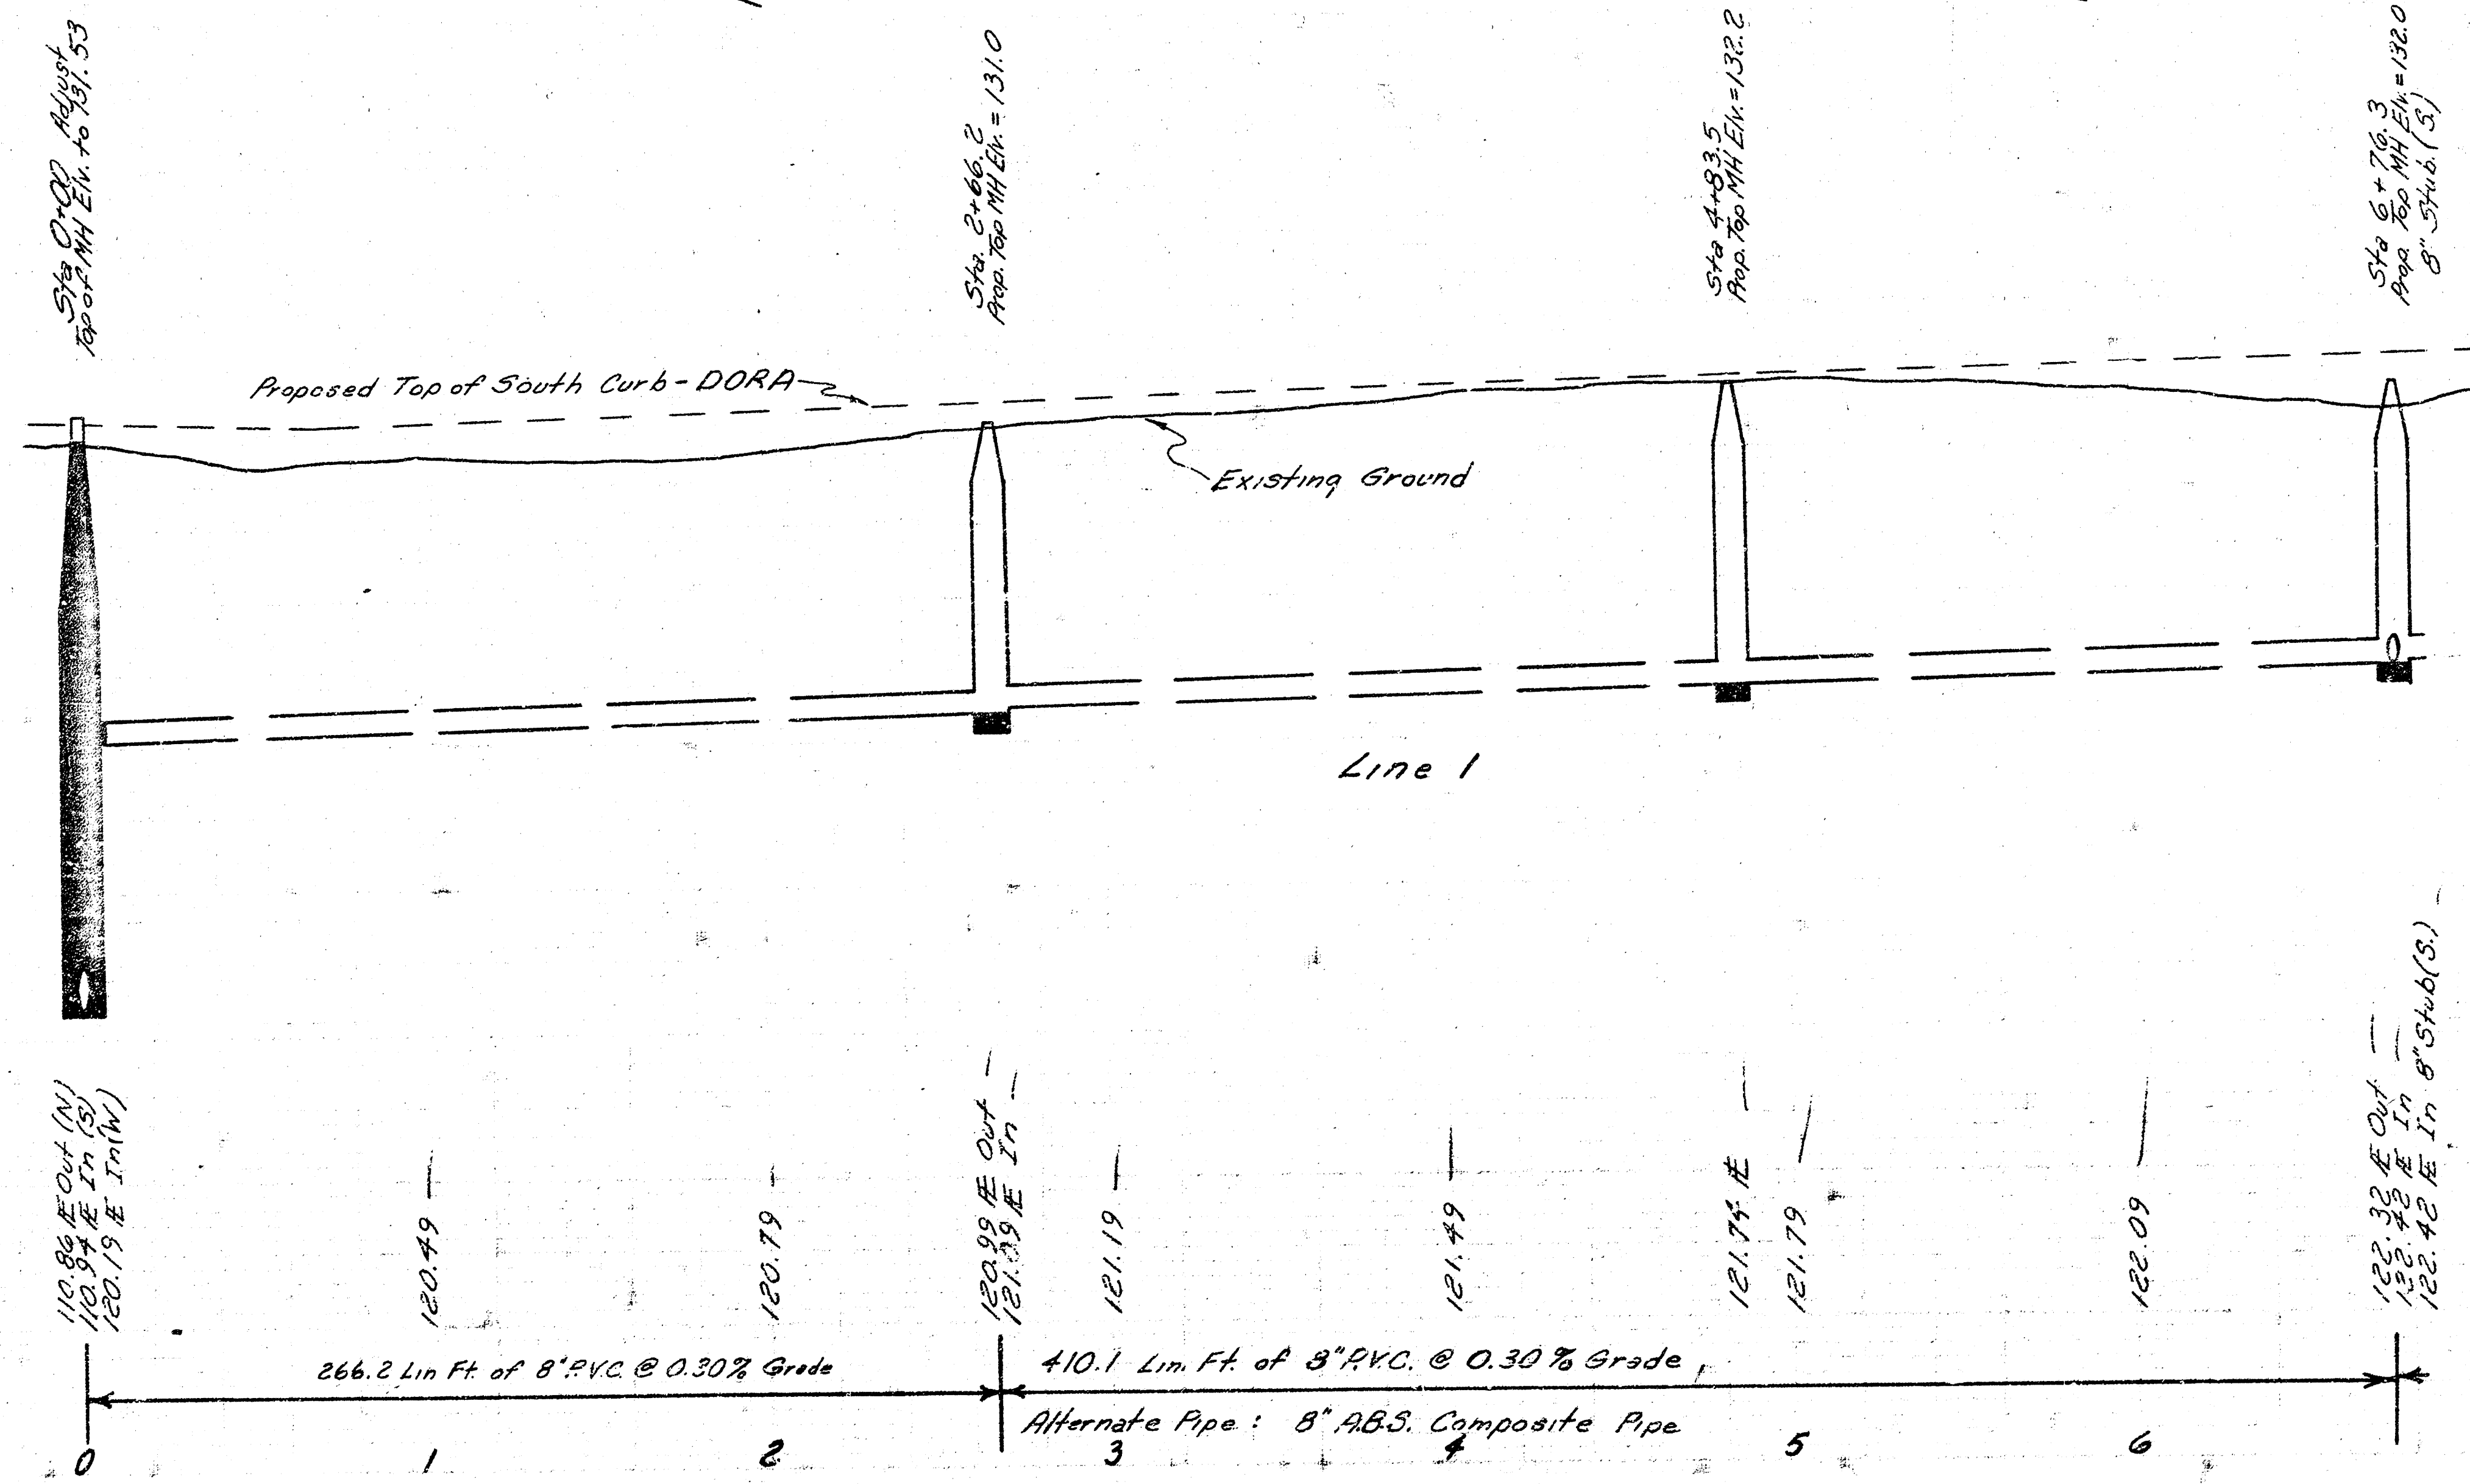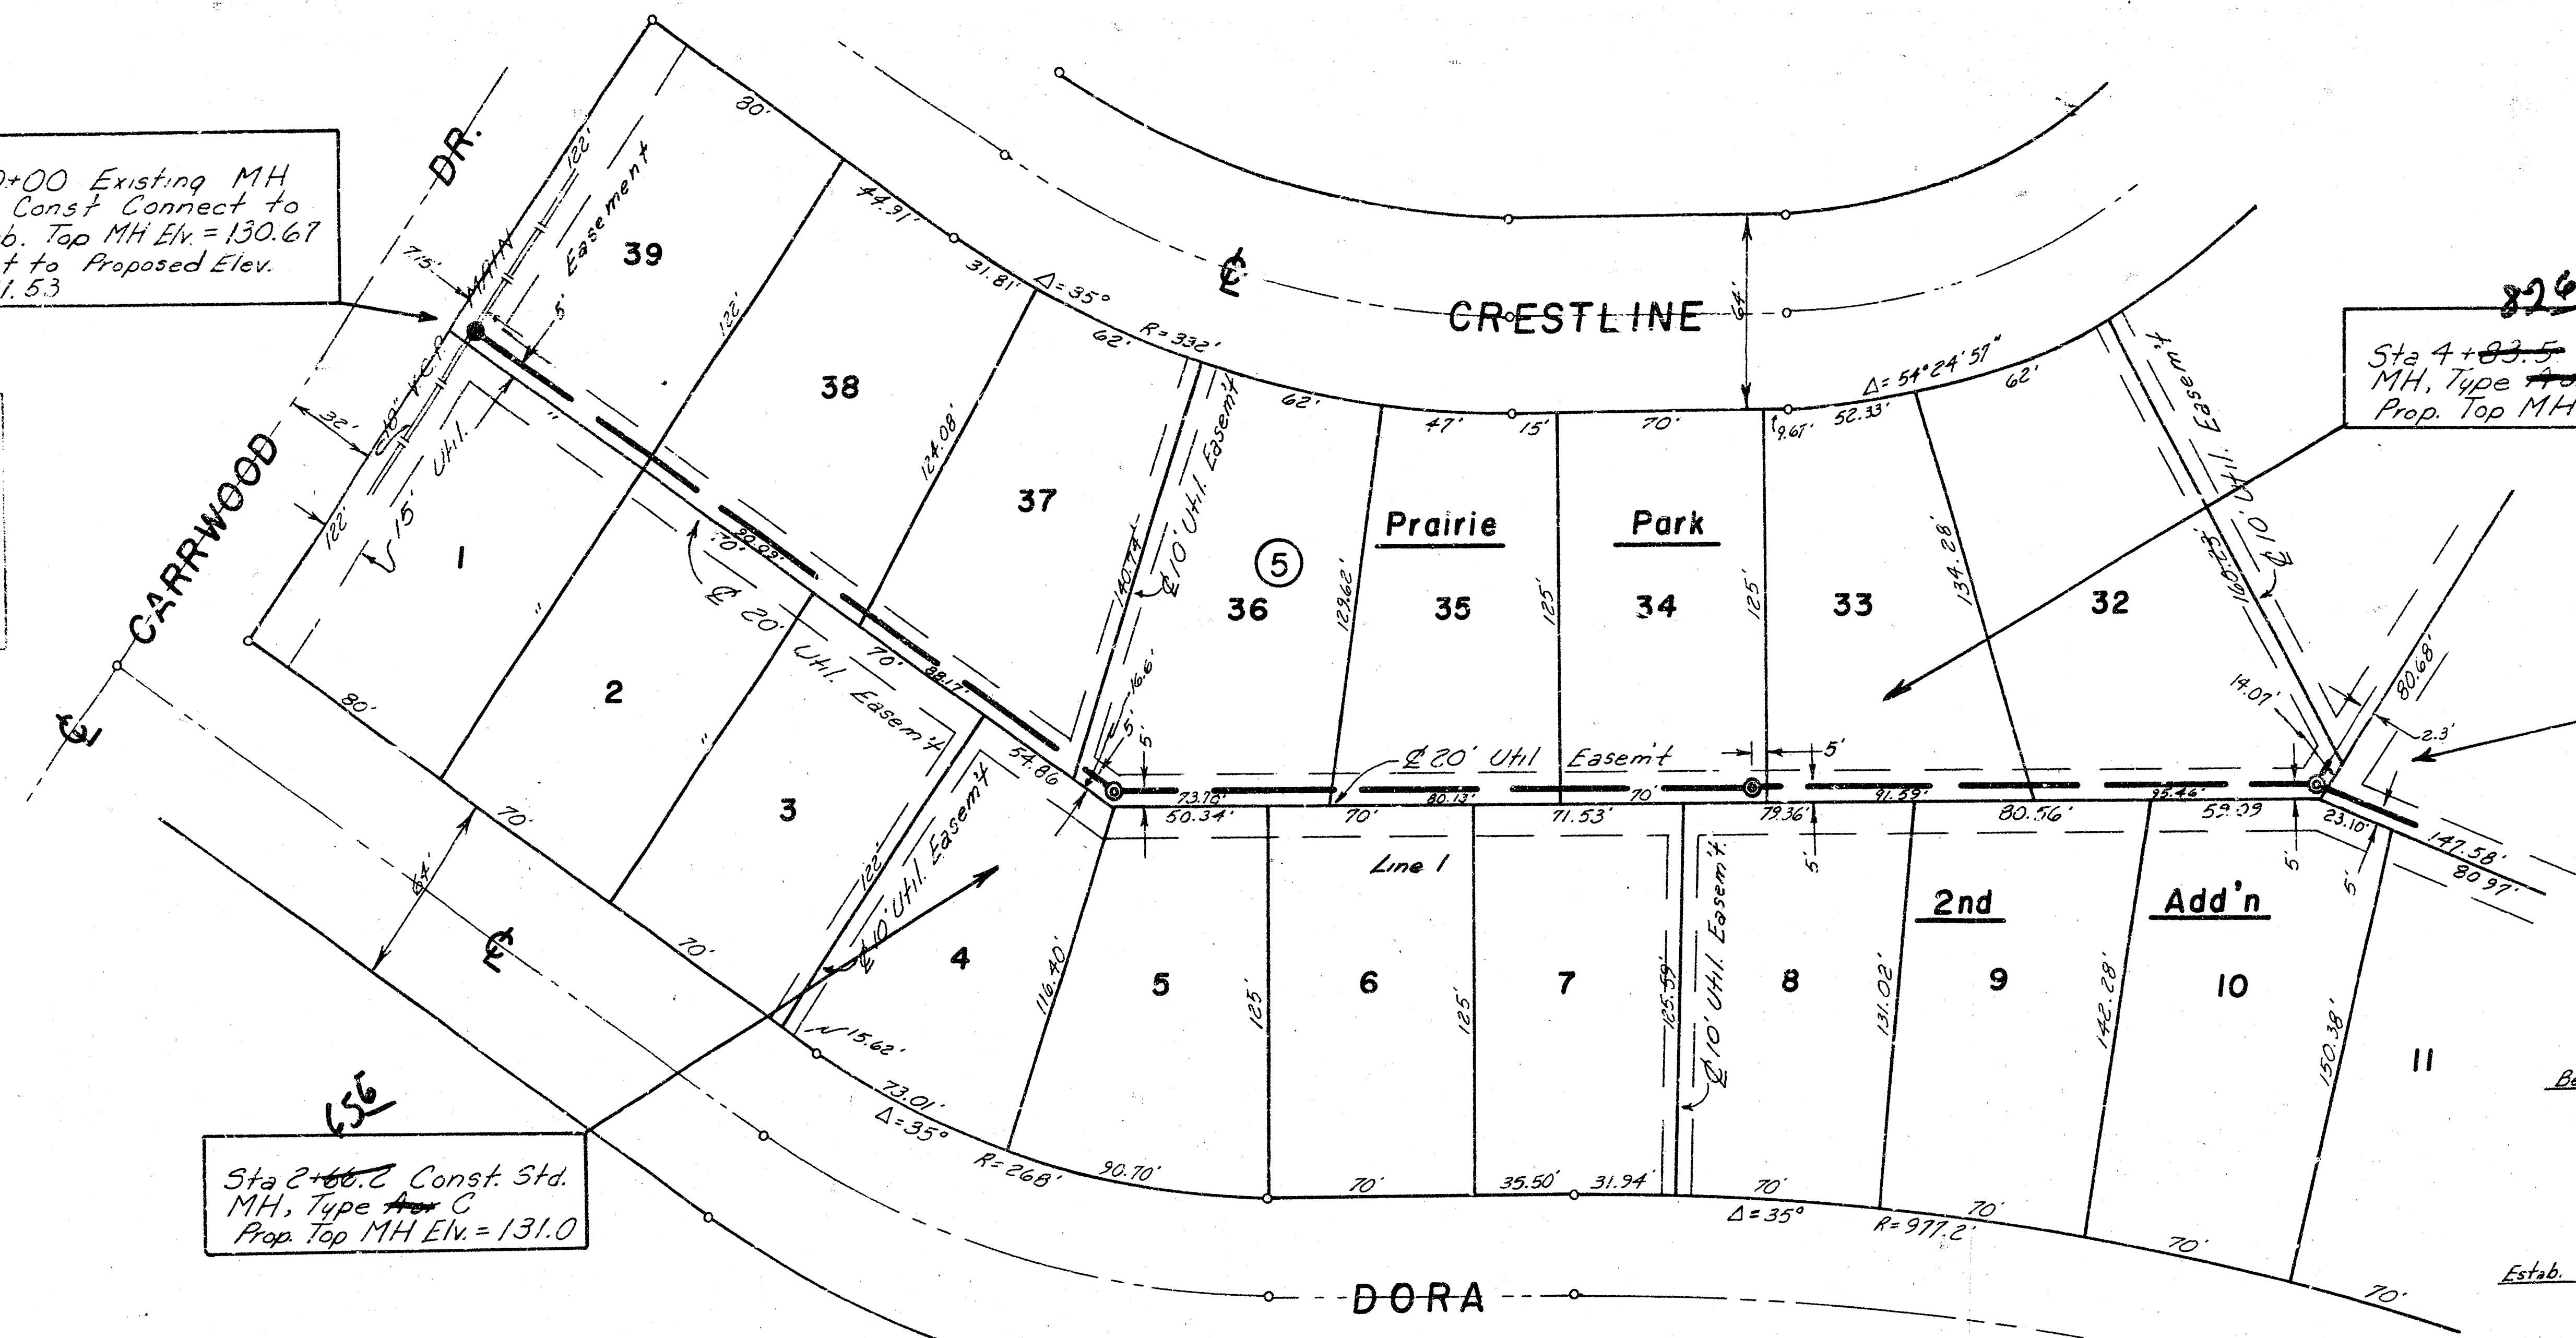

LAT. 4 , MAIN II , S.W.I.
PROJ. NO. 468-76-245-81093-000-000-001
Sheet 2 of 2

