

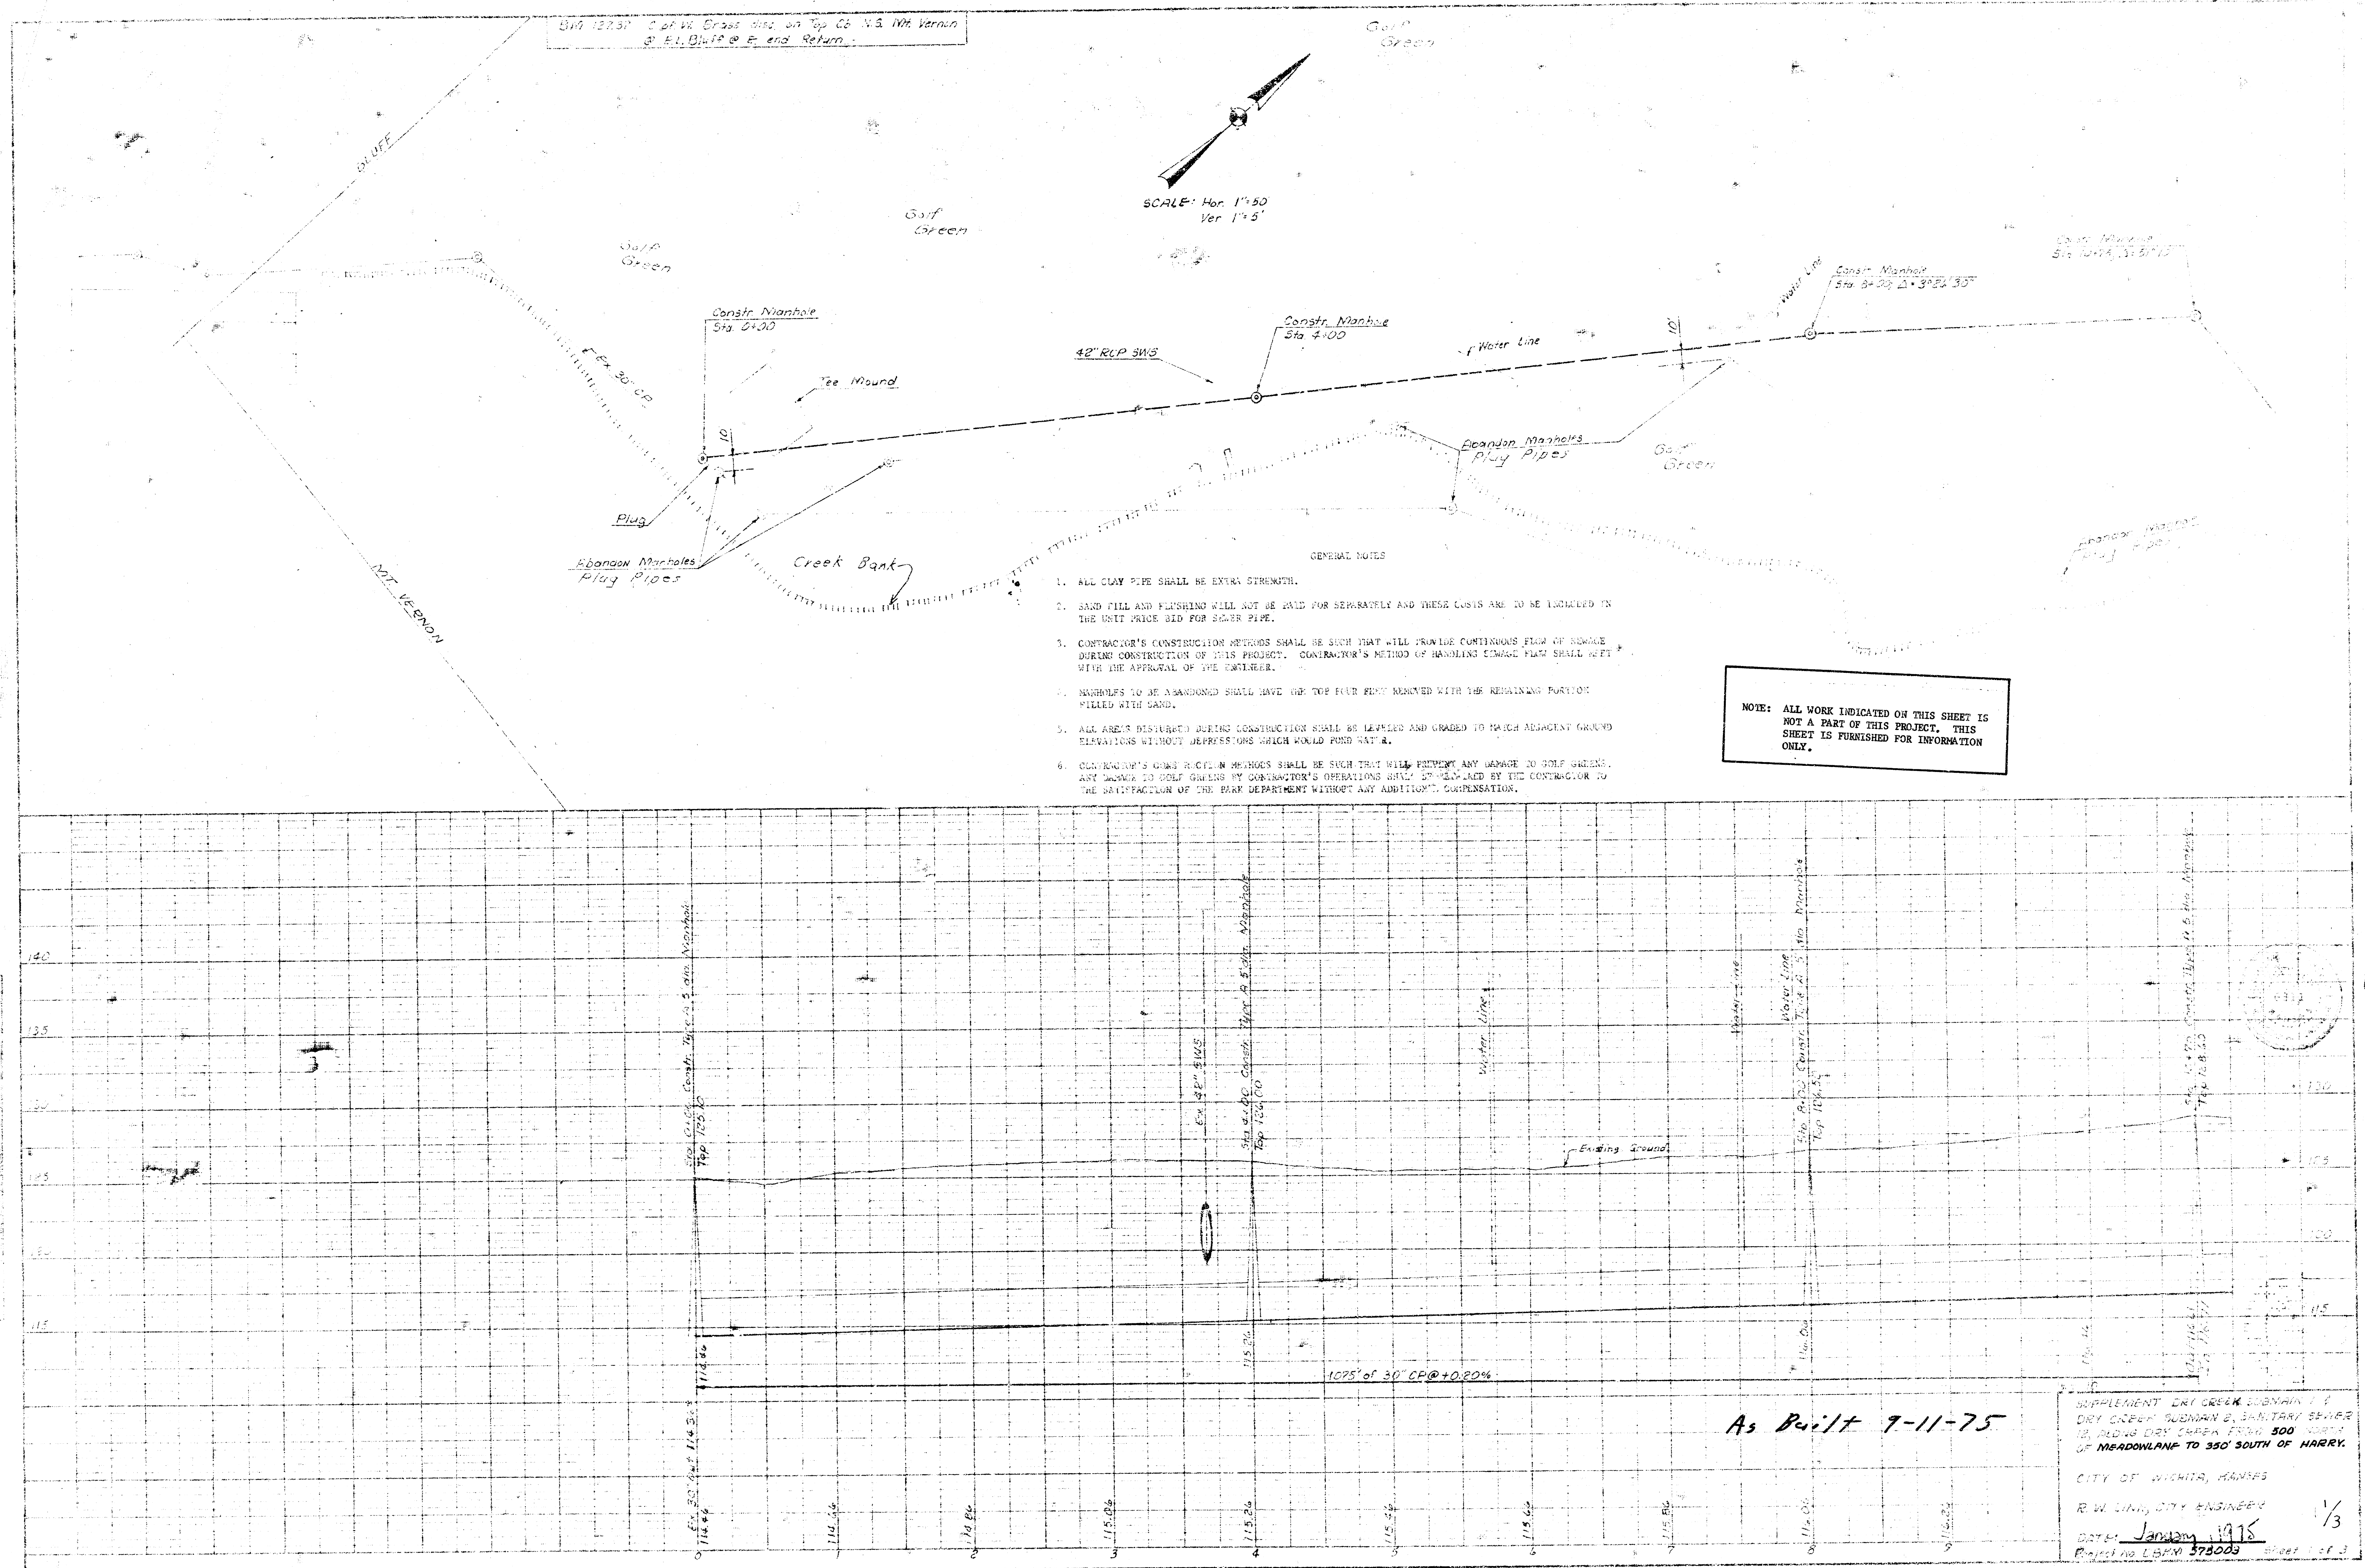


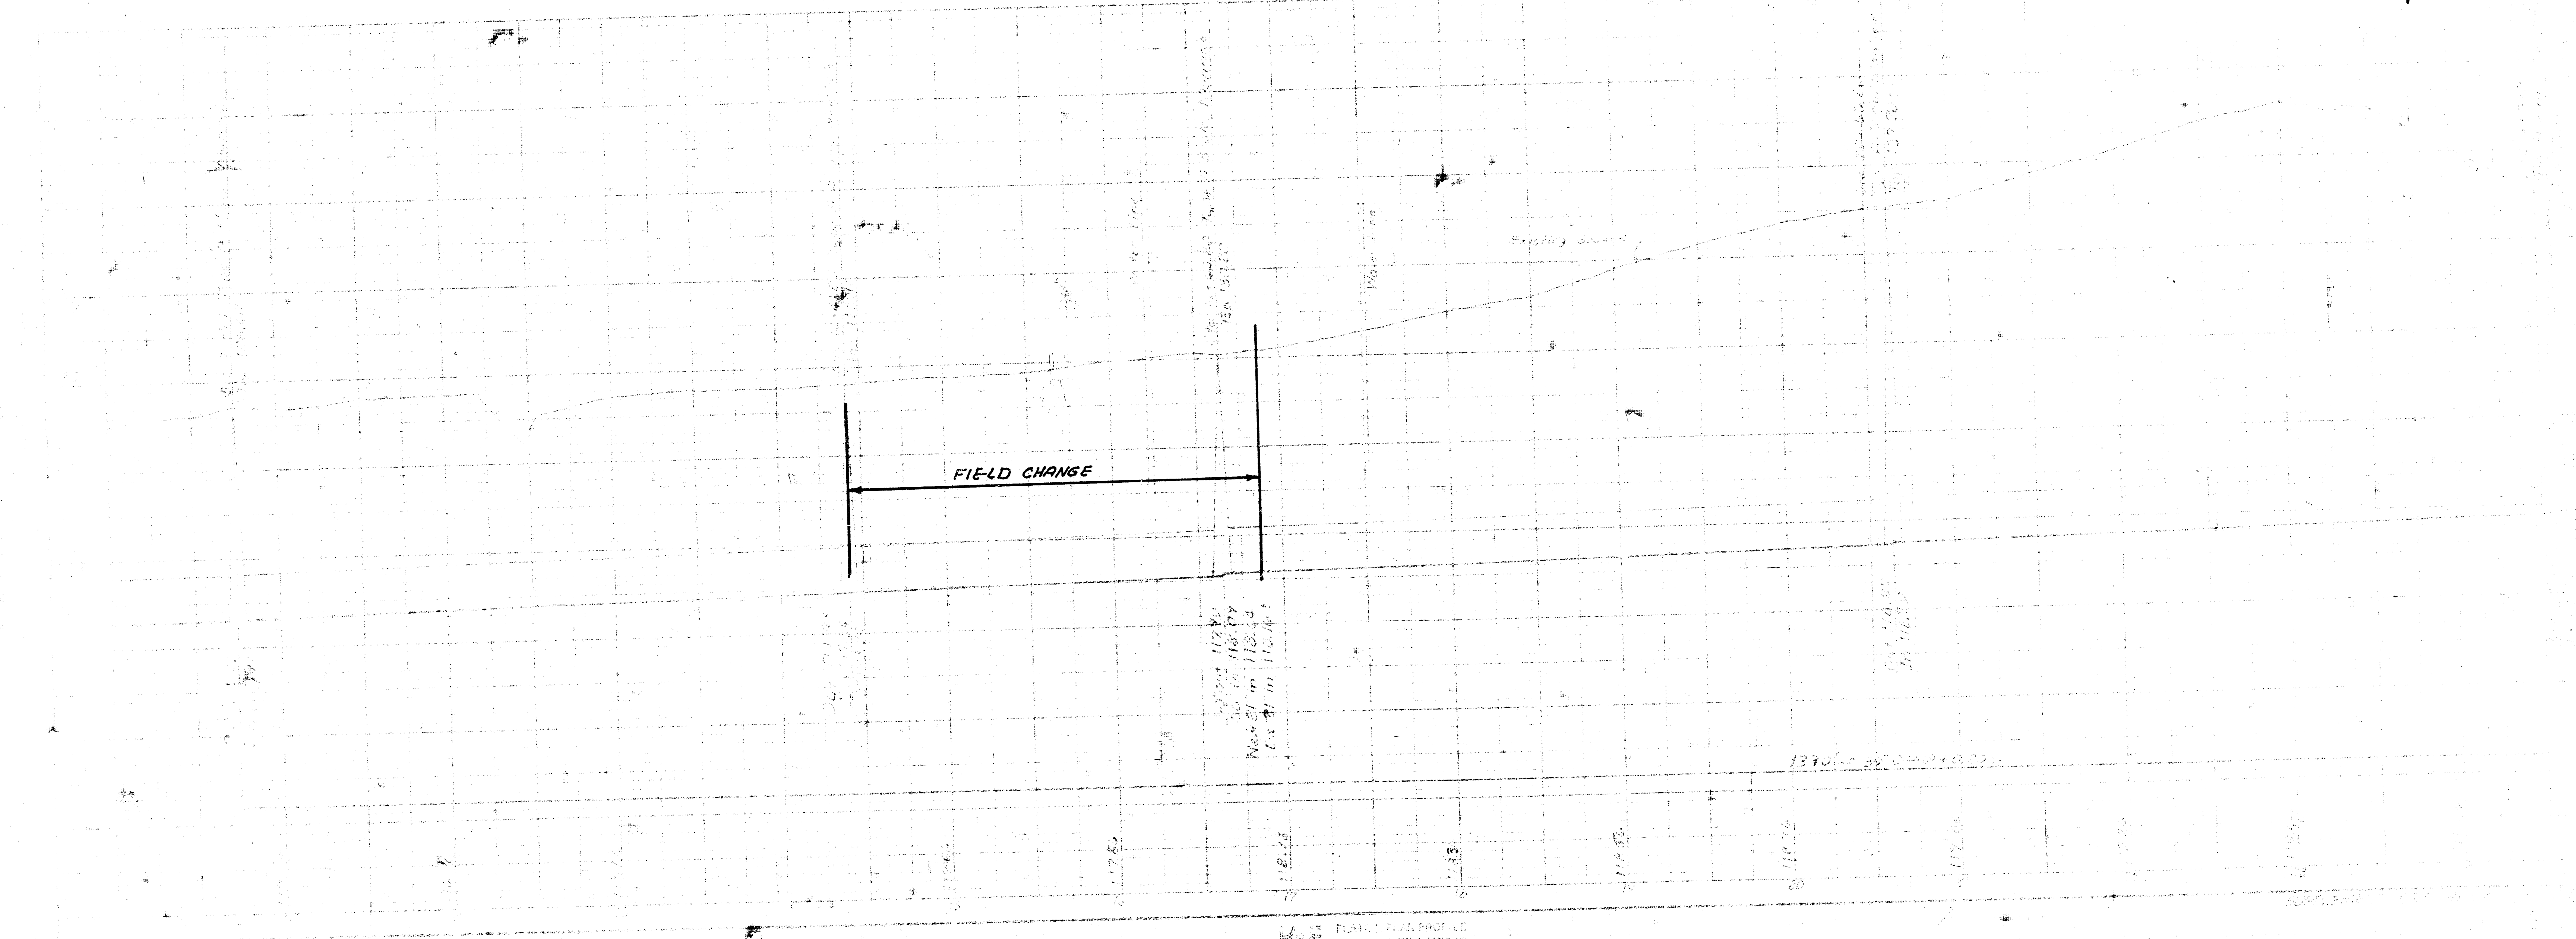

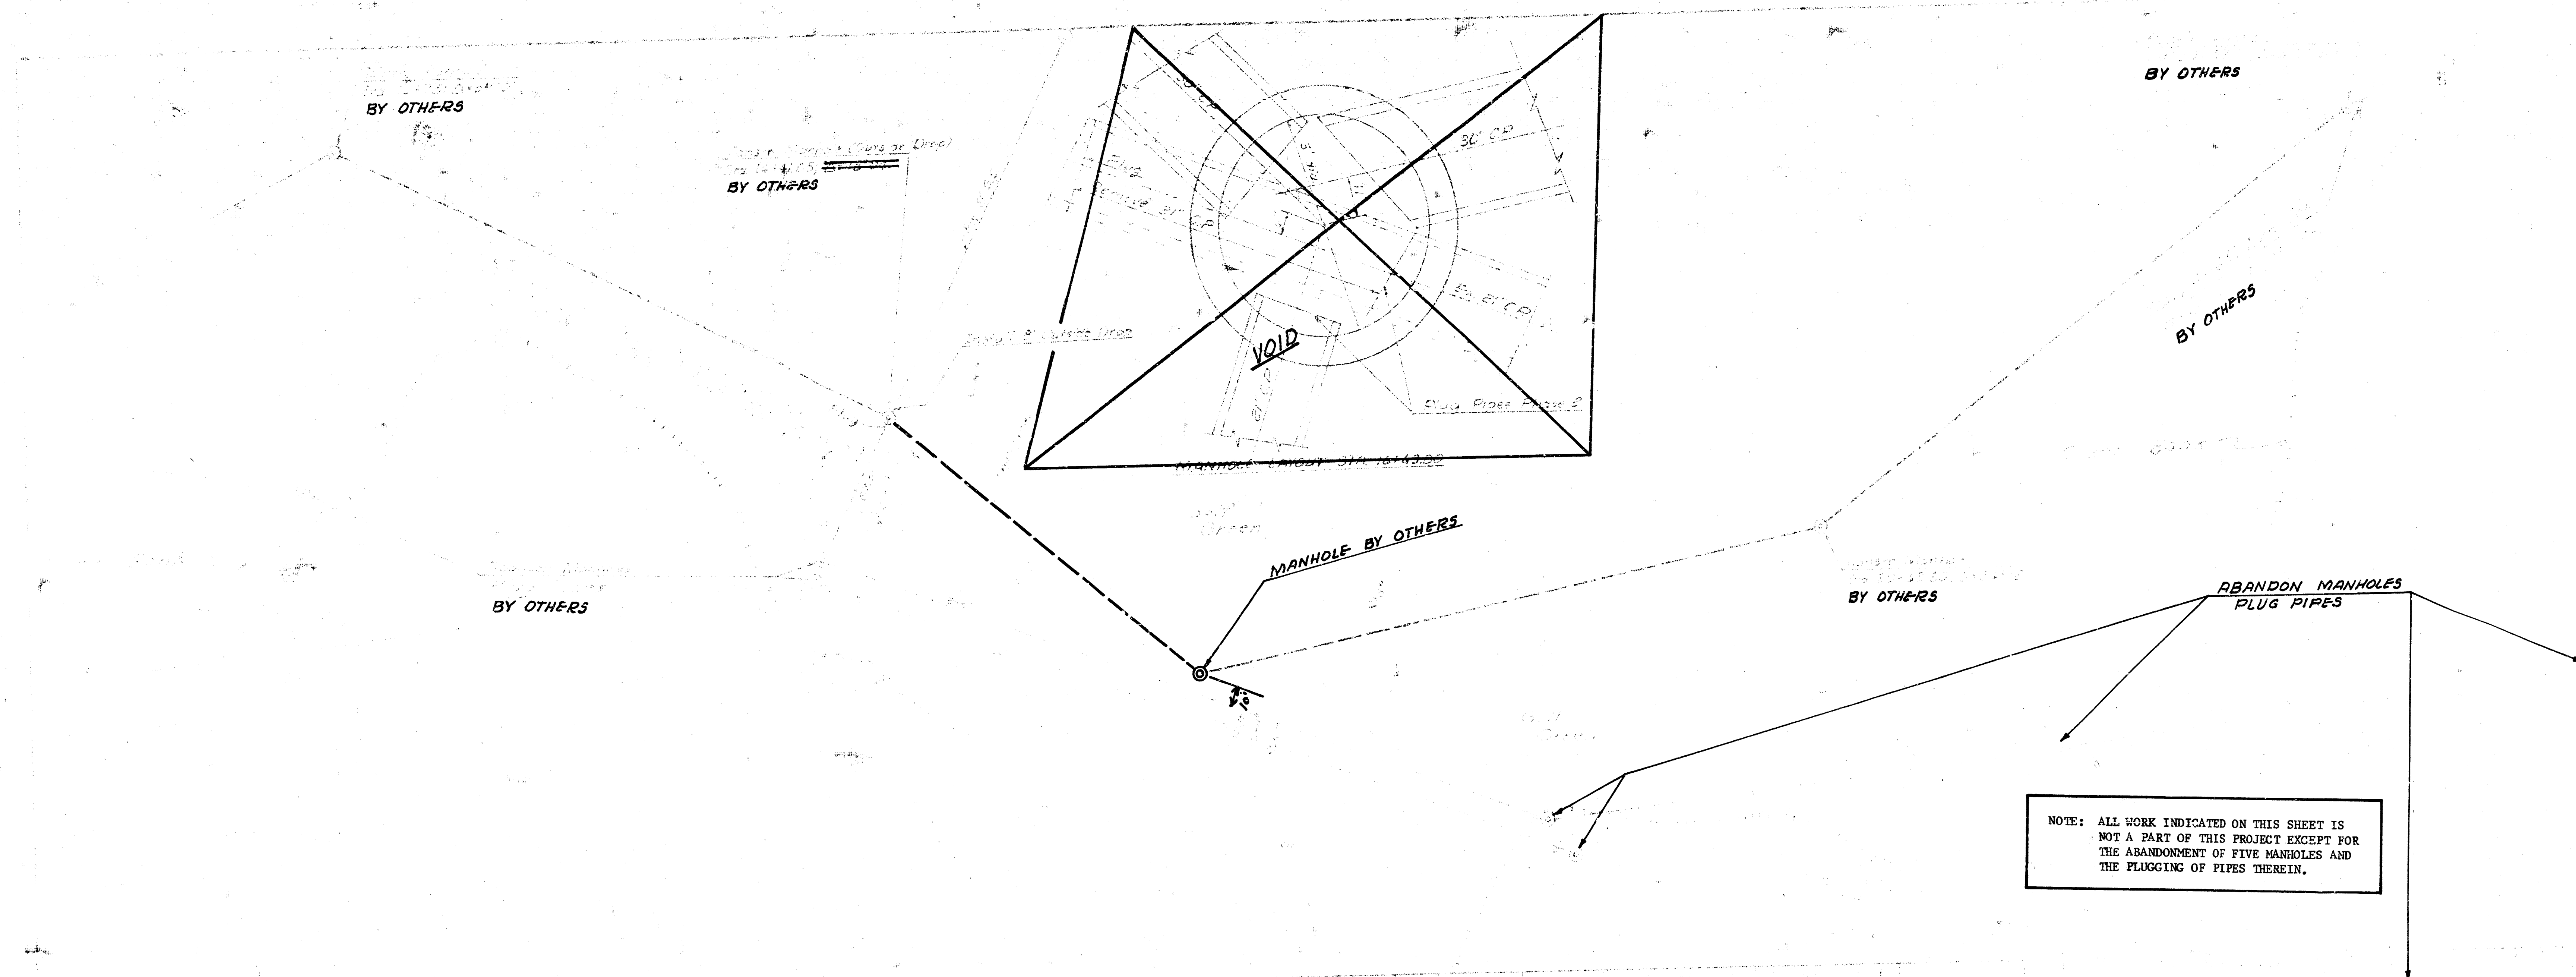

PLAN 195433 City Sid on West side to Red line
100' R. of Ditch on Harry

Const. Manhole with 30" stub N.E.
BY OTHERS

BY OTHERS

Connect to stub

Const. Manhole
28+57.4

Sta. 32+24.6
Const. Manhole

32+56.6

Exist. 12" Sewer

Abandon Manholes
Plug Pipes

NOTE: THIS PROJECT INCLUDES ALL WORK ON THIS
SHEET EXCEPT AS OTHERWISE NOTED.

CONNECT TO STUB