



PLAN SCALE 1/4" = 1'-0"
 PROFILE SCALE 1/4" = 4'-0" HOR, 1/2" = 4'-0" VERT.

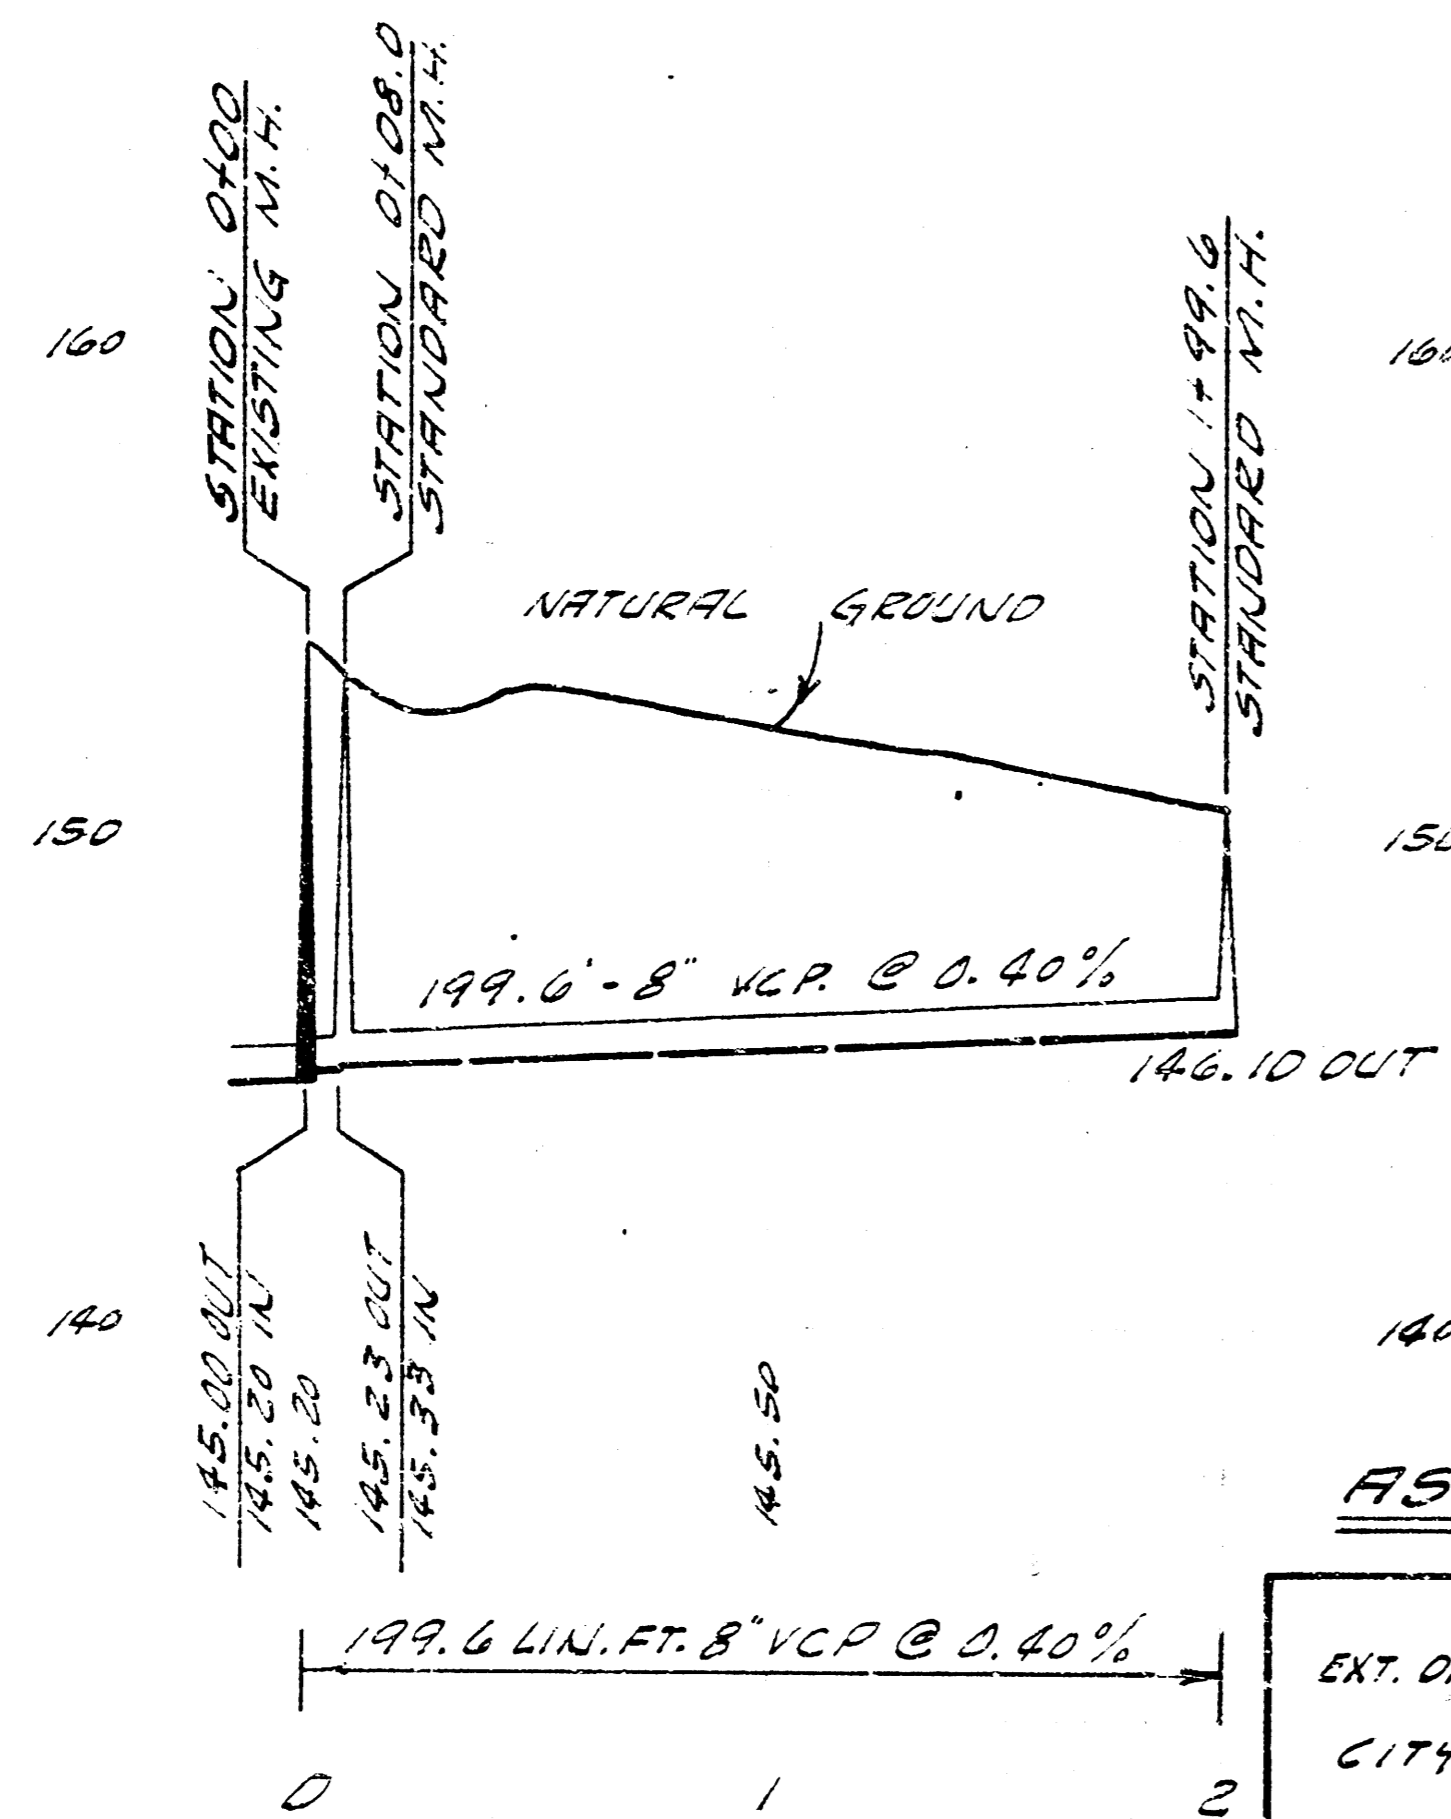


AS BUILT PLANS

EXT. OF LAT. 33 DCS SS 12
 CITY OF WICHITA, KANSAS
 B.E. SMITH CITY ENGINEER
 PRIVATE JOB. OCT., 1960

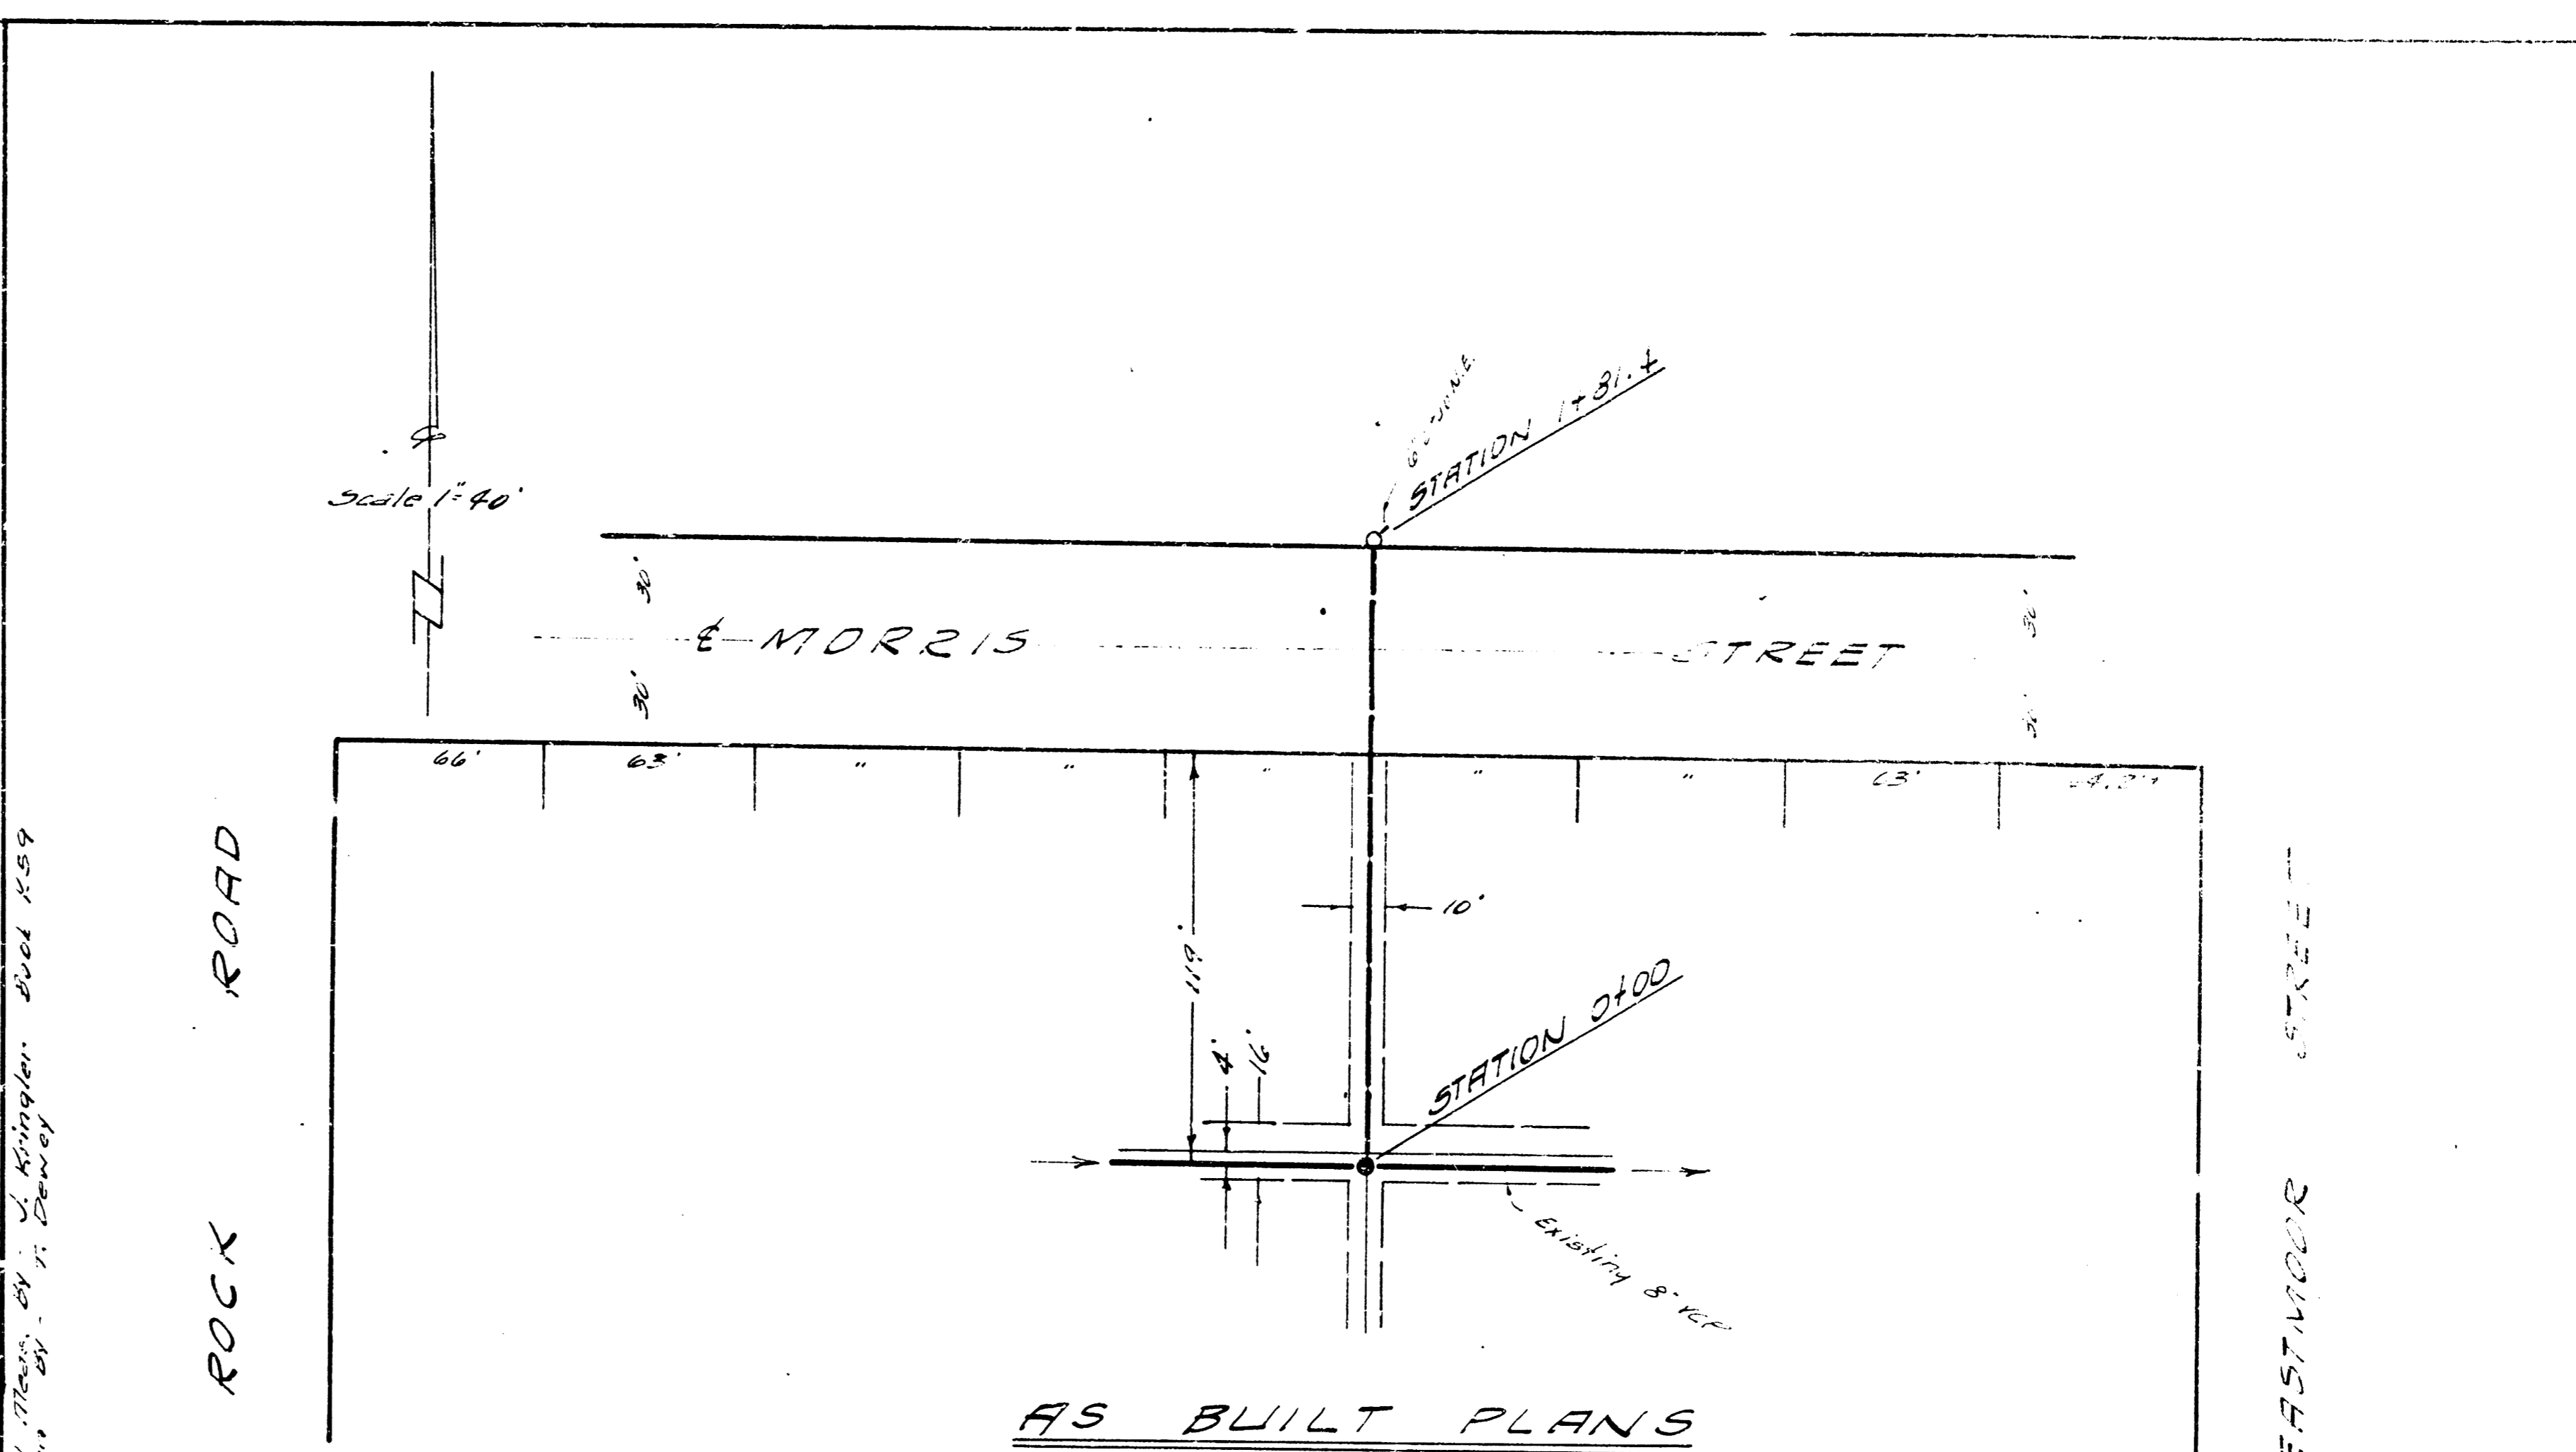

AS BUILT PLANS

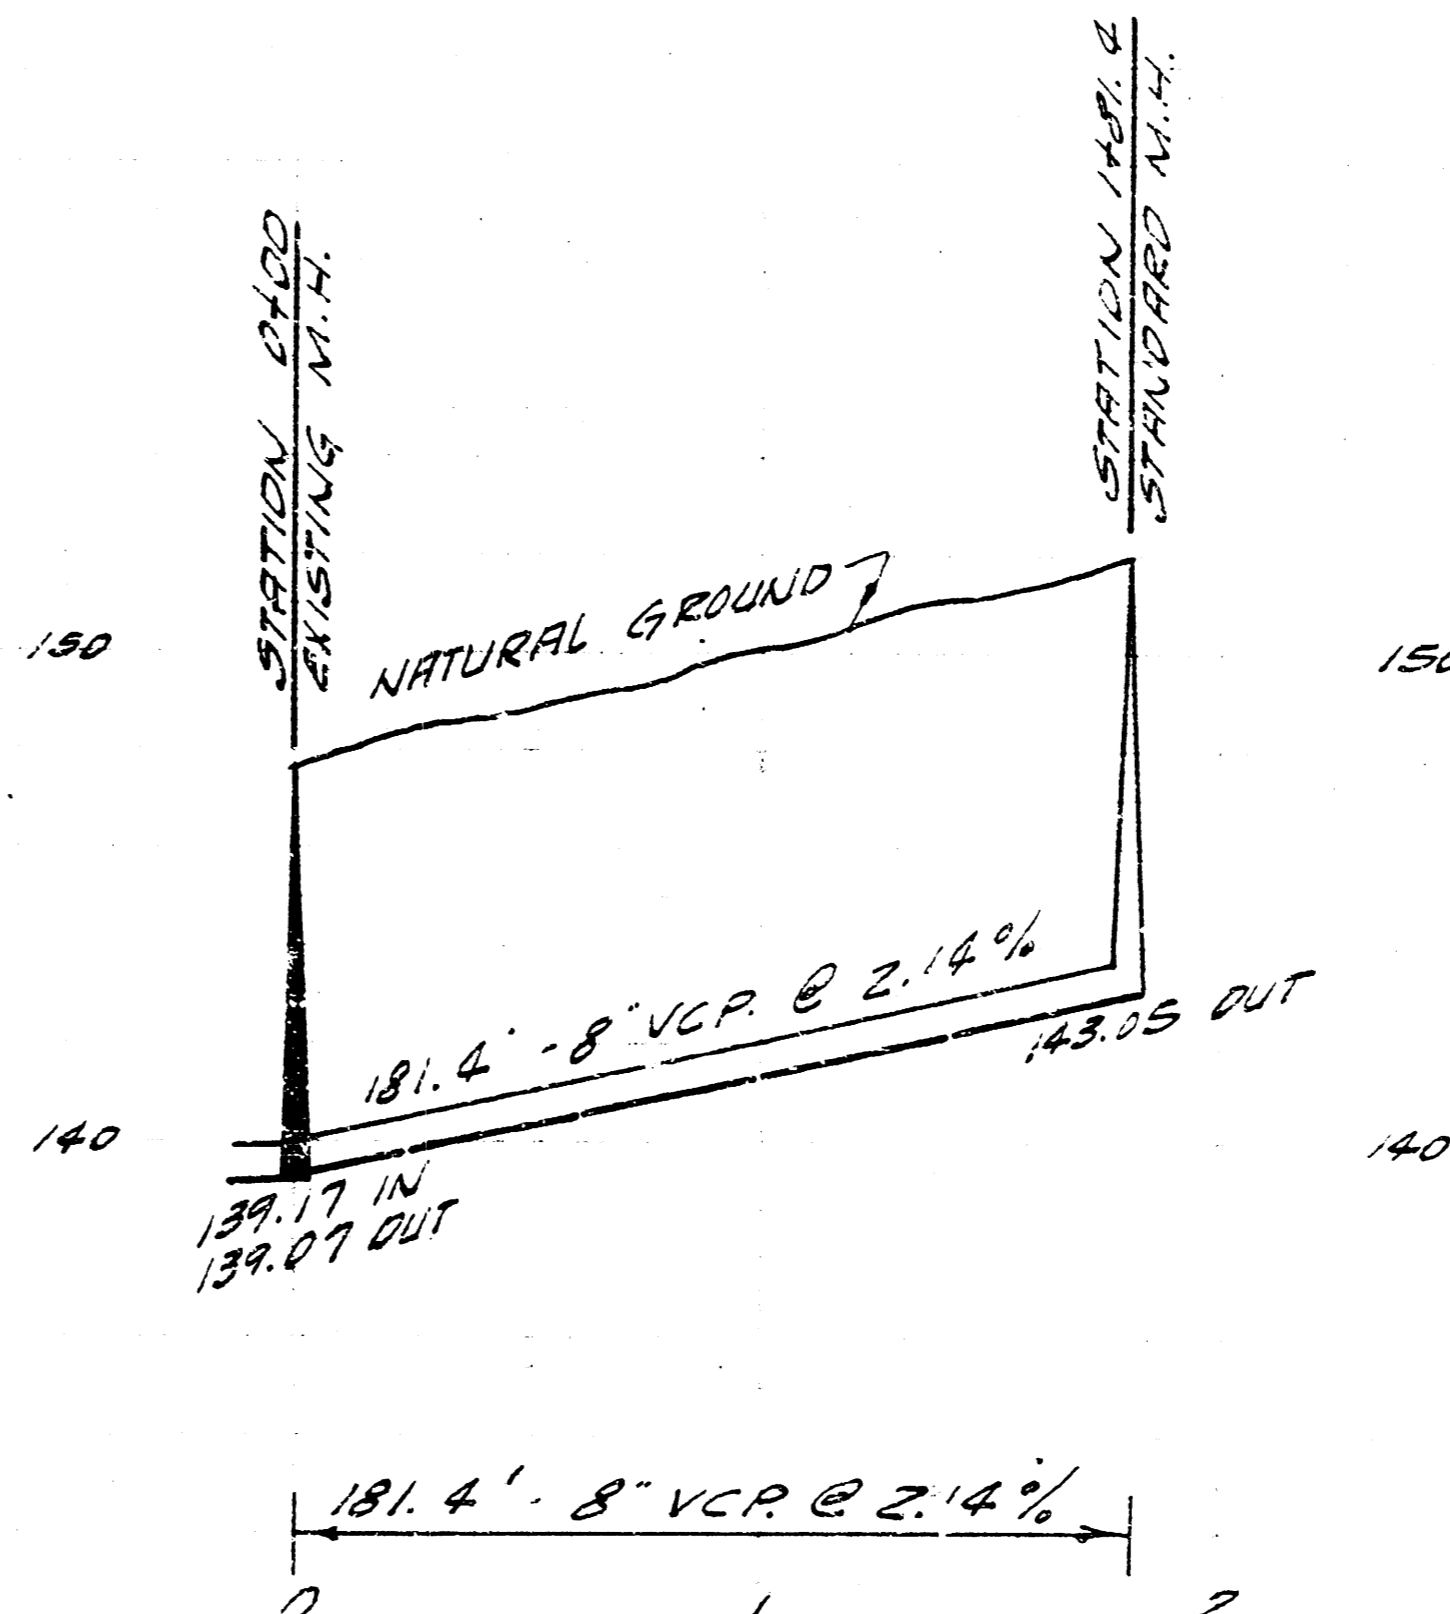

AS BUILT PLANS

EXT. OF LATERAL 28 W15
 CITY OF WICHITA, KANSAS
 B.E. SMITH CITY ENGINEER
 PRIVATE JOB. OCT., 1960