

PROJECT NO. 468-76-245-81449-000-000-001



NOTES:

1. Contractor shall be responsible for preserving property irons. Any irons distributed as a result of his operations shall be re-established at the contractor's expense. Any such work shall be performed by a licensed surveyor or professional engineer.
2. The contractor shall contact the utilities prior to any excavation to determine the location of existing or future underground utilities in the project area.

CITY ENGINEER






BAUGHMAN COMPANY, P.A.
SURVEYING & ENGINEERING
316/262-7271 • 330 LAURA • WICHITA, KANSAS 67211

FEBRUARY 1986

FILMED FROM THE BEST
AVAILABLE COPY

B.M. - R.R. SPIKE IN W. FACE POWER POLE
132' S. OF S. LINE KELLOGG & 10' W. OF E. LINE
PINECREST, ELEV. 154.33

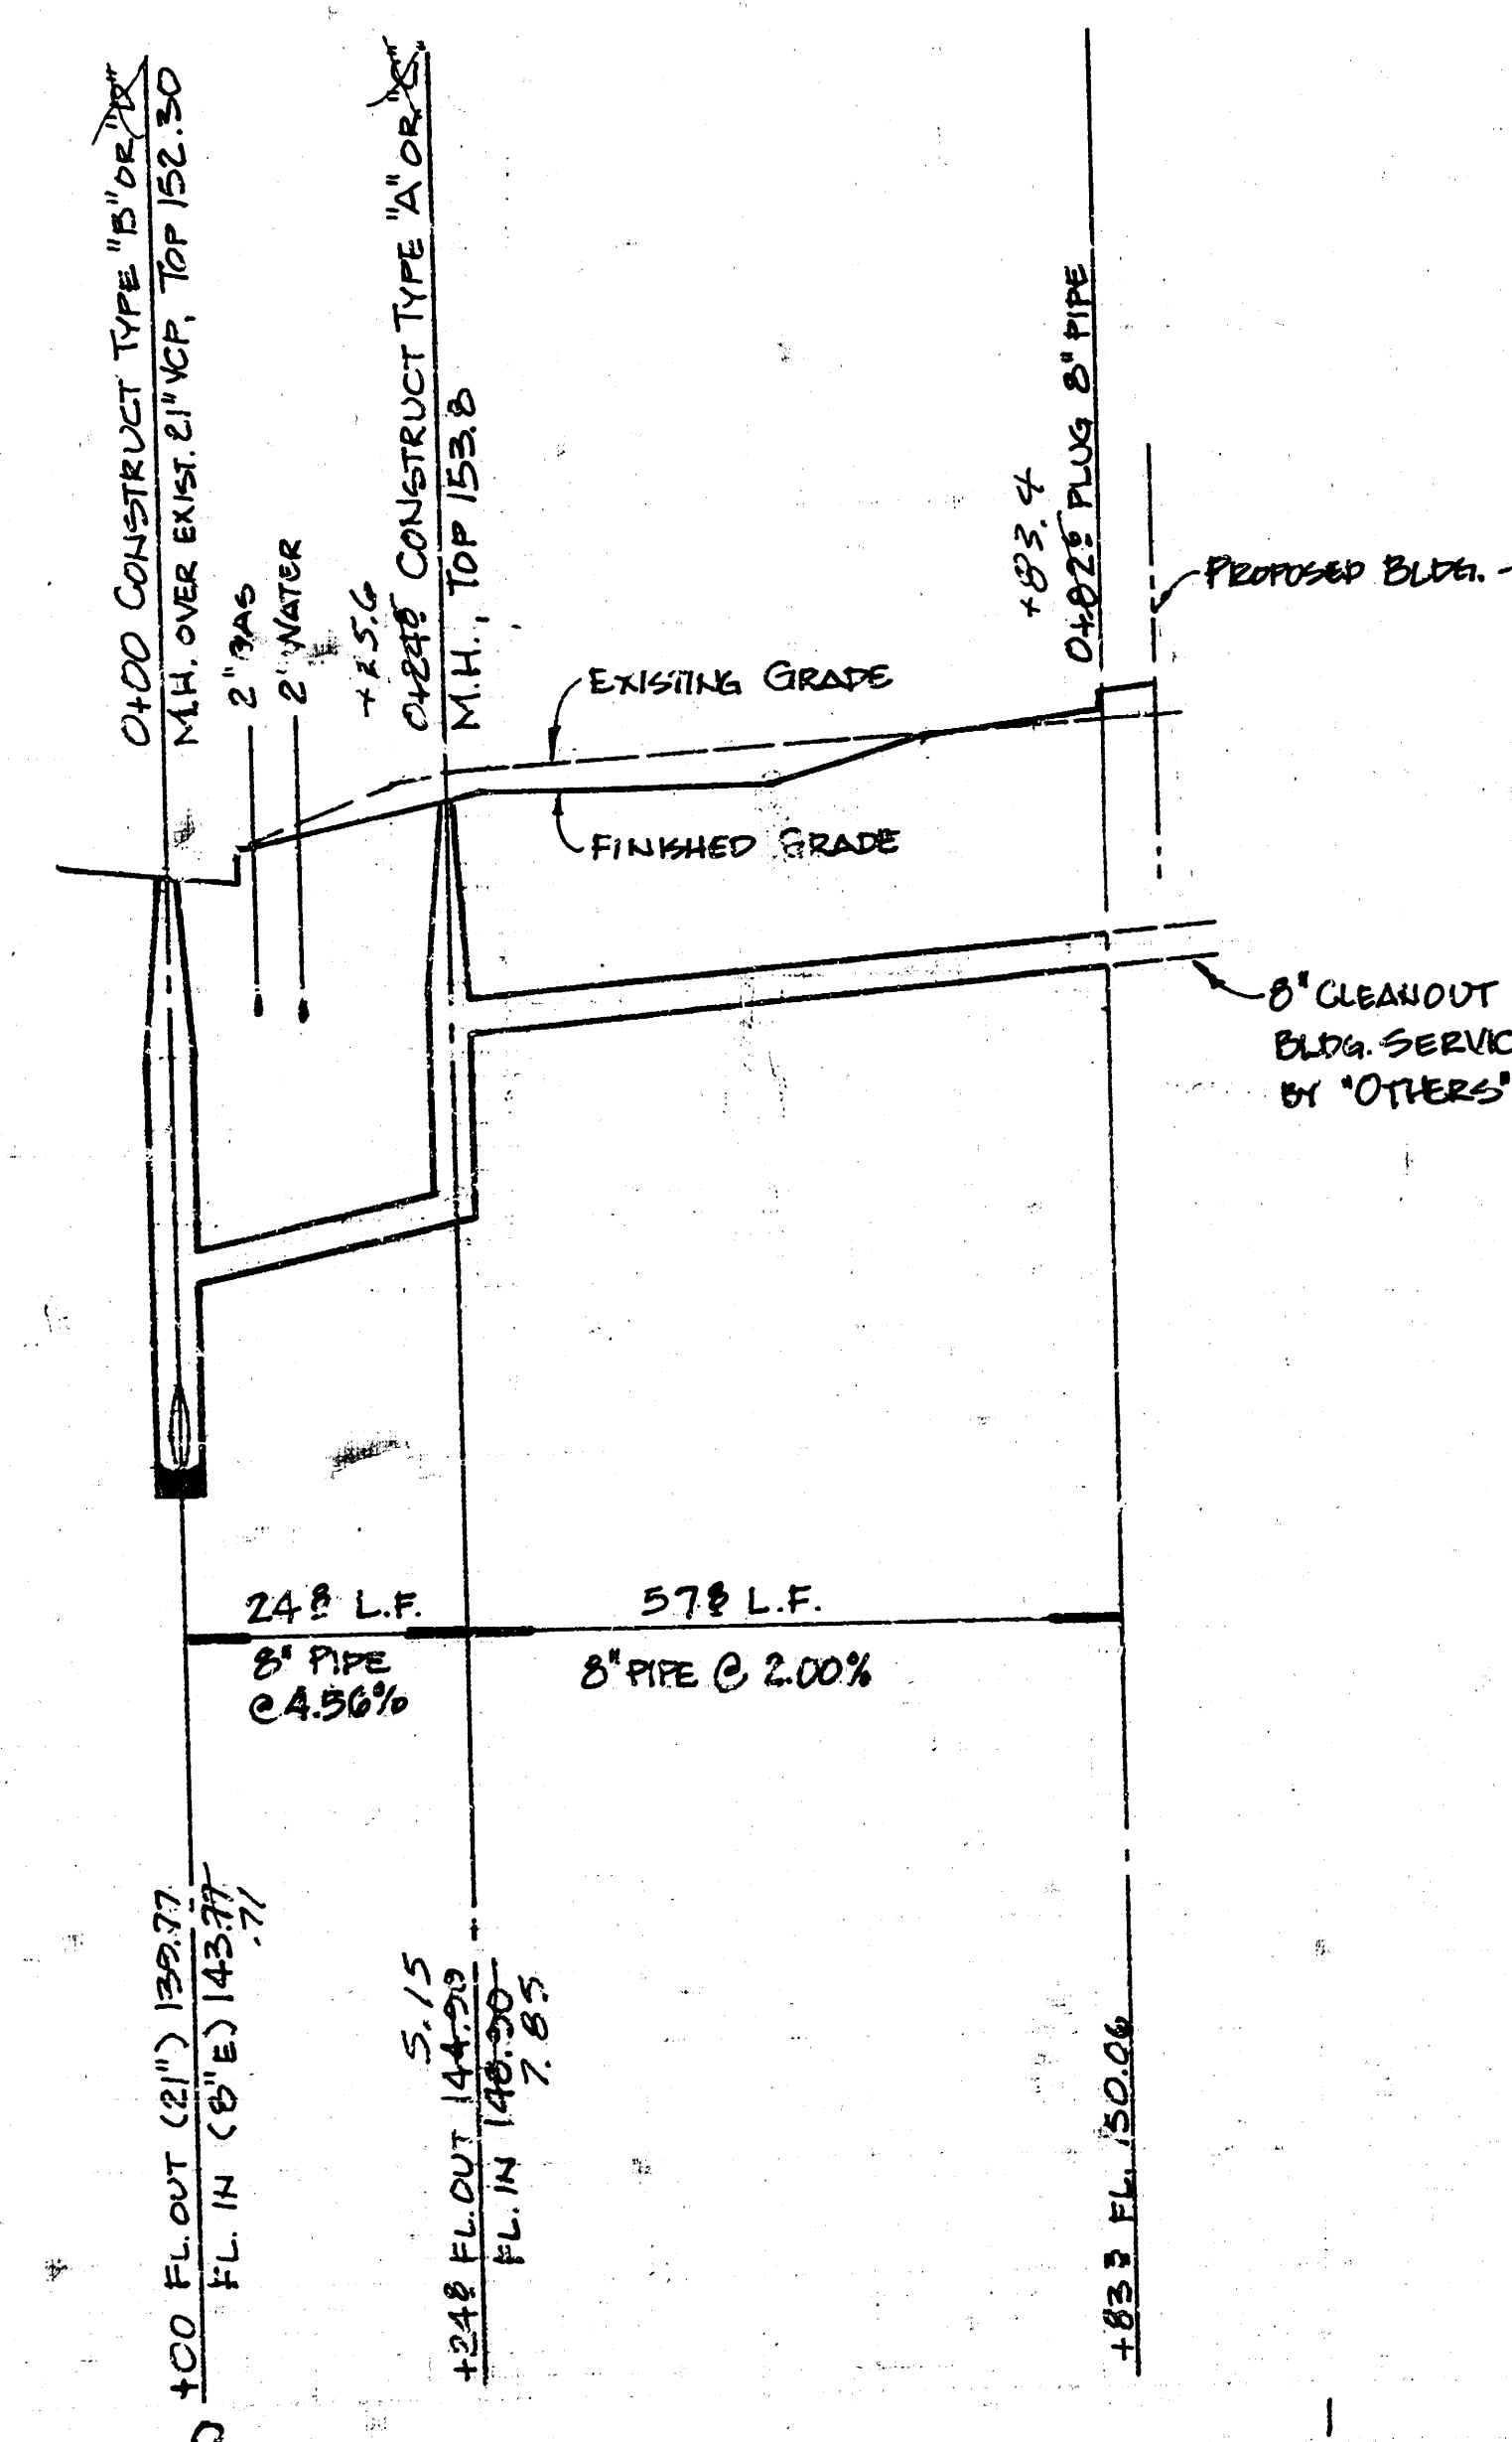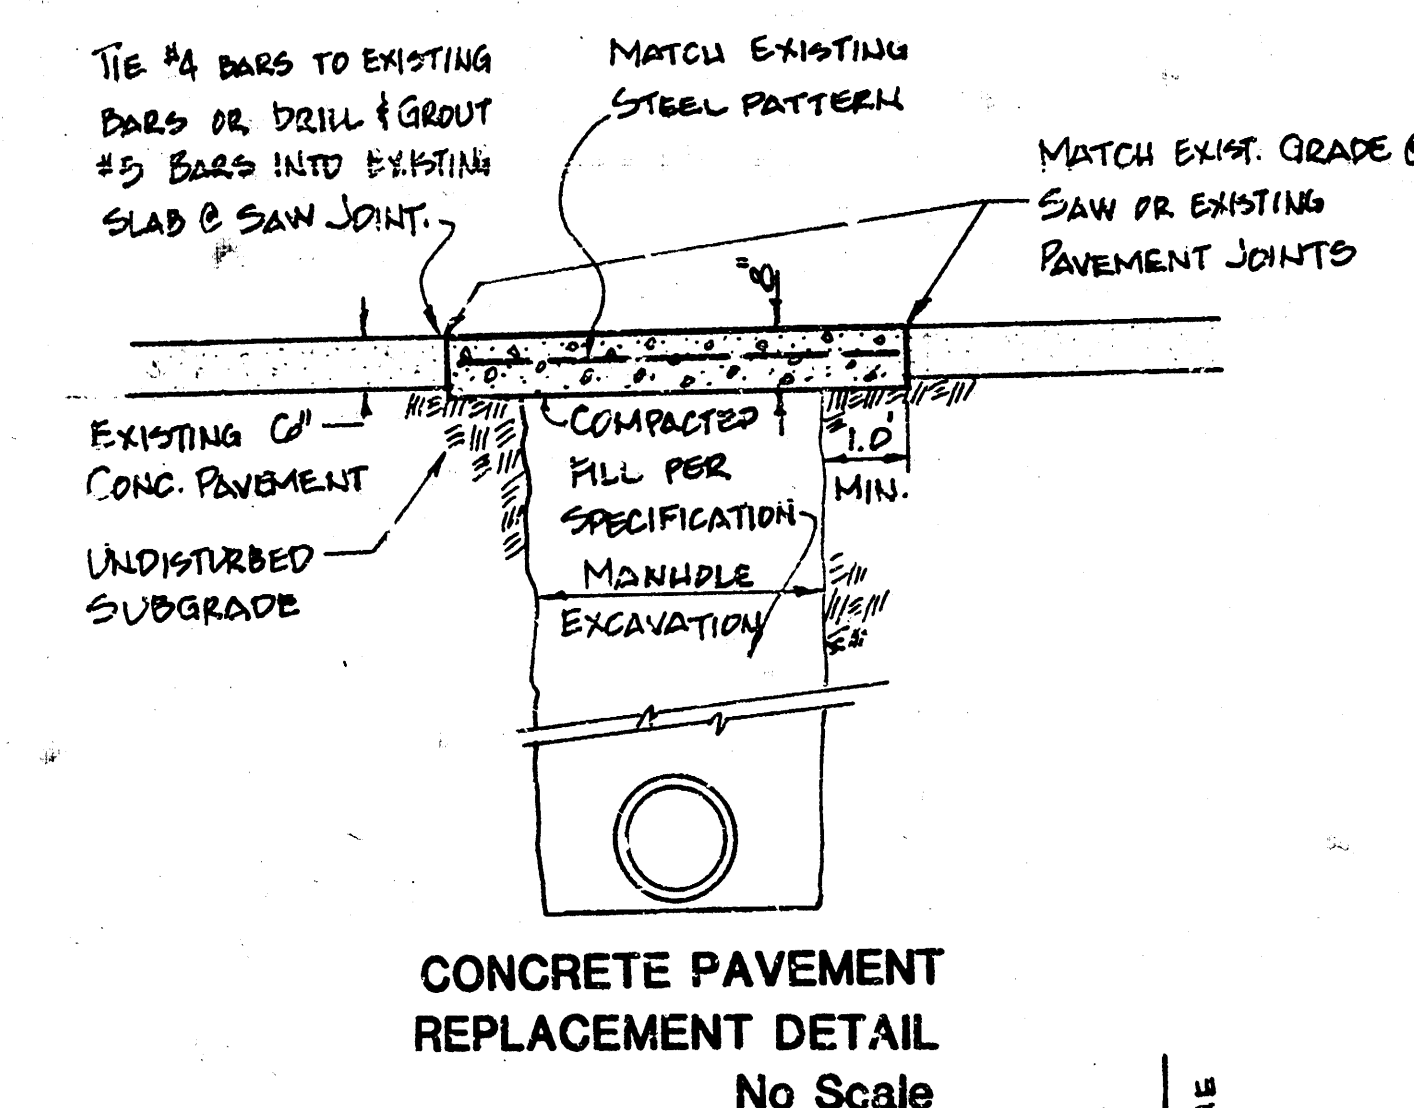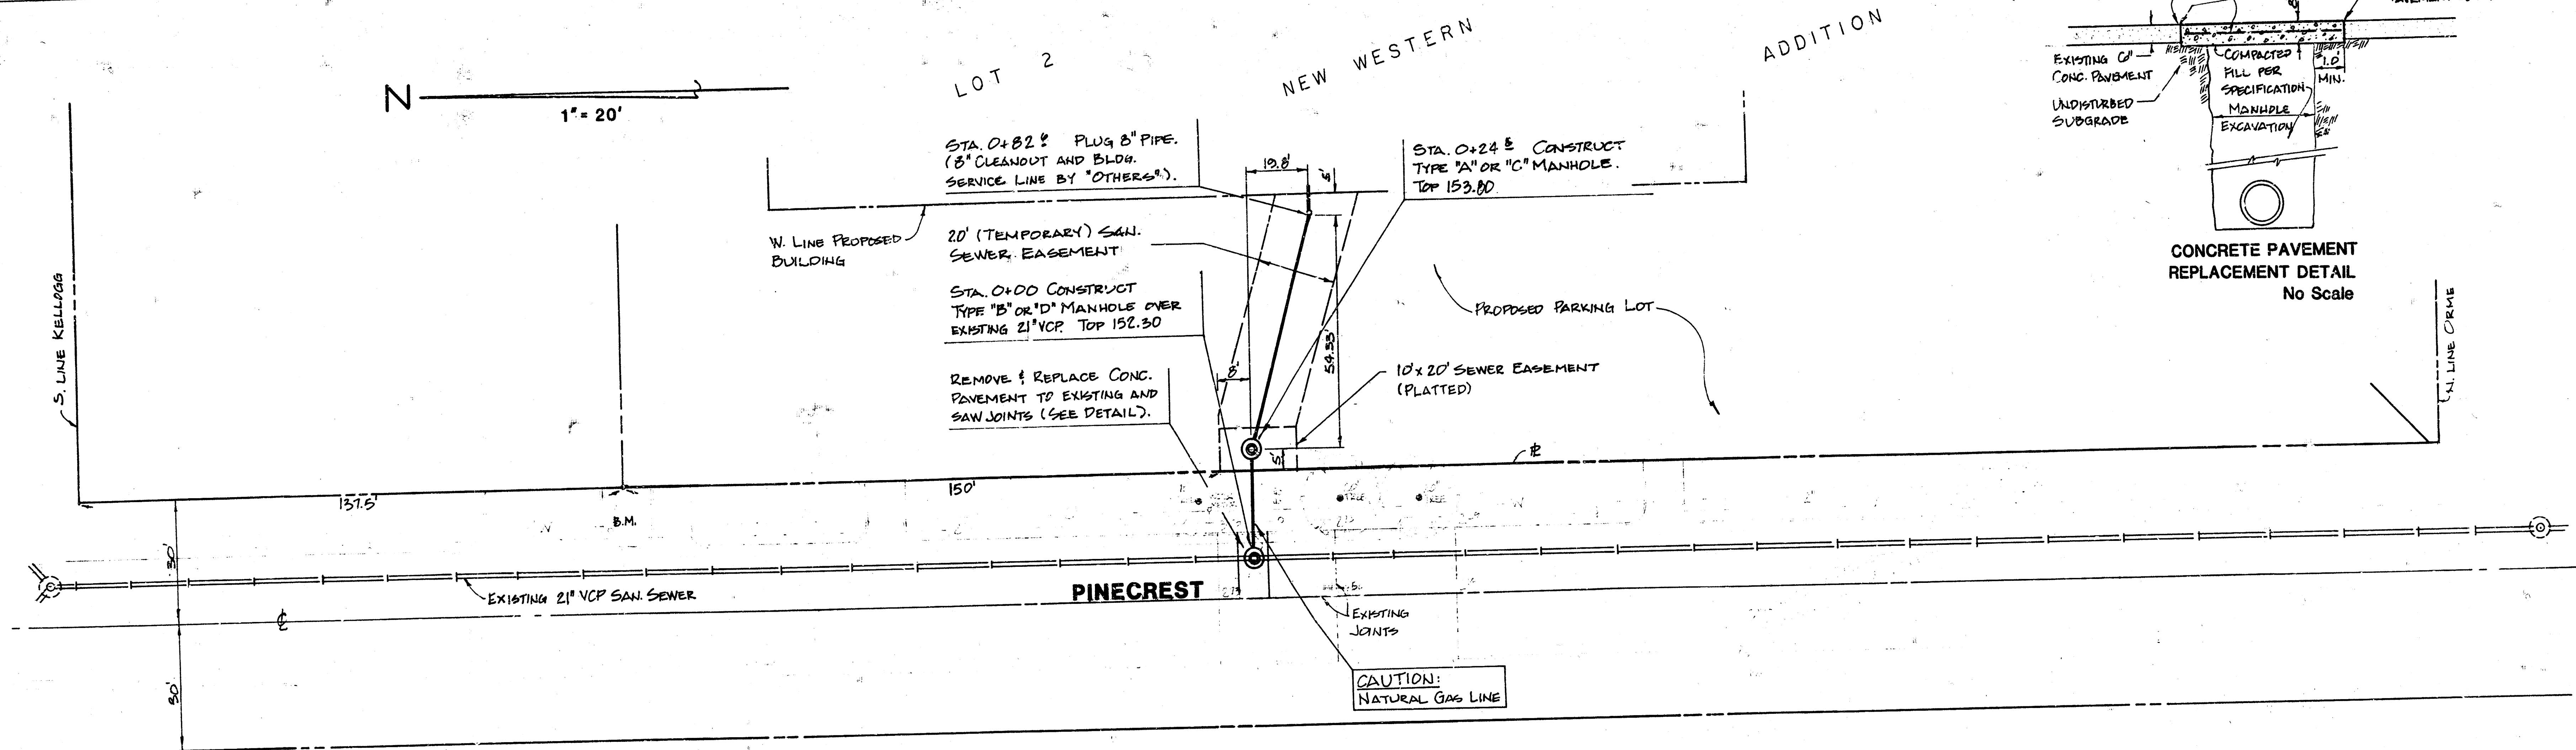

AS BUILT
RPL
5-22-86

LATERAL 70, MAIN 1, S.S. 12	
NEW WESTERN ADDITION	
CITY OF WICHITA, KANSAS	
Project number: 488-72-245-81149-000-000-001 2/2	
BAUGHMAN COMPANY, P.A. SURVEYING & ENGINEERING 316/263-7271 • 300 LAURA • WICHITA, KANSAS 67211 2/2	