

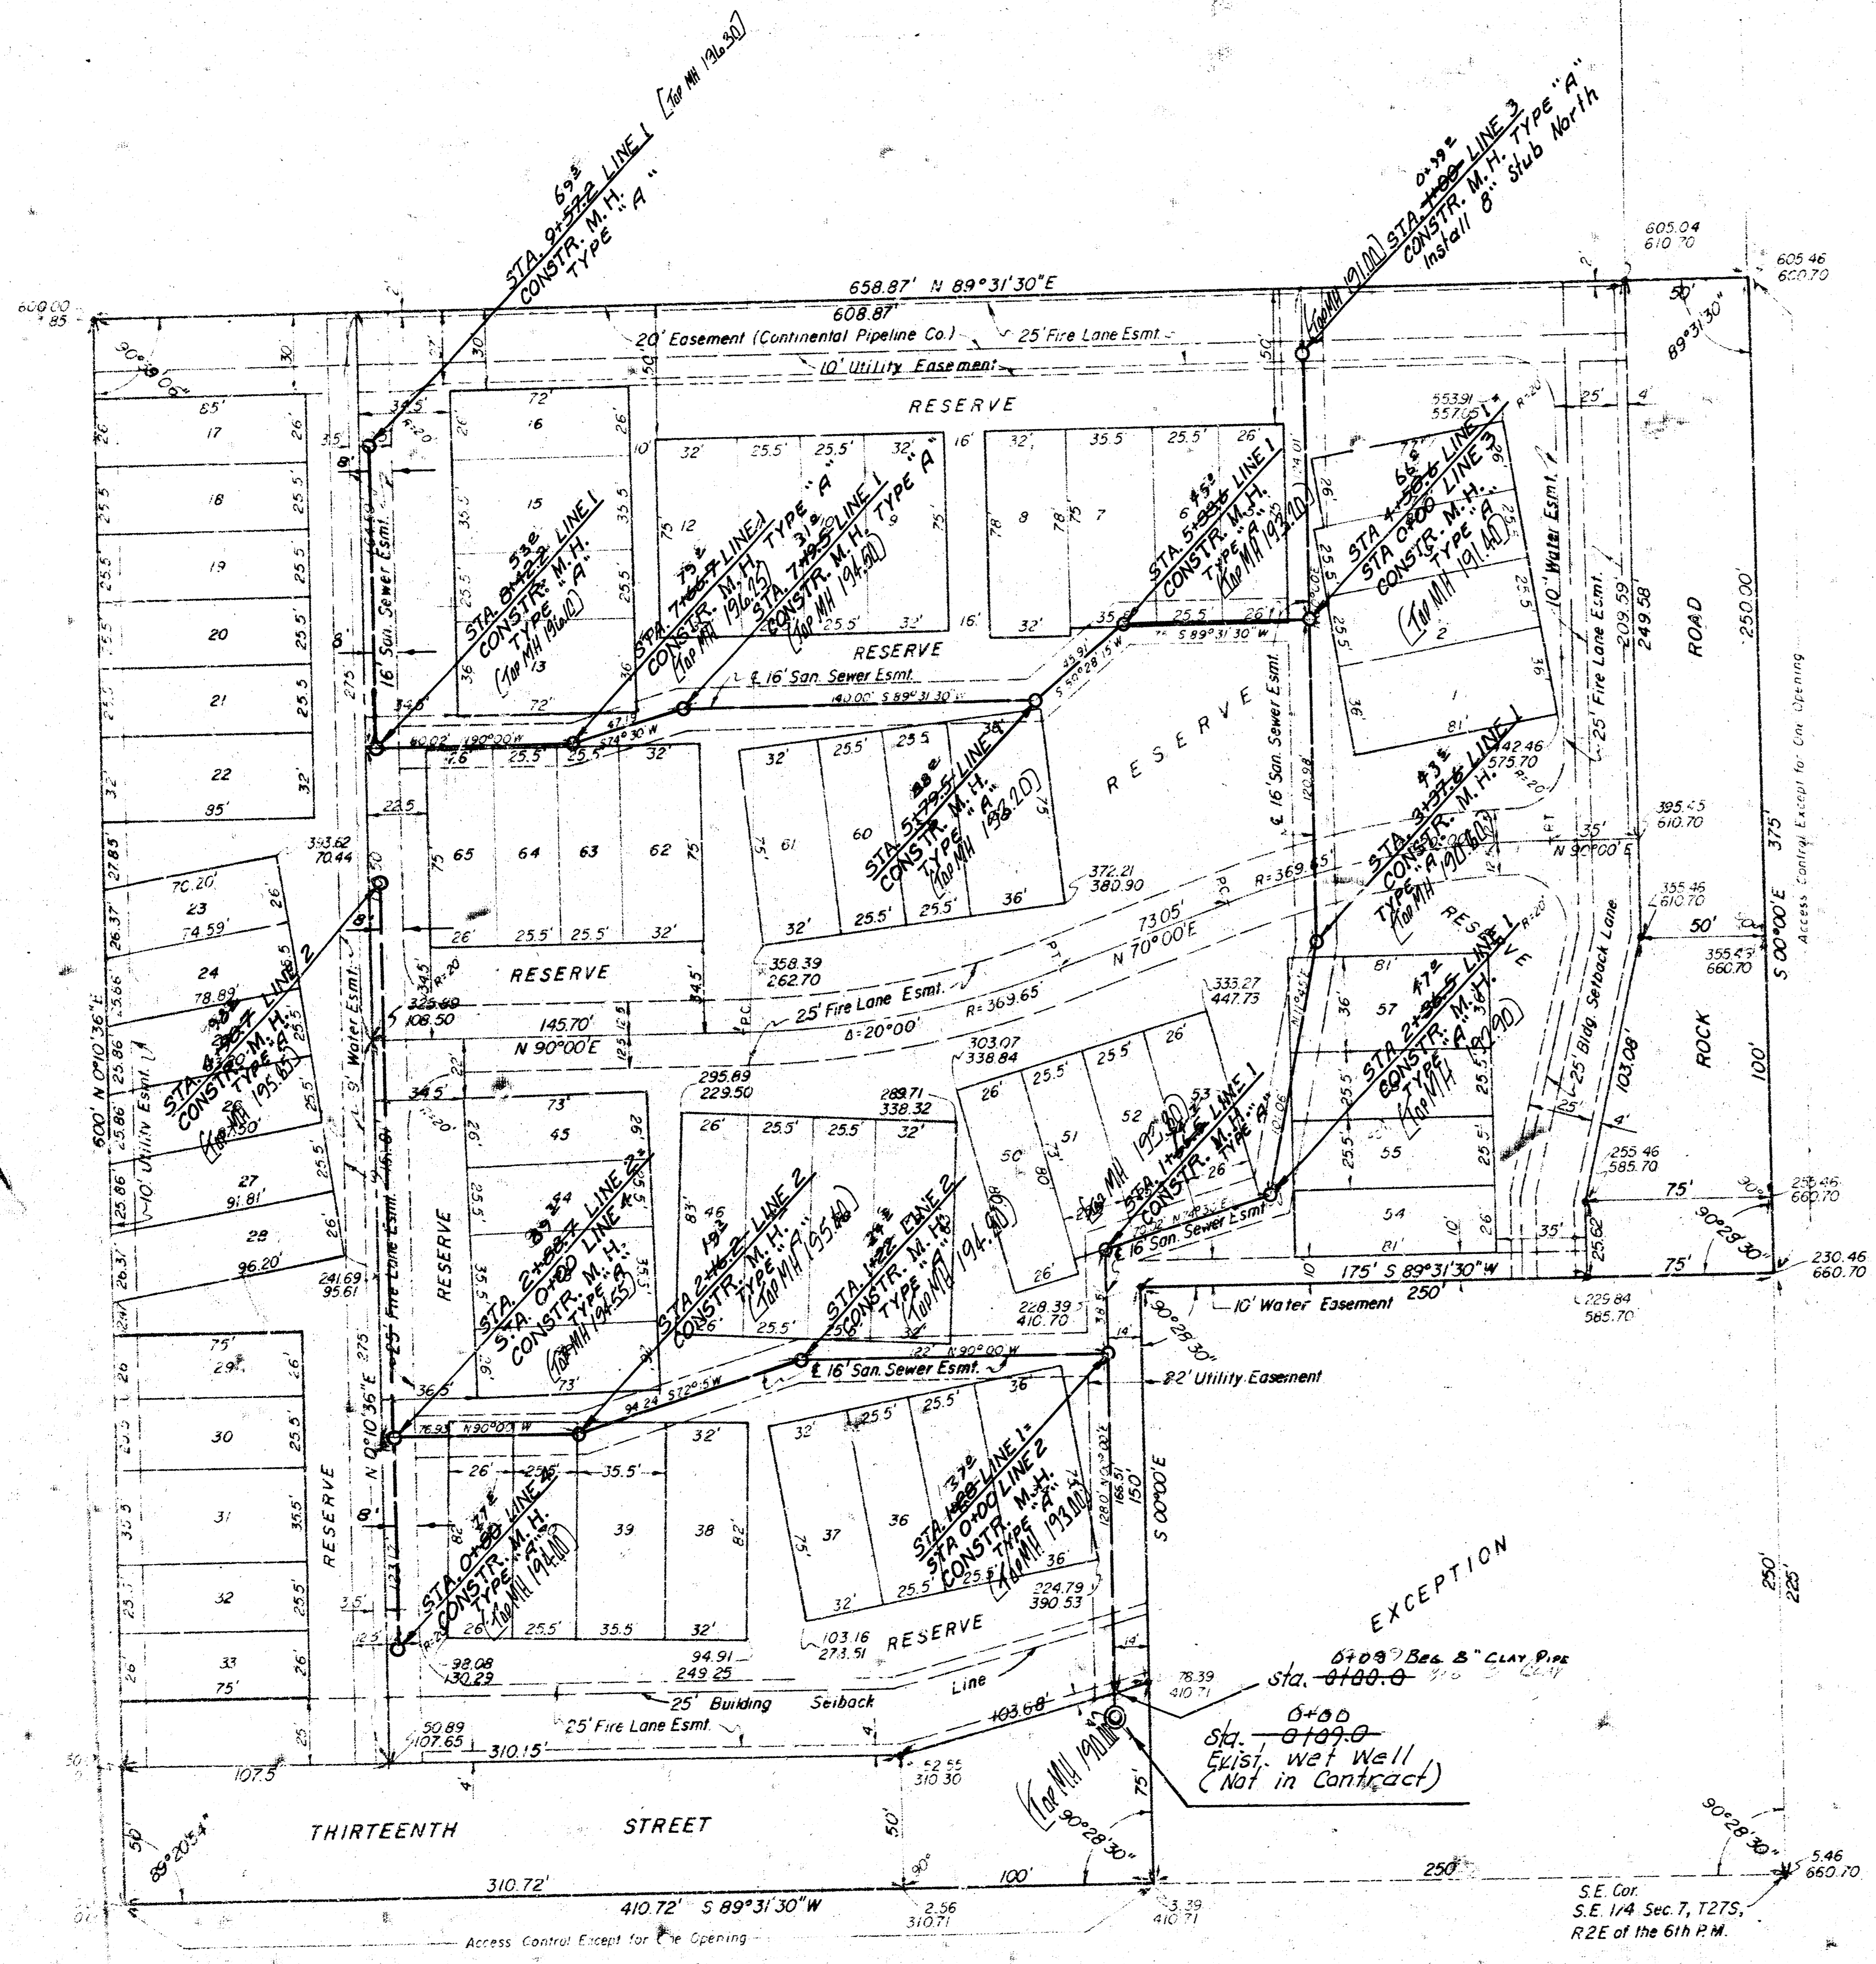


Plan by  
L.W.L.  
C.R.W.  
Notes by others

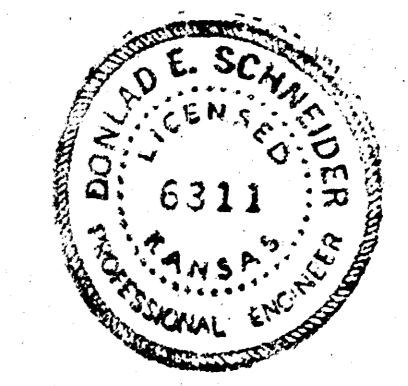

1" = 40'  
• = Iron

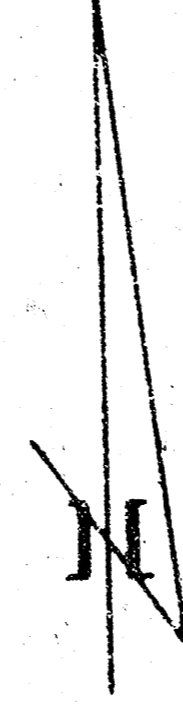


"As Built"  
FINAL MEASUREMENTS 1.11.59

LAT. 94, DRY CREEK MAIN 2, S. S. 12  
 R. W. LINN CITY ENGINEER  
 CITY OF WICHITA, KANSAS  
 PROJ. NO. DBKL 572065  
 DATE: DEC. 1972

SE Cor.  
 S.E. 1/4 Sec. 7, T27S,  
 R2E of the 6th P.M.


EXCEPTION  
 0+00 Beg. B" CLAY PIPE  
 Sta. 0+00.0  
 0+00  
 Sta. 0+00.0  
 Exst. Well  
 (Not in Contract)

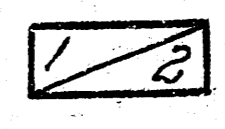

1/2

S. M. 188.16 R. R. Spike in Power Pole N.E. Cor. 13th and Rock Rd.

NOTE: Contractor to contact developer to establish top of manhole elevations.

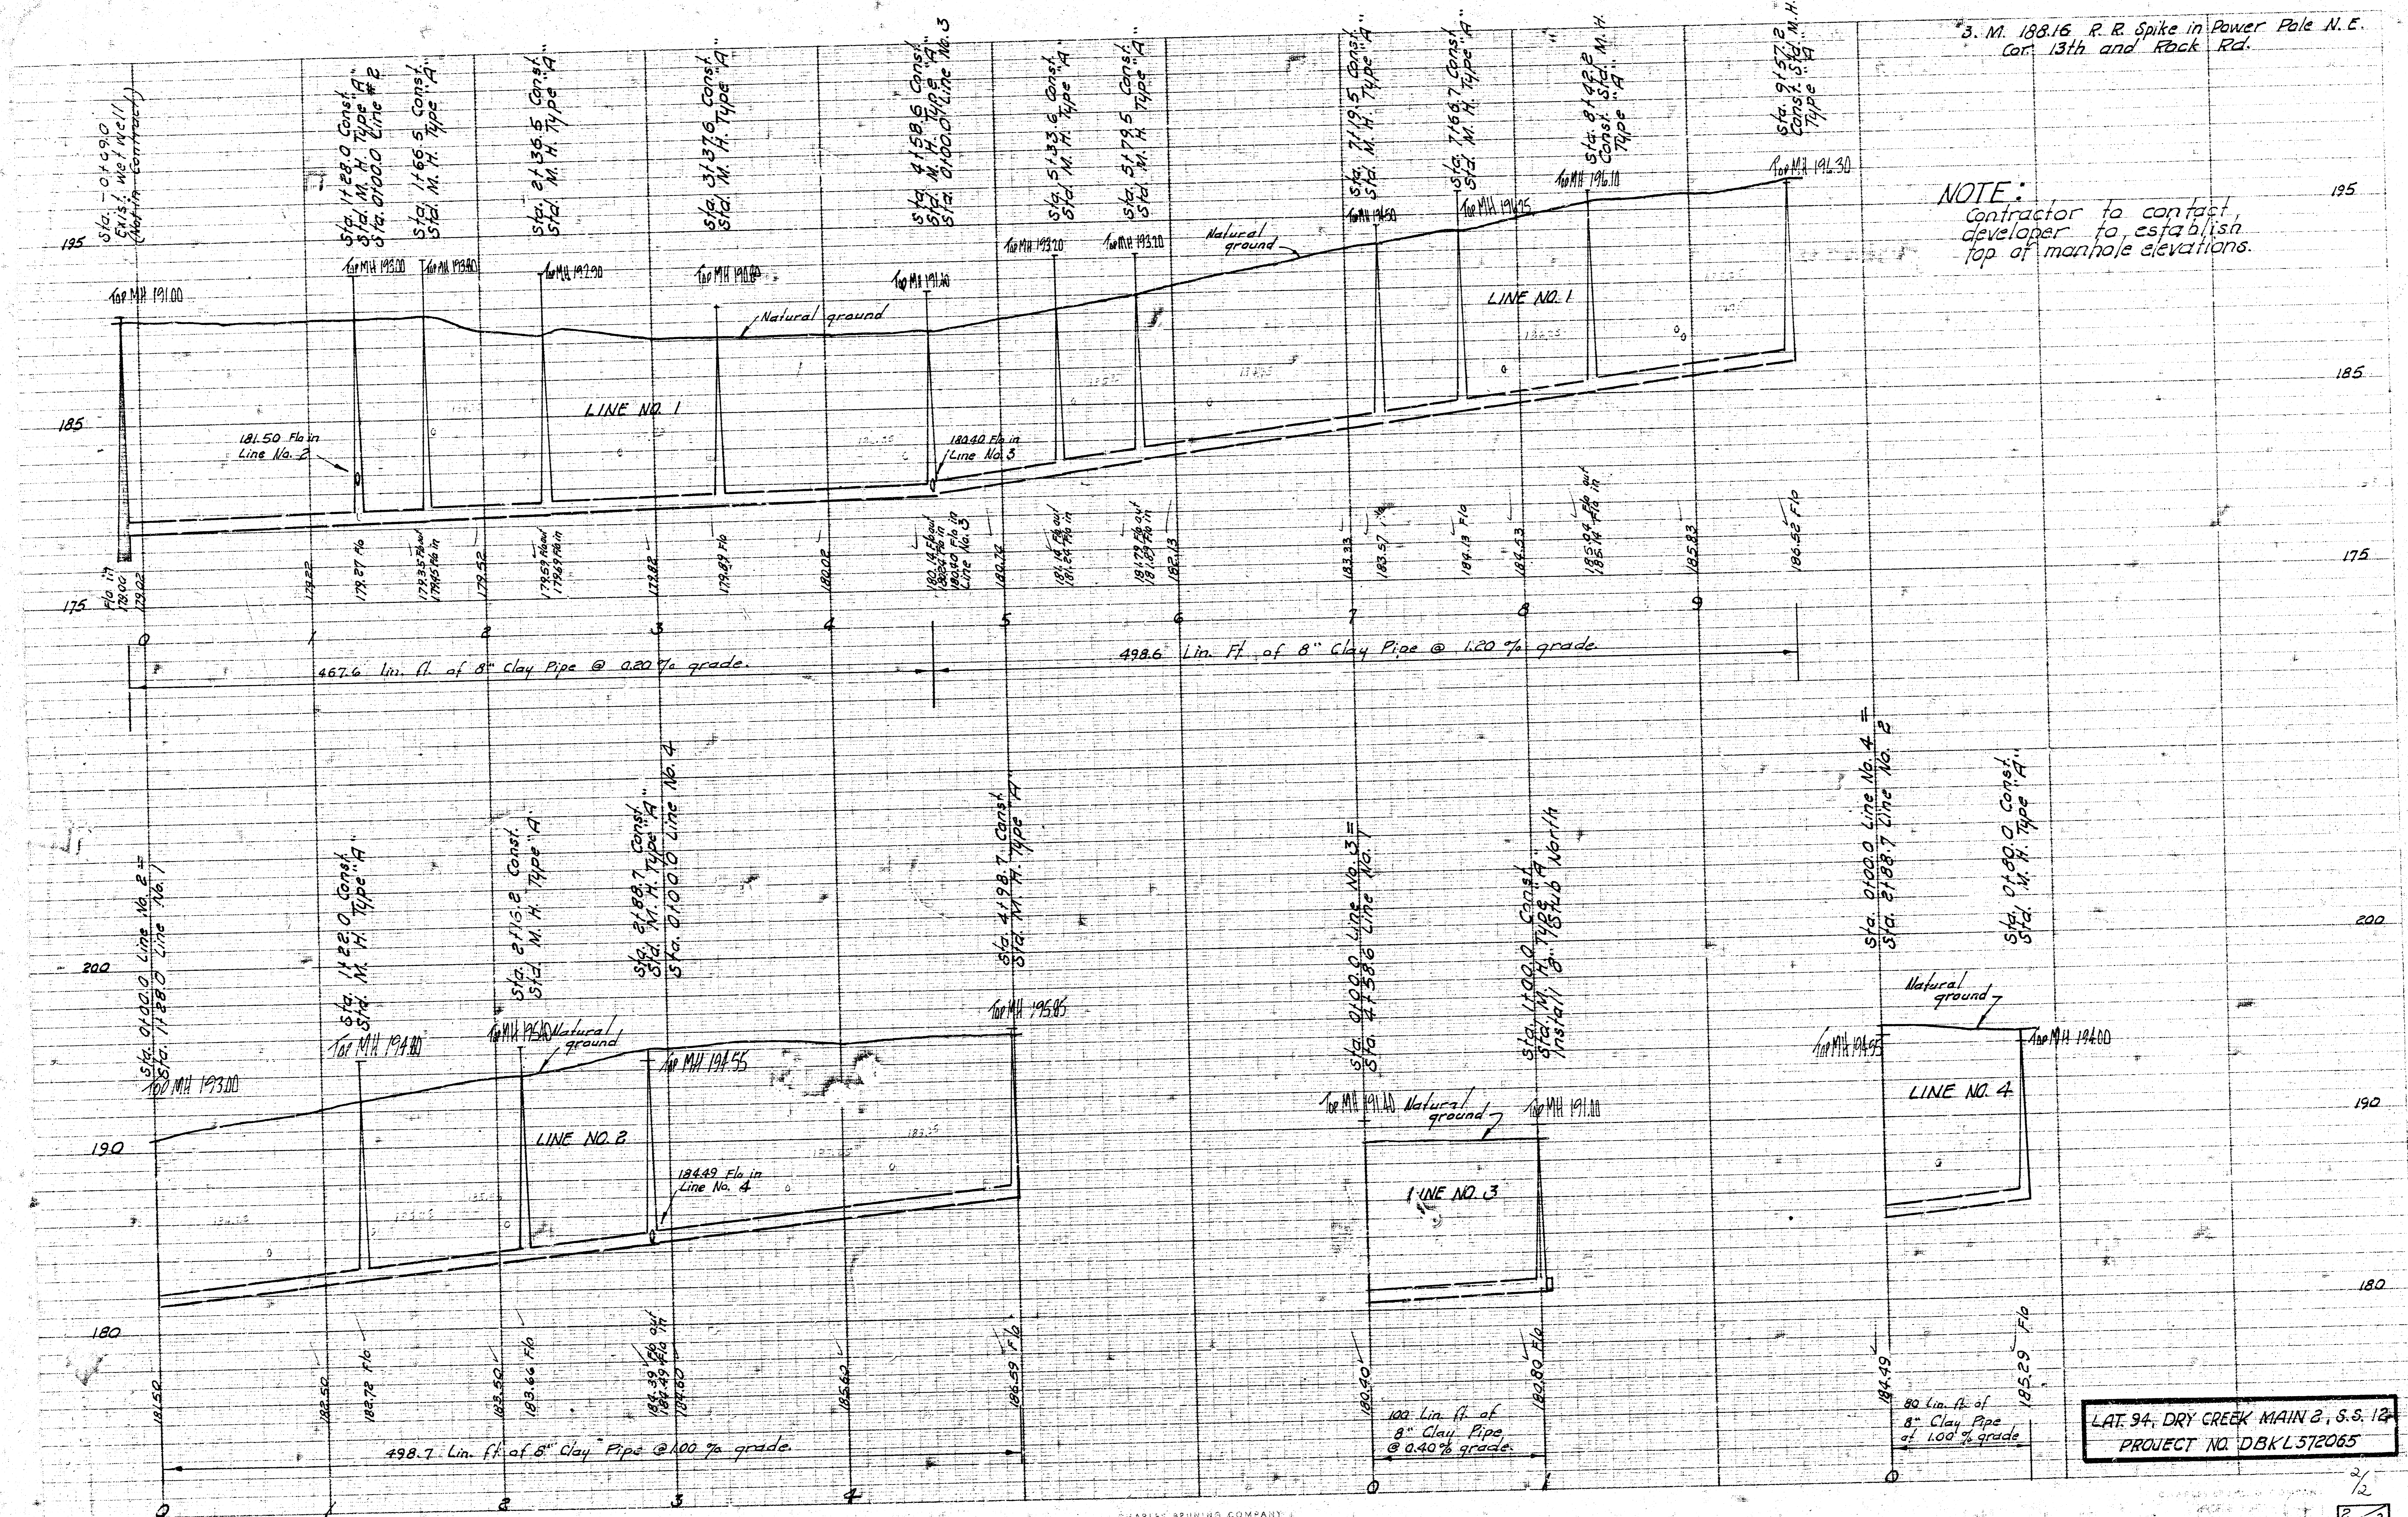

LAT. 94, DRY CREEK MAIN 2, S.S. 12  
PROJECT NO. DBK L572065

CHARLES BRUNING COMPANY  
PROFILE PLATE A

2/2

FILMED FROM THE BEST