

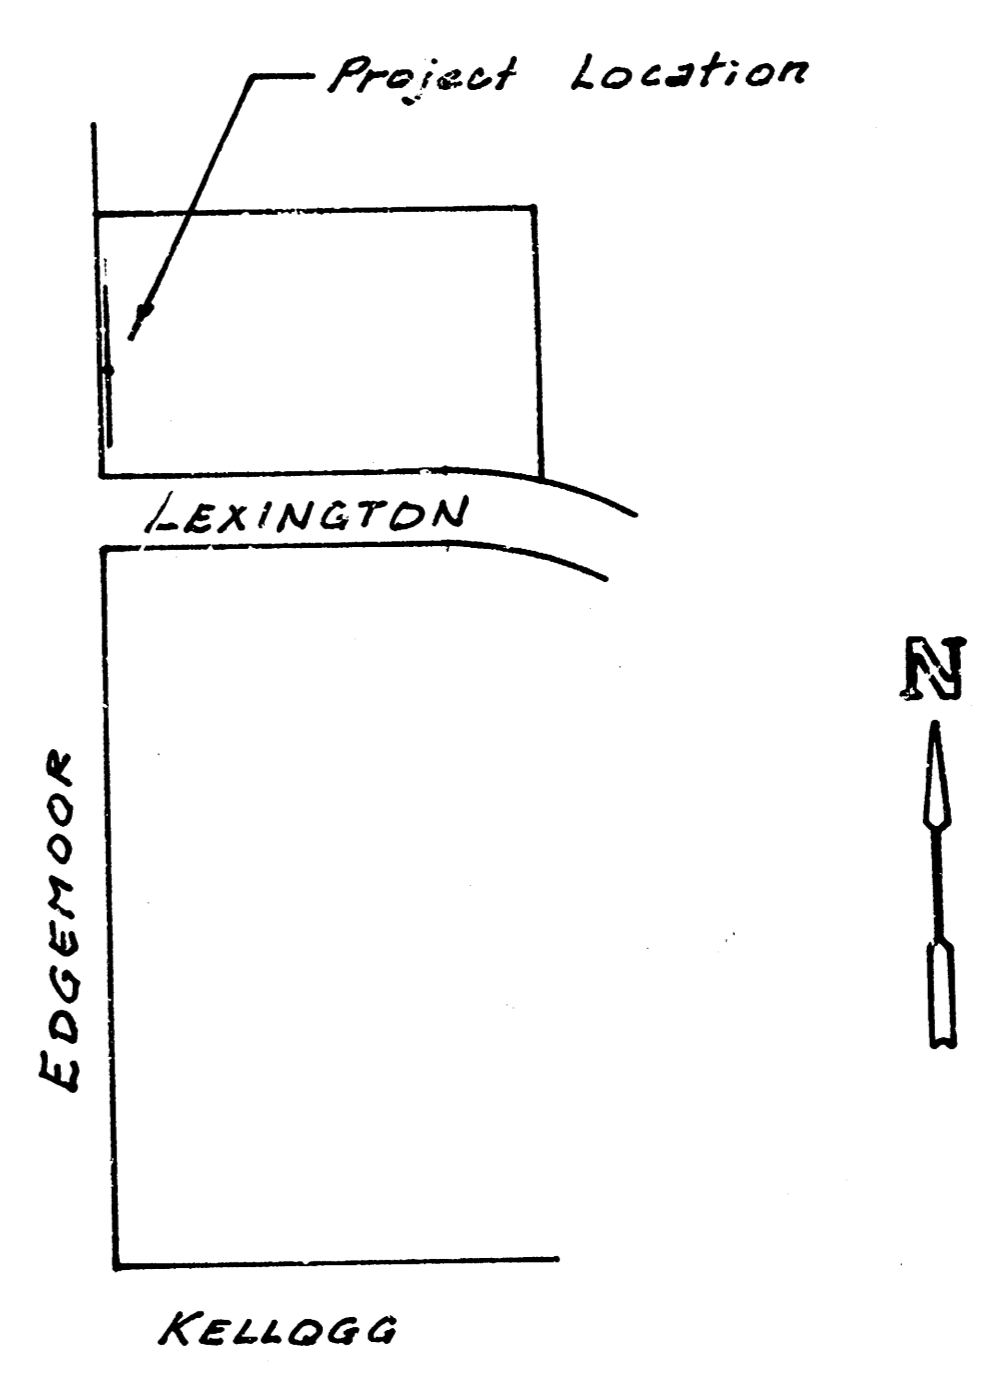


159.99 Elev. City of Wichita Bench Mark Disc.  
 N.E. Corner R.C.B.C. at Edgemoor and  
 East Branch Dry Creek (North of Kellogg).

Scale  
 Plan 1" = 40'  
 Profile 1" = 40' Horiz.  
 1" = 5' Vert.

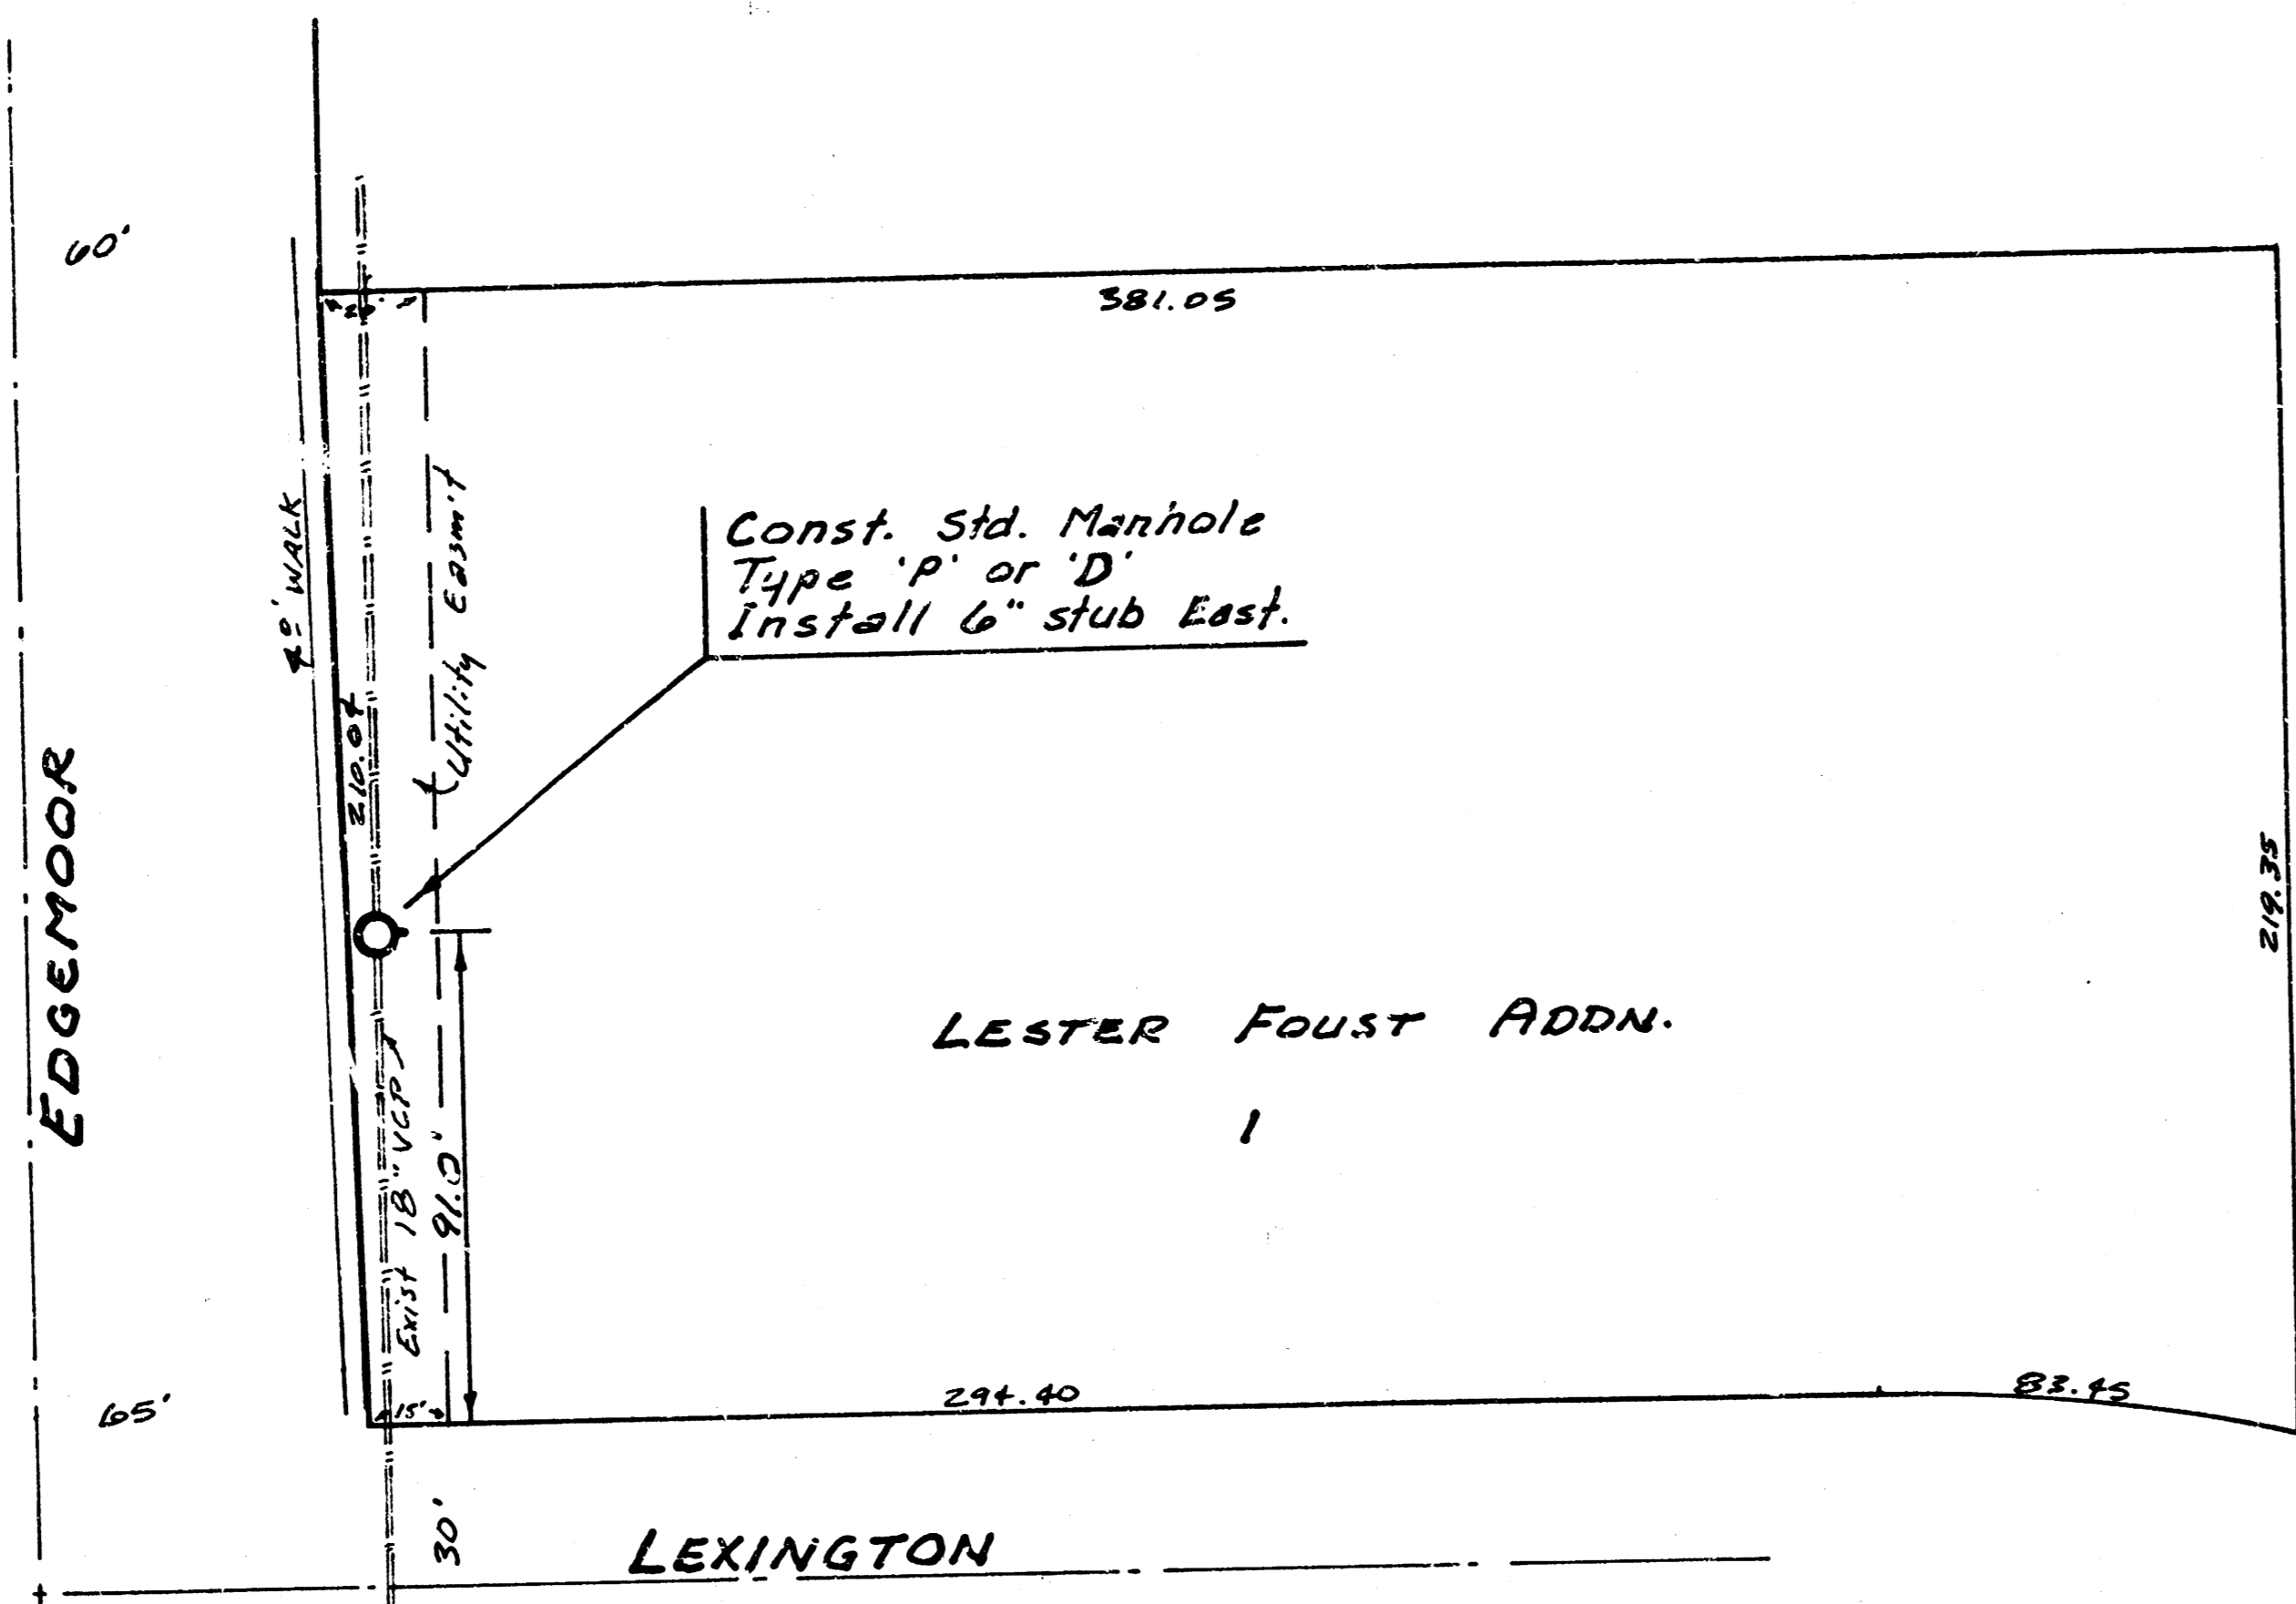

160  
 155  
 150

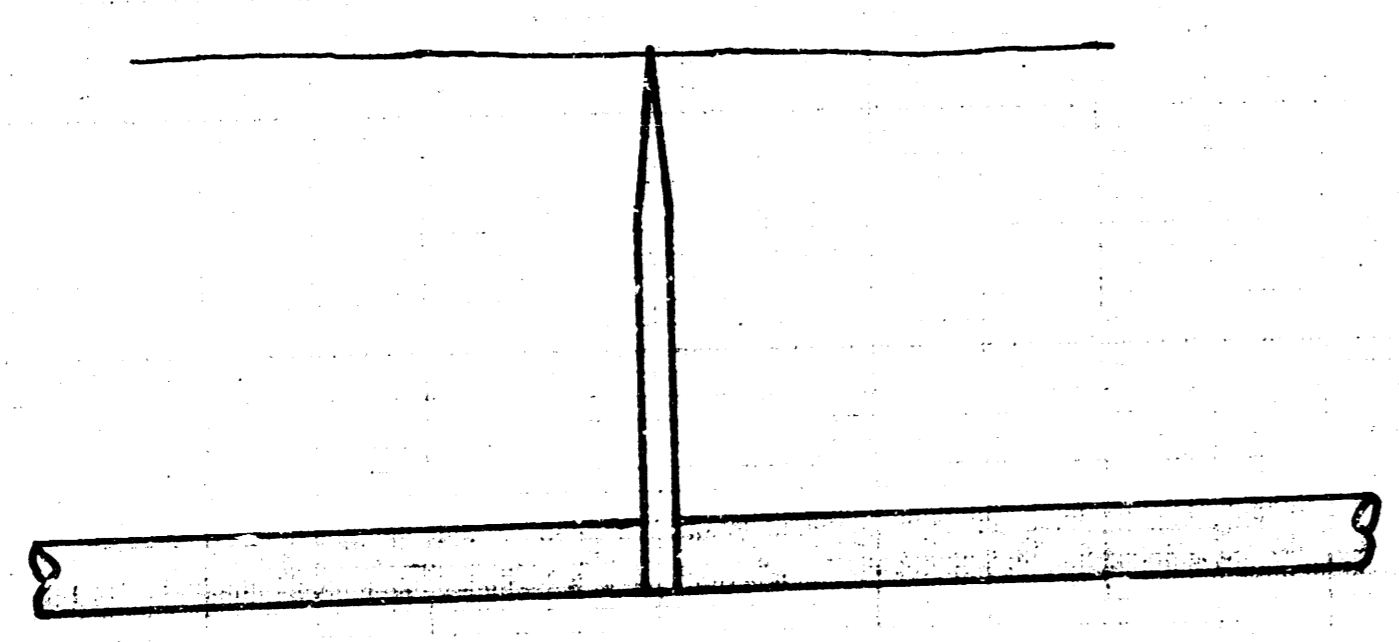


Const. Std. Manhole  
 Type 'P' or 'D'  
 Top elev. 161.51

149.98 Fto Exst. 18" VCP  
 150.98 Fto 6" stub E.  
 107

AS BUILT  
 RPL  
 12.87

**LATERAL 110, MAIN 2, SANITARY SEWER NO. 12**  
**PROJ. NO. 458-76-245- 81682-000-000-001**  
**CITY OF WICHITA, KANSAS**  
**M. E. LINDEBAK - CITY ENGINEER**

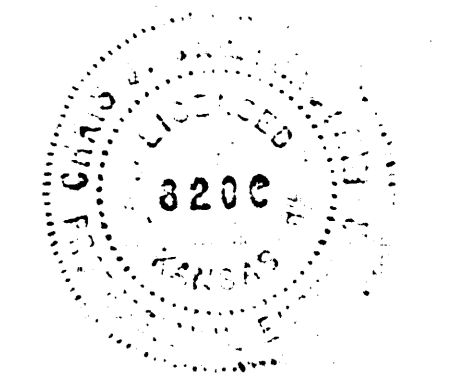

PROJECT DESCRIPTION
PROJECT NUMBER

FILMED FROM THE BEST  
 AVAILABLE COPY