
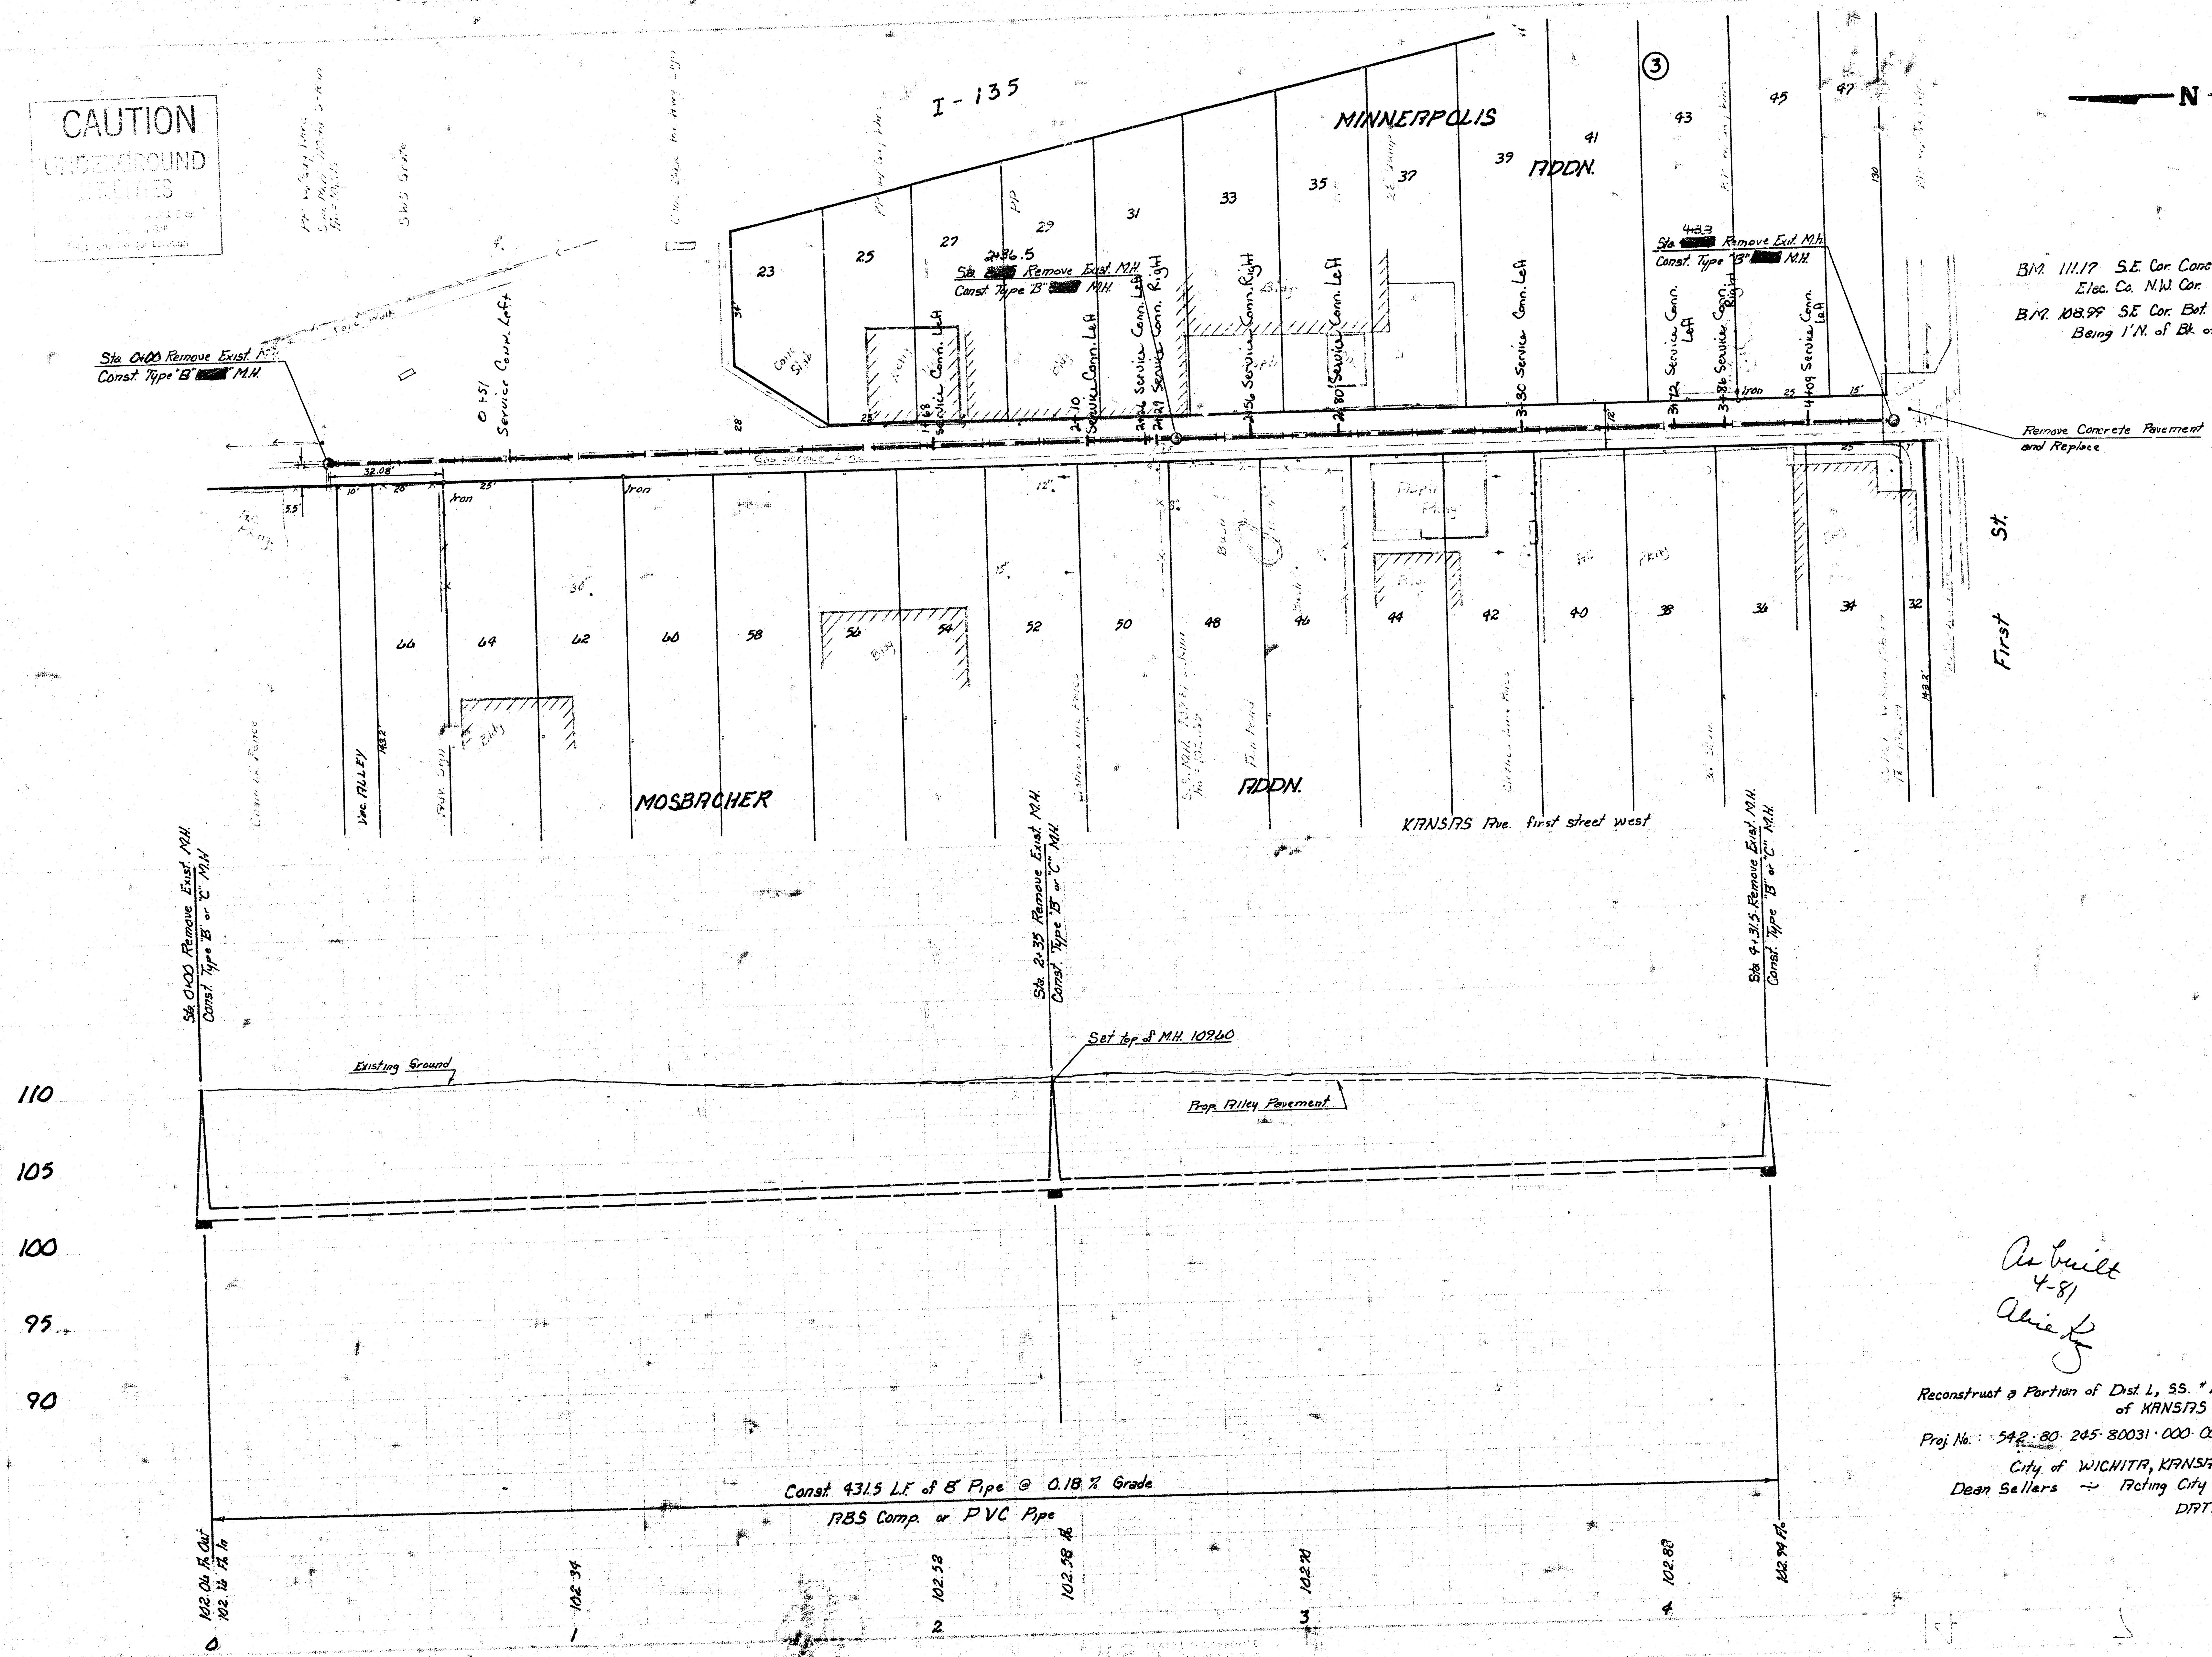


CAUTION
UNDERGROUND
UTILITIES

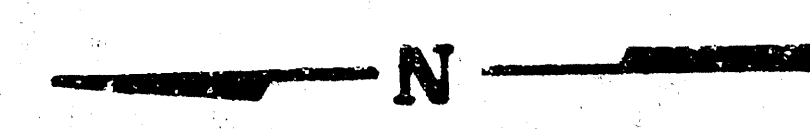

BM 111.17 S.E. Cor. Conc. Walk E-Side SW
Elec. Co. N.W. Cor. 1st & Hyd.
B.M. 108.99 S.E. Cor. Bot. Step 18th E. First
Being 1' N. of Bk. of 4' Wlk. E-W

Remove Concrete Pavement
and Replace

SCALE
Plan 1" = 20'
Profile 1" = 20'
Horz 1" = 20'
Vert 1" = 5'

As built
4-81
Albie

Reconstruct a Portion of Dist. 1, SS. * 20 in the Alley East
of KANSAS Pve. between 1st and 2nd
Proj. No.: 542-80-245-80031-000-000-201
City of WICHITA, KANSAS
Dean Sellers ~ Acting City Engineer
DATE _____

