

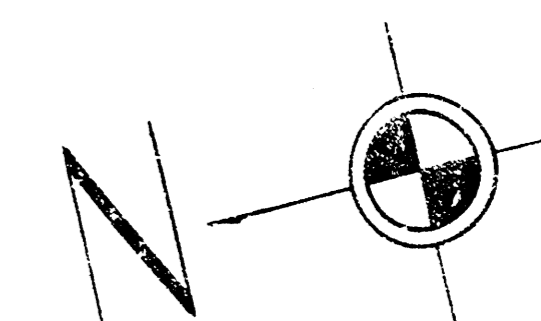


BM 96.96 'D' Cut top of East curb at St. Francis & 40' N. of C Pawnee

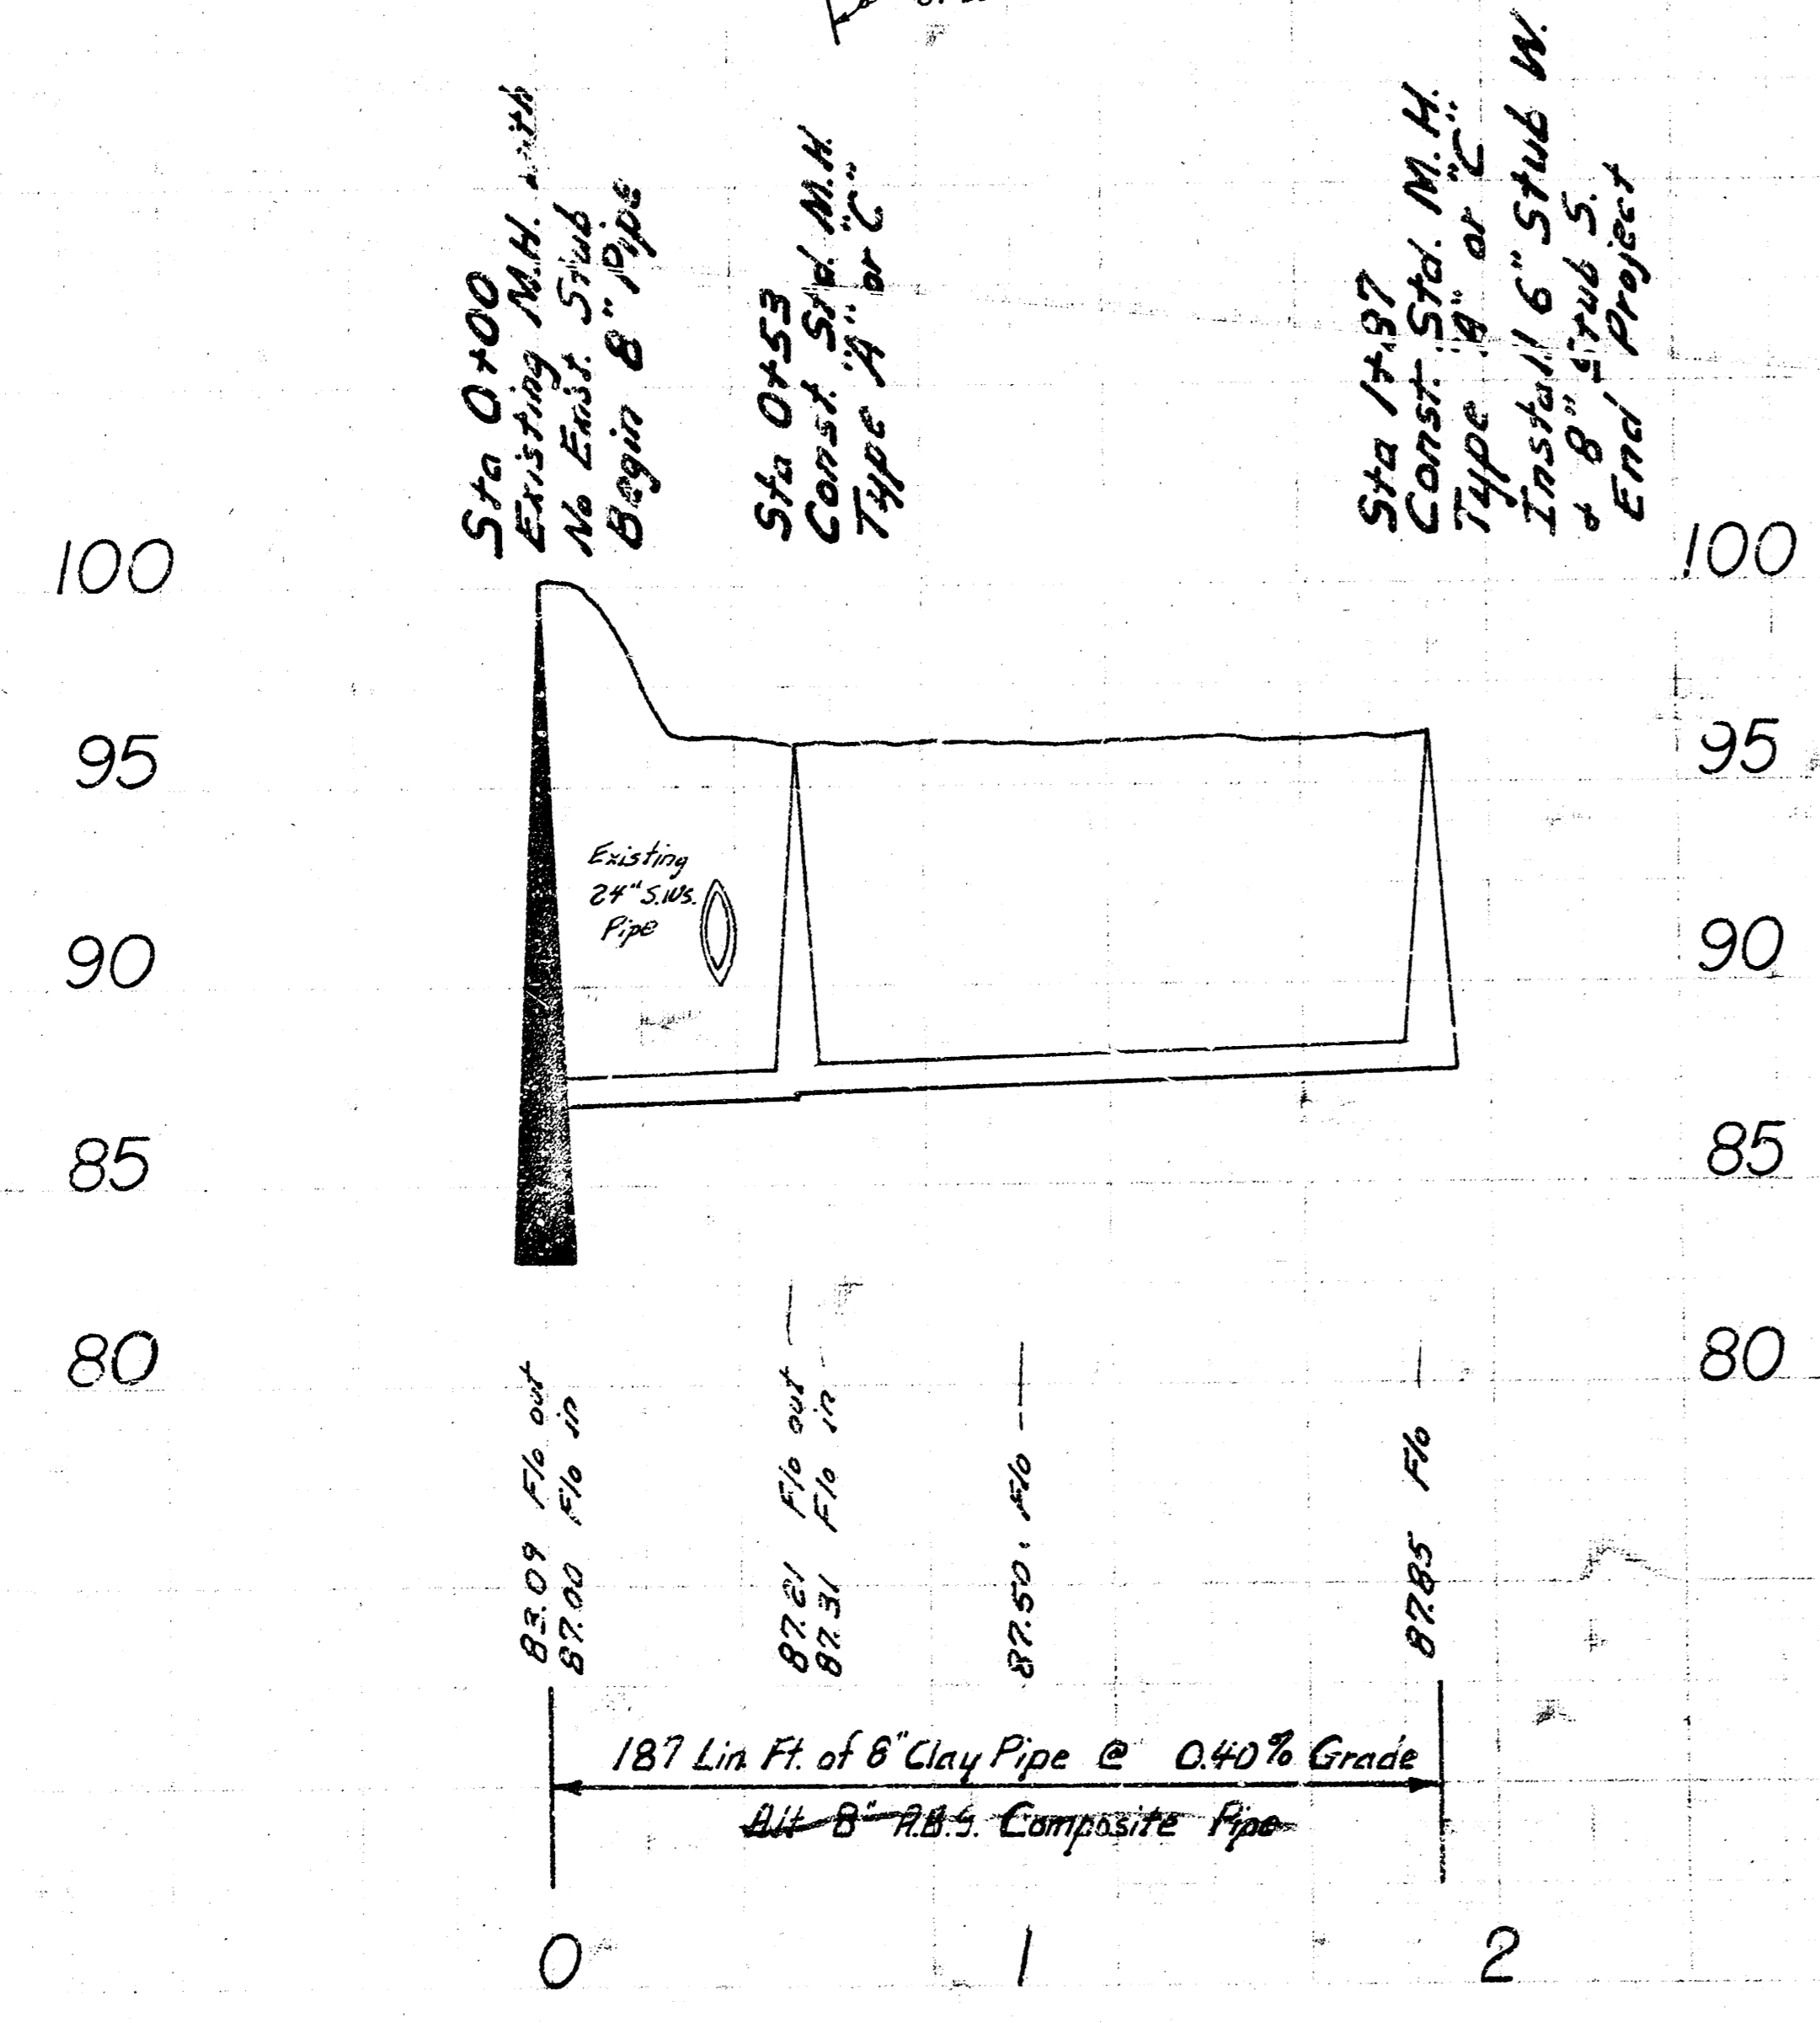

Plan Scale 1" = 40'
 Profile Scale 1" = 40' Horz.
 1" = 5' Vert.

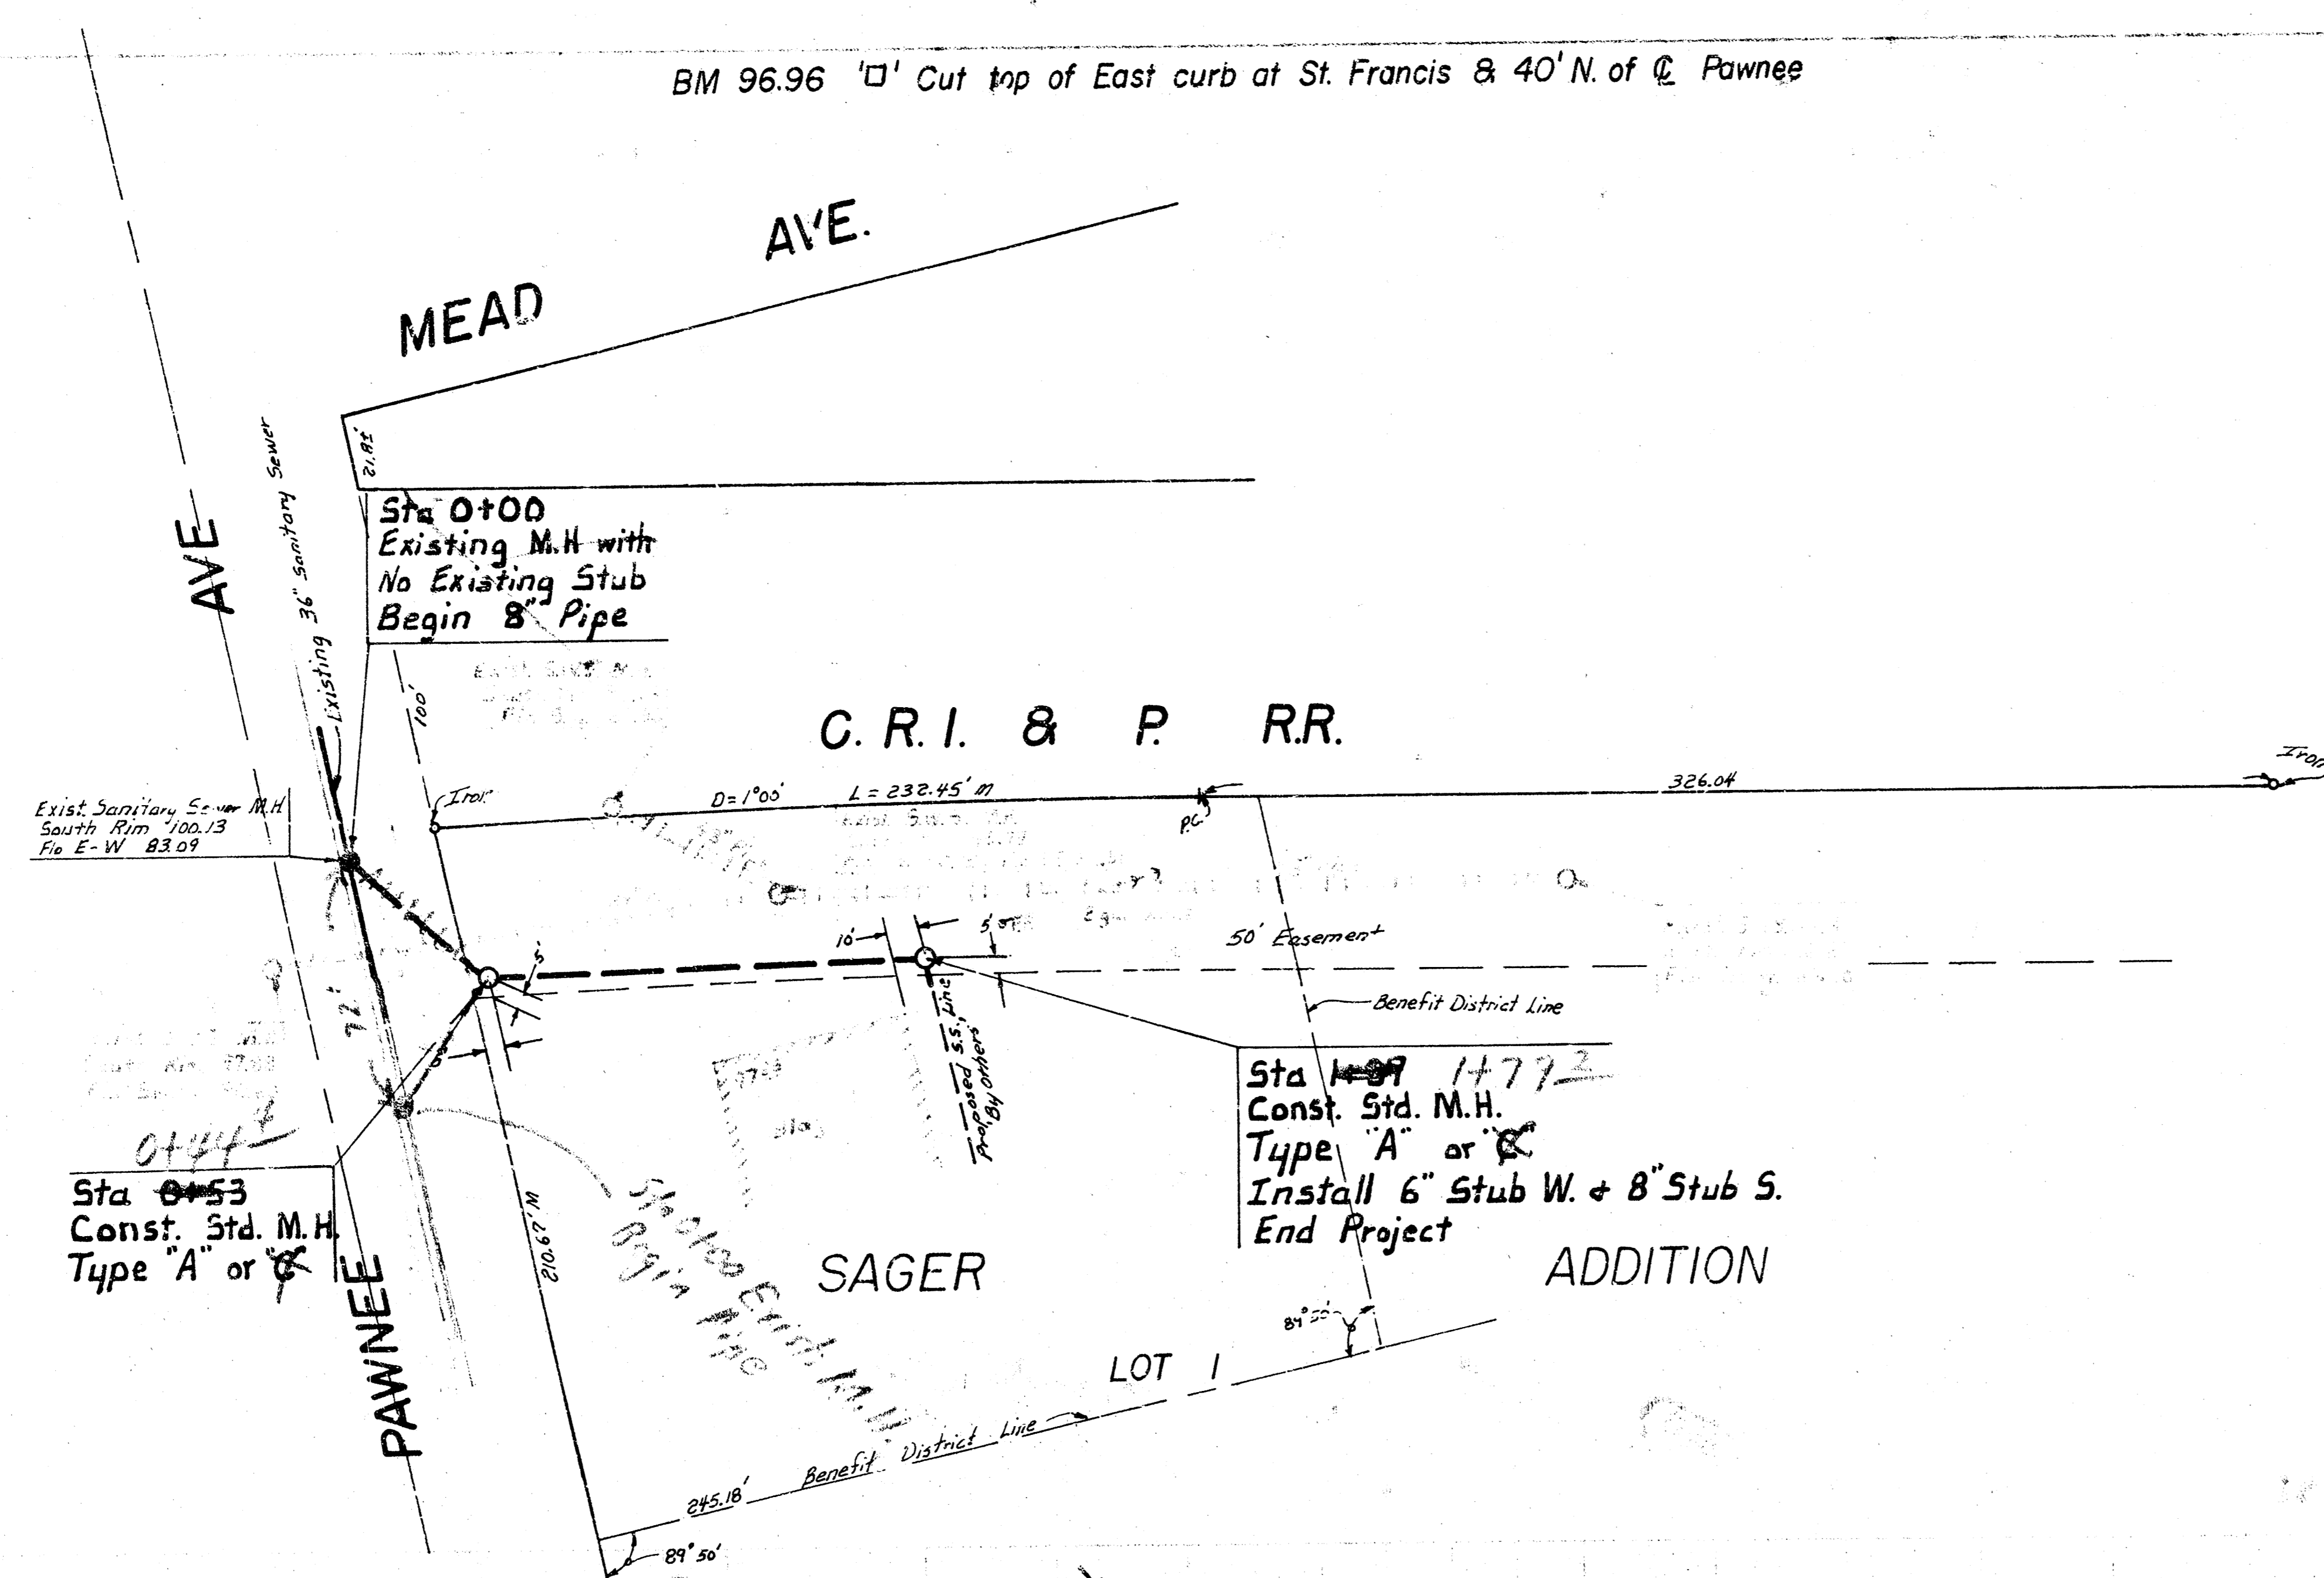

As built 6-28-78

LAT. 31 DIST. B S.S. NO. 20
 CITY OF WICHITA, KS.
 R. W. LINN CITY ENGINEER
 Project No. 468 76 245 80505 000 000 001

