
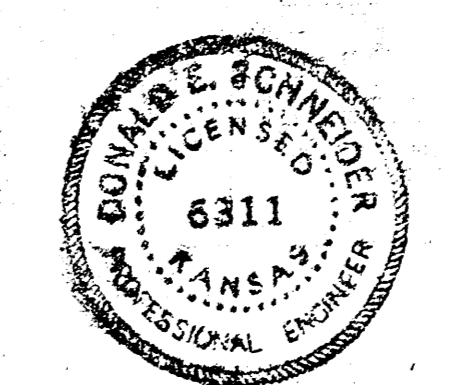
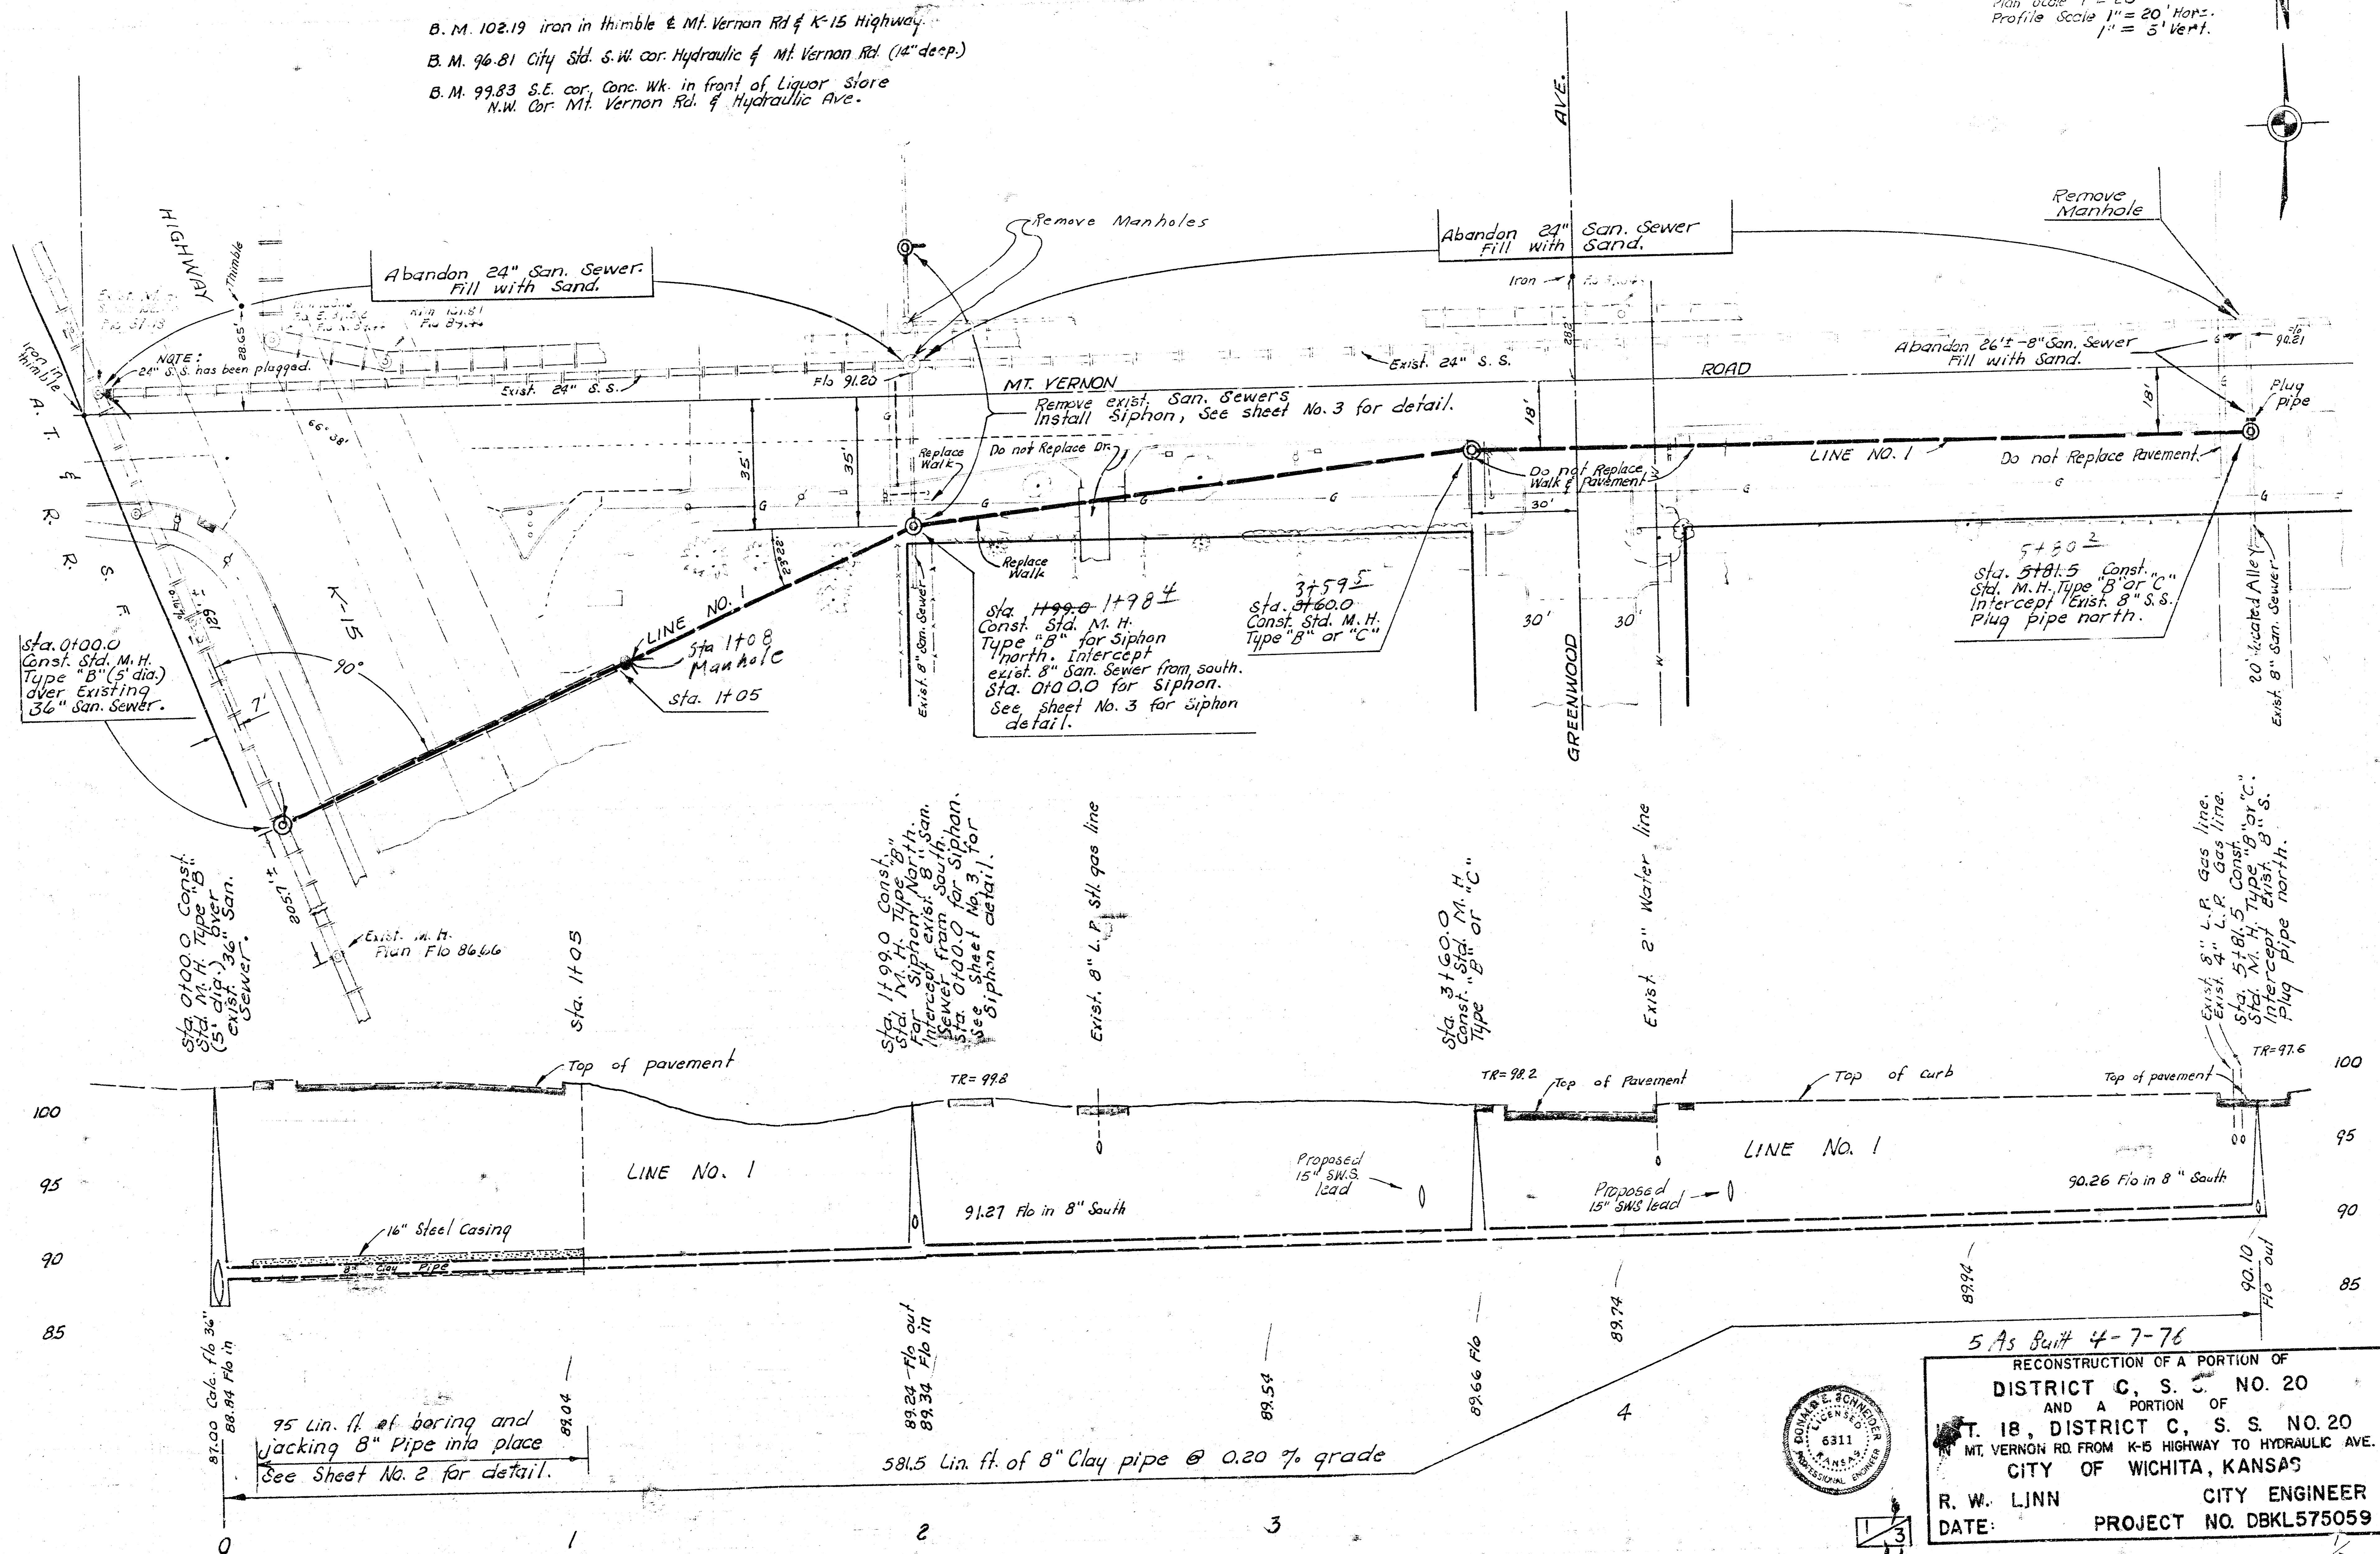


Plan Scale 1" = 20'
 Profile Scale 1" = 20' Horiz.
 1" = 3' Vert.

- B. M. 102.19 iron in thimble @ Mt. Vernon Rd & K-15 Highway.
- B. M. 96.81 City Std. S.W. cor. Hydraulic & Mt. Vernon Rd (14" deep.)
- B. M. 99.83 S.E. cor. Conc. Wk. in front of Liquor store
 N.W. Cor. Mt. Vernon Rd. & Hydraulic Ave.

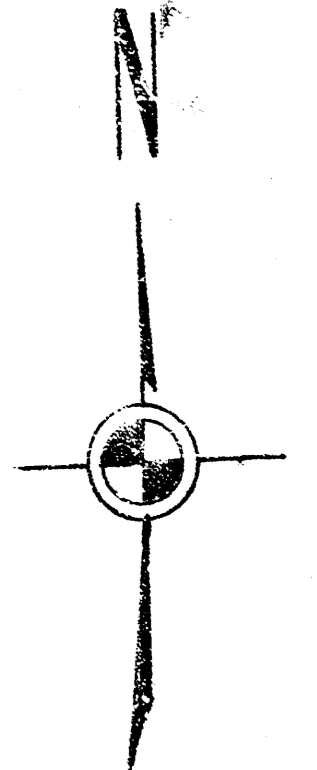

5 As Built 4-7-76

RECONSTRUCTION OF A PORTION OF
 DISTRICT C, S. S. NO. 20
 AND A PORTION OF
 T. 18, DISTRICT C, S. S. NO. 20
 MT. VERNON RD. FROM K-15 HIGHWAY TO HYDRAULIC AVE.
 CITY OF WICHITA, KANSAS

R. W. LINN CITY ENGINEER
 DATE: PROJECT NO. DBKL575059

