



B. M. 103.10 "5" in globe top E. of Dodge
3' S. of N. May

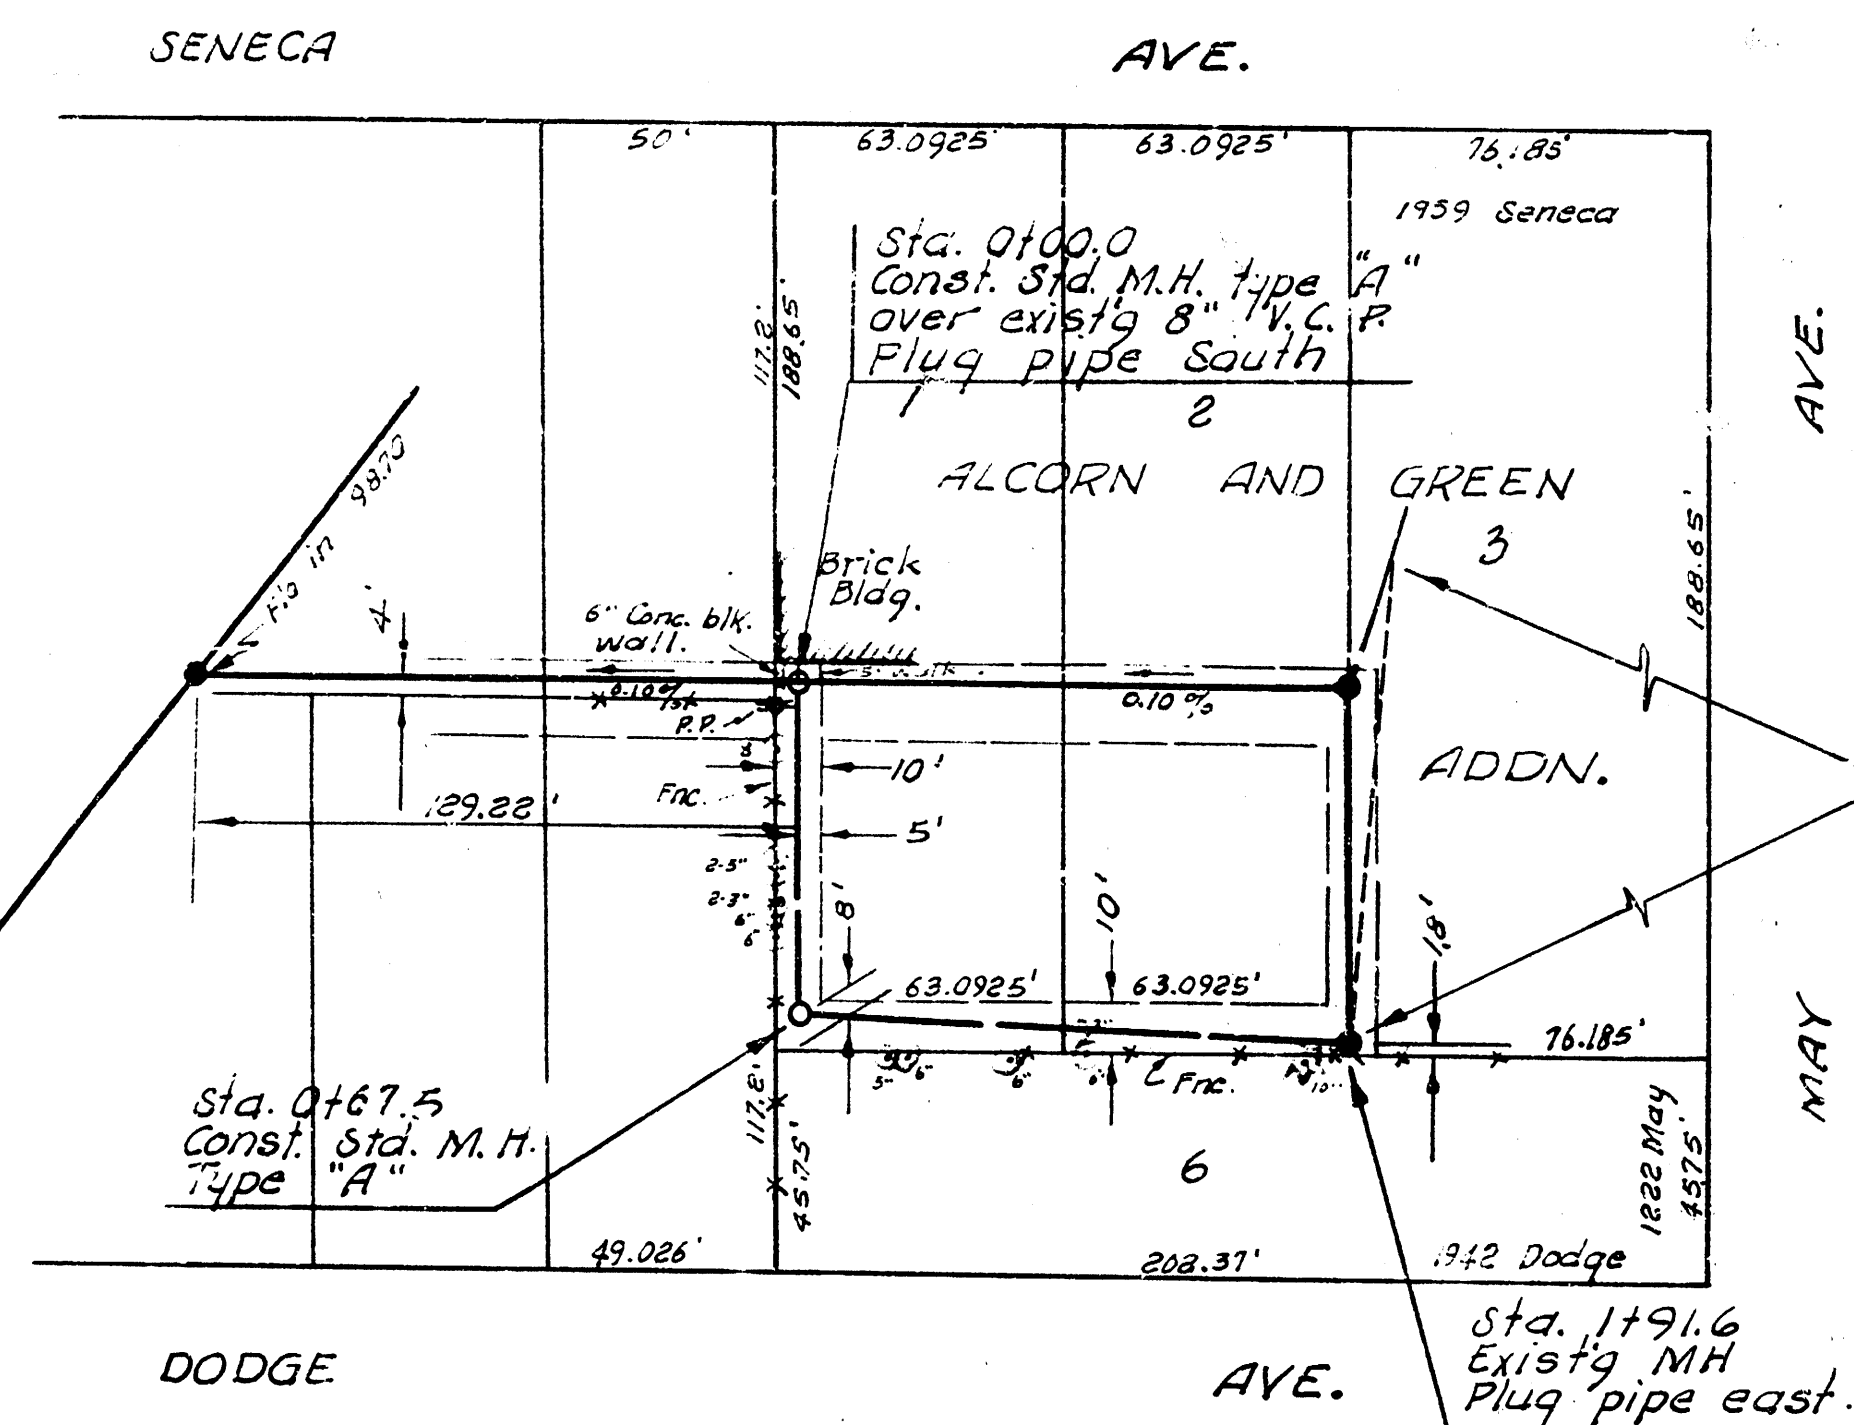

Plan Scale 1" = 40'
Profile Scale 1" = 4' Vert.


NOTE:
Connect existing 4" lead to
existing M.H. at Sta. 1791.6.

Survey by G.Y. Bk. No. 244-Y
Checked by G.Y.

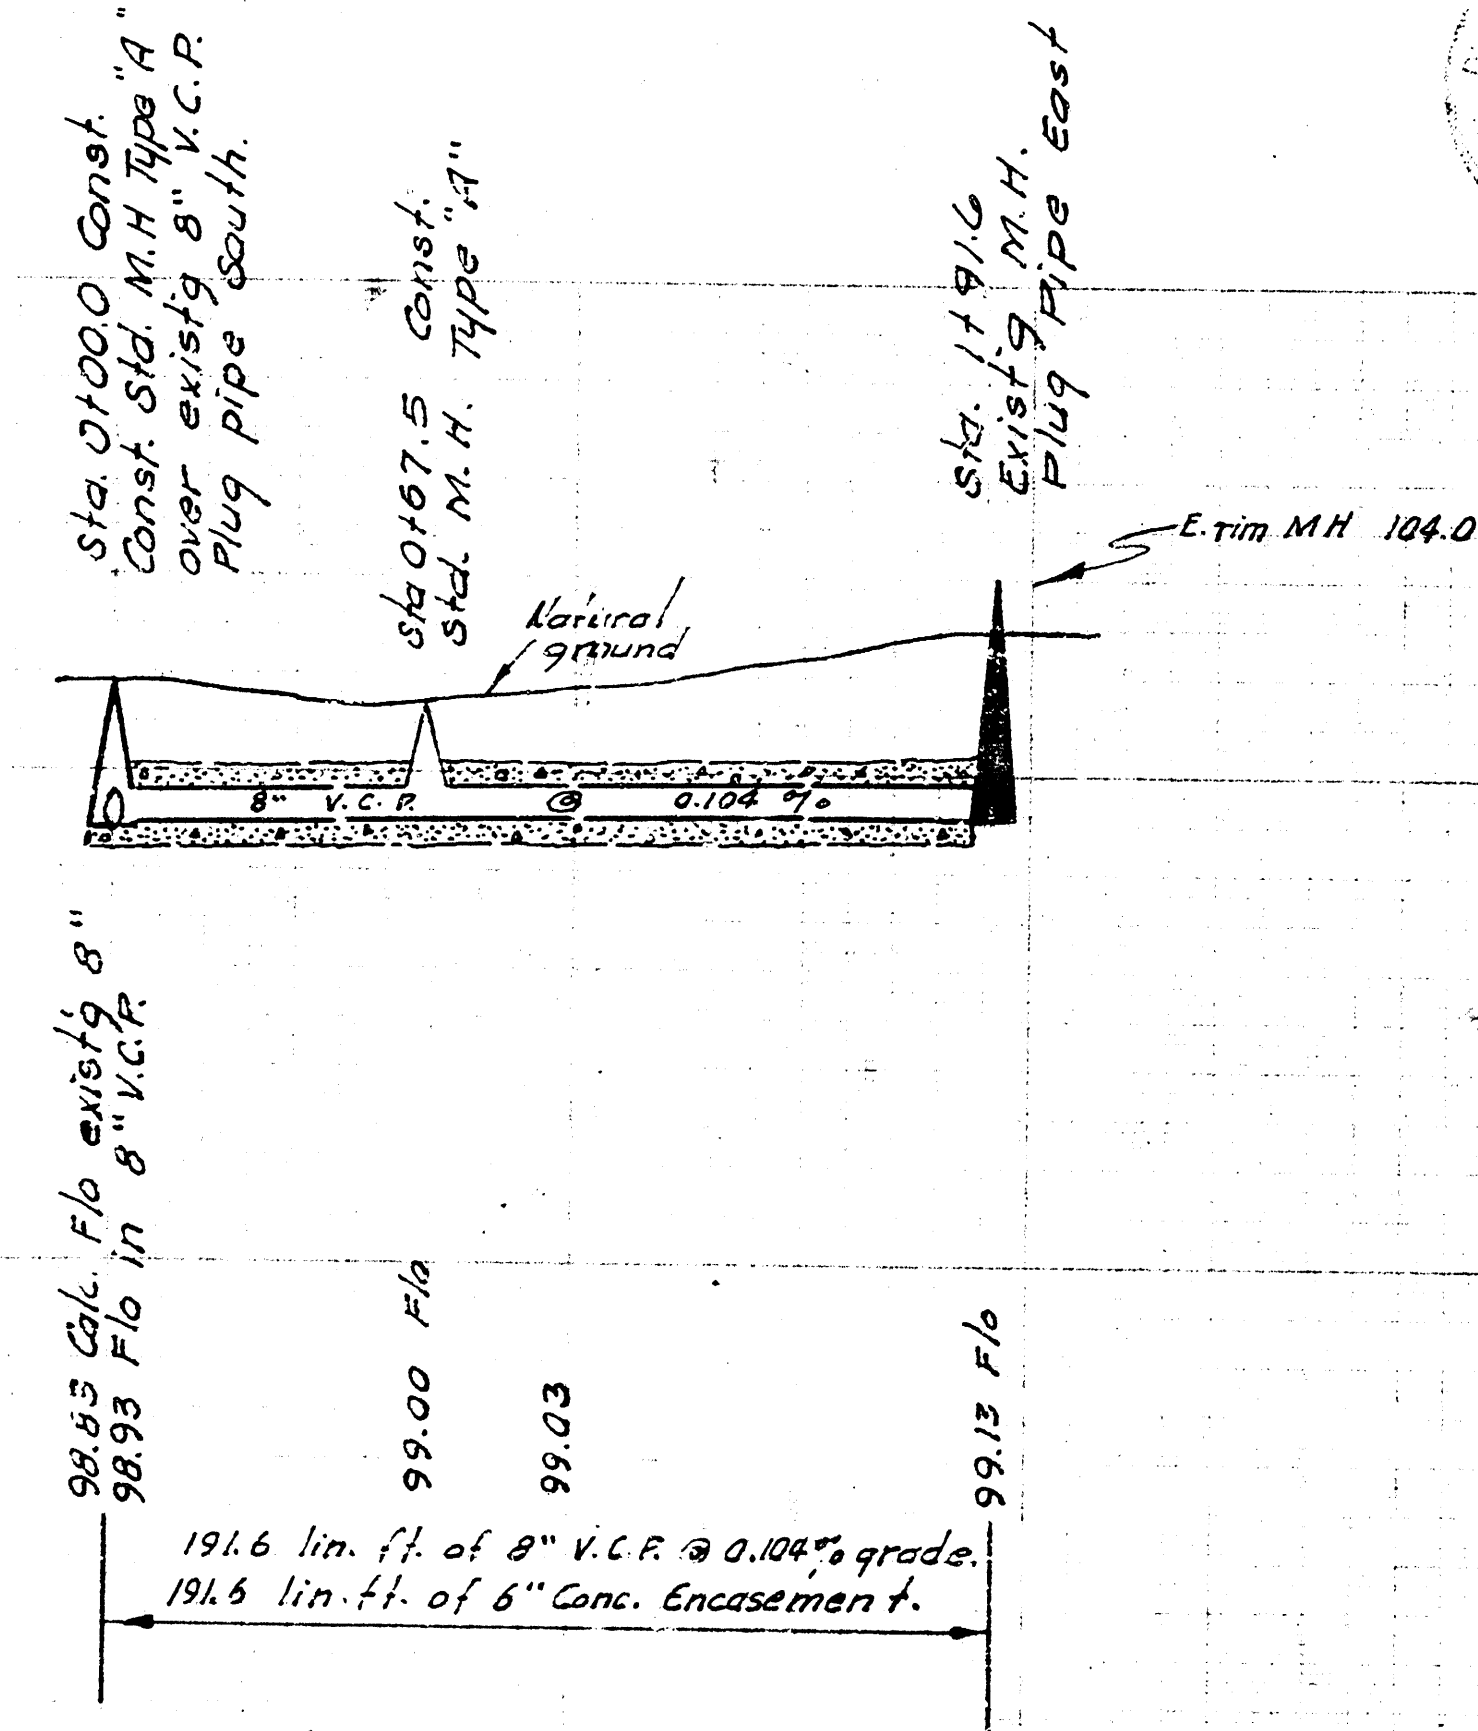

RELOCATION OF A PART OF
LAT. 2, DIST. E, S.S. NO. 21
CITY OF WICHITA, KANSAS
B. E. SMITH CITY ENGINEER
JAN. 1967. PRIVATE CONTRACT


B. M. 89.01 R.R. Spike E. S.
P.P. W. S. Seneca @
43rd St. S.O.

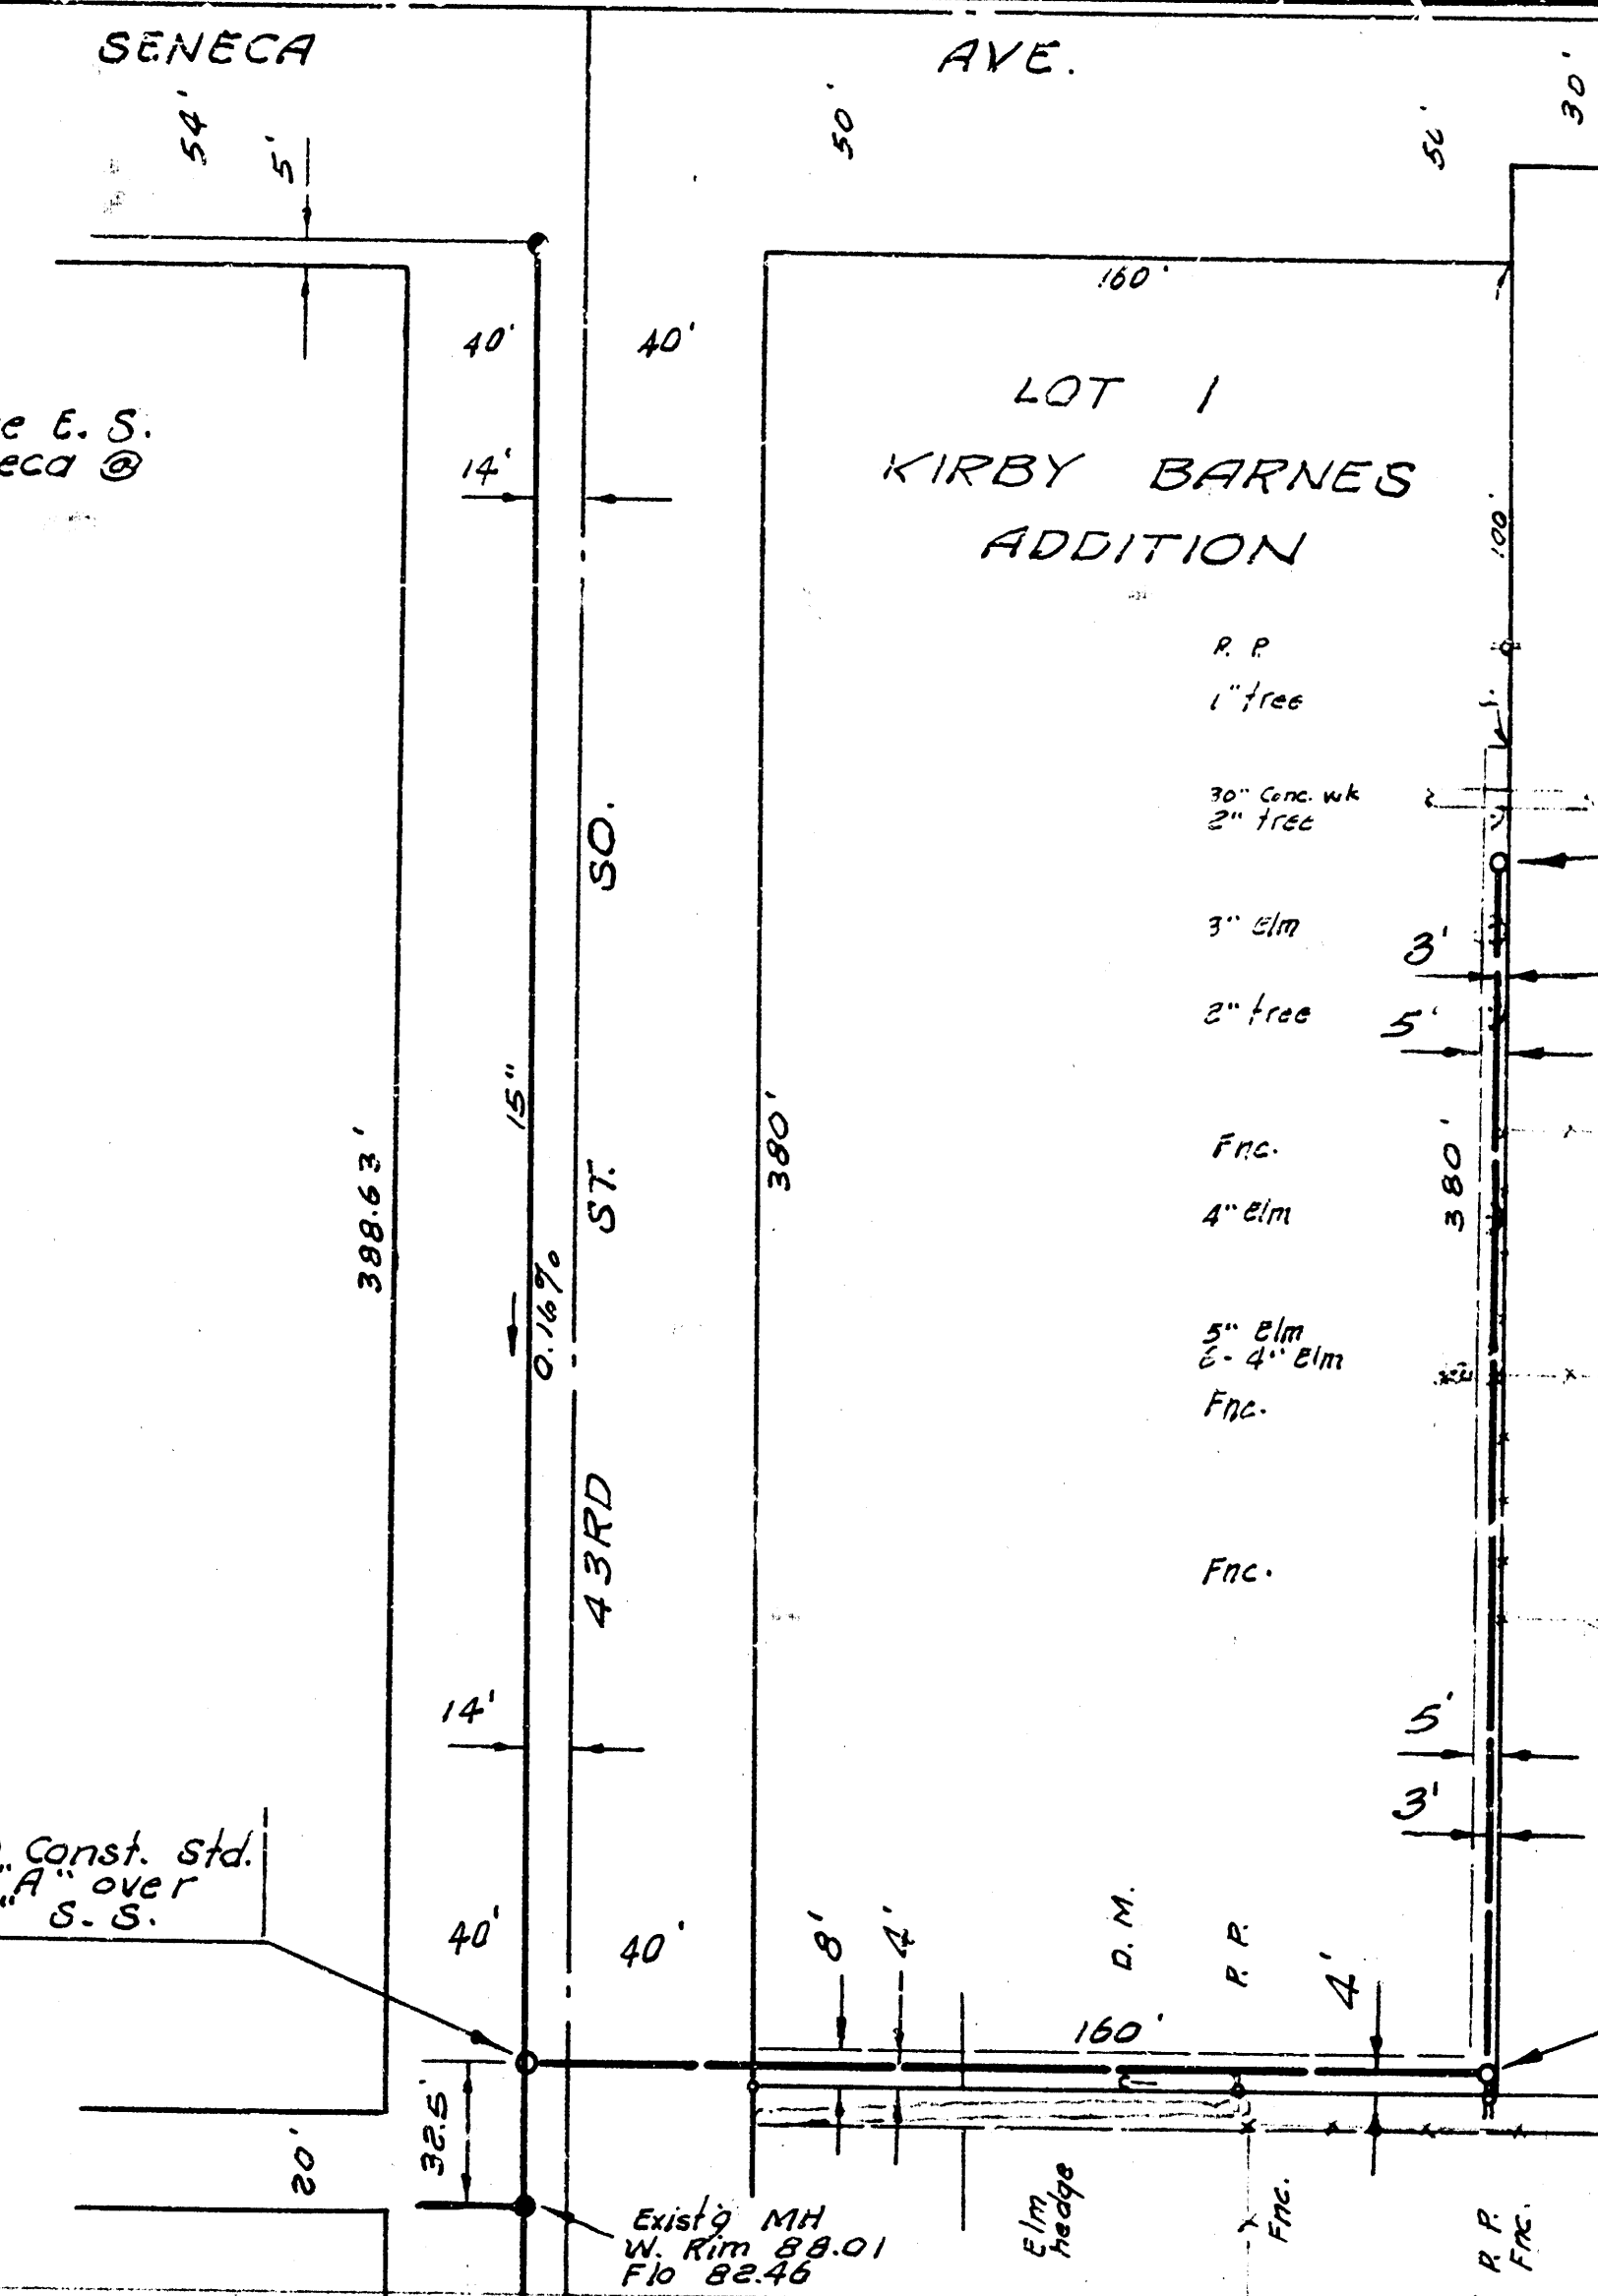

Plan Scale 1" = 40'
Profile Scale 1" = 4' Vert.

Sta. 0100.0 Const. Std.
M.H. Type 'A' over
existing 15" S.S.

Sta. 2111.0 Const.
Std. M.H. Type 'A'

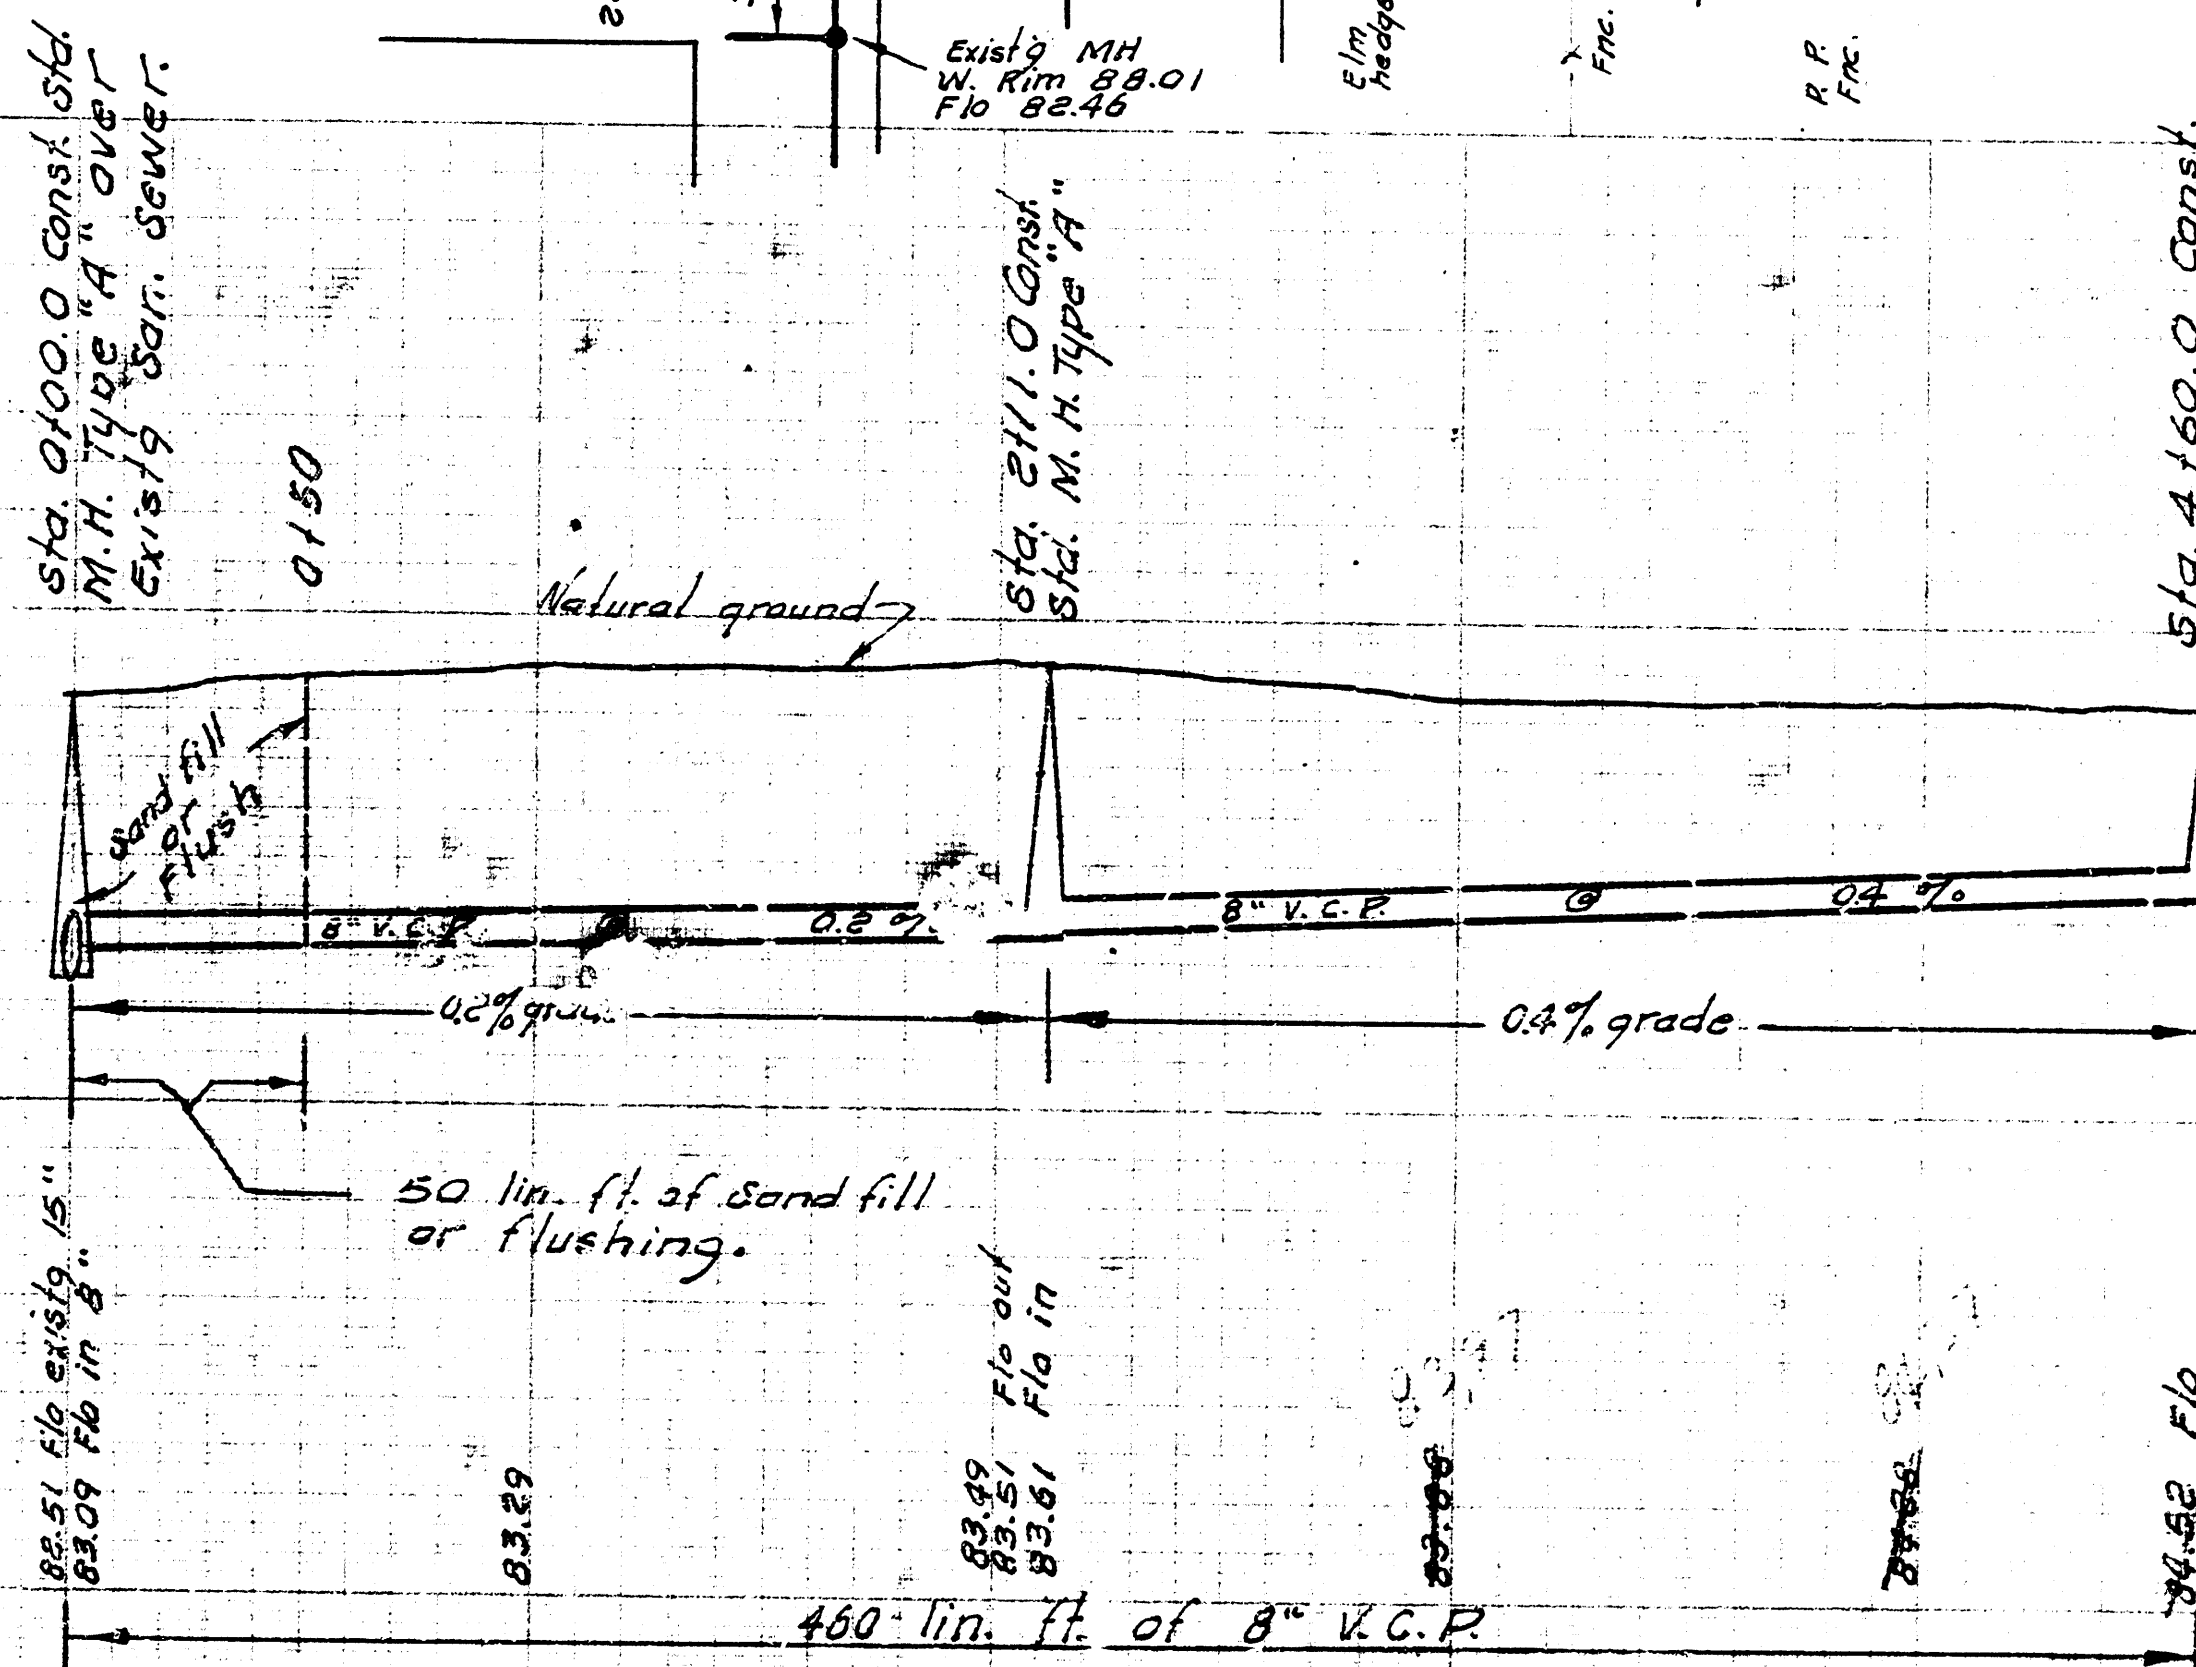

KIRBY BARNES ADDITION
SANITARY SEWER
N.E. 43RD ST. SO. AND SENECA
CITY OF WICHITA, KANSAS
B. E. SMITH CITY ENGINEER
FEB. 1967. PRIVATE CONTRACT