



Survey & Location by LUC-3
Plan D. Connor
Ext.
Checked T. J. J.



B.M. 99.40 1" E. End S.E. Curb Return S.E. Cor. 30th & Gordon
B.M. 102.87 N.E. Cor. 1st Step on back porch of Ho. S.E. Cor. Wildwood & St. Paul

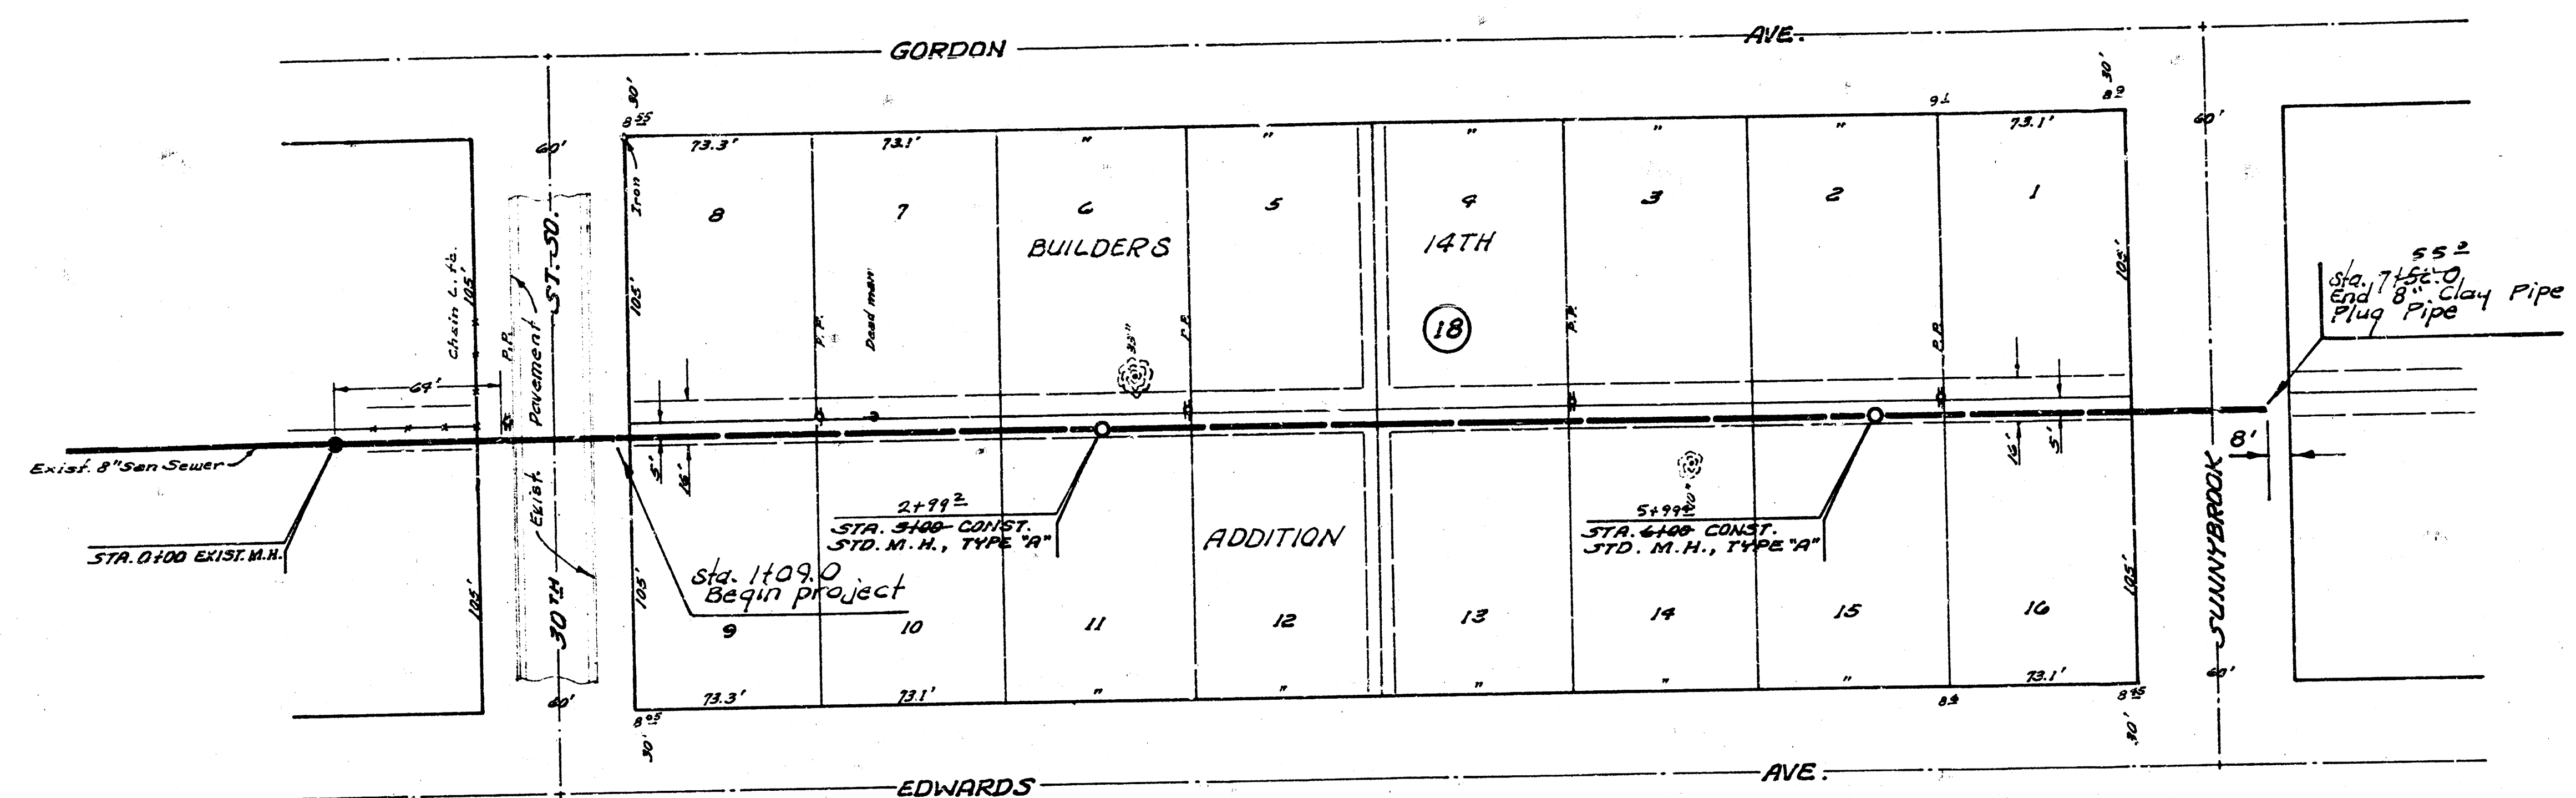

Plan Scale 1"=90'
Profile Scale 1"=90' Hor.
1"=9' Vert.

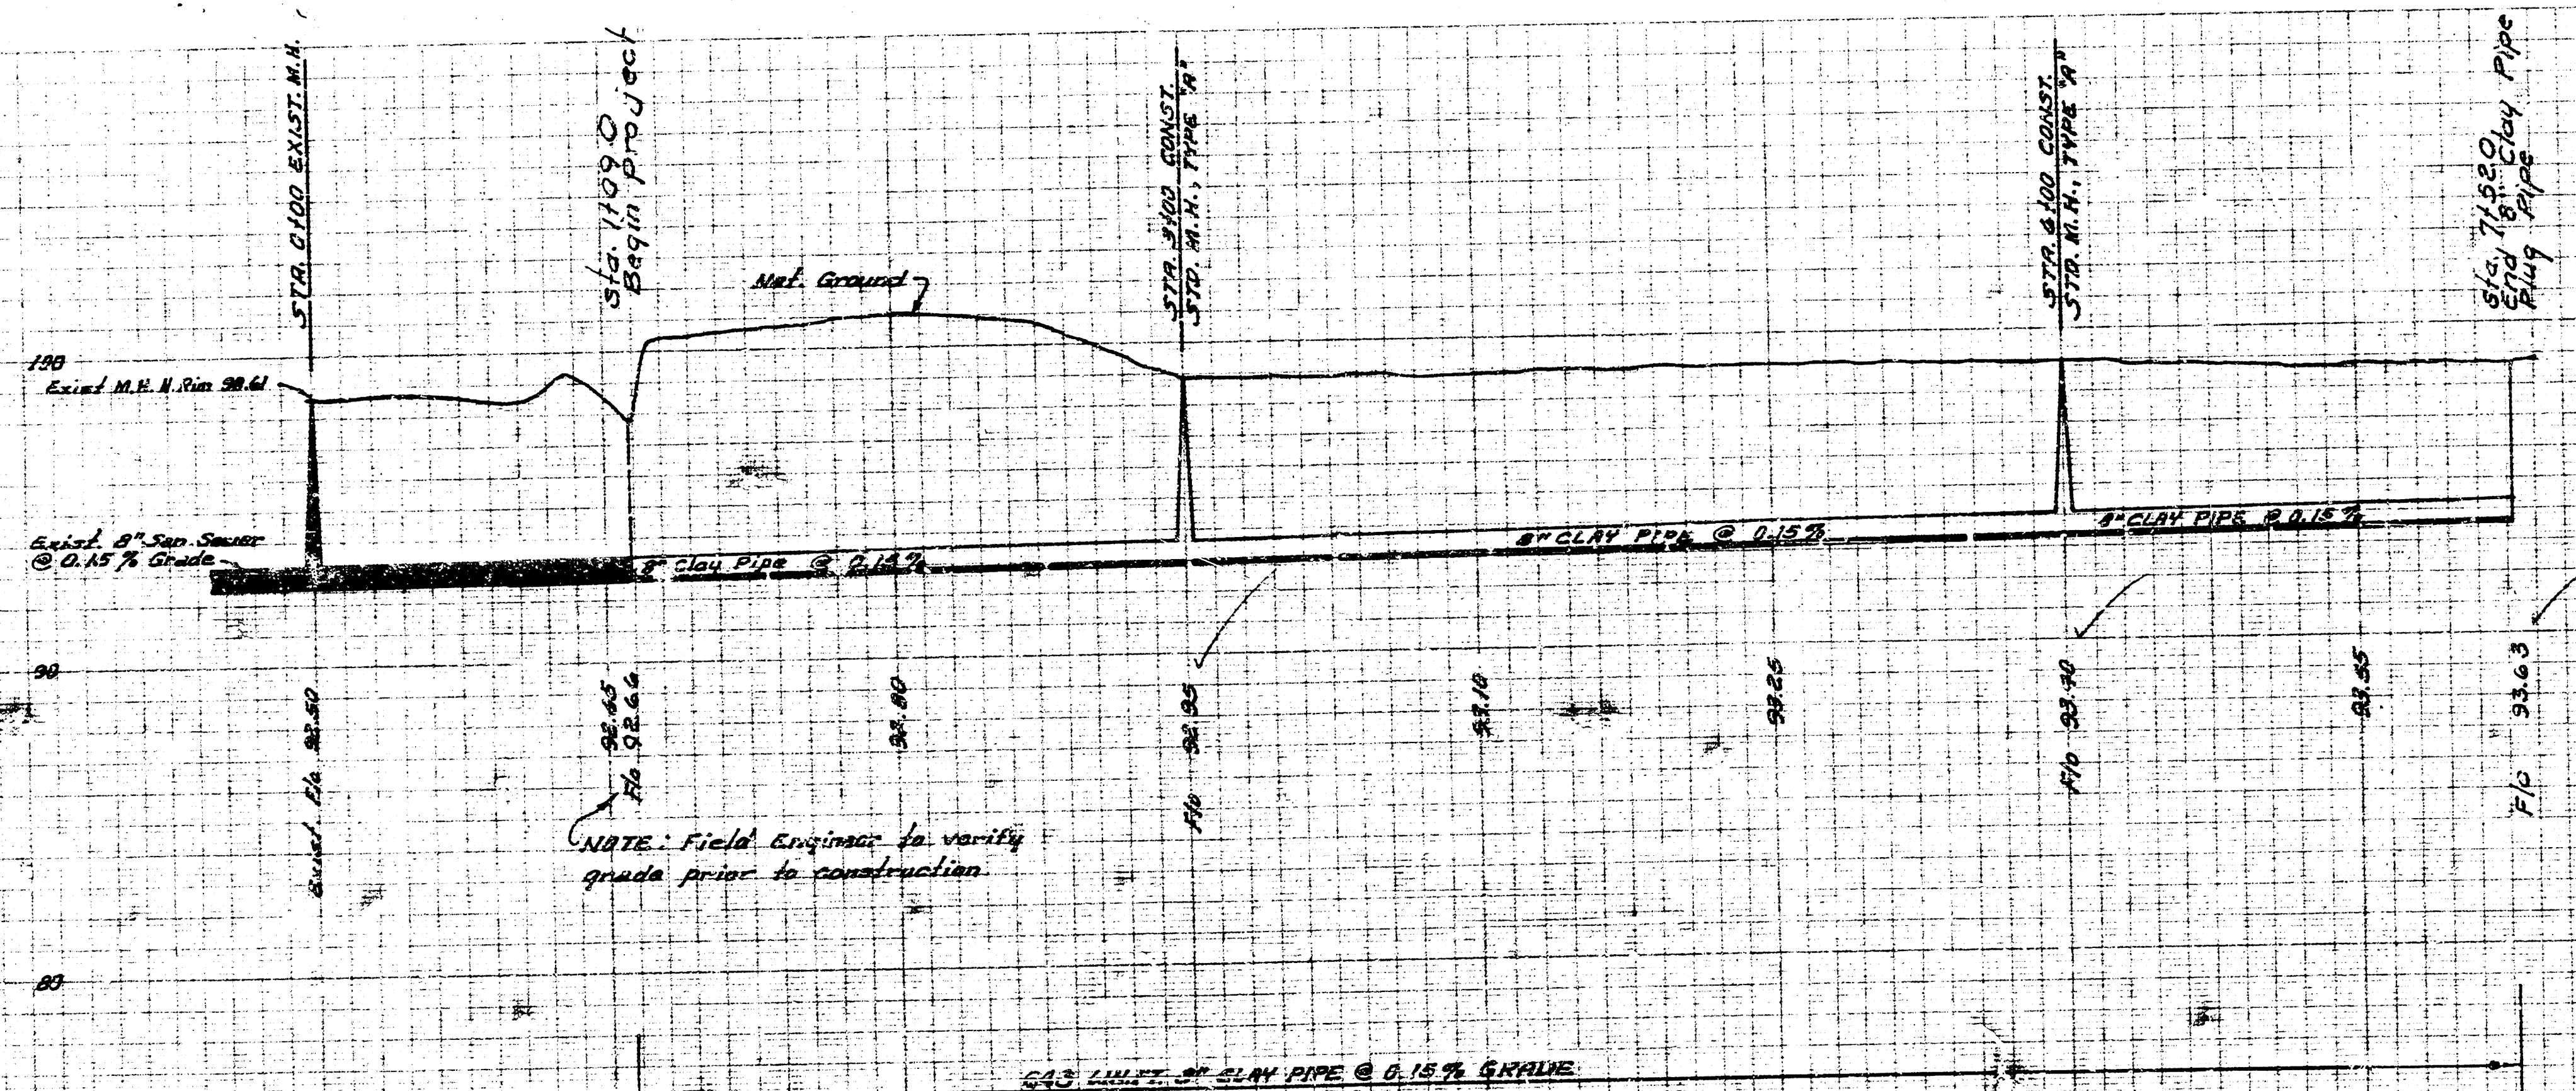

NOTE: Field Engineer to verify grade prior to construction.

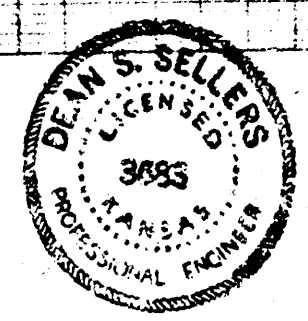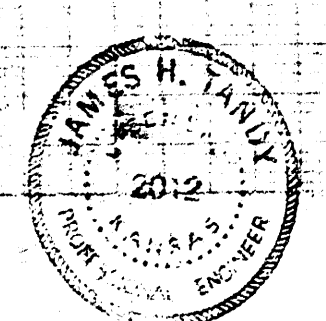

As Built Final Map 55*13 JK
LAT. 109, SAN. SEWER 22
CITY OF WICHITA, KANSAS
R. W. LINN, CITY ENGINEER
PROJ. NO. DBKL568009
DATE: NOV. 1973