

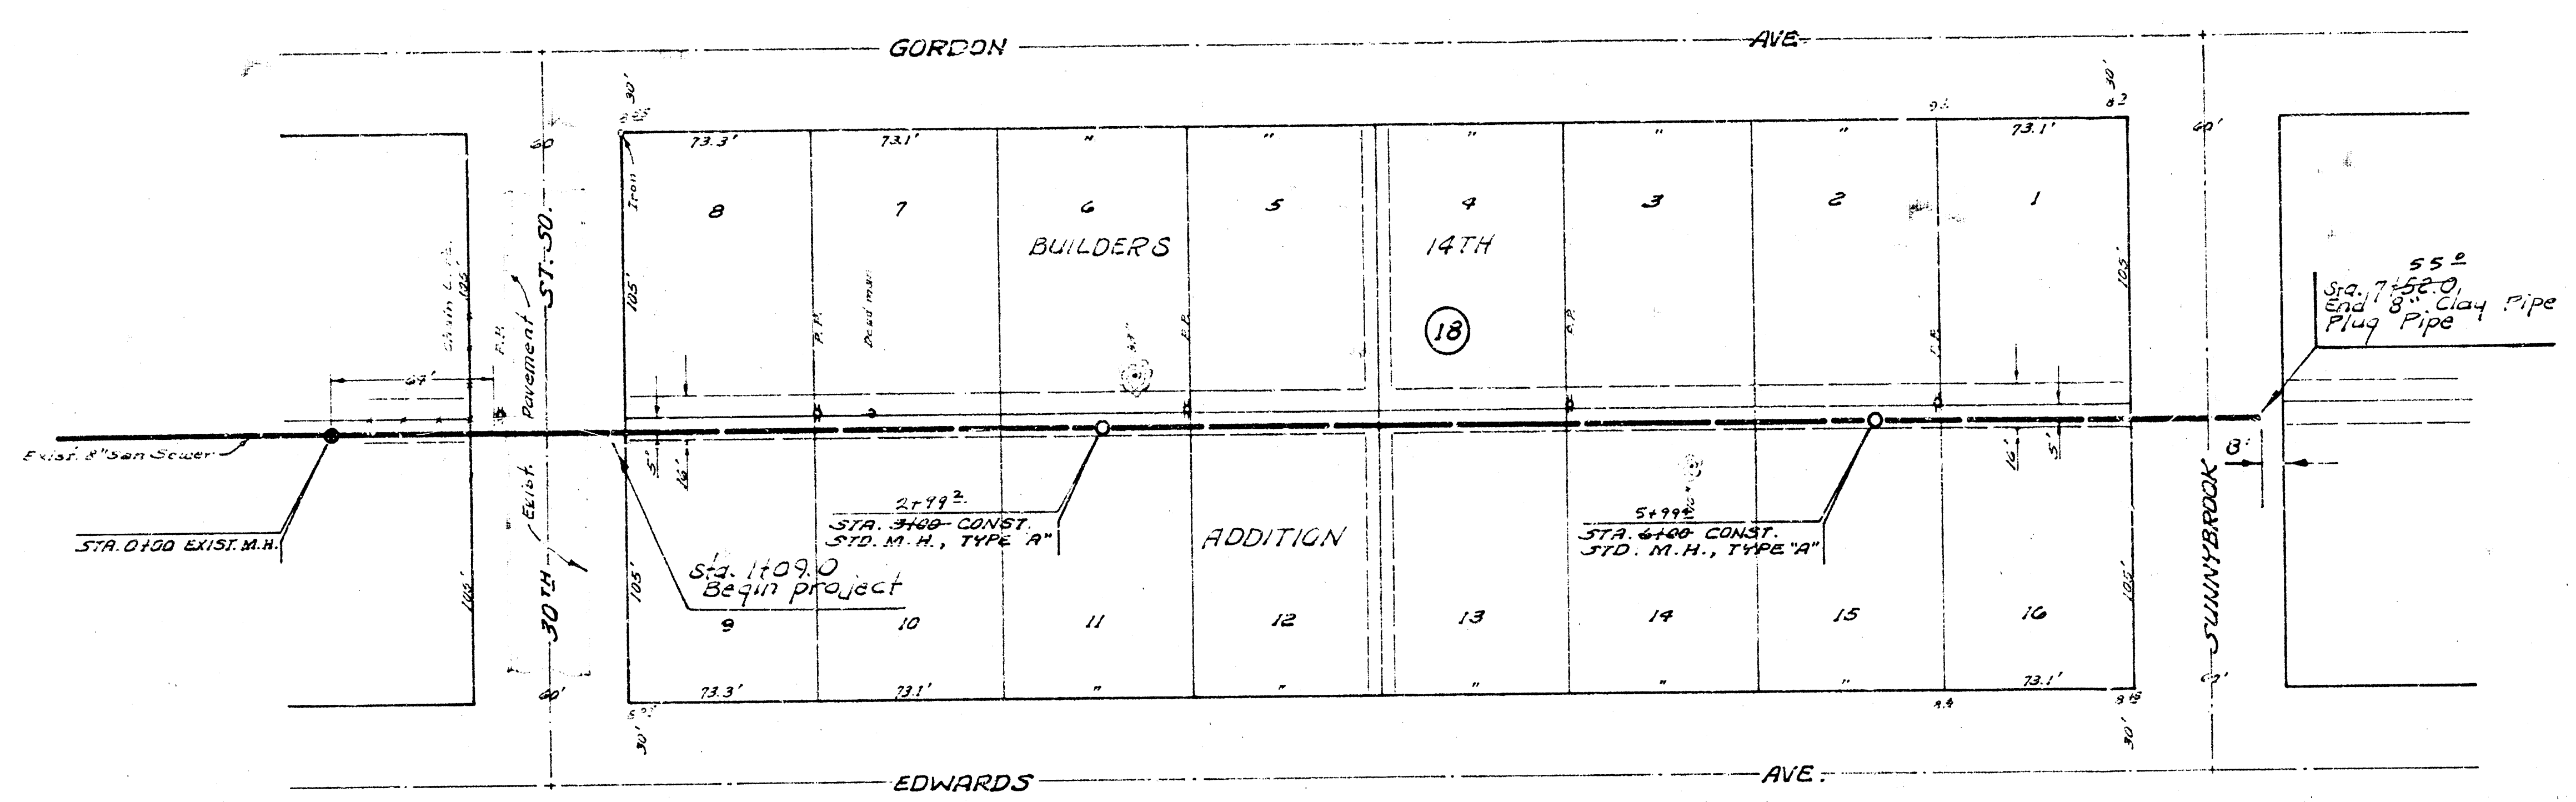


L. J. Jansen - Lbl. 29
D. Granger

B.M. 98.40 "I" E. End S.E. Curb Return S.E. Cor. 30th & Gordon
B.M. 102.87 N.E. Cor. 1st Step on back porch of Ho. S.E. Cor. Wildwood & St. Paul

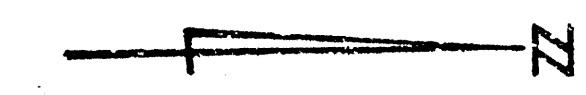

Plan Scale 1"=40'
Profile Scale 1"=40' Hor.
1"=4' Vert.

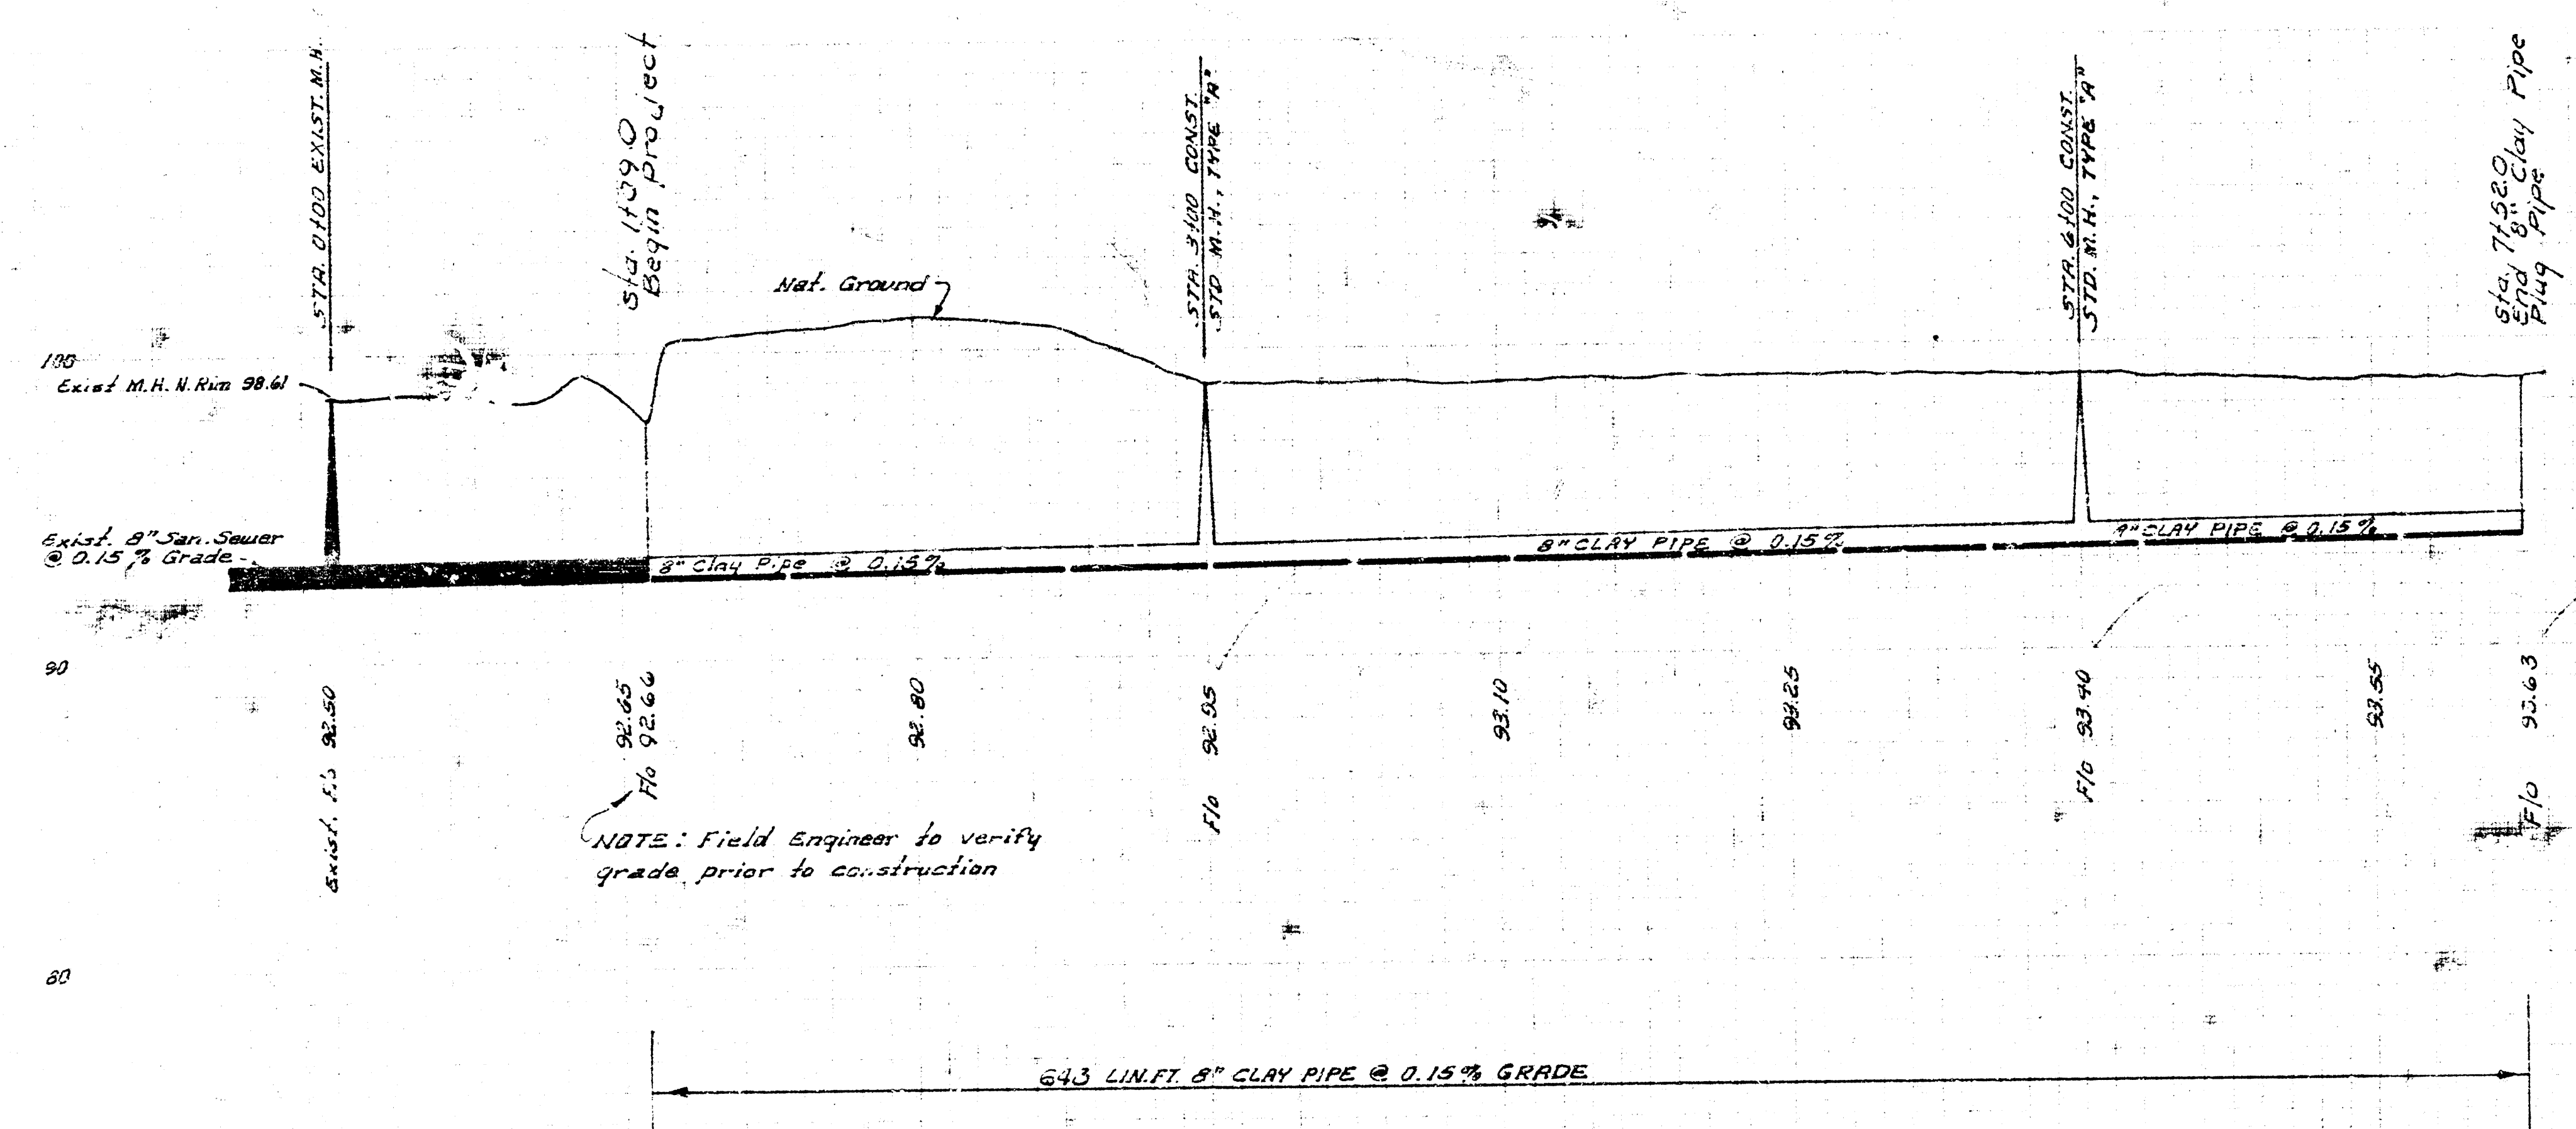

NOTE: Field Engineer to verify grade prior to construction

As Built Elevation 55.13

LAT. 109, SAN. SEWER 22
CITY OF WICHITA, KANSAS
R. W. LINN, CITY ENGINEER
PROJ. NO. DBKL568009
DATE: NOV. 1973

