




St. Also  
S. Spence

DBK-157

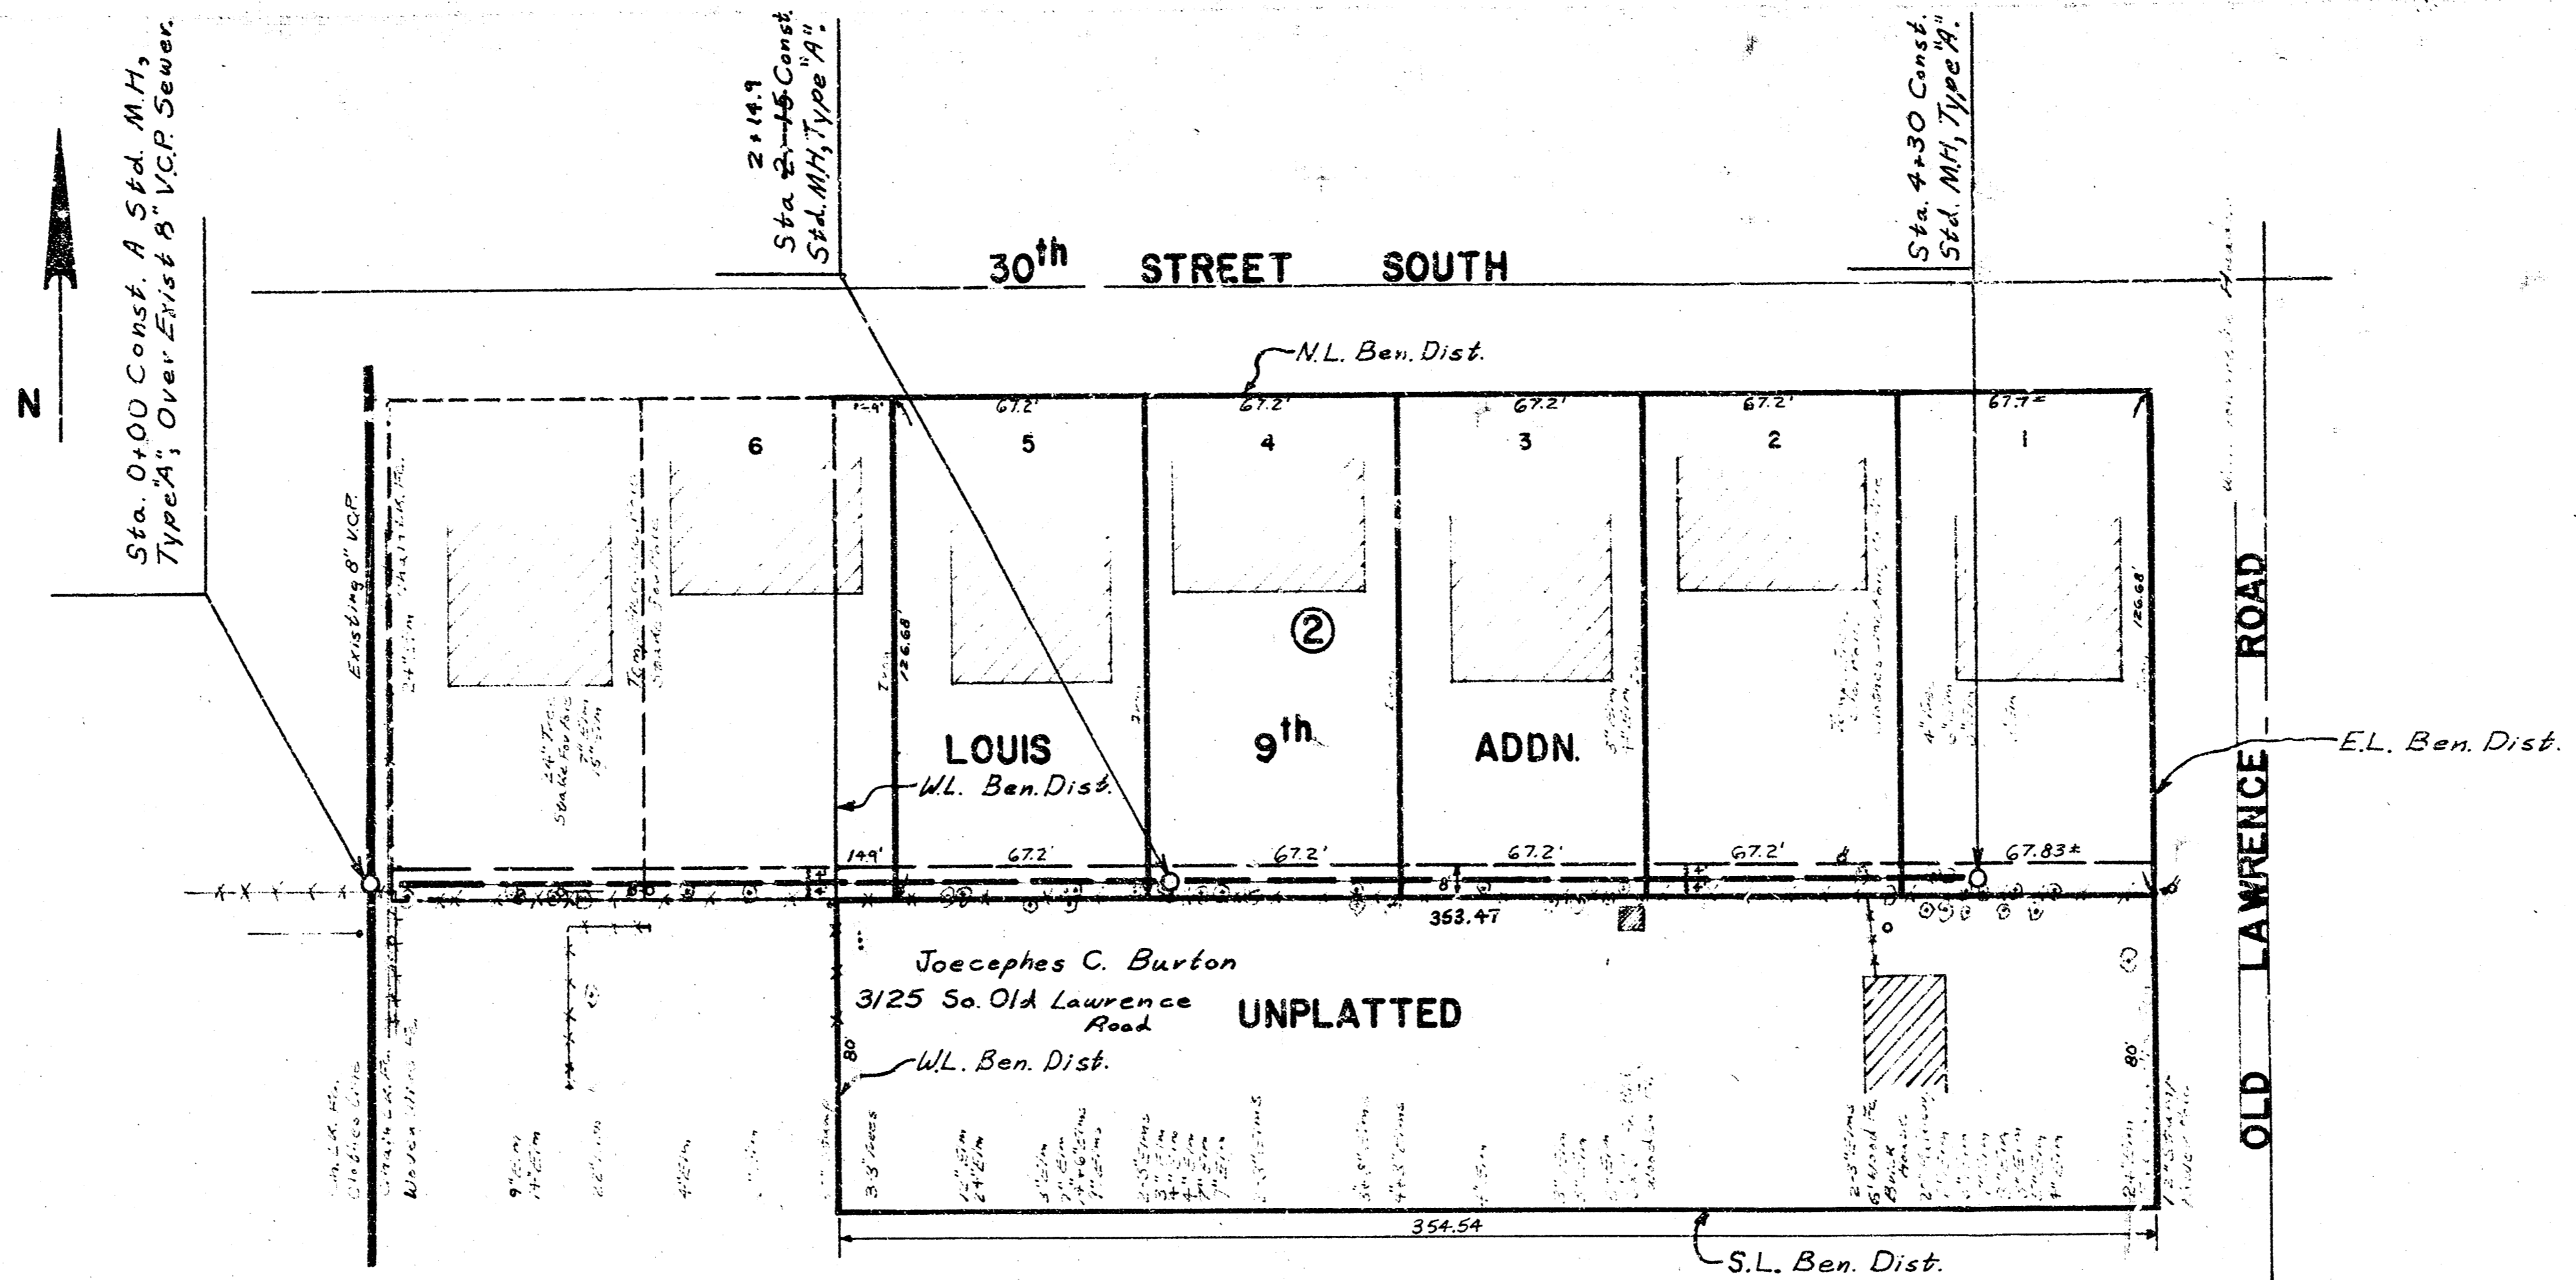

BM\*1 96.70 SW Cor. 1st Concrete Step, 210 W. 30th Street South.

Plan Scale: 1"=40'  
Profile Scale: Horizontal 1"=40'  
Vertical 1"=5'

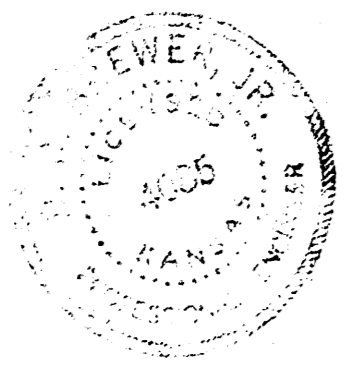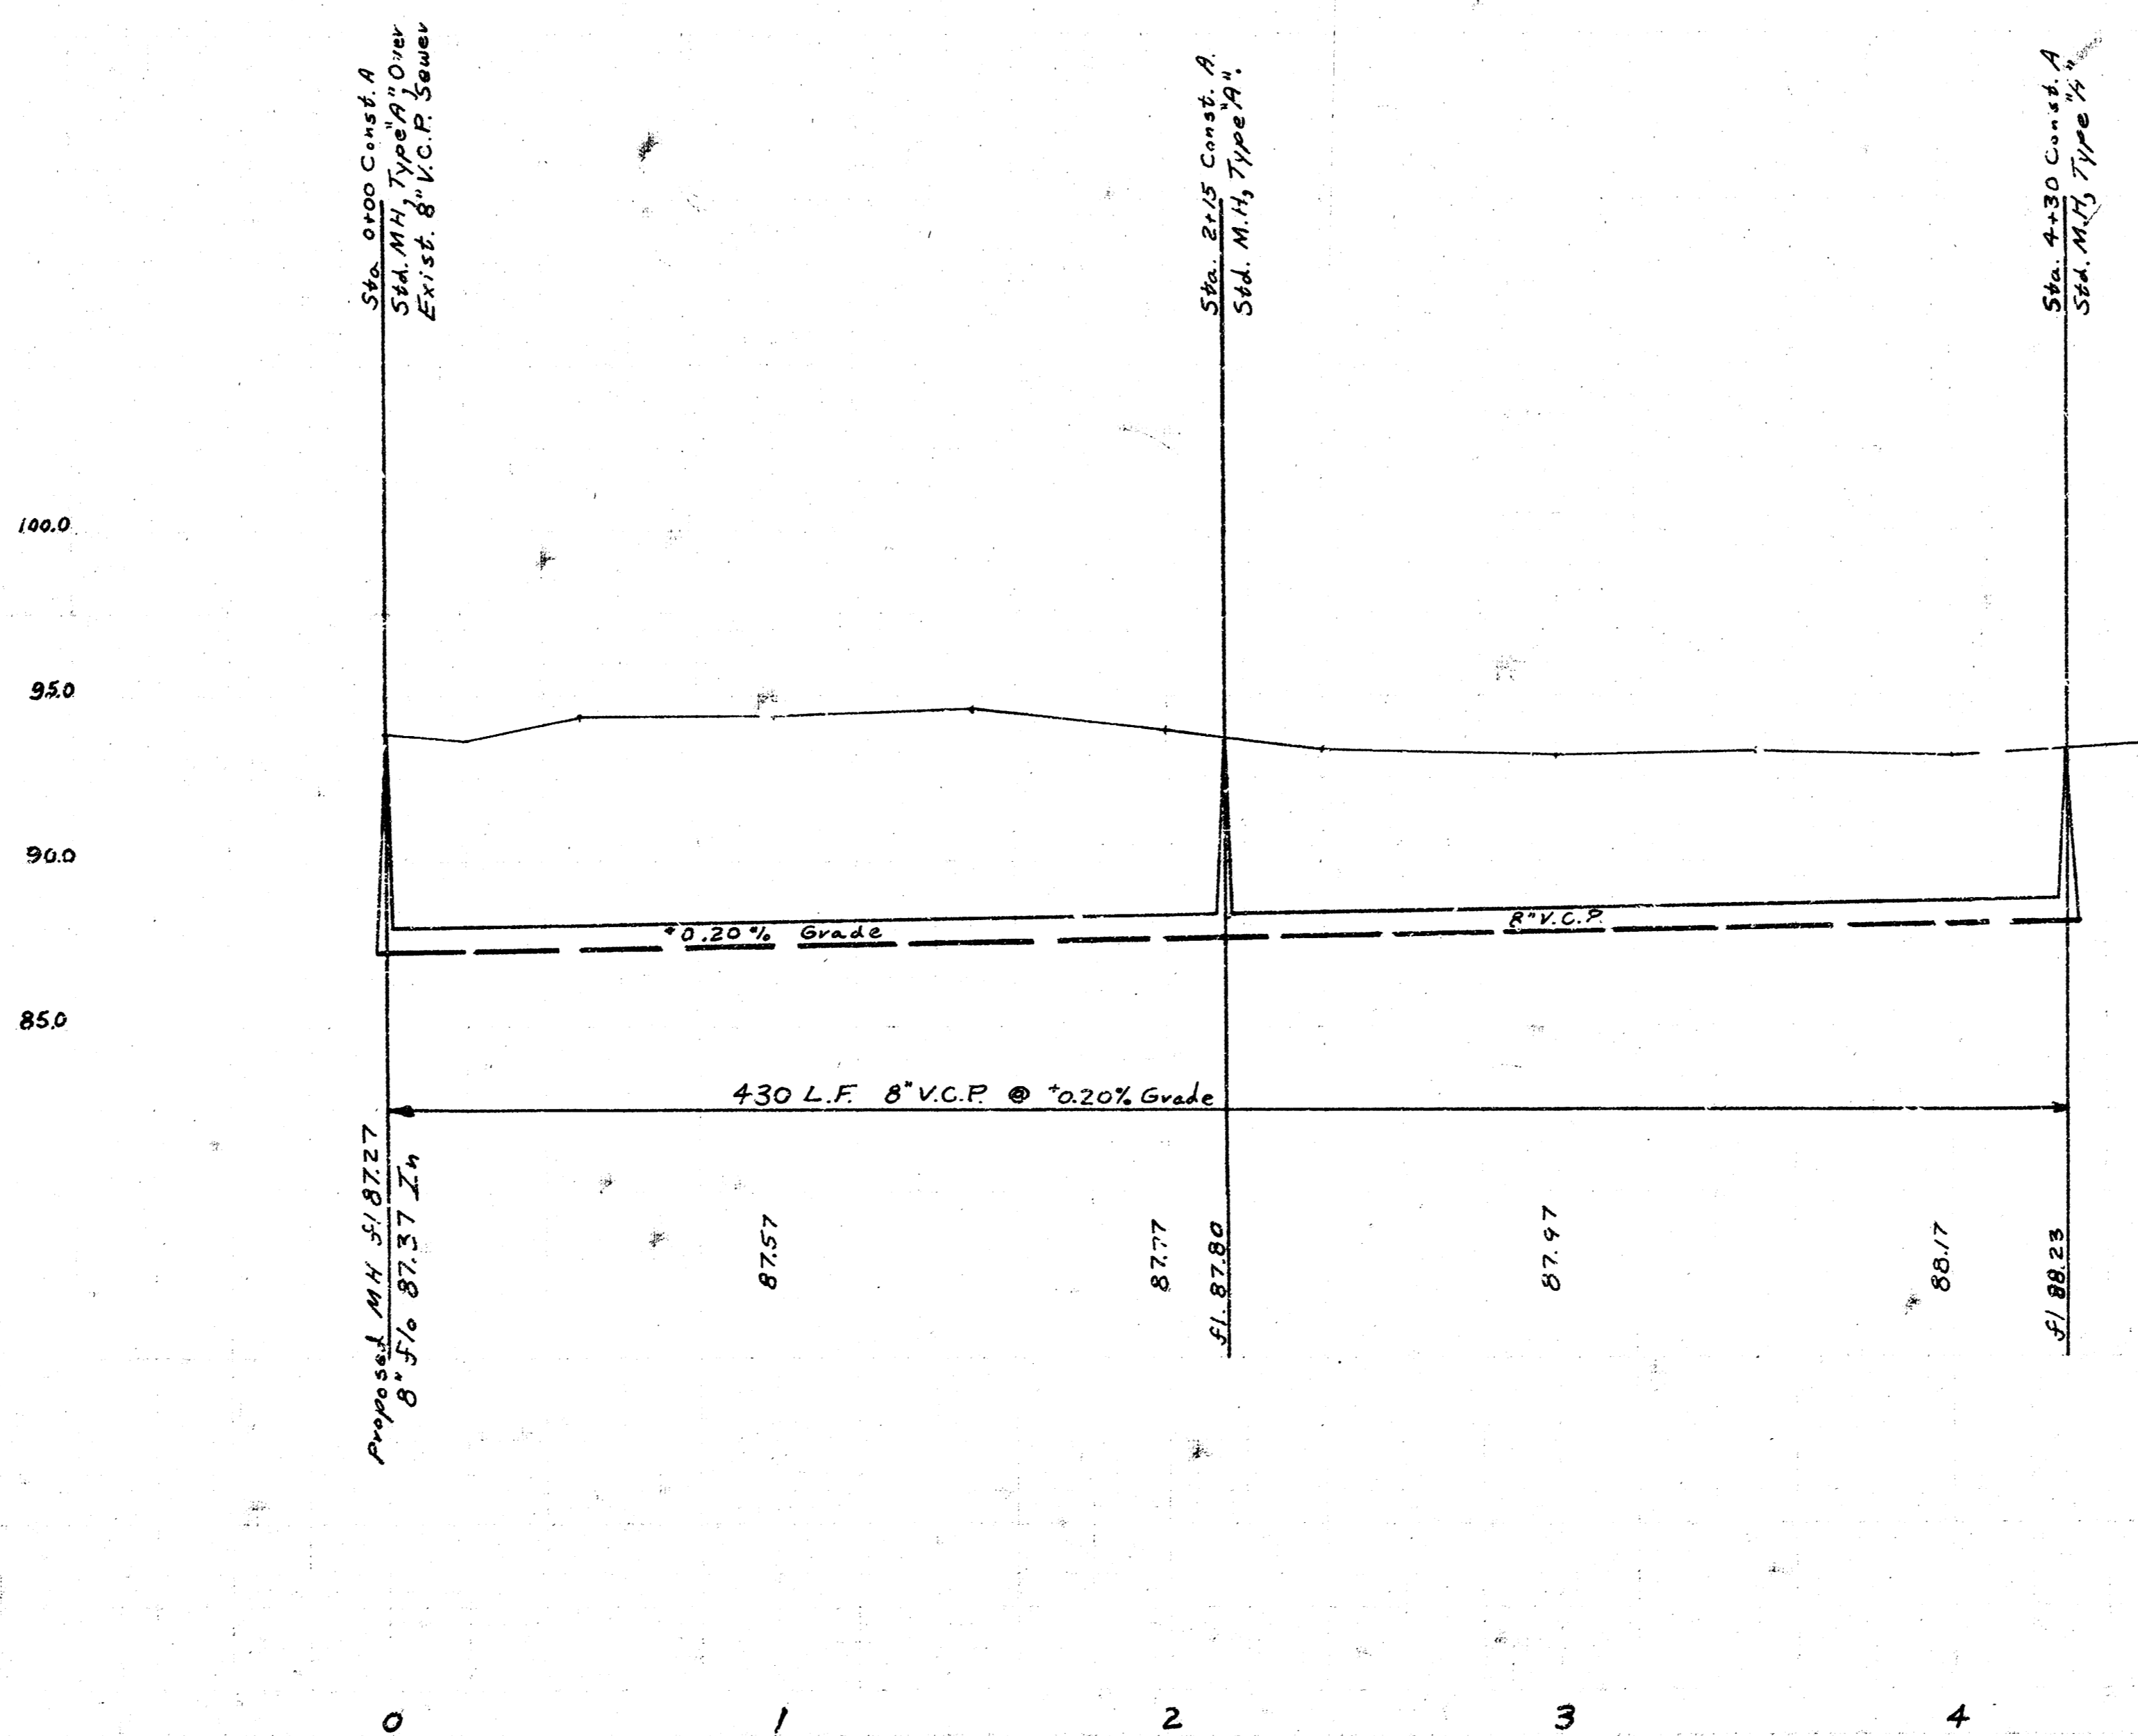

As Built Final Measmt. SS JK #9

LAT. 122 S.S. NO. 22  
CITY OF WICHITA, KANSAS  
R.W. LINN CITY ENGINEER  
DATE: JULY 1973  
SHEET: 1 OF 1  
PROJECT NO. DBKL 573031

14 2 5 18 Eng  
Water