


BM#1 96.70 W. Cor. 14" Concrete Step, 210 W. 30th Street South.

Plan Scale: 1" = 40'
 Profile Scale: Horizontal 1" = 40'
 Vertical 1" = 5'

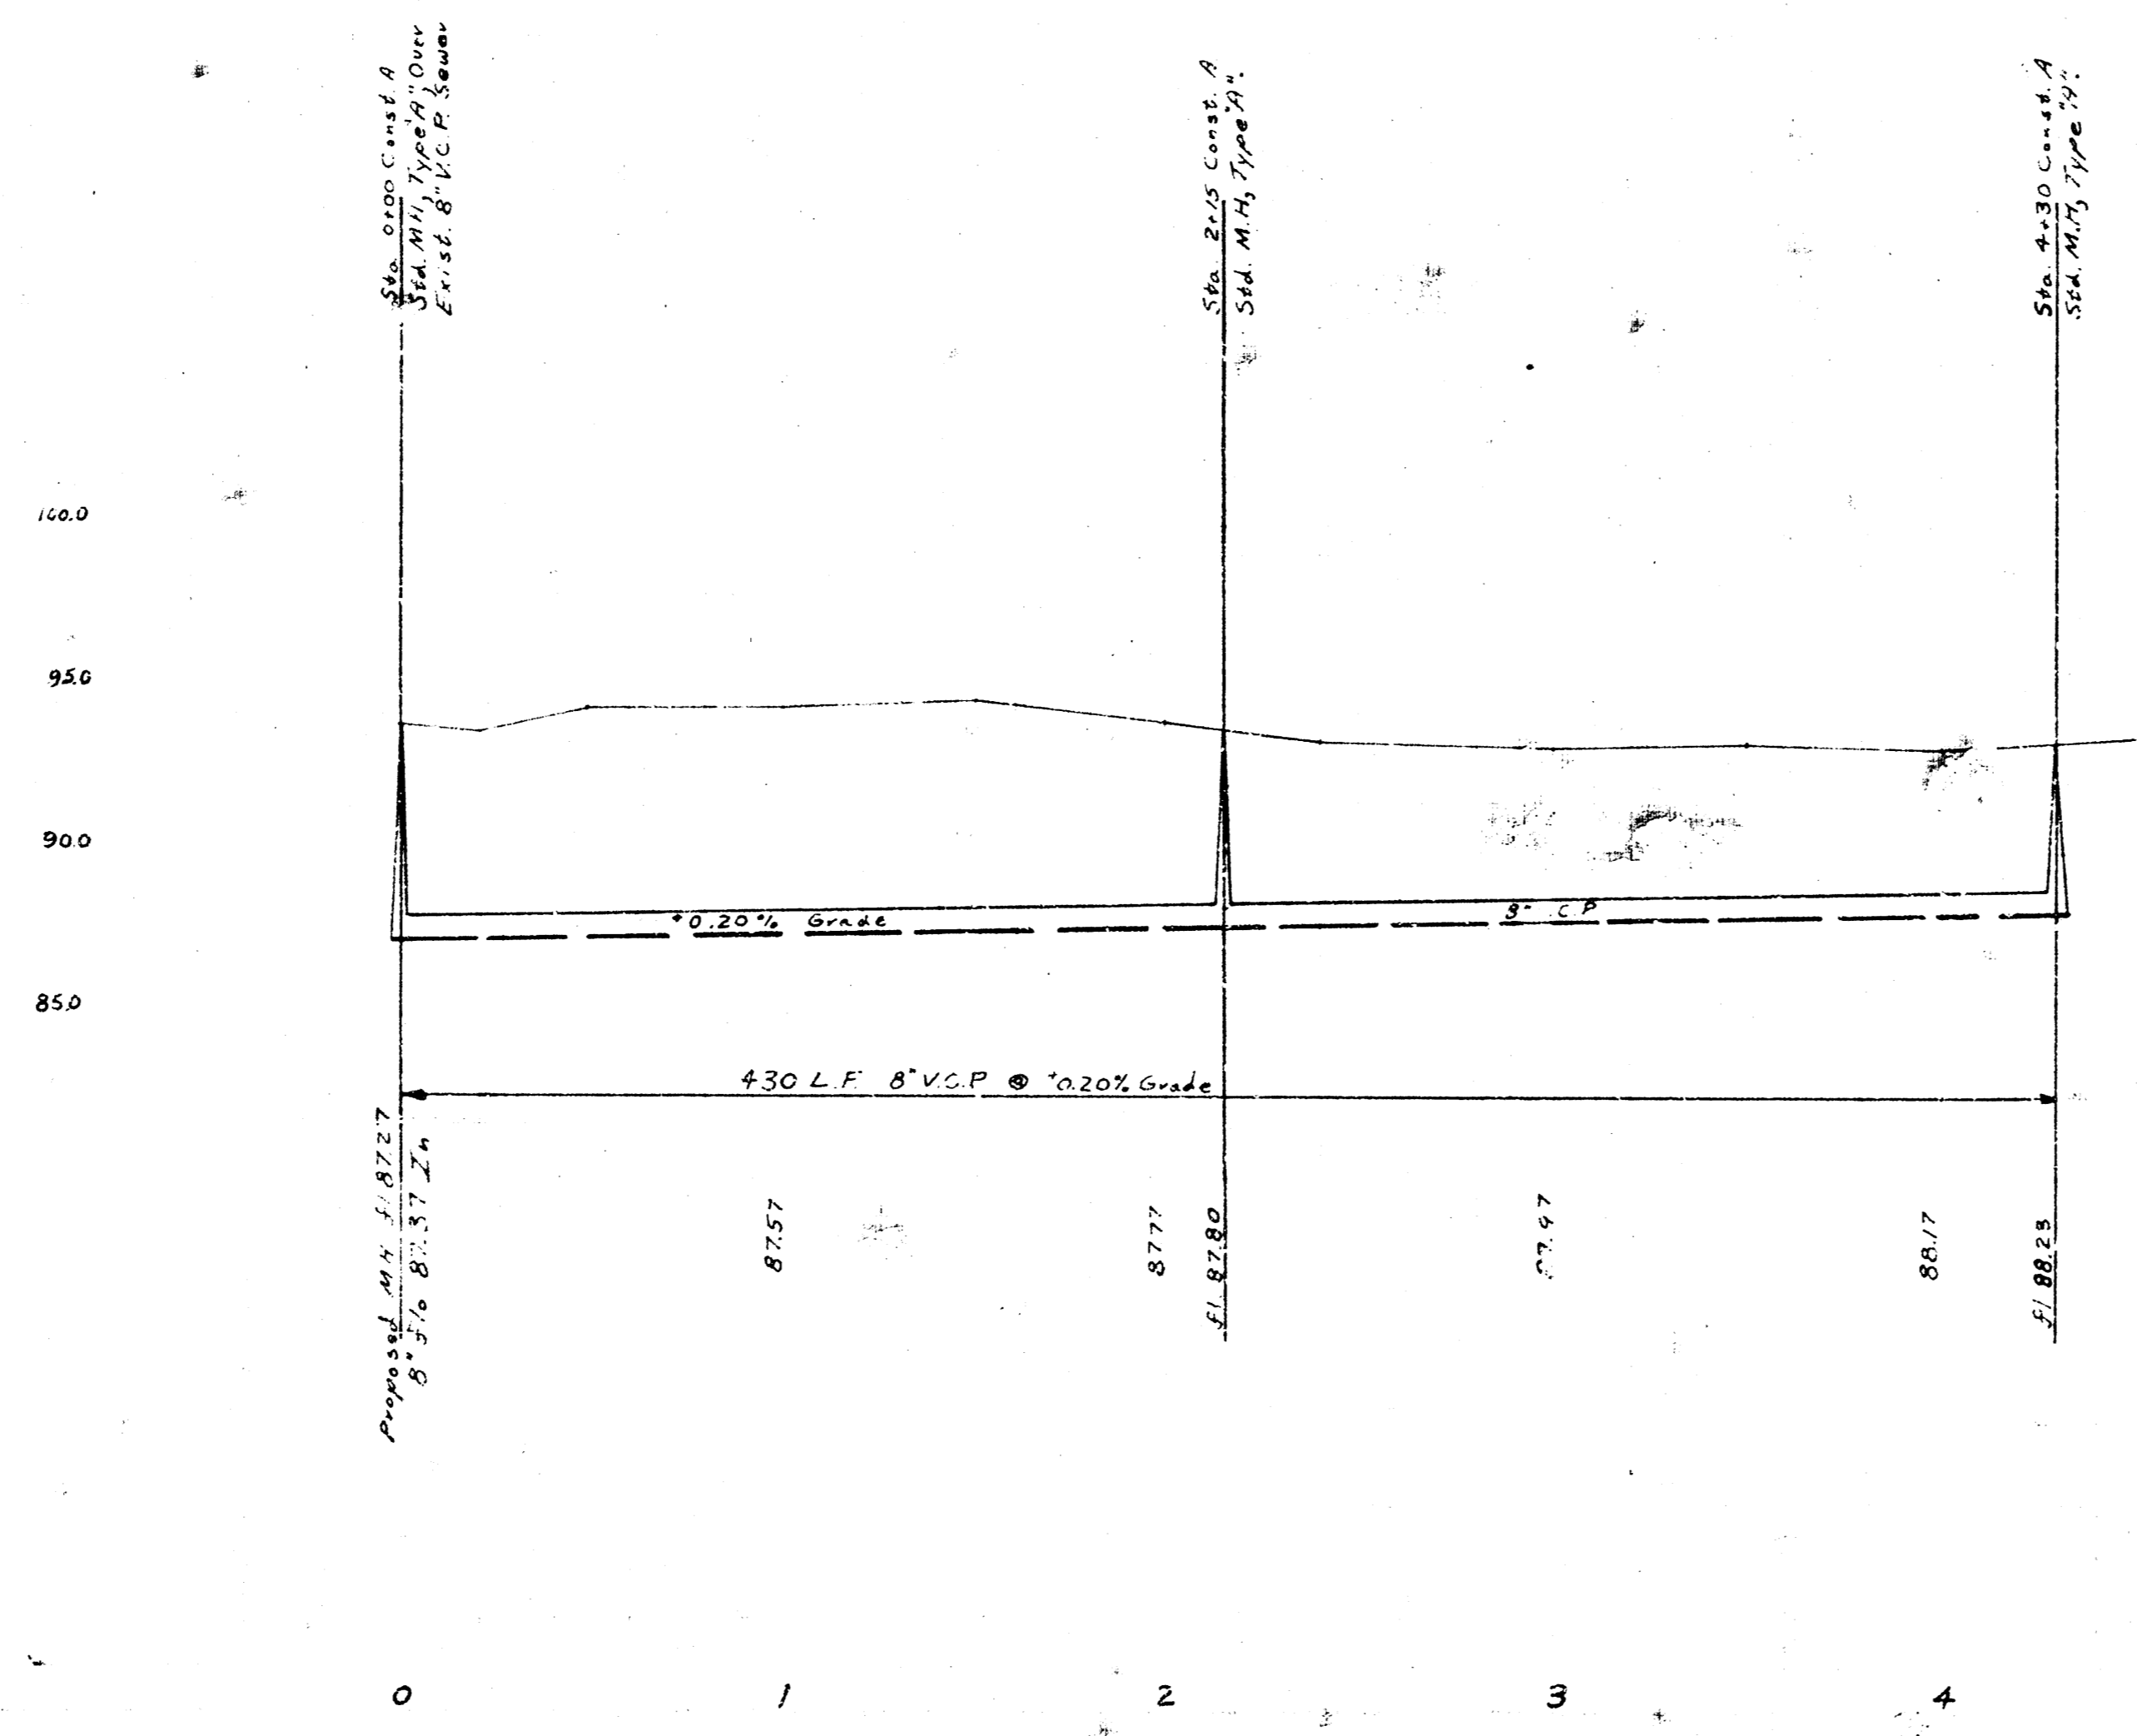

As Built Final Measmt. SS JK #9

LAT 122 S.S. NO. 22
 CITY OF WICHITA, KANSAS
 R.W. LINN CITY ENGINEER
 DATE: JULY 1973
 SHEET: 1 OF 1
 PROJECT NO. DBKL 573031