



B. M. 115.54 "M" in Mueller F. P.
S. E. West & M^c Carmick
B. M. 113.25 S.W. cor. wk S.E.
Kessler & M^c Carmick.

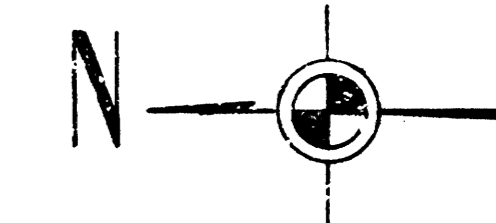

Plan Scale 1" = 40'
Profile Scale 1" = 5' Vert.


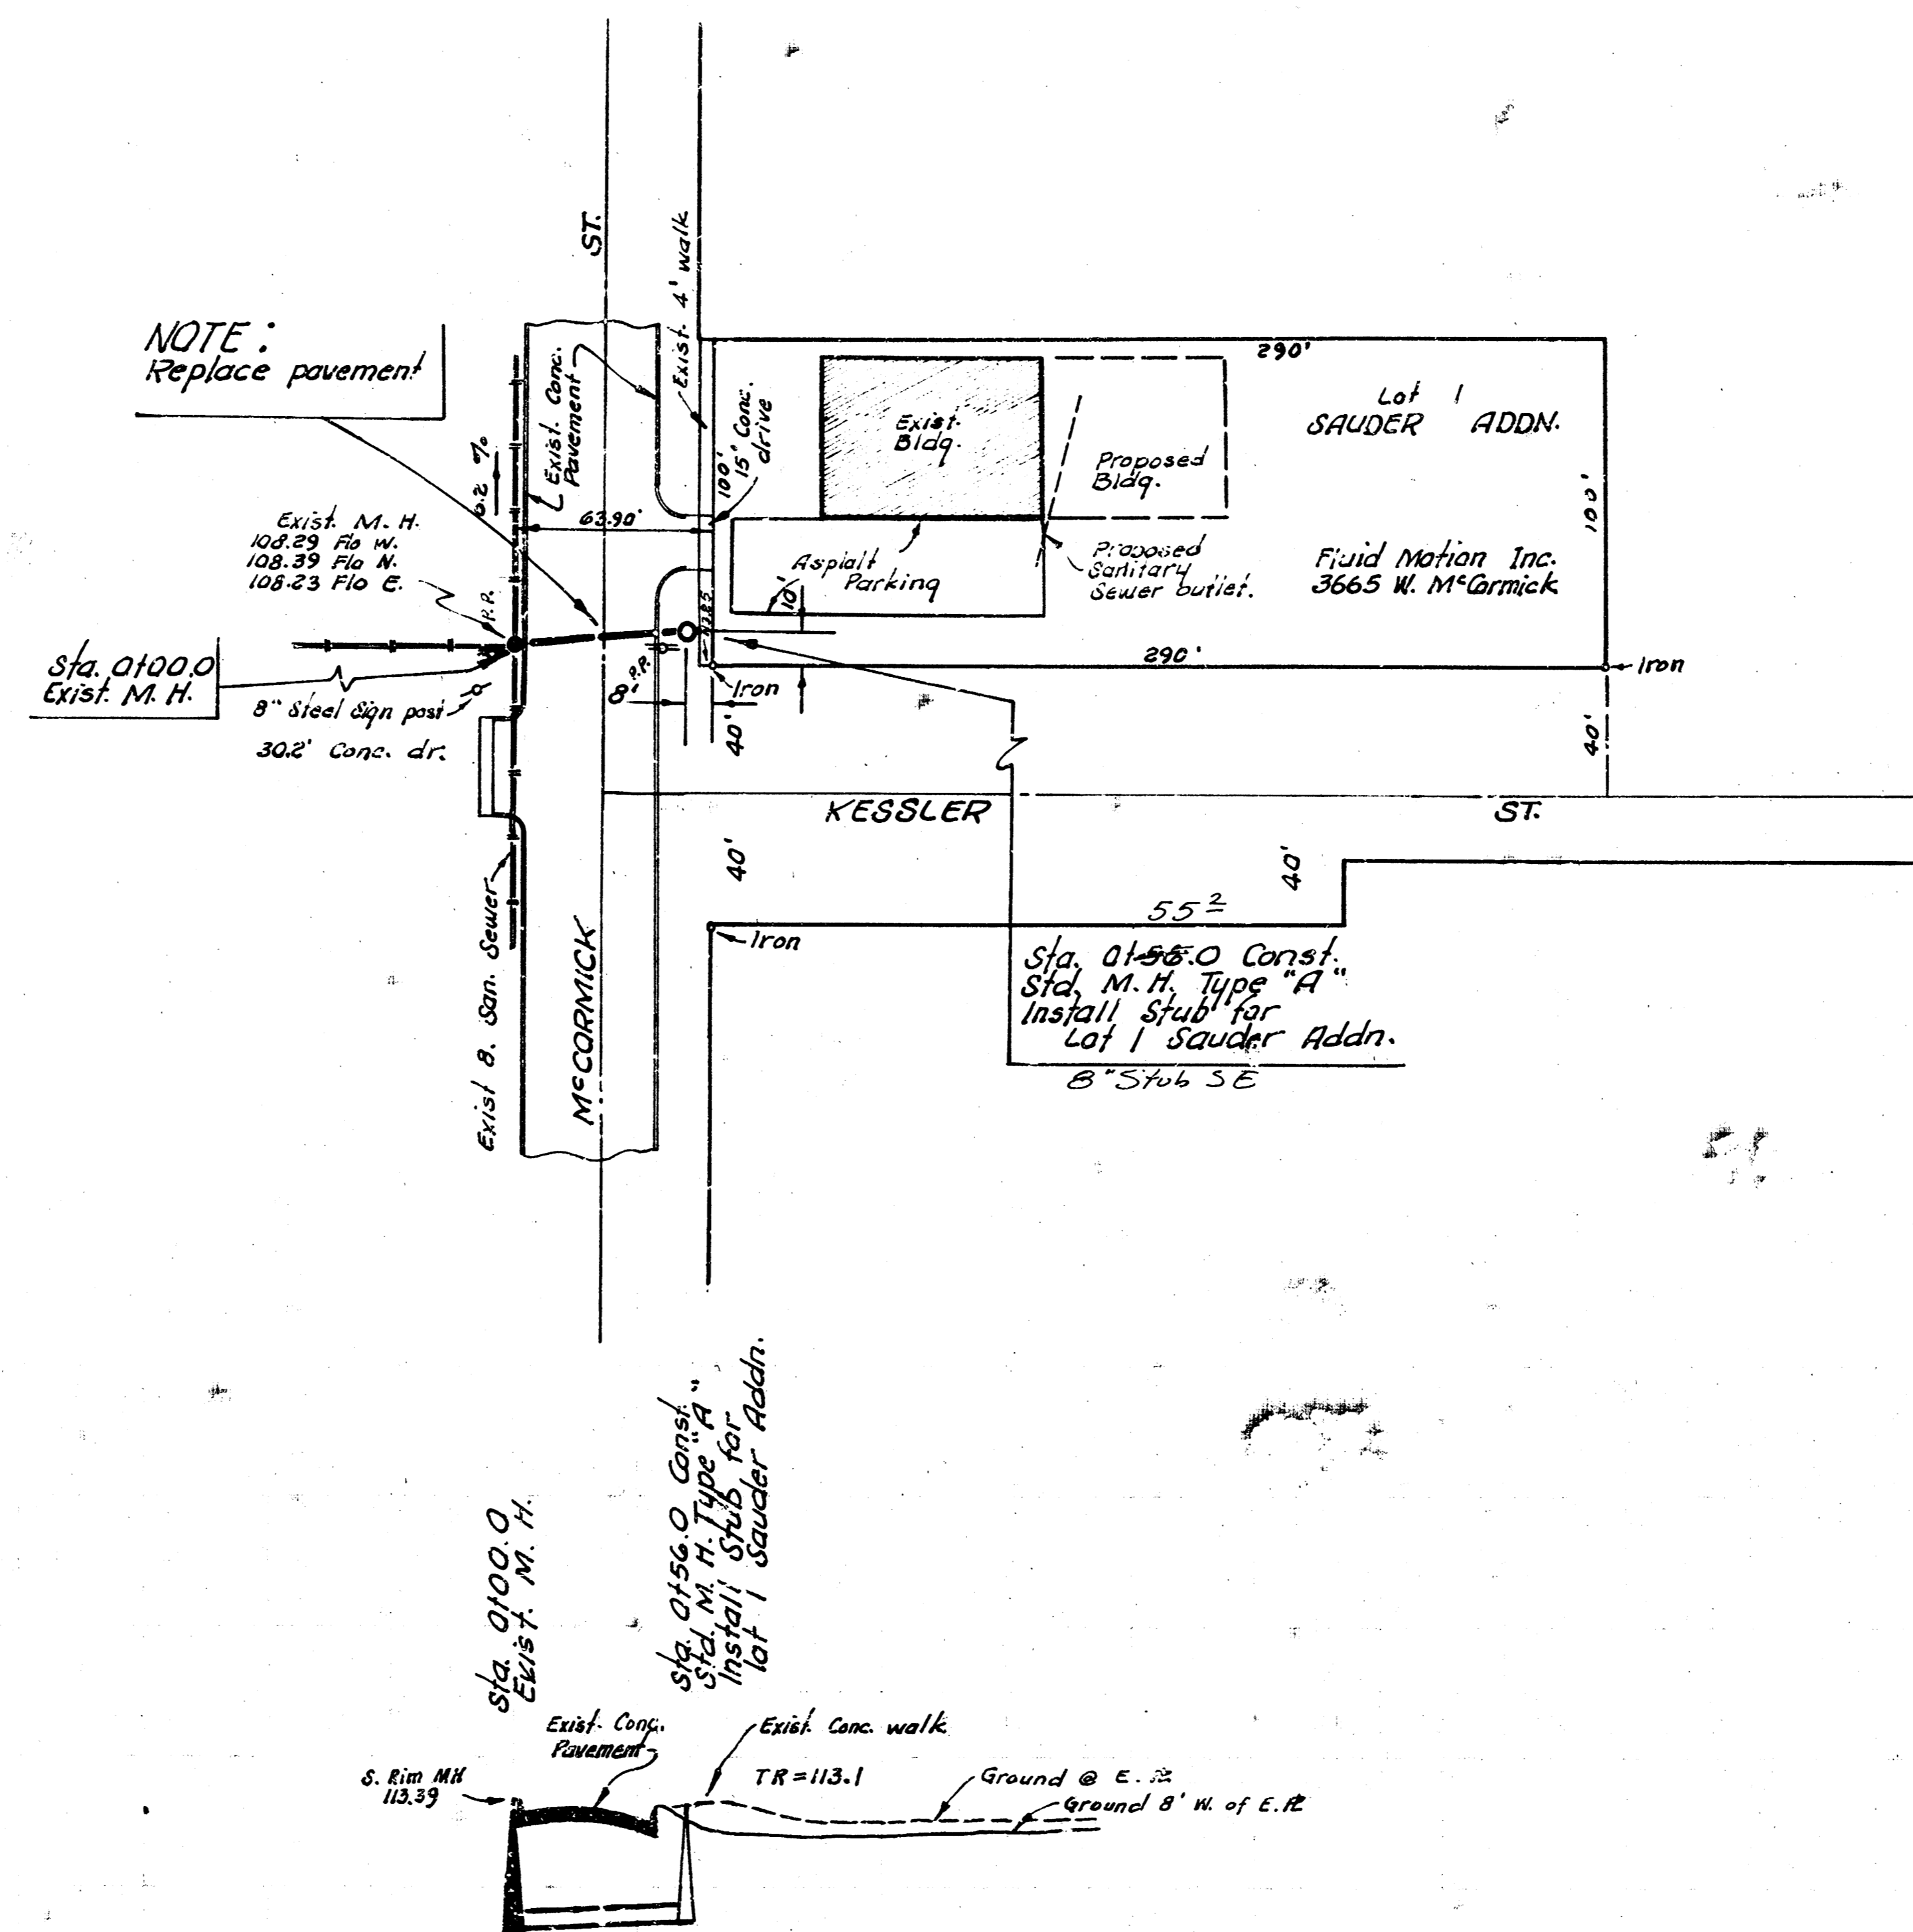


D. R. W.

S

115
110
105

115
110
105

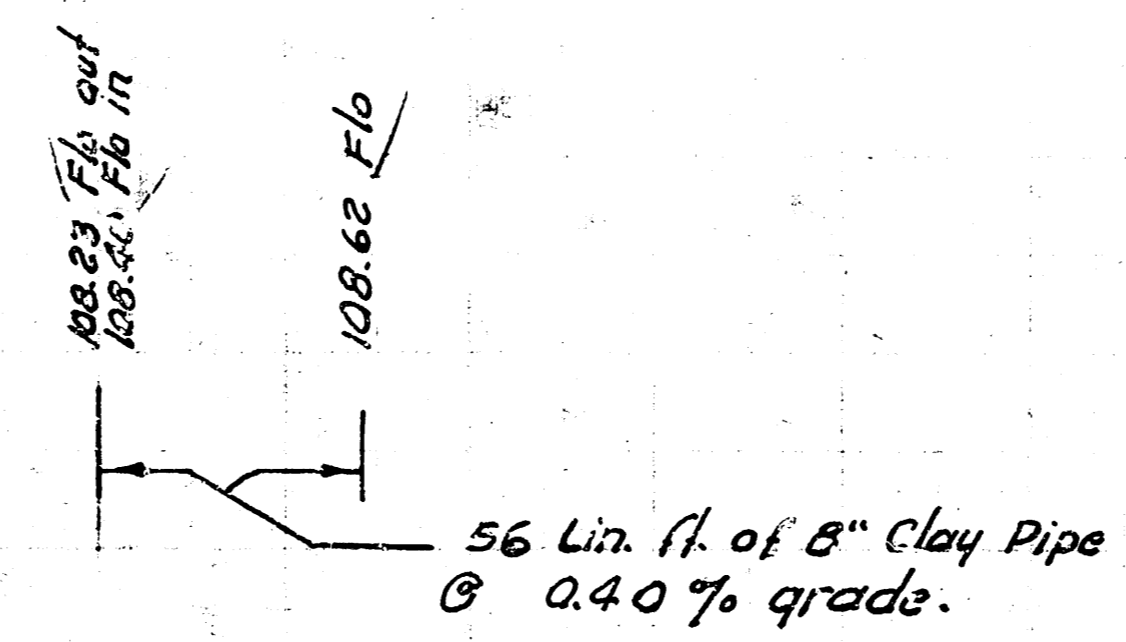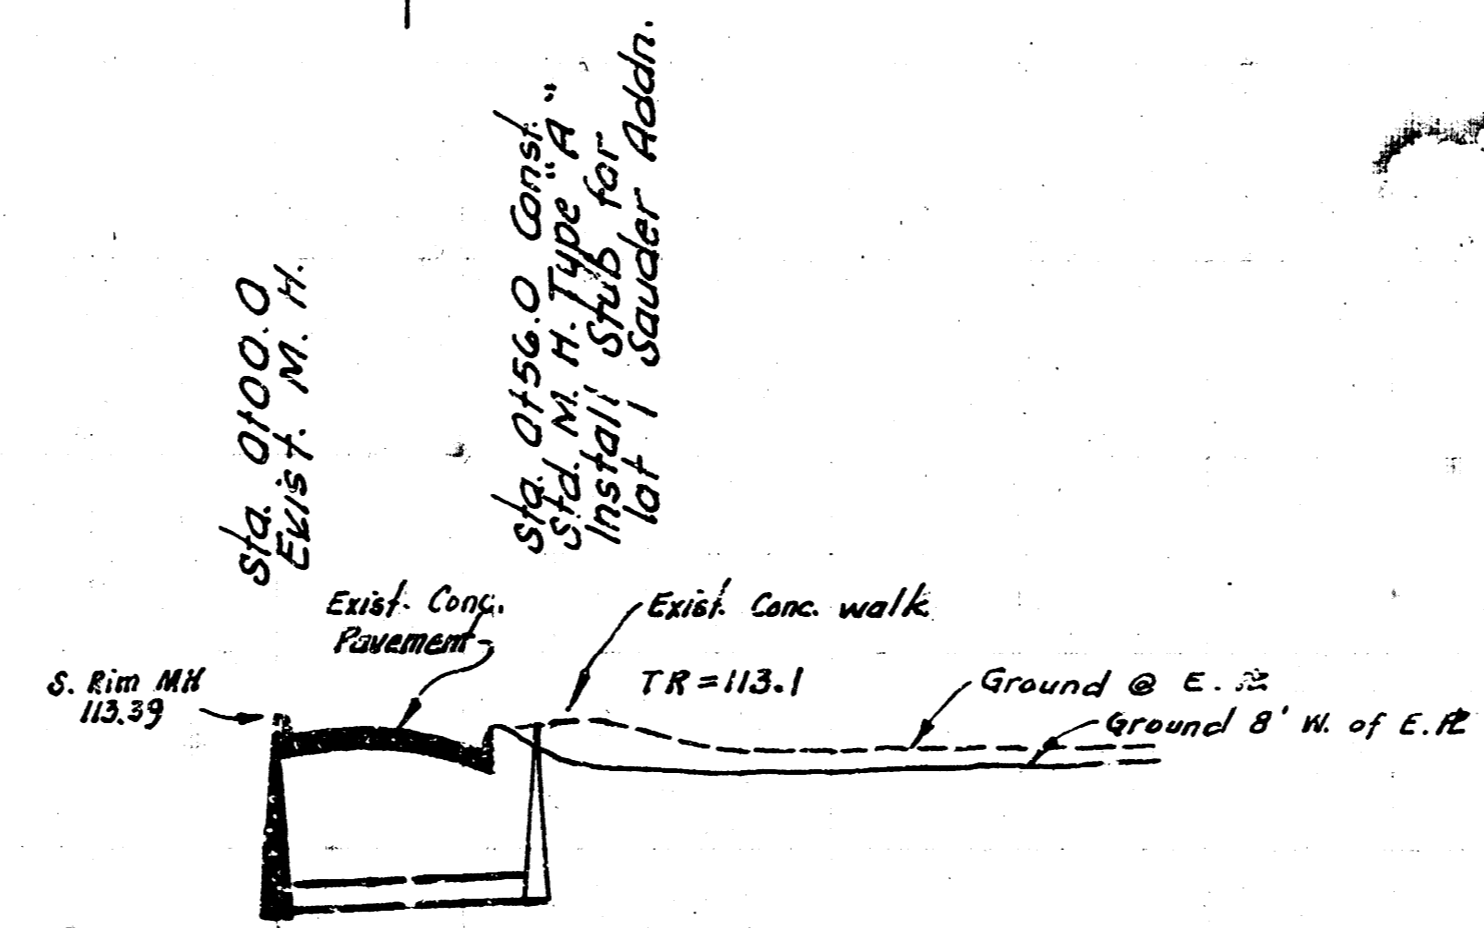

As Built Final Meas SS JK #6
LAT. 125, S. S. NO. 22
 CITY OF WICHITA, KANSAS
 R. W. LINN — CITY ENGINEER
 MAR. 1974 PROJECT NO. DBKL 574004