





B.M. 100<sup>26</sup> 12" Top Curb - South Return S.W. Cor. Wildwood & St Paul  
 B.M. 99<sup>26</sup> Spike, West-face Power Pole S.E. Cor. Wildwood & Edwards  
 B.M. 79<sup>26</sup> City Std. Dec. 6' N & 2' E. of S.E. 1/4 Cor. Sheridan & 31<sup>st</sup> St South

Drawn from 1975 Survey

JUL 20 1975

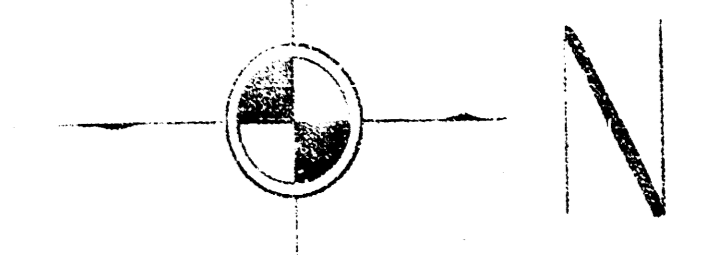

Plan Scale 1" = 40'  
 Profile Scale 1" = 40' Horiz.  
 1" = 5' Vert.

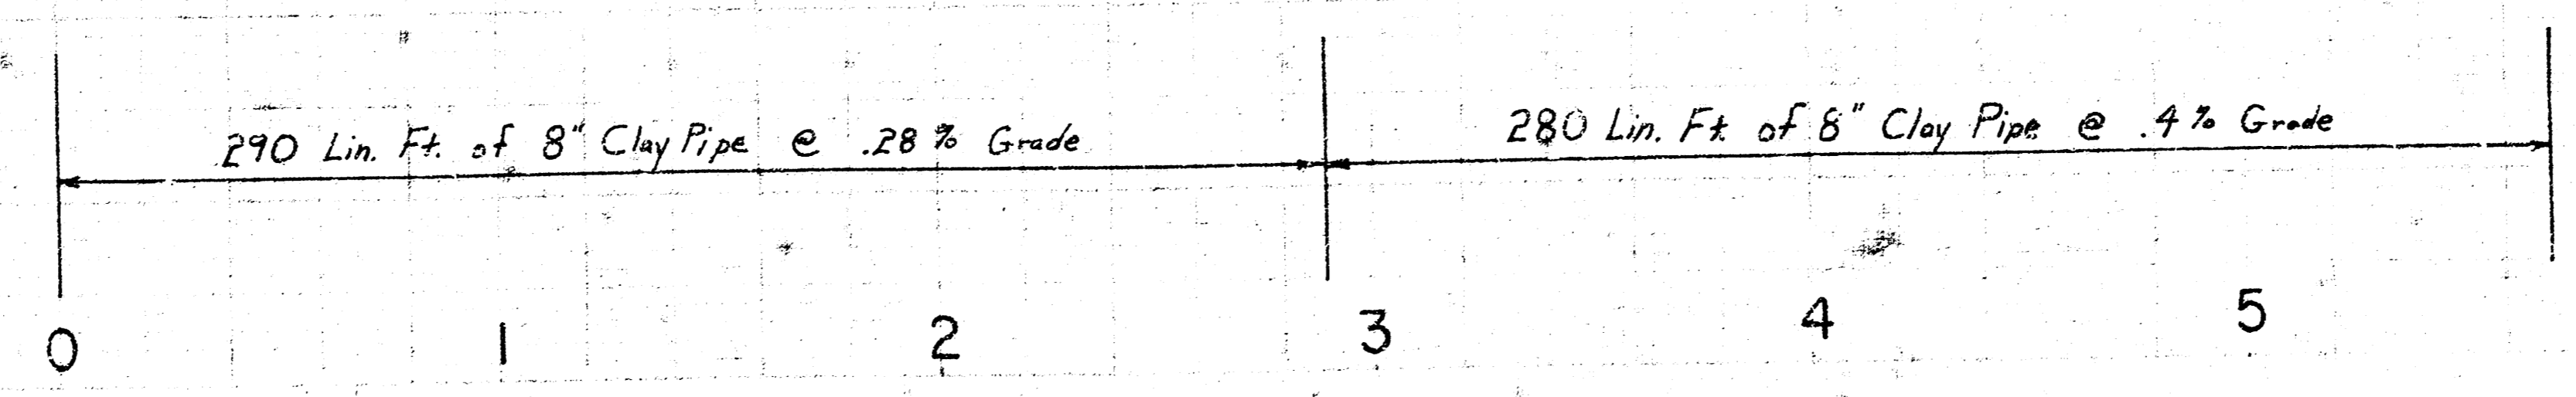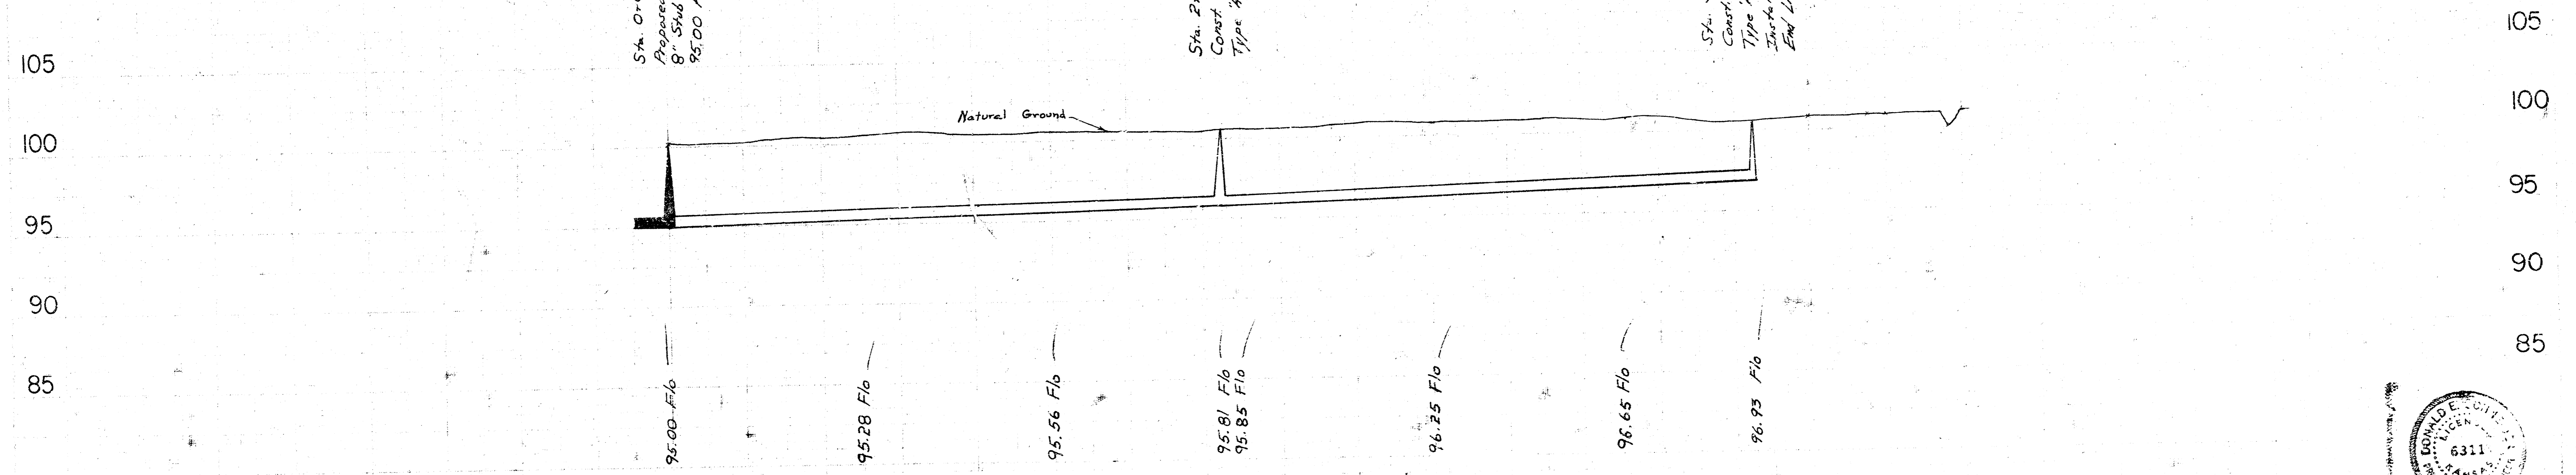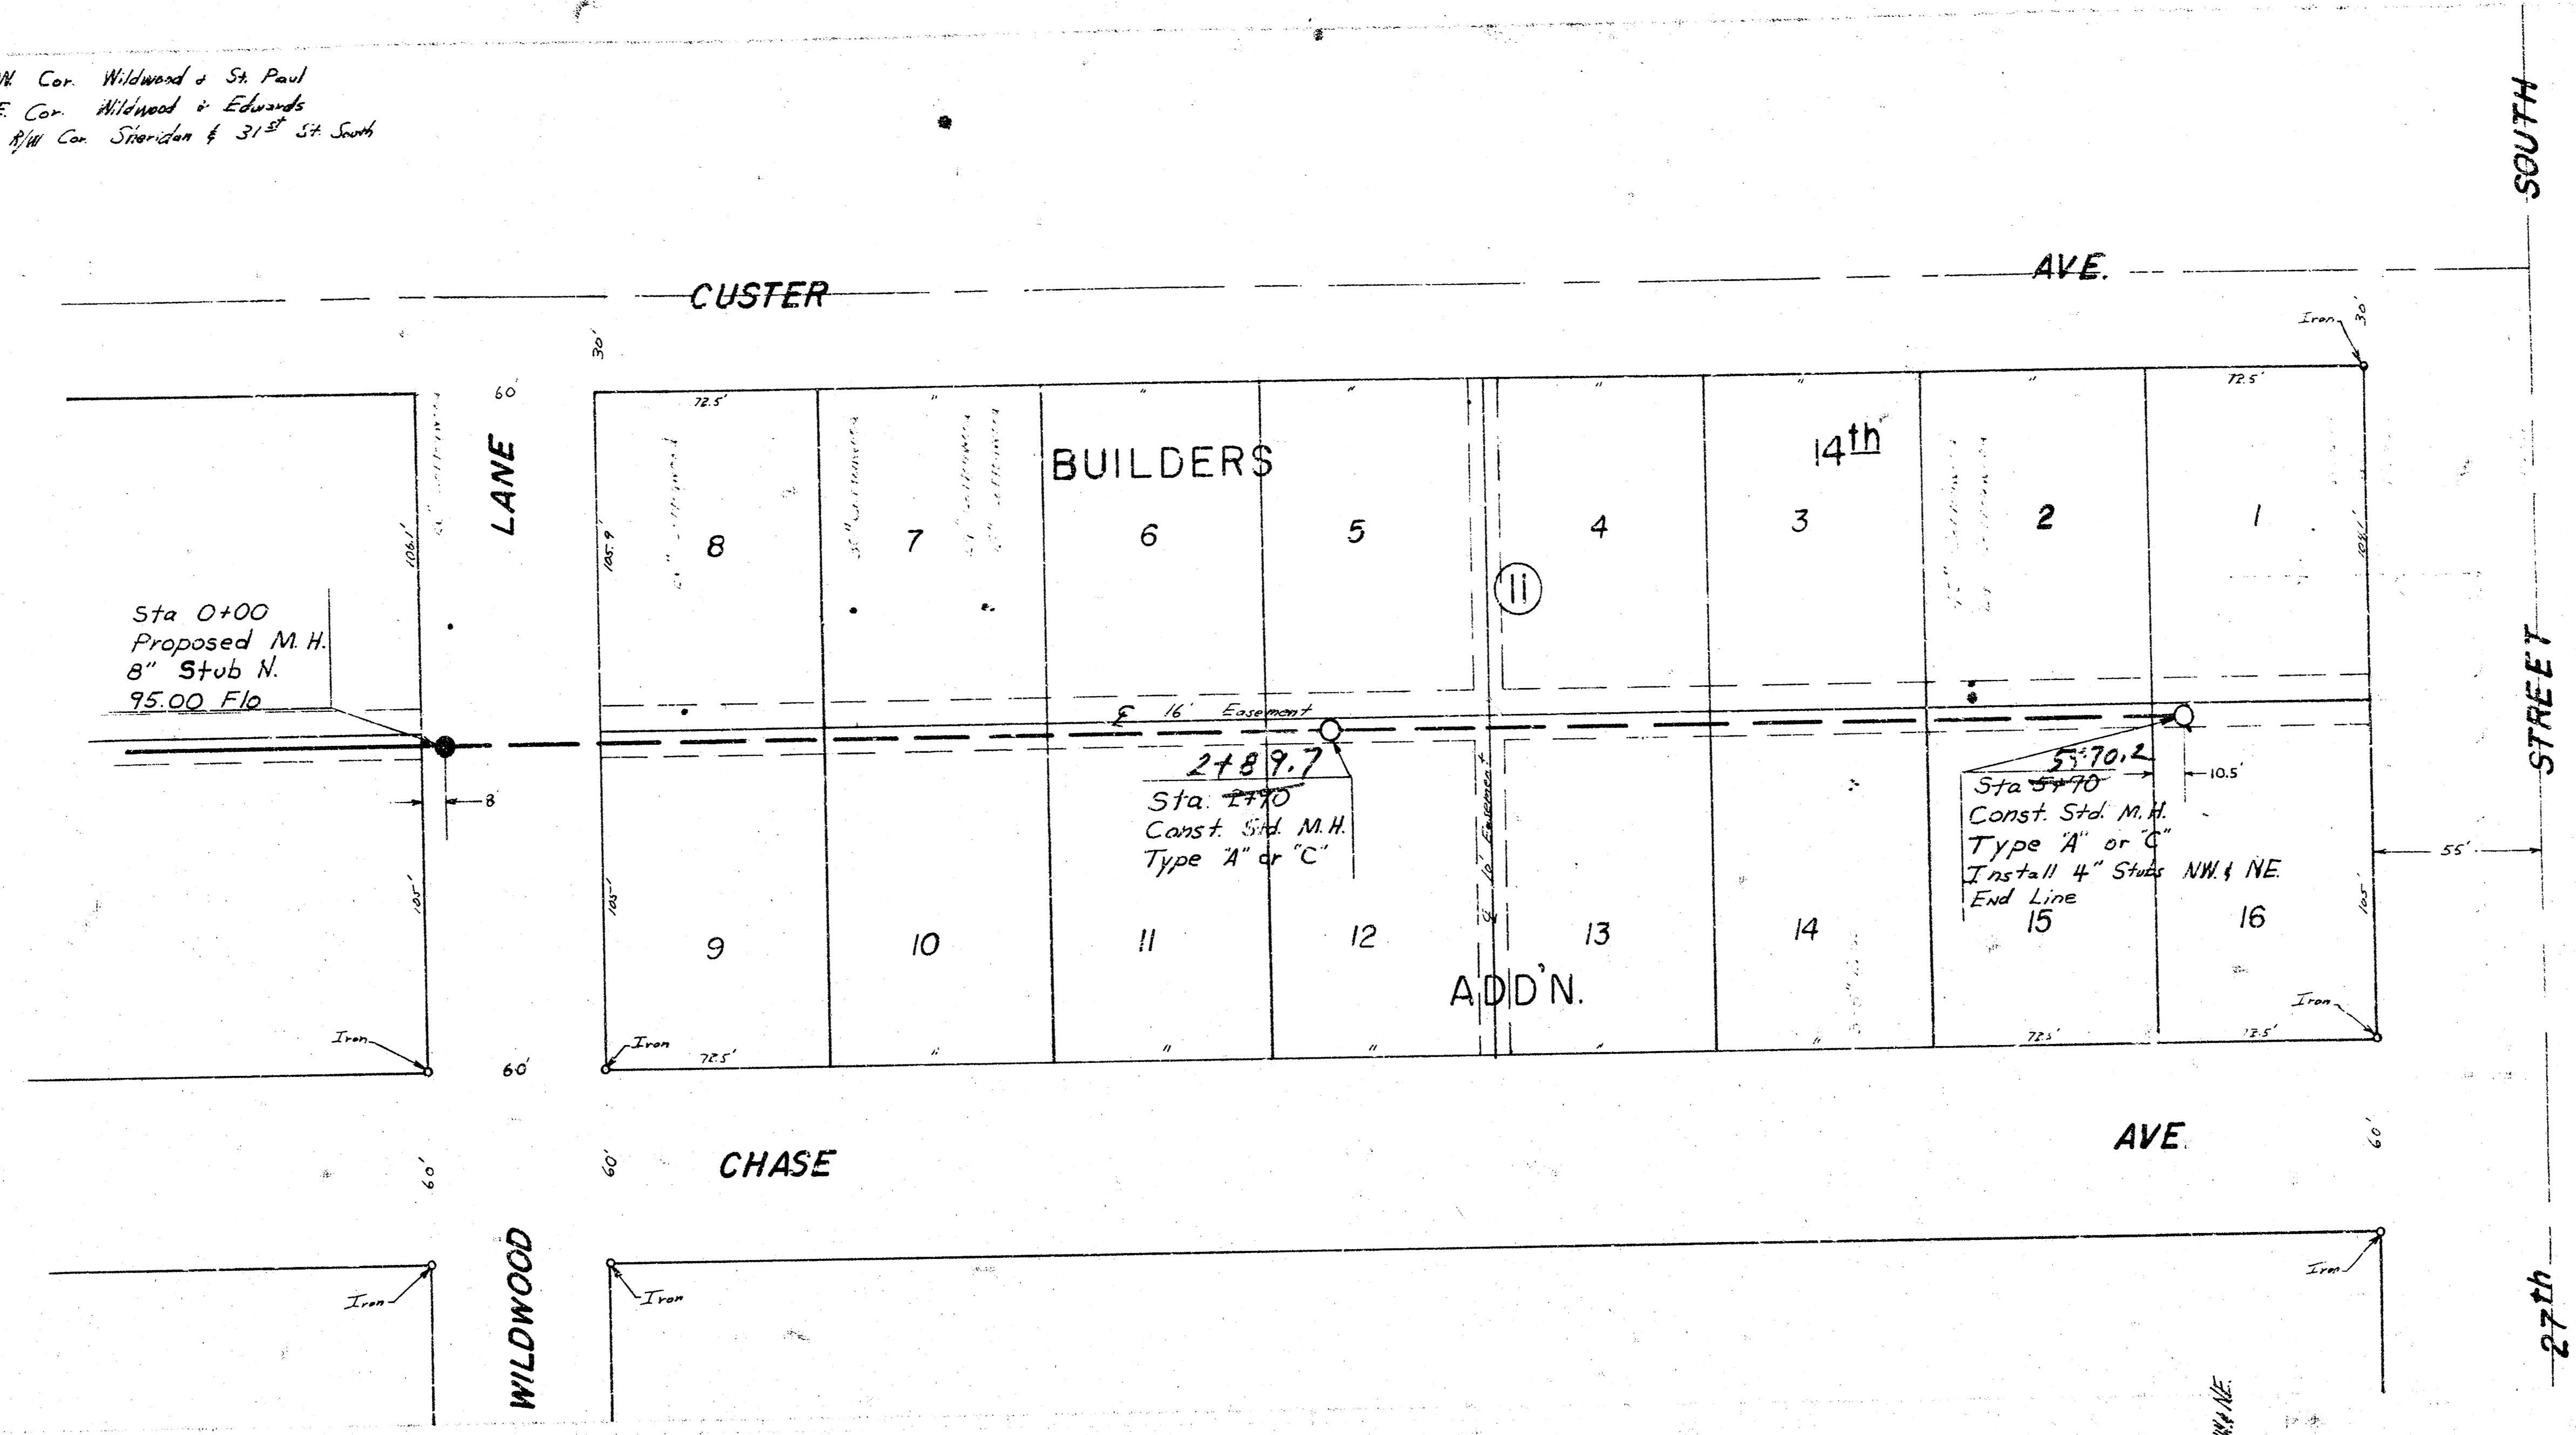

*As Built 7-2-75*

LAT. 128	S.S. NO. 22
CITY OF WICHITA, KANSAS	
R. W. LINN	CITY ENGINEER
PROJECT NO. DBKL 575028	

