



B.M. 103.52 City B.M. Disc Top East End
 South Handrail RCBC Sheridan & 31st
 B.M. 99.93 City Std. Disc. 6' N & 2' E. of
 SE R/W Corner of Sheridan & 31st

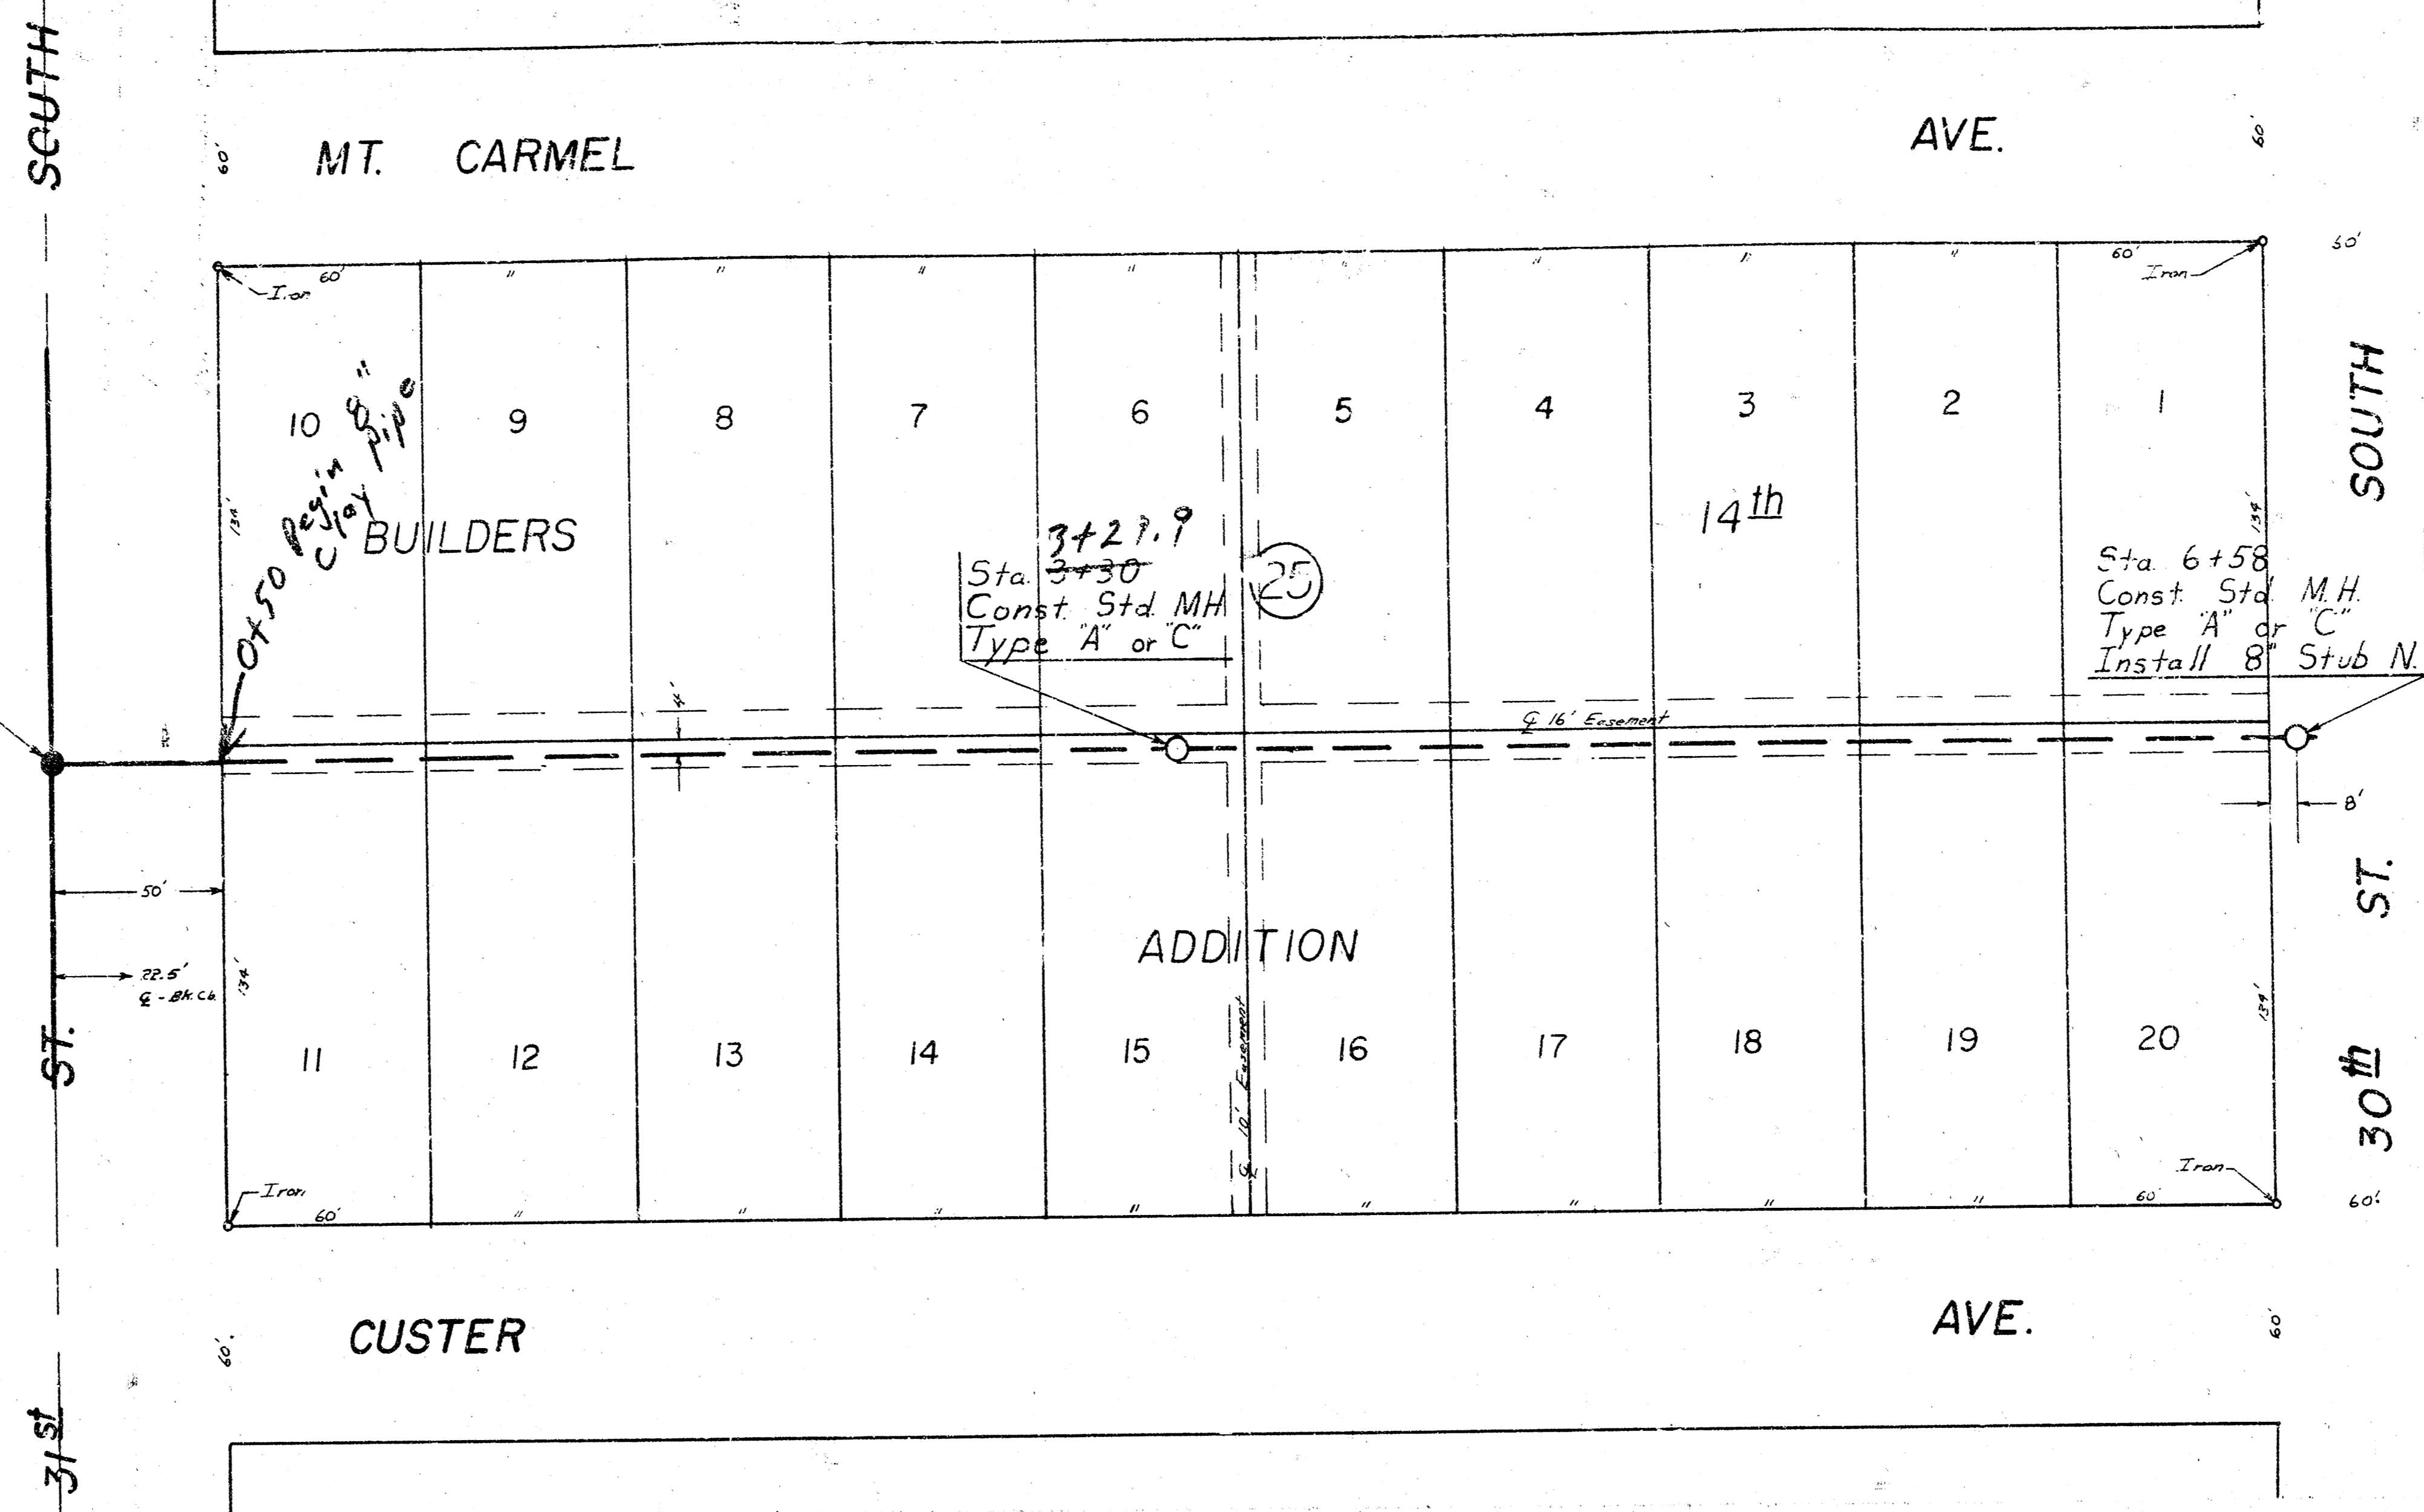

Plan Scale 1" = 40'
 Profile Scale 1" = 40' Horiz.
 1" = 5' Vert.

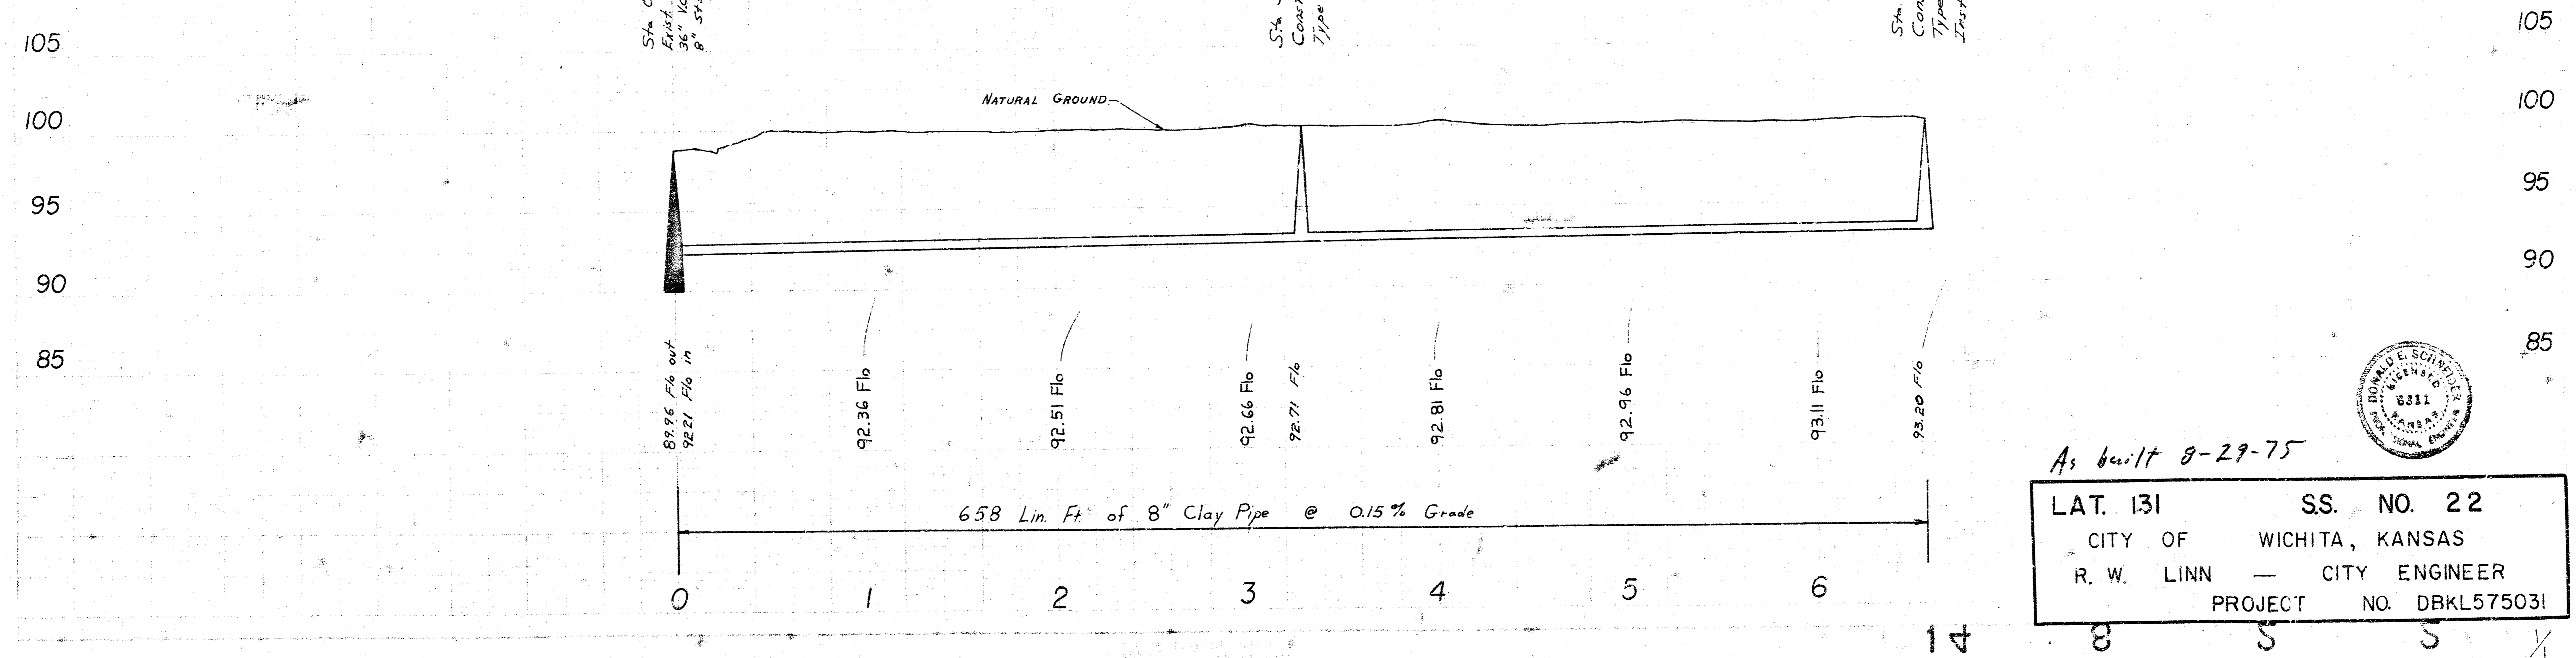

As built 8-29-75
 LAT. 131 SS. NO. 22
 CITY OF WICHITA, KANSAS
 R. W. LINN — CITY ENGINEER
 PROJECT NO. DBKL575031

