




LOCATION MAP
 LAT. 24 SAN. SEWER 22
 CITY OF WICHITA
 B.E. SMITH CITY ENGINEER PROJECT NO. C25-101

SURVEY BY: C. H. MALLS NOTEBOOK CH. 100
 DRAWN BY: T. F. PEYER
 CHECKED BY: FEB. 1956
 DATE

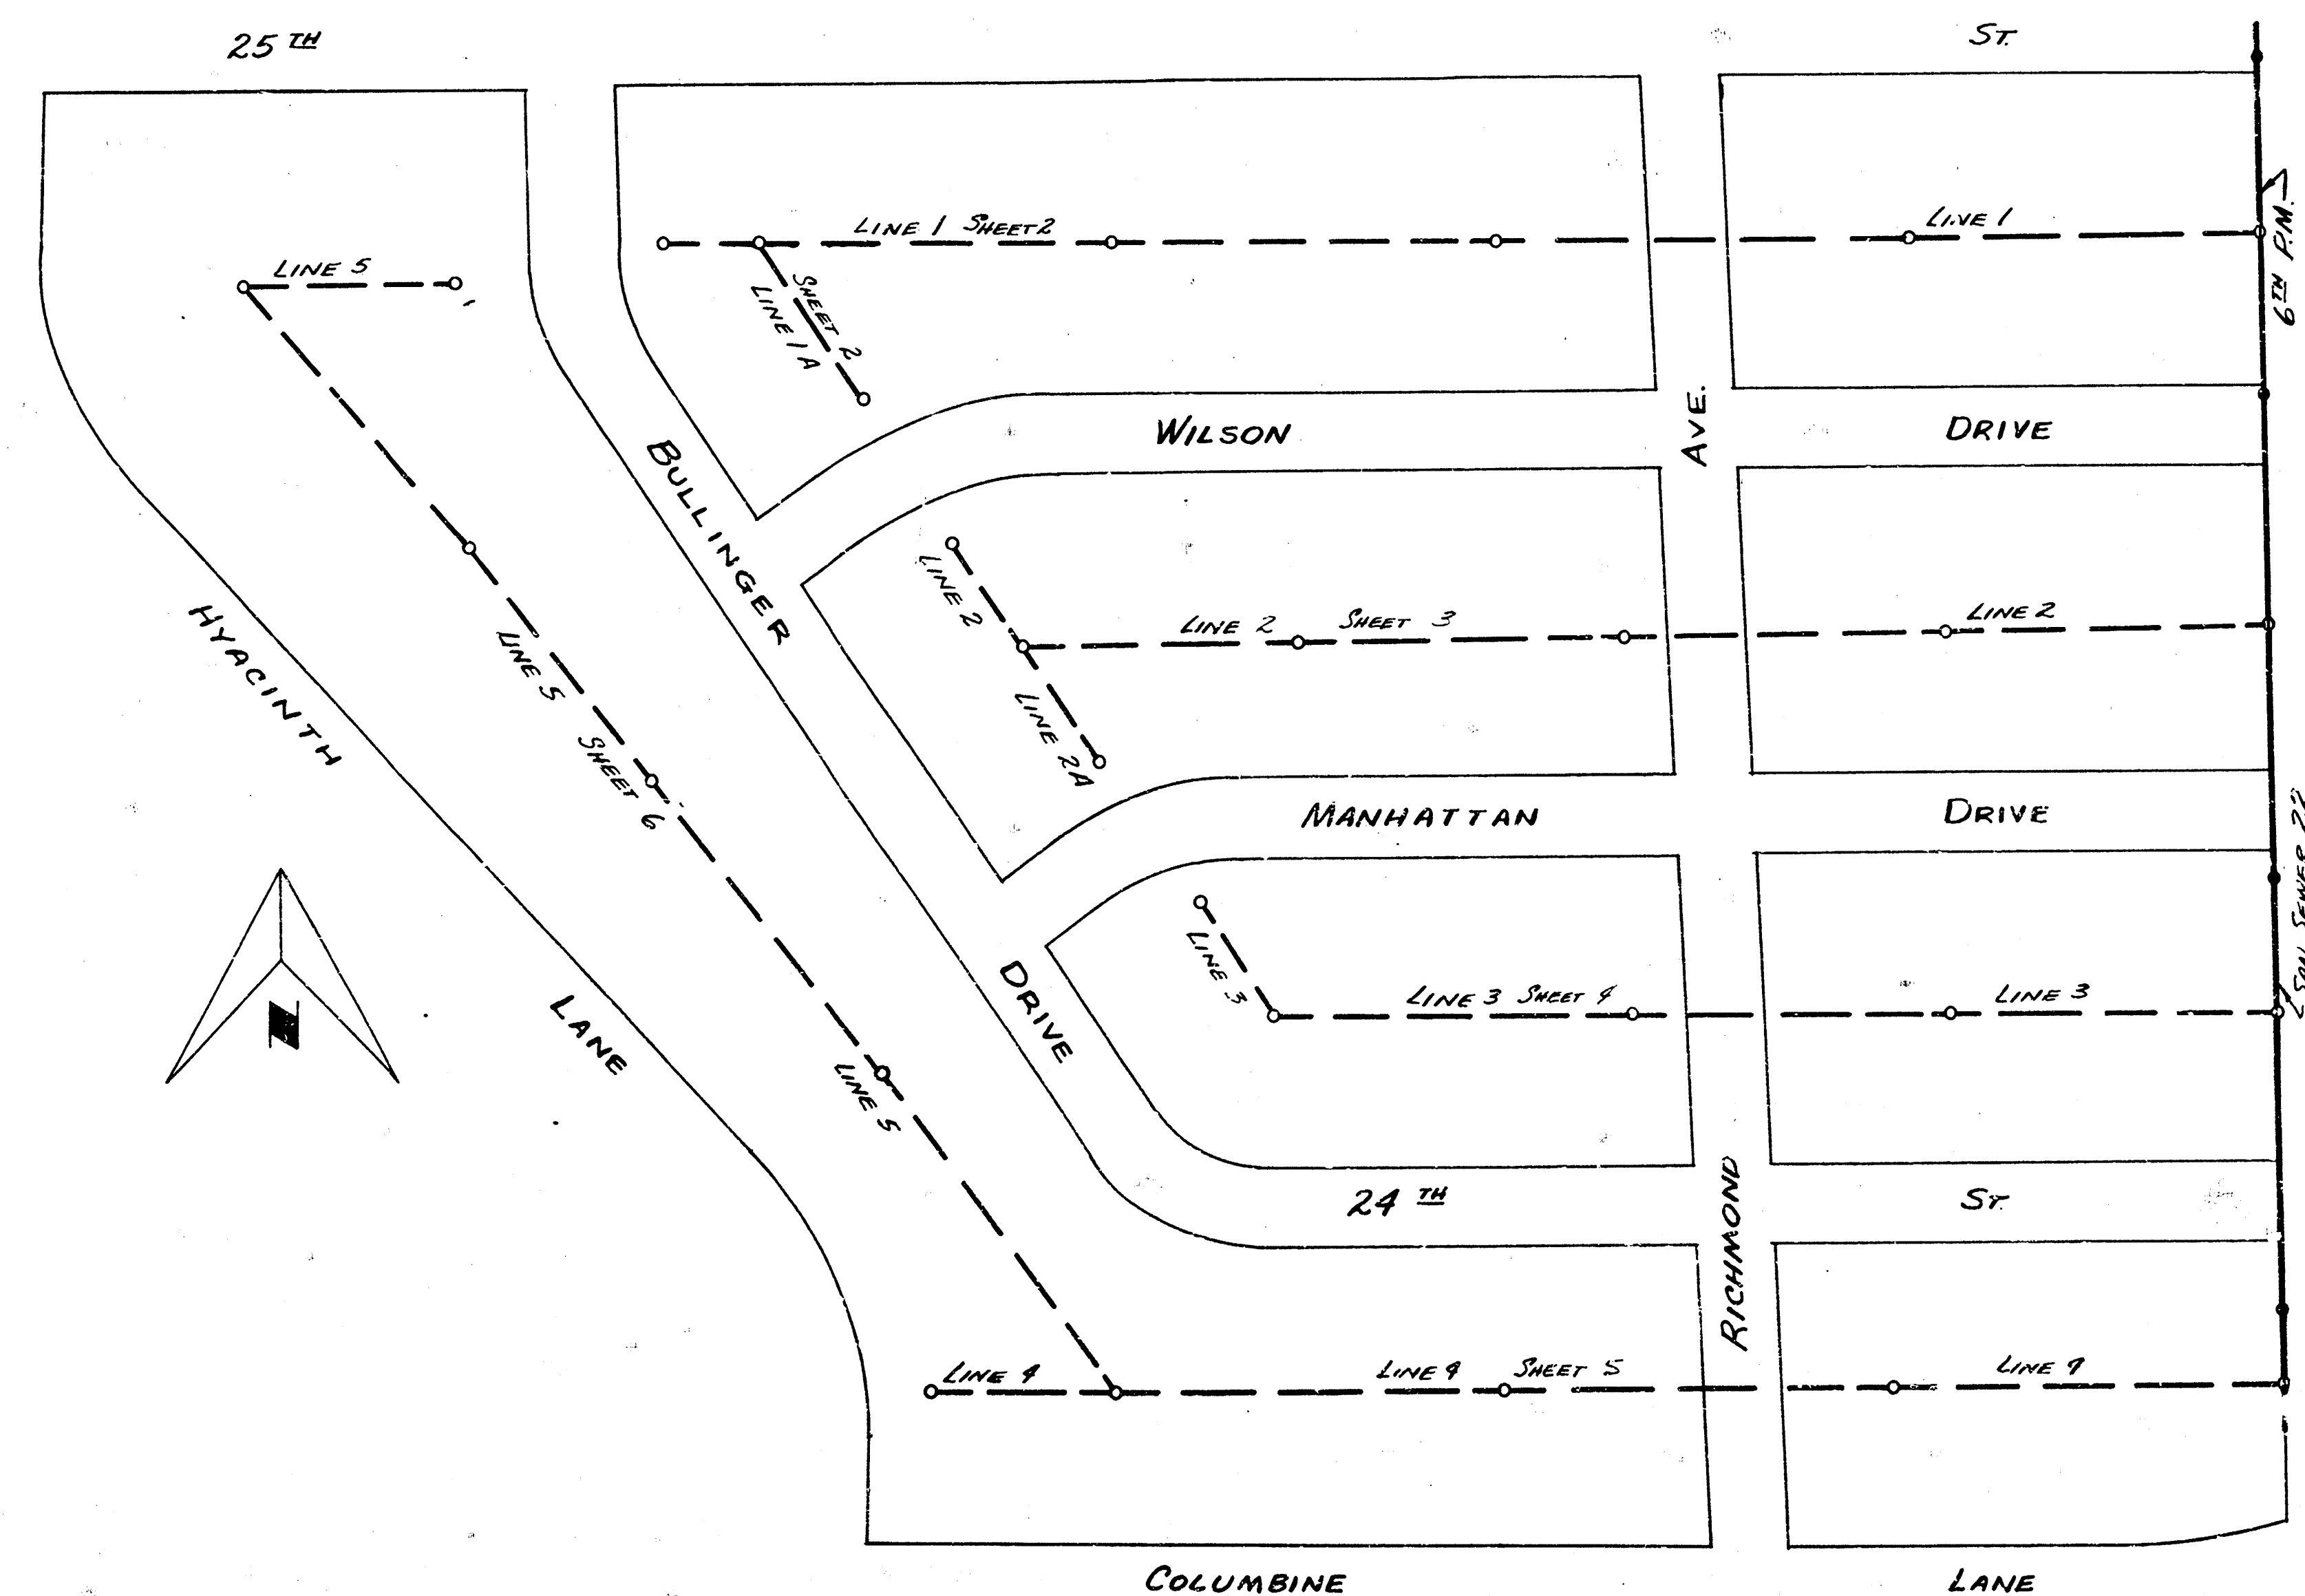

B.E. Smith
 City Engineer
 4/25/54

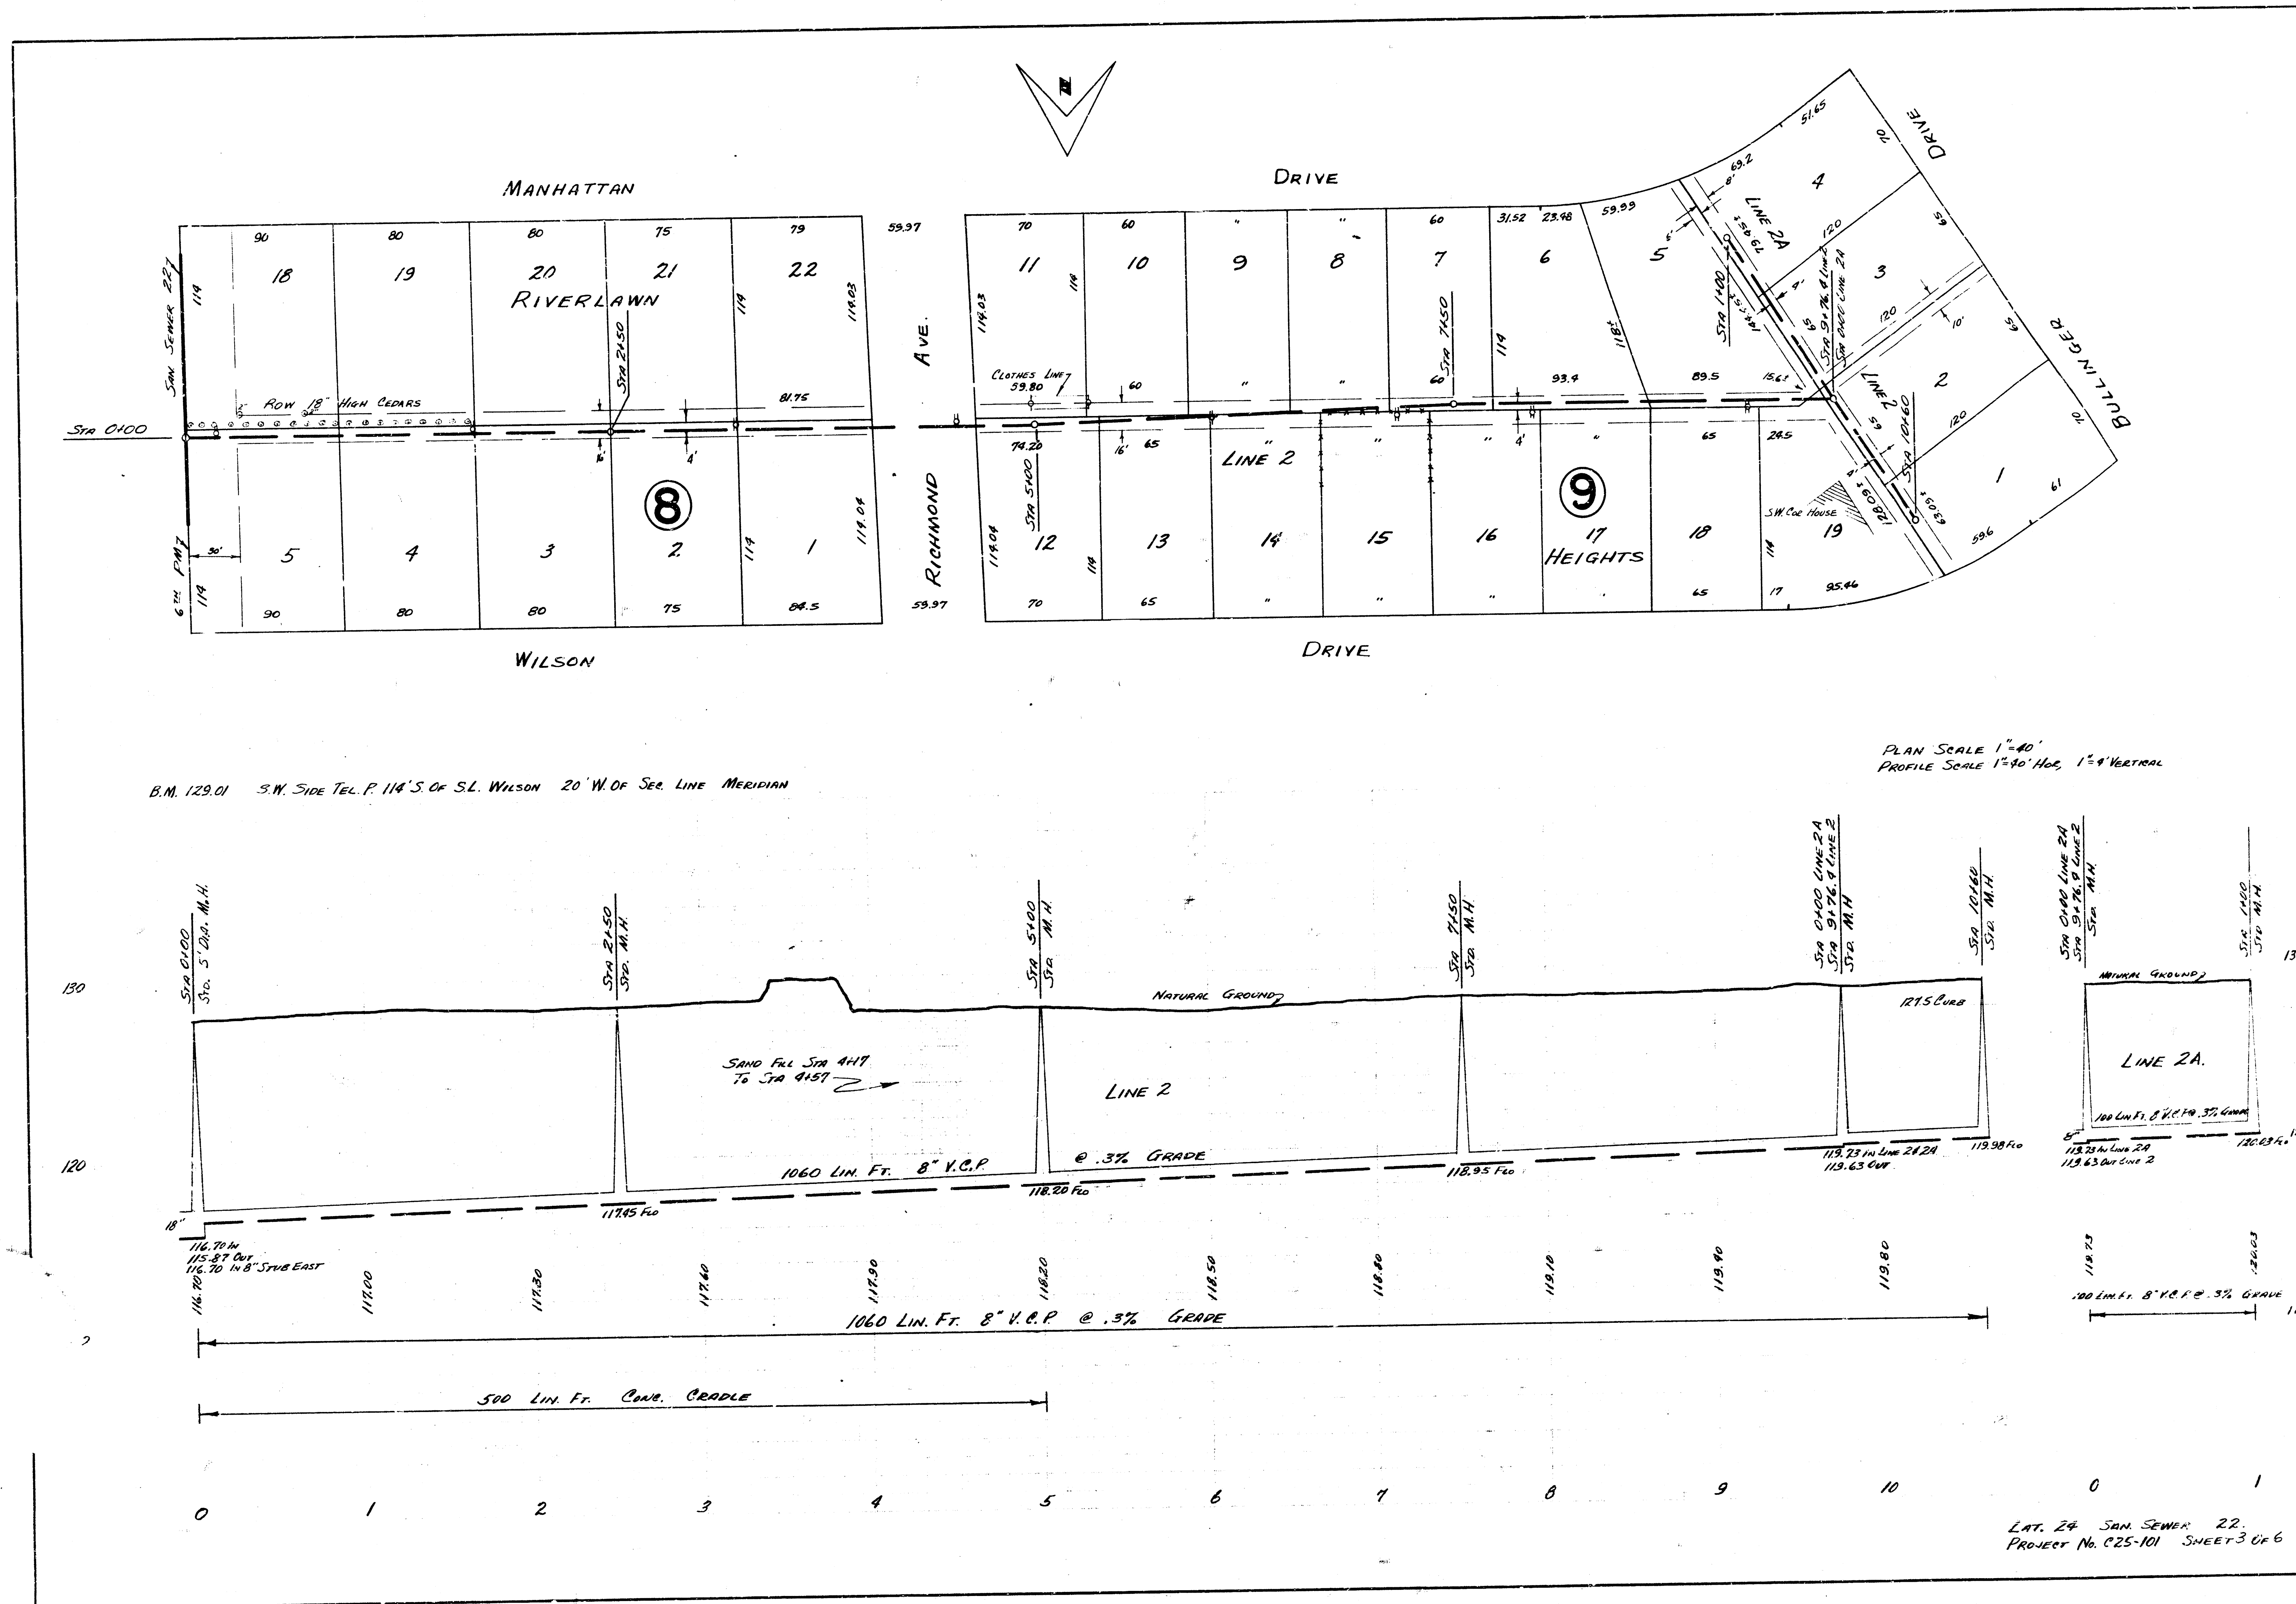

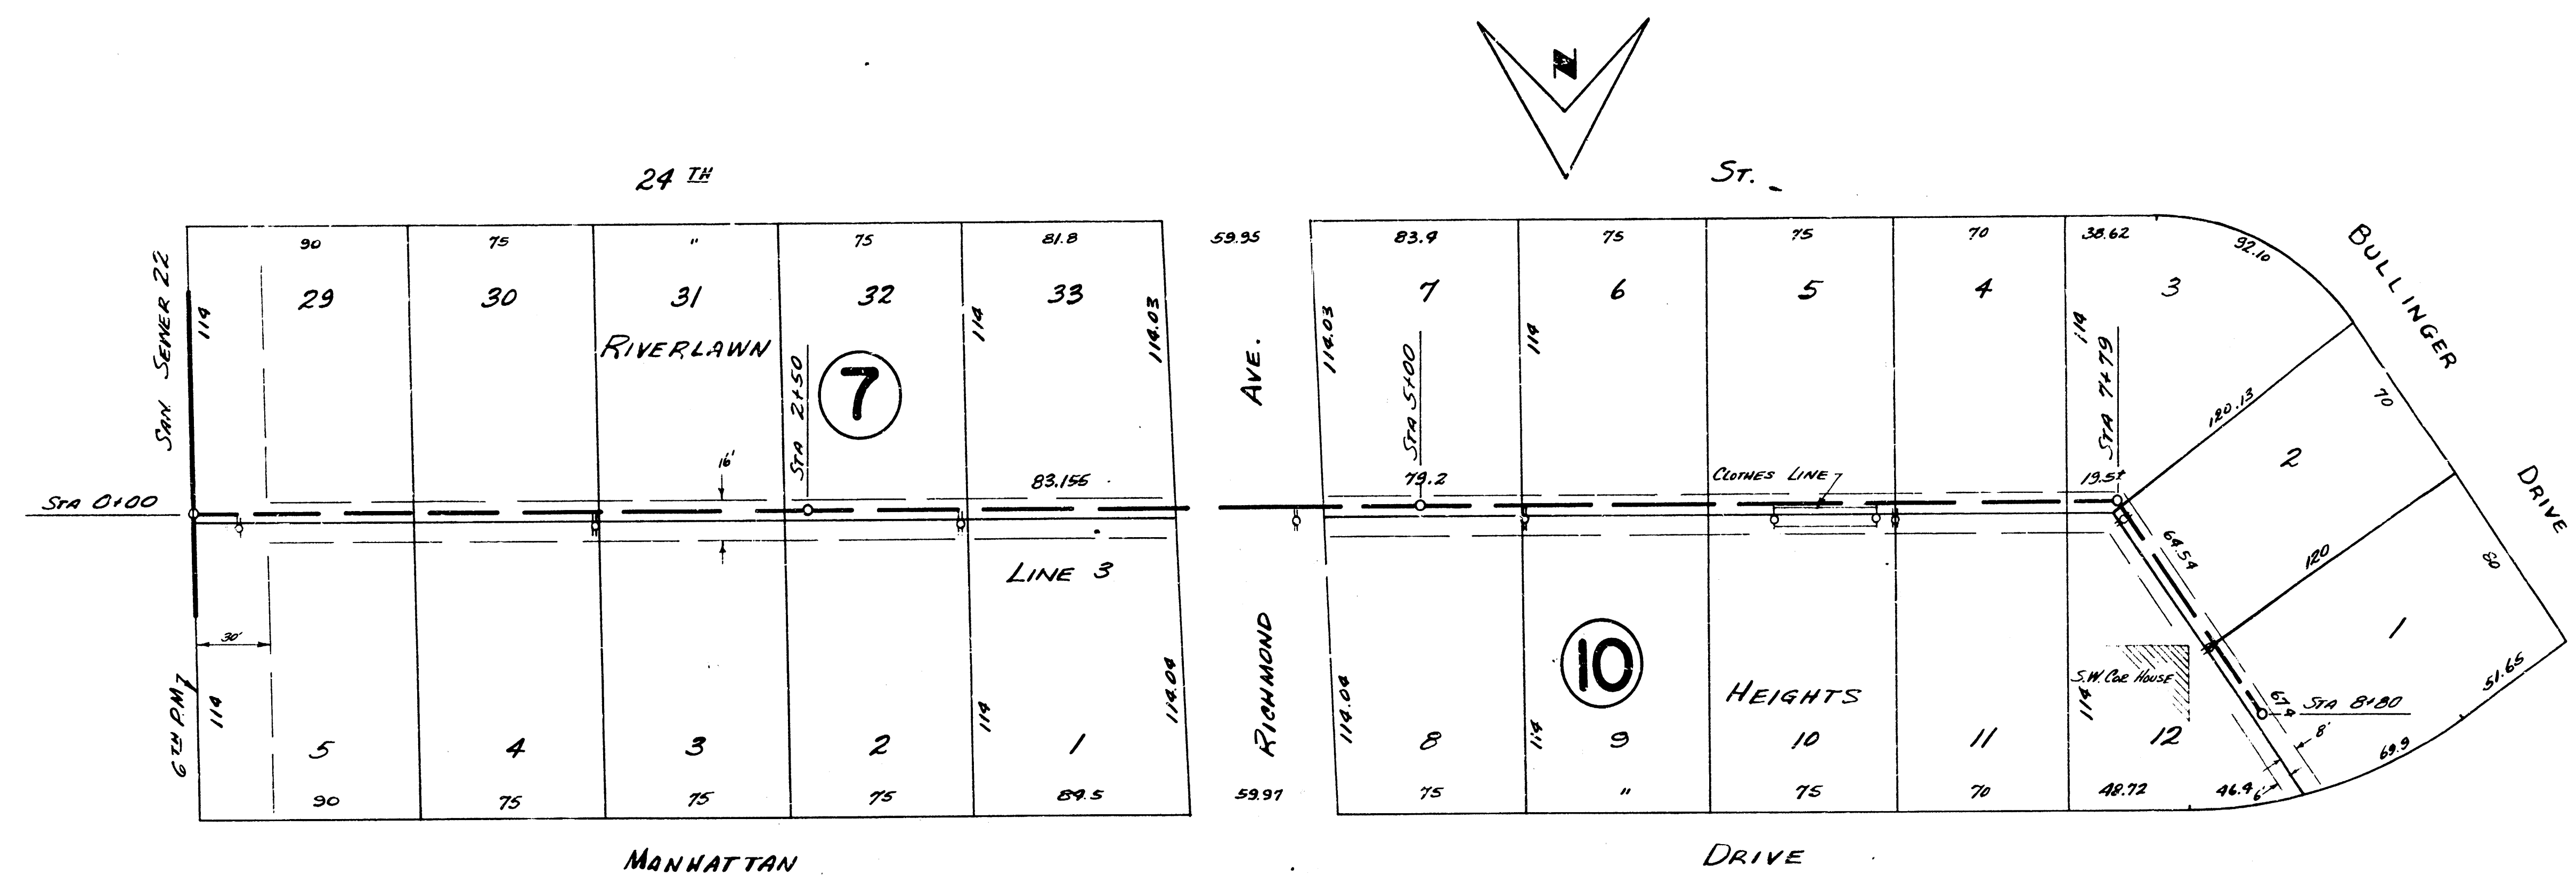

B.M. 129.62 N.W. SIDE TEL. P. 14' N. & N.L. 24TH, 20' W. OF SEC. LINE MERIDIAN

PLAN SCALE 1"=40'
PROFILE SCALE 1"=40' HOR, 1"=4' VERTICAL

