



NOTE: Sheds are to be moved off of permanent easement sheds are to be reset on foundations equal to original foundation.

NOTE: Dashed lines indicate proposed SWITH'S PARKWILDE ADDITION.

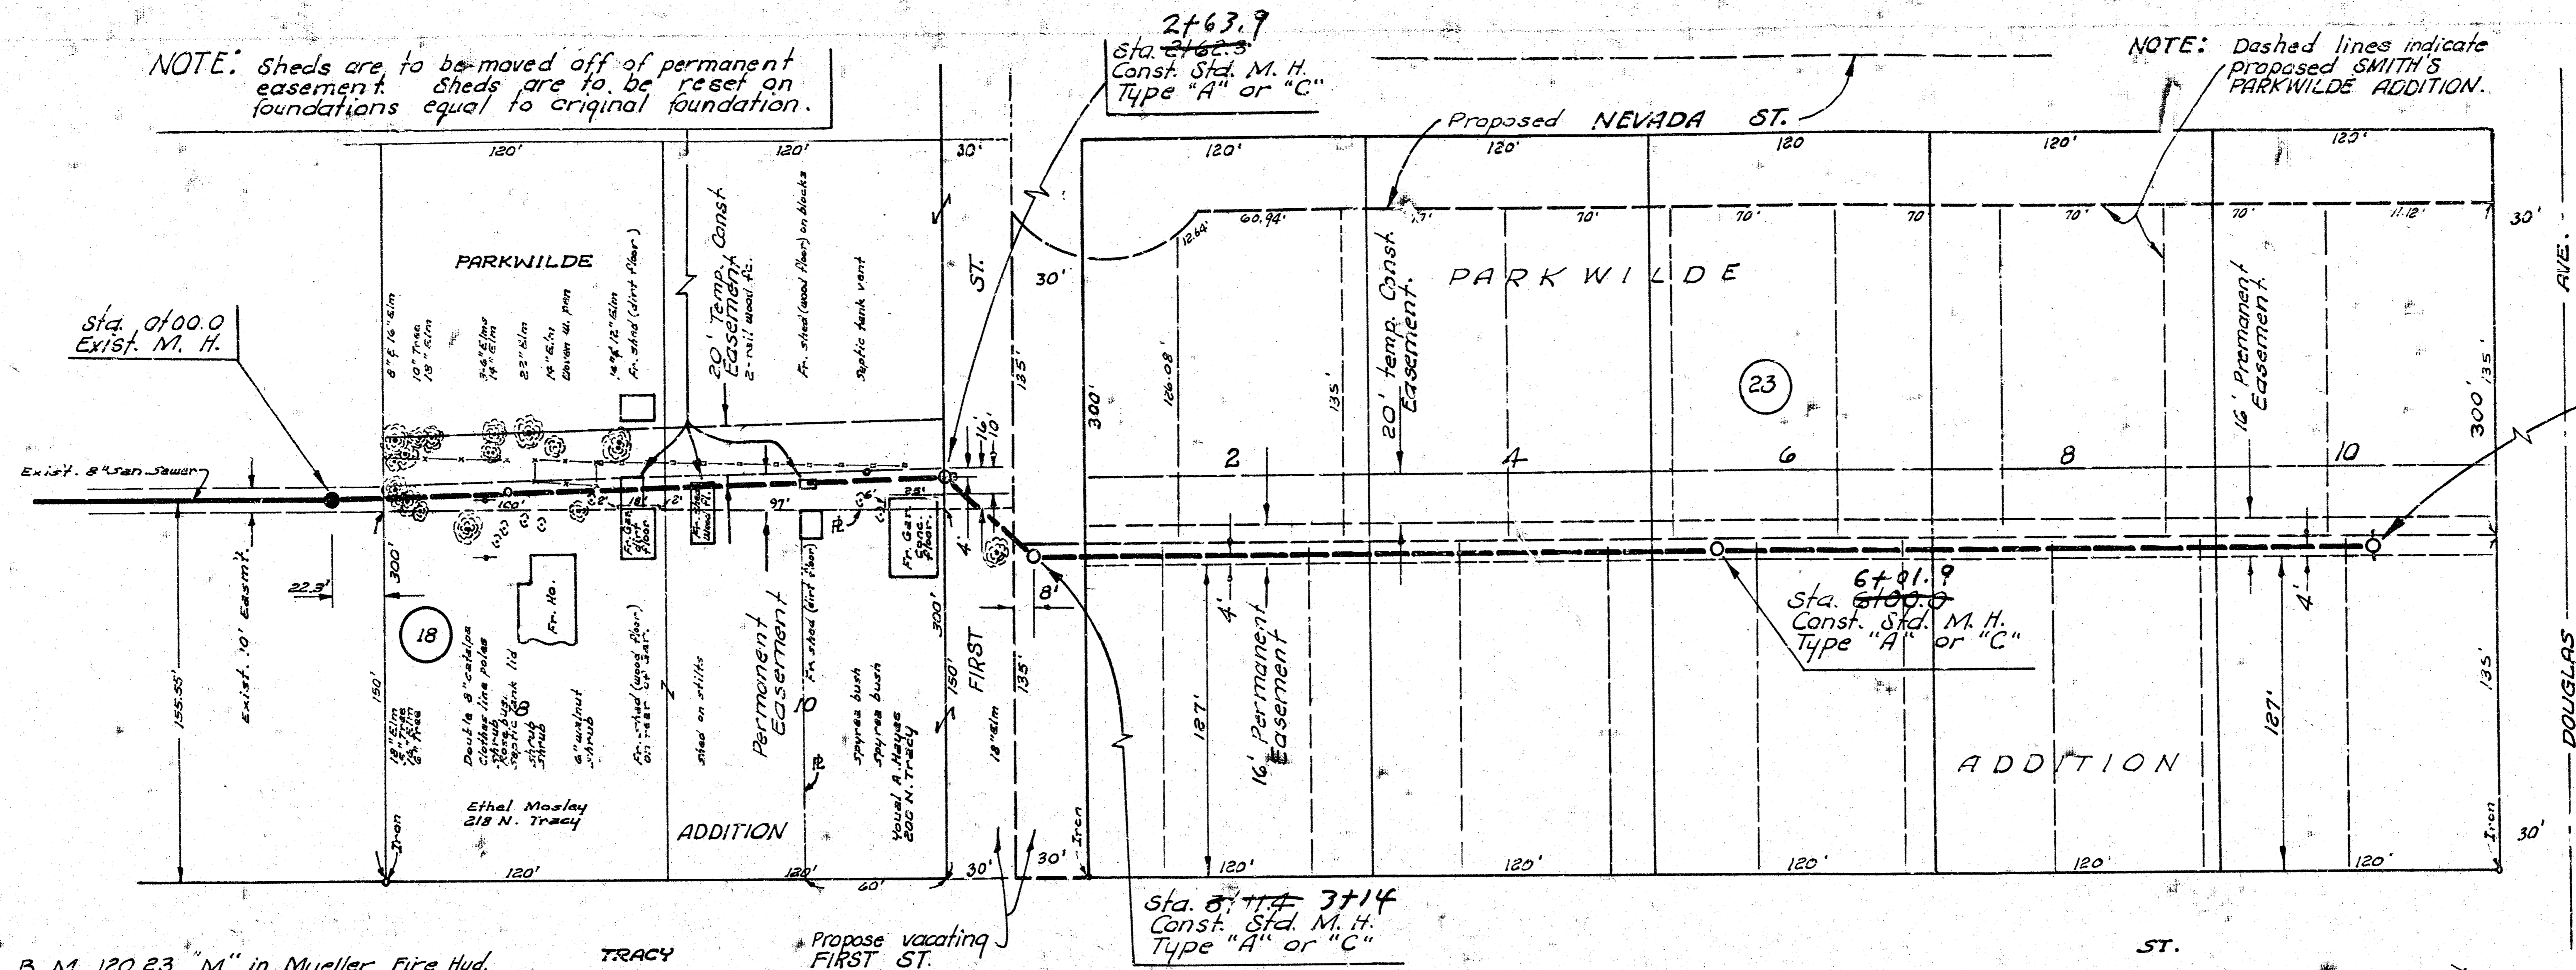

B. M. 120.23 "M" in Mueller Fire Hyd. S. E. Cor. Tracy & Douglas.

Plan Scale 1"=40'  
Profile Scale 1"=40' Hor.  
1"=5' Vert.

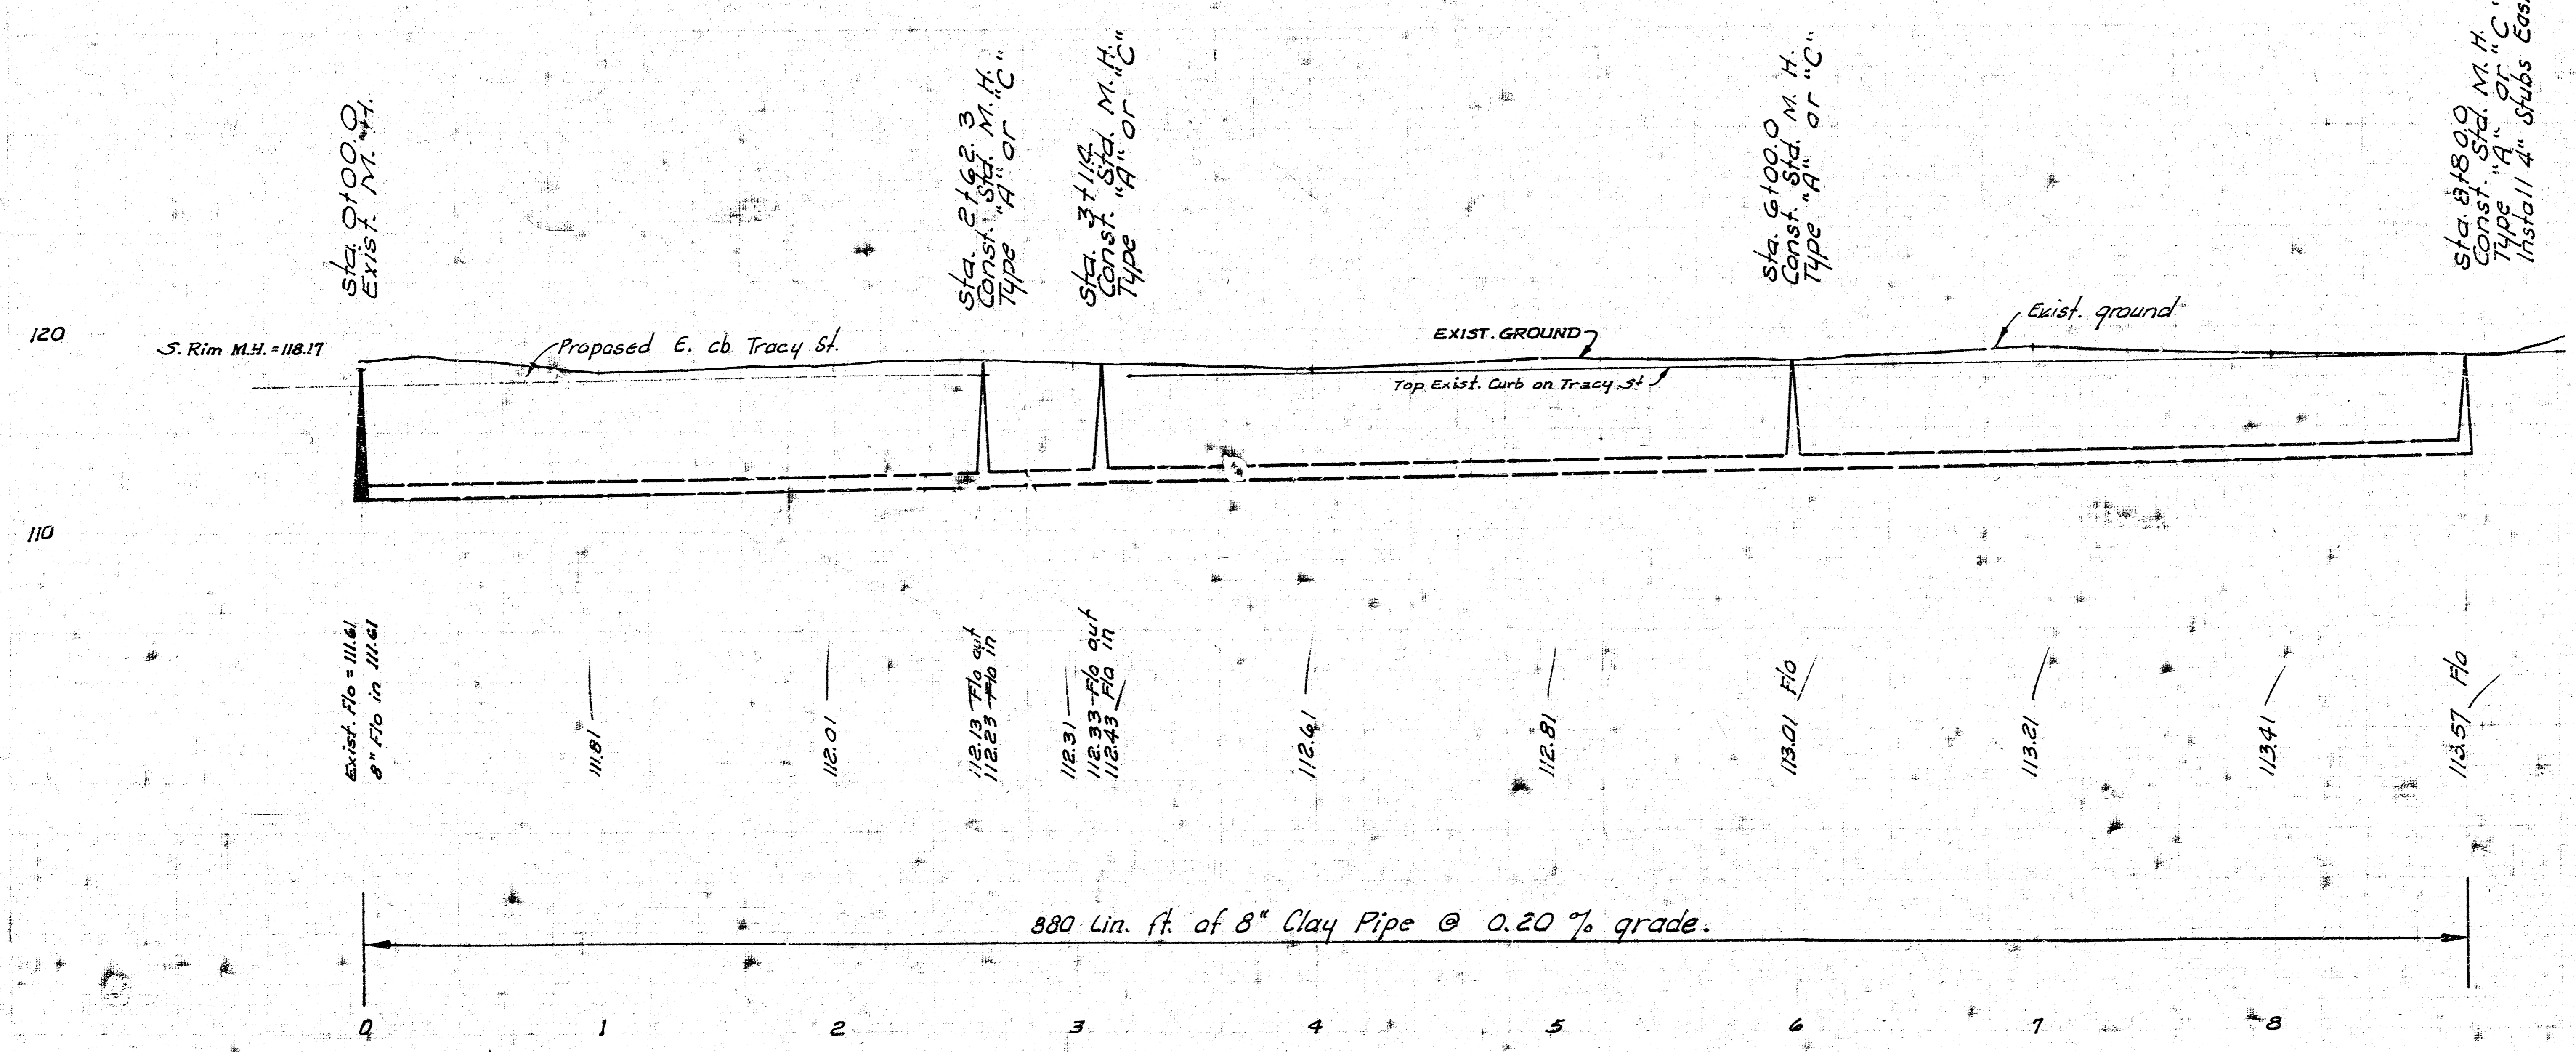

As Built 7-4-75

LAT. 208, MAIN 5, S.S. #22  
CITY OF WICHITA, KANSAS  
R. W. LAMM, CITY ENGINEER  
PROJ. NO. DBRL570062  
DATE: \_\_\_\_\_