

I-235


SERVICE ROAD





SCALE
VERTICAL - 1" = 5'
HORIZONTAL - 1" = 40'



BM*1 - 121.82 - RR SPIKE ON E-SIDE OF RR.
N.W. COR. HOOVER & 3RD ST.
BM*2 - 121.00 - RR SPIKE N-FACE PP. E.L.
GILDR, N.L. 3RD ST.
BM*3 - 123.36 - SW COR. CONC. PORCH
500 S. GILDR

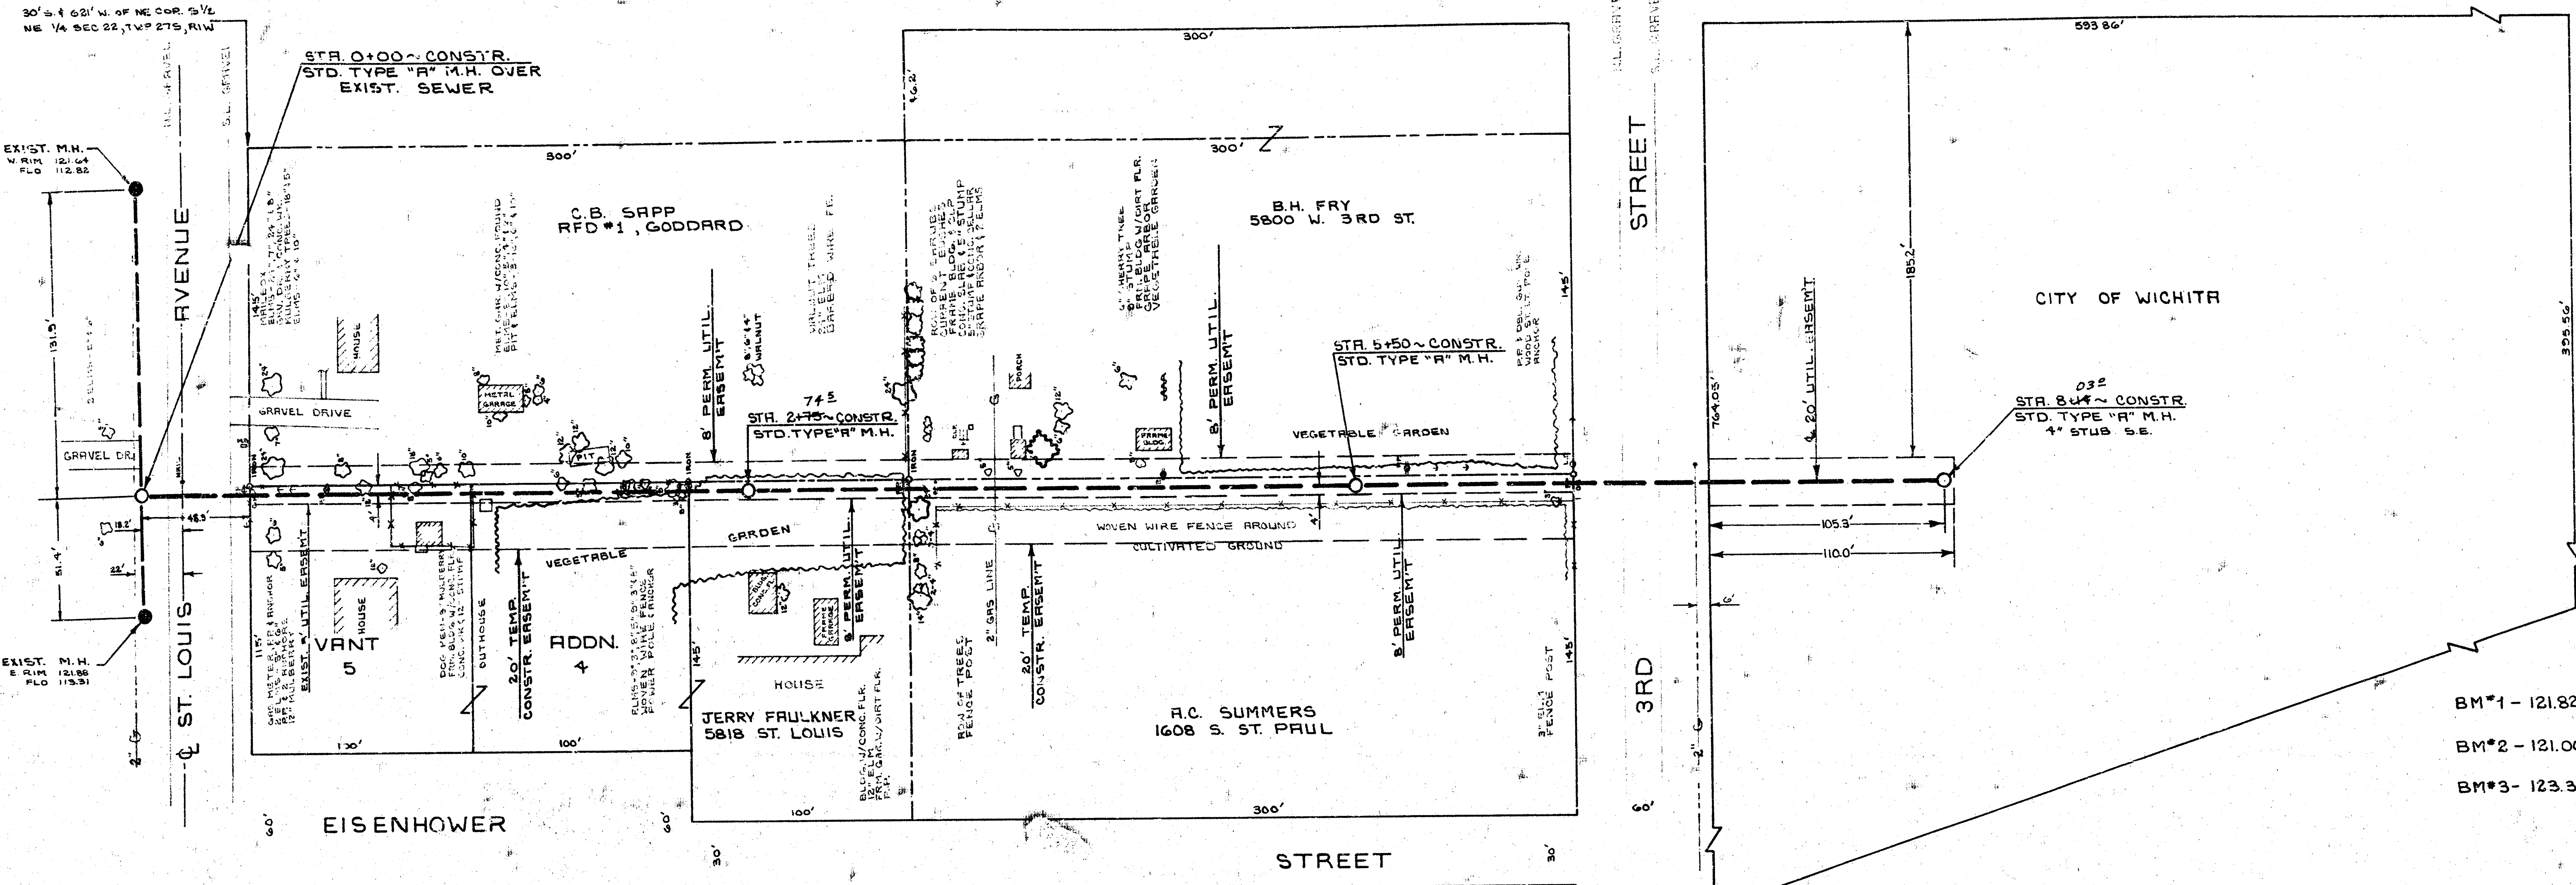

NOTE TO CONTRACTOR:
CONTACT MRS. MARTIN, TEL. 943-1585
OR RD. FAULKNER, TEL. 522-3516 AT
LEAST 3 DAYS BEFORE CONSTRUCTION
BEGINS SO THAT GERMAN SHEPHERD
DOGS MAY BE REMOVED FROM
DOG PEN ON LOT 5.

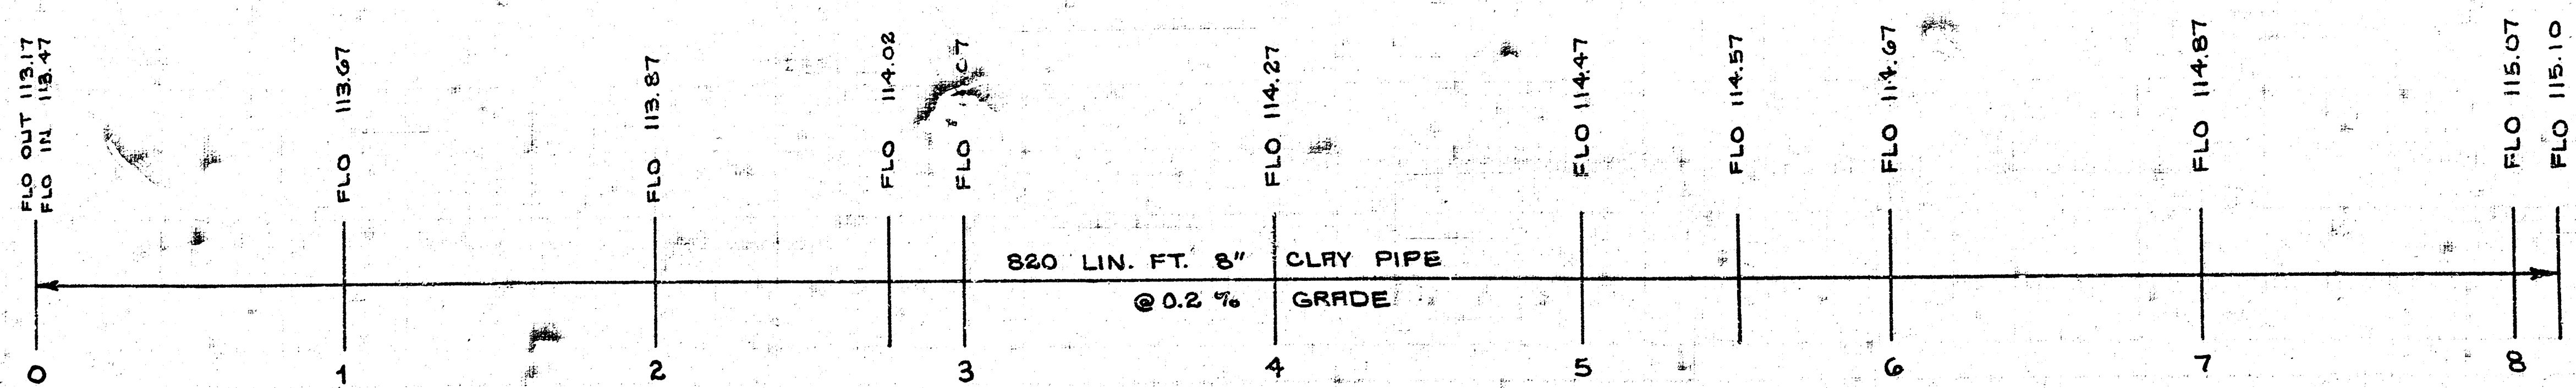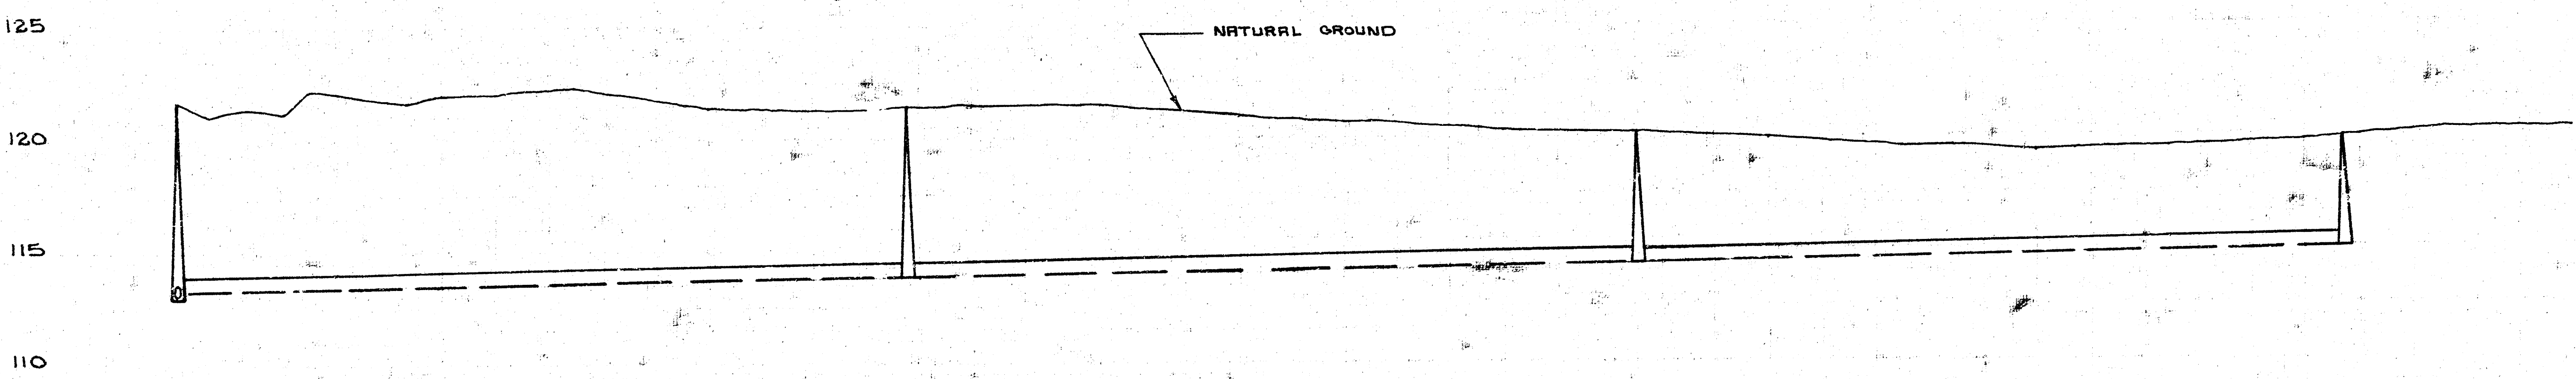

As Built Final Meas. K-105
LAT. 211 SUB. 5 S.S. *22
CITY OF WICHITA
R.W. LINN CITY ENGINEER
DATE NOV. 1972 PROJECT NO. DBKL572024

FILMED FROM THE BEST