



NOTE: REMOVAL OF EXIST. STUB N. SHALL NOT BE PAID FOR DIRECTLY, BUT SHALL BE INCLUDED IN THE COST OF THE PROJECT.

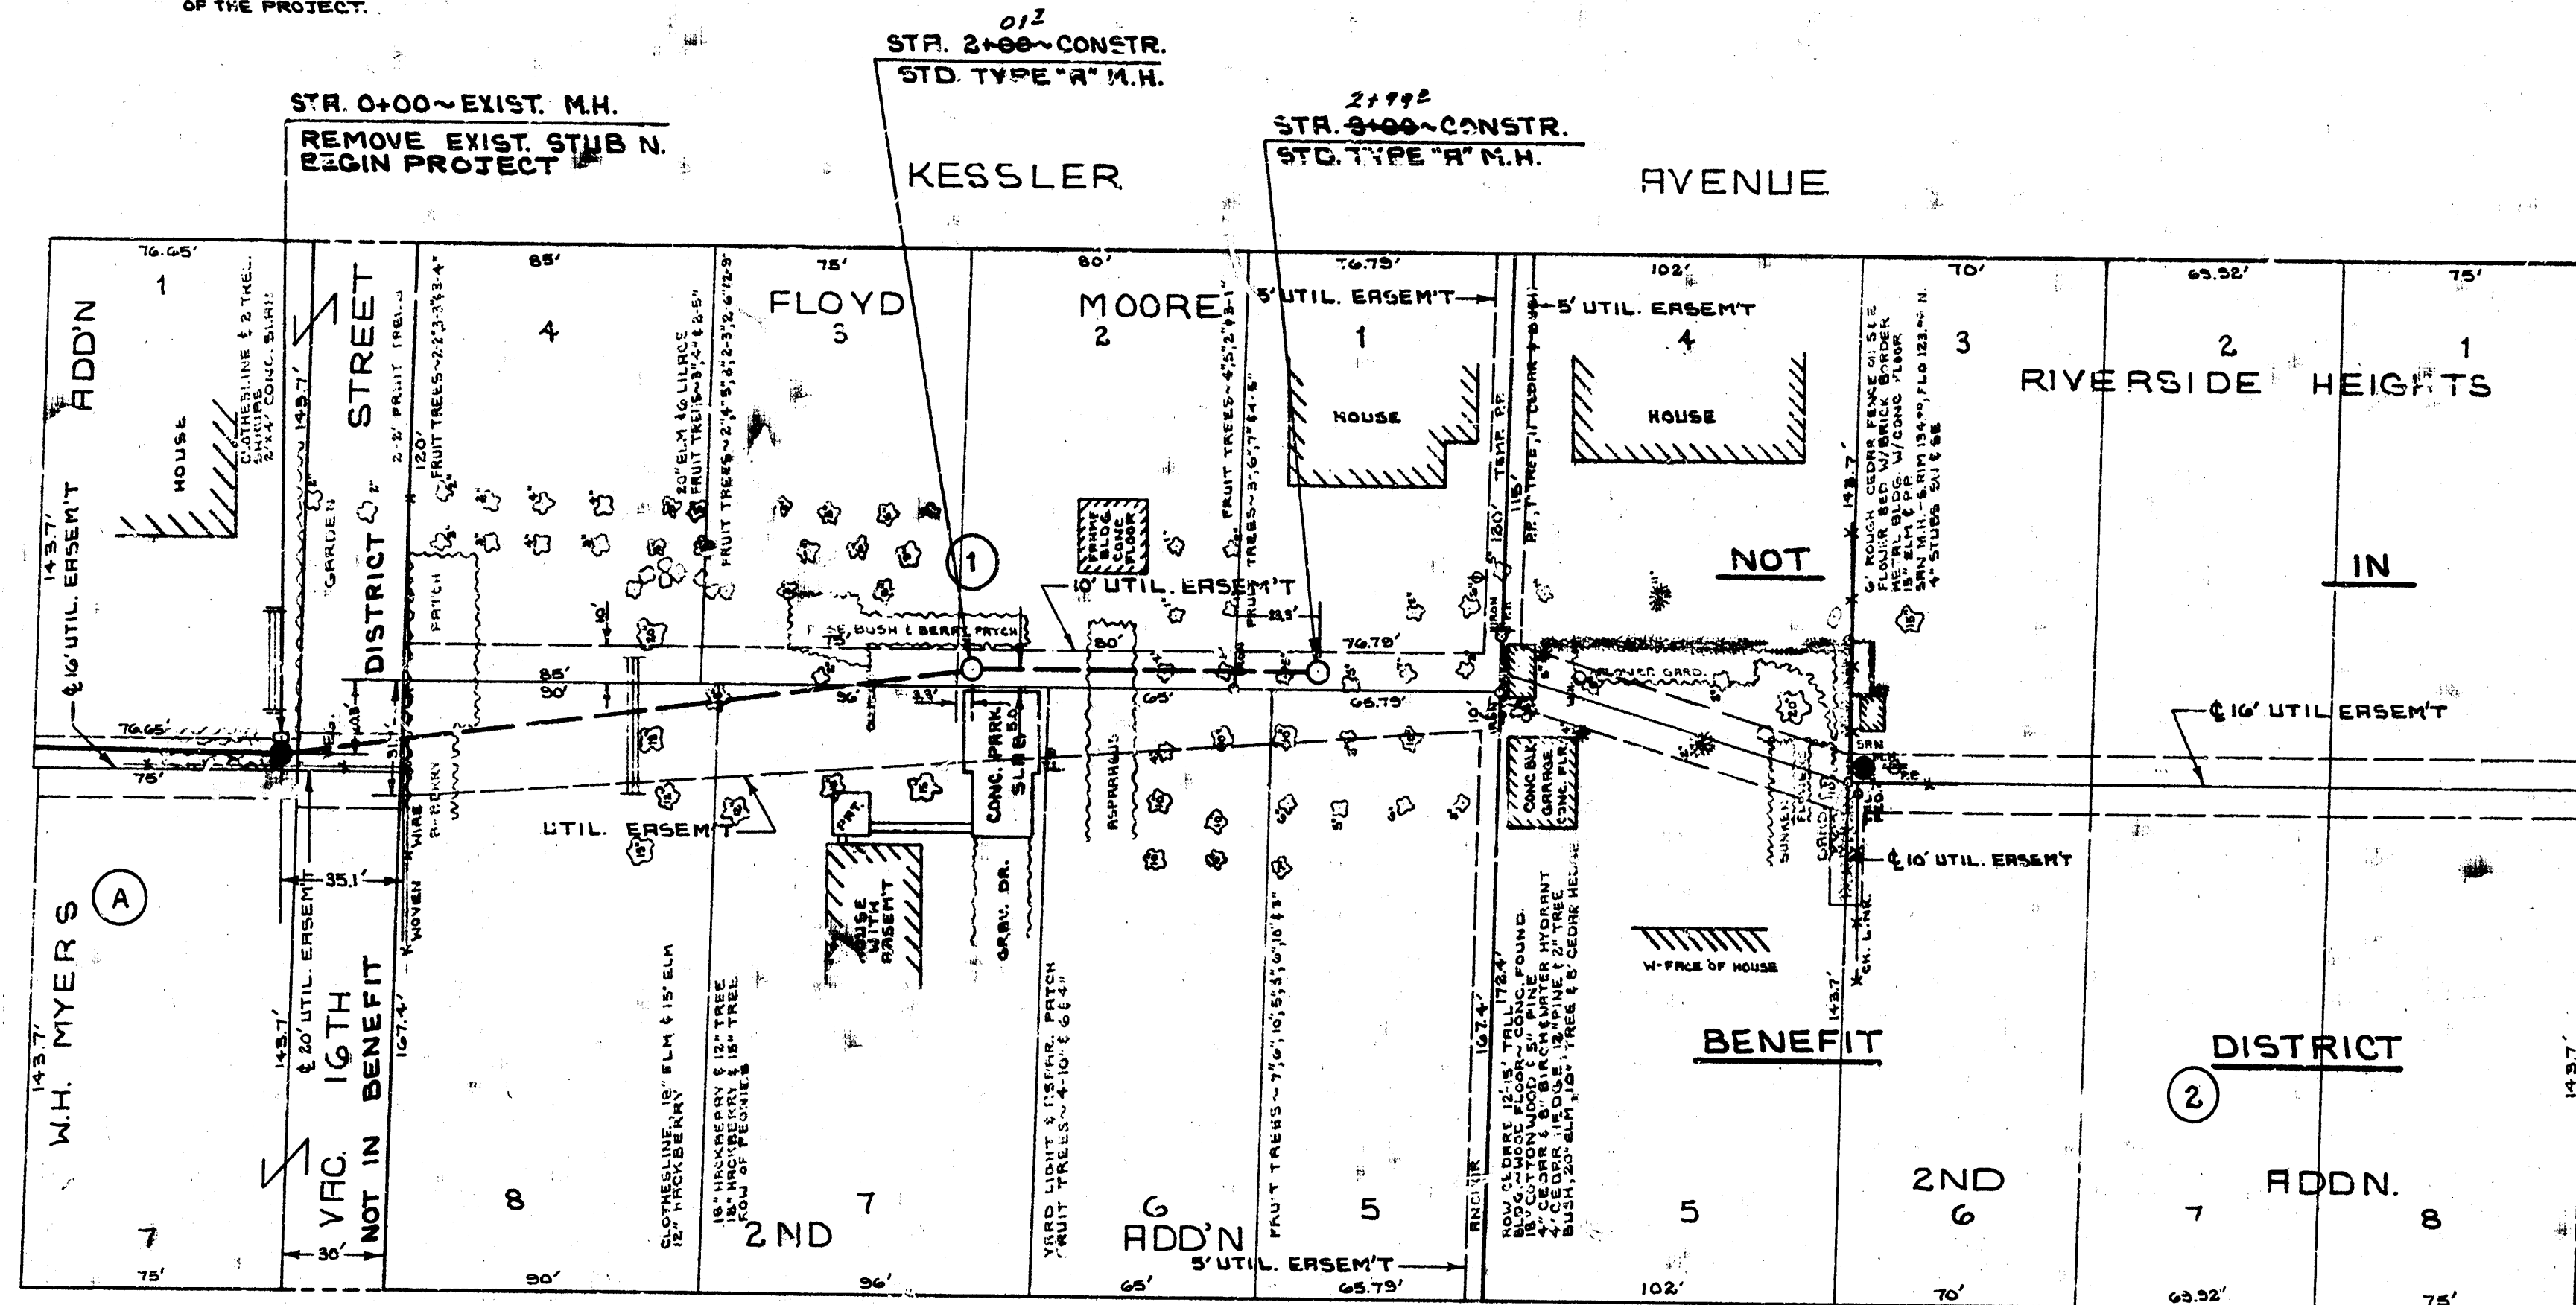

BM #1~129.423~NE COR. CONC. PORCH HOUSE
#1649 N. KESSLER
BM #2~130.95~"H" IN RITCHIE TOP WEST CB. ON
KESSLER AVE. 1 FT. N. OF N.L. 17TH ST.

PLAN SCALE 1"=40'
PROFILE SCALE 1"=5' HORIZONTAL
1"=5' VERTICAL

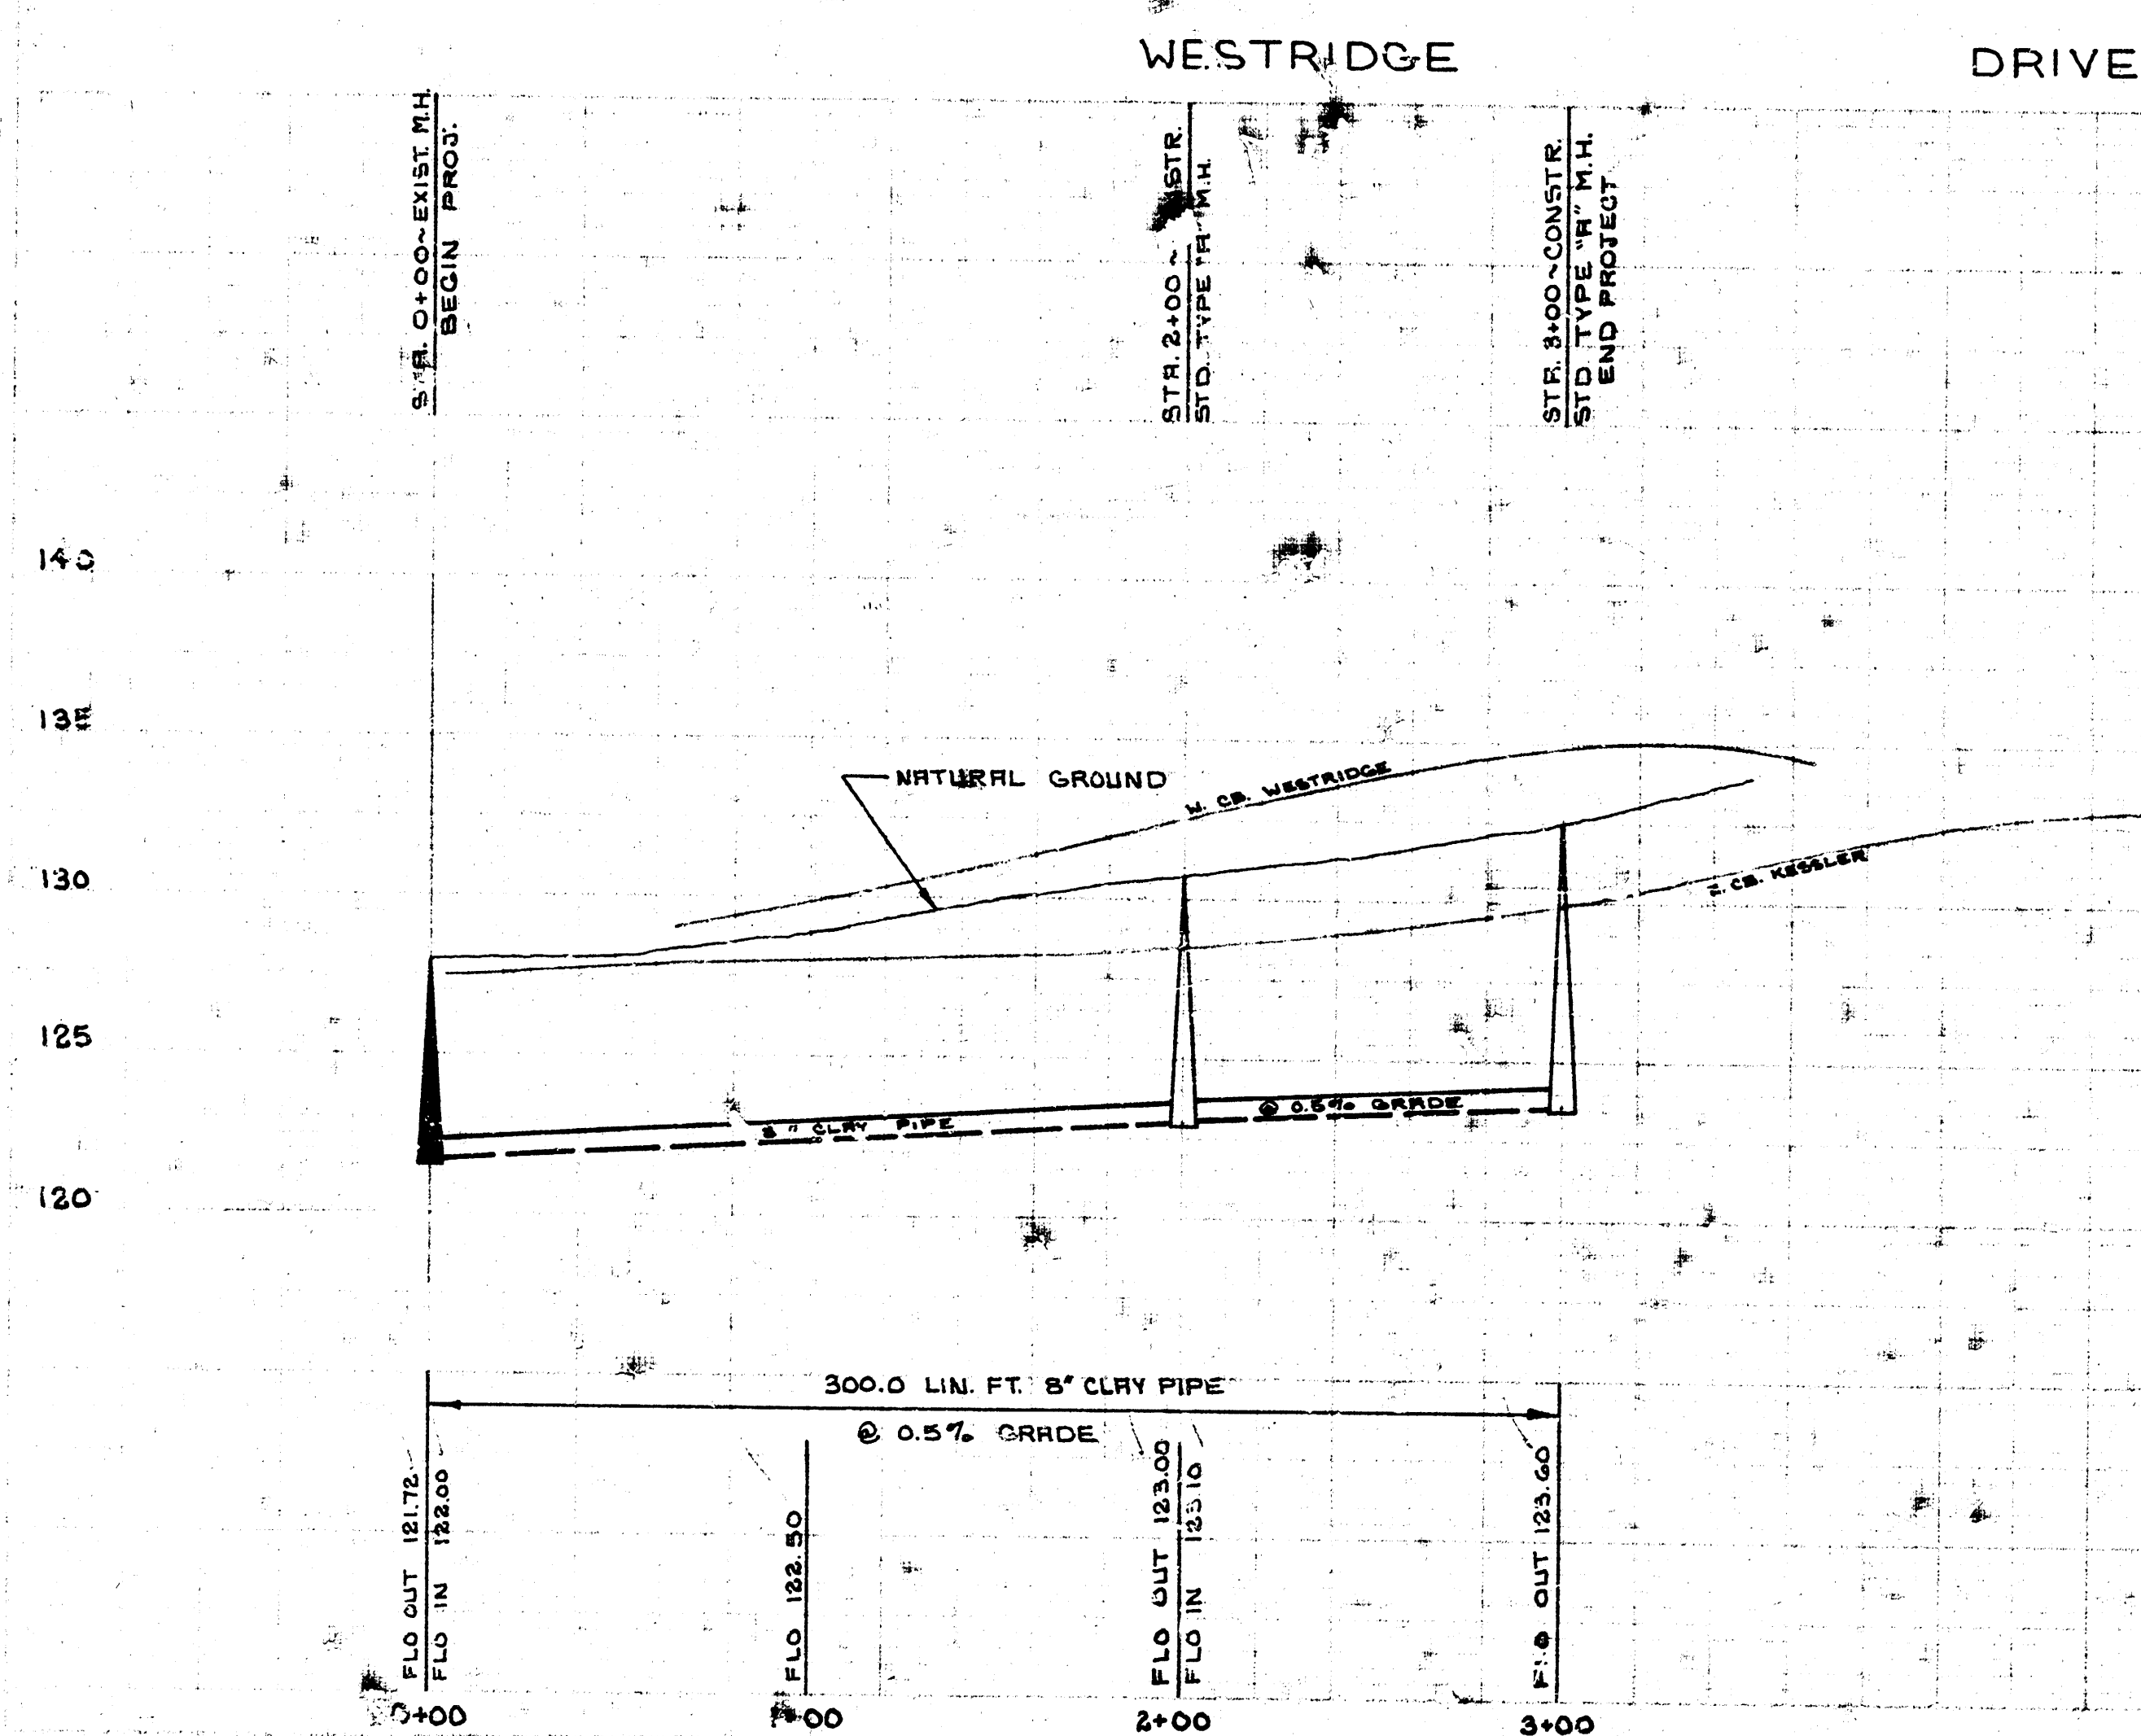

As Built Final Map 5-111

LAT. 212-MAIN 5~ S.S. 22

CITY OF WICHITA

R.W. LINN ~ CITY ENGINEER

DATE FEB. 1978 PROJ. NO. D&KL 572028



14 2 1 3