

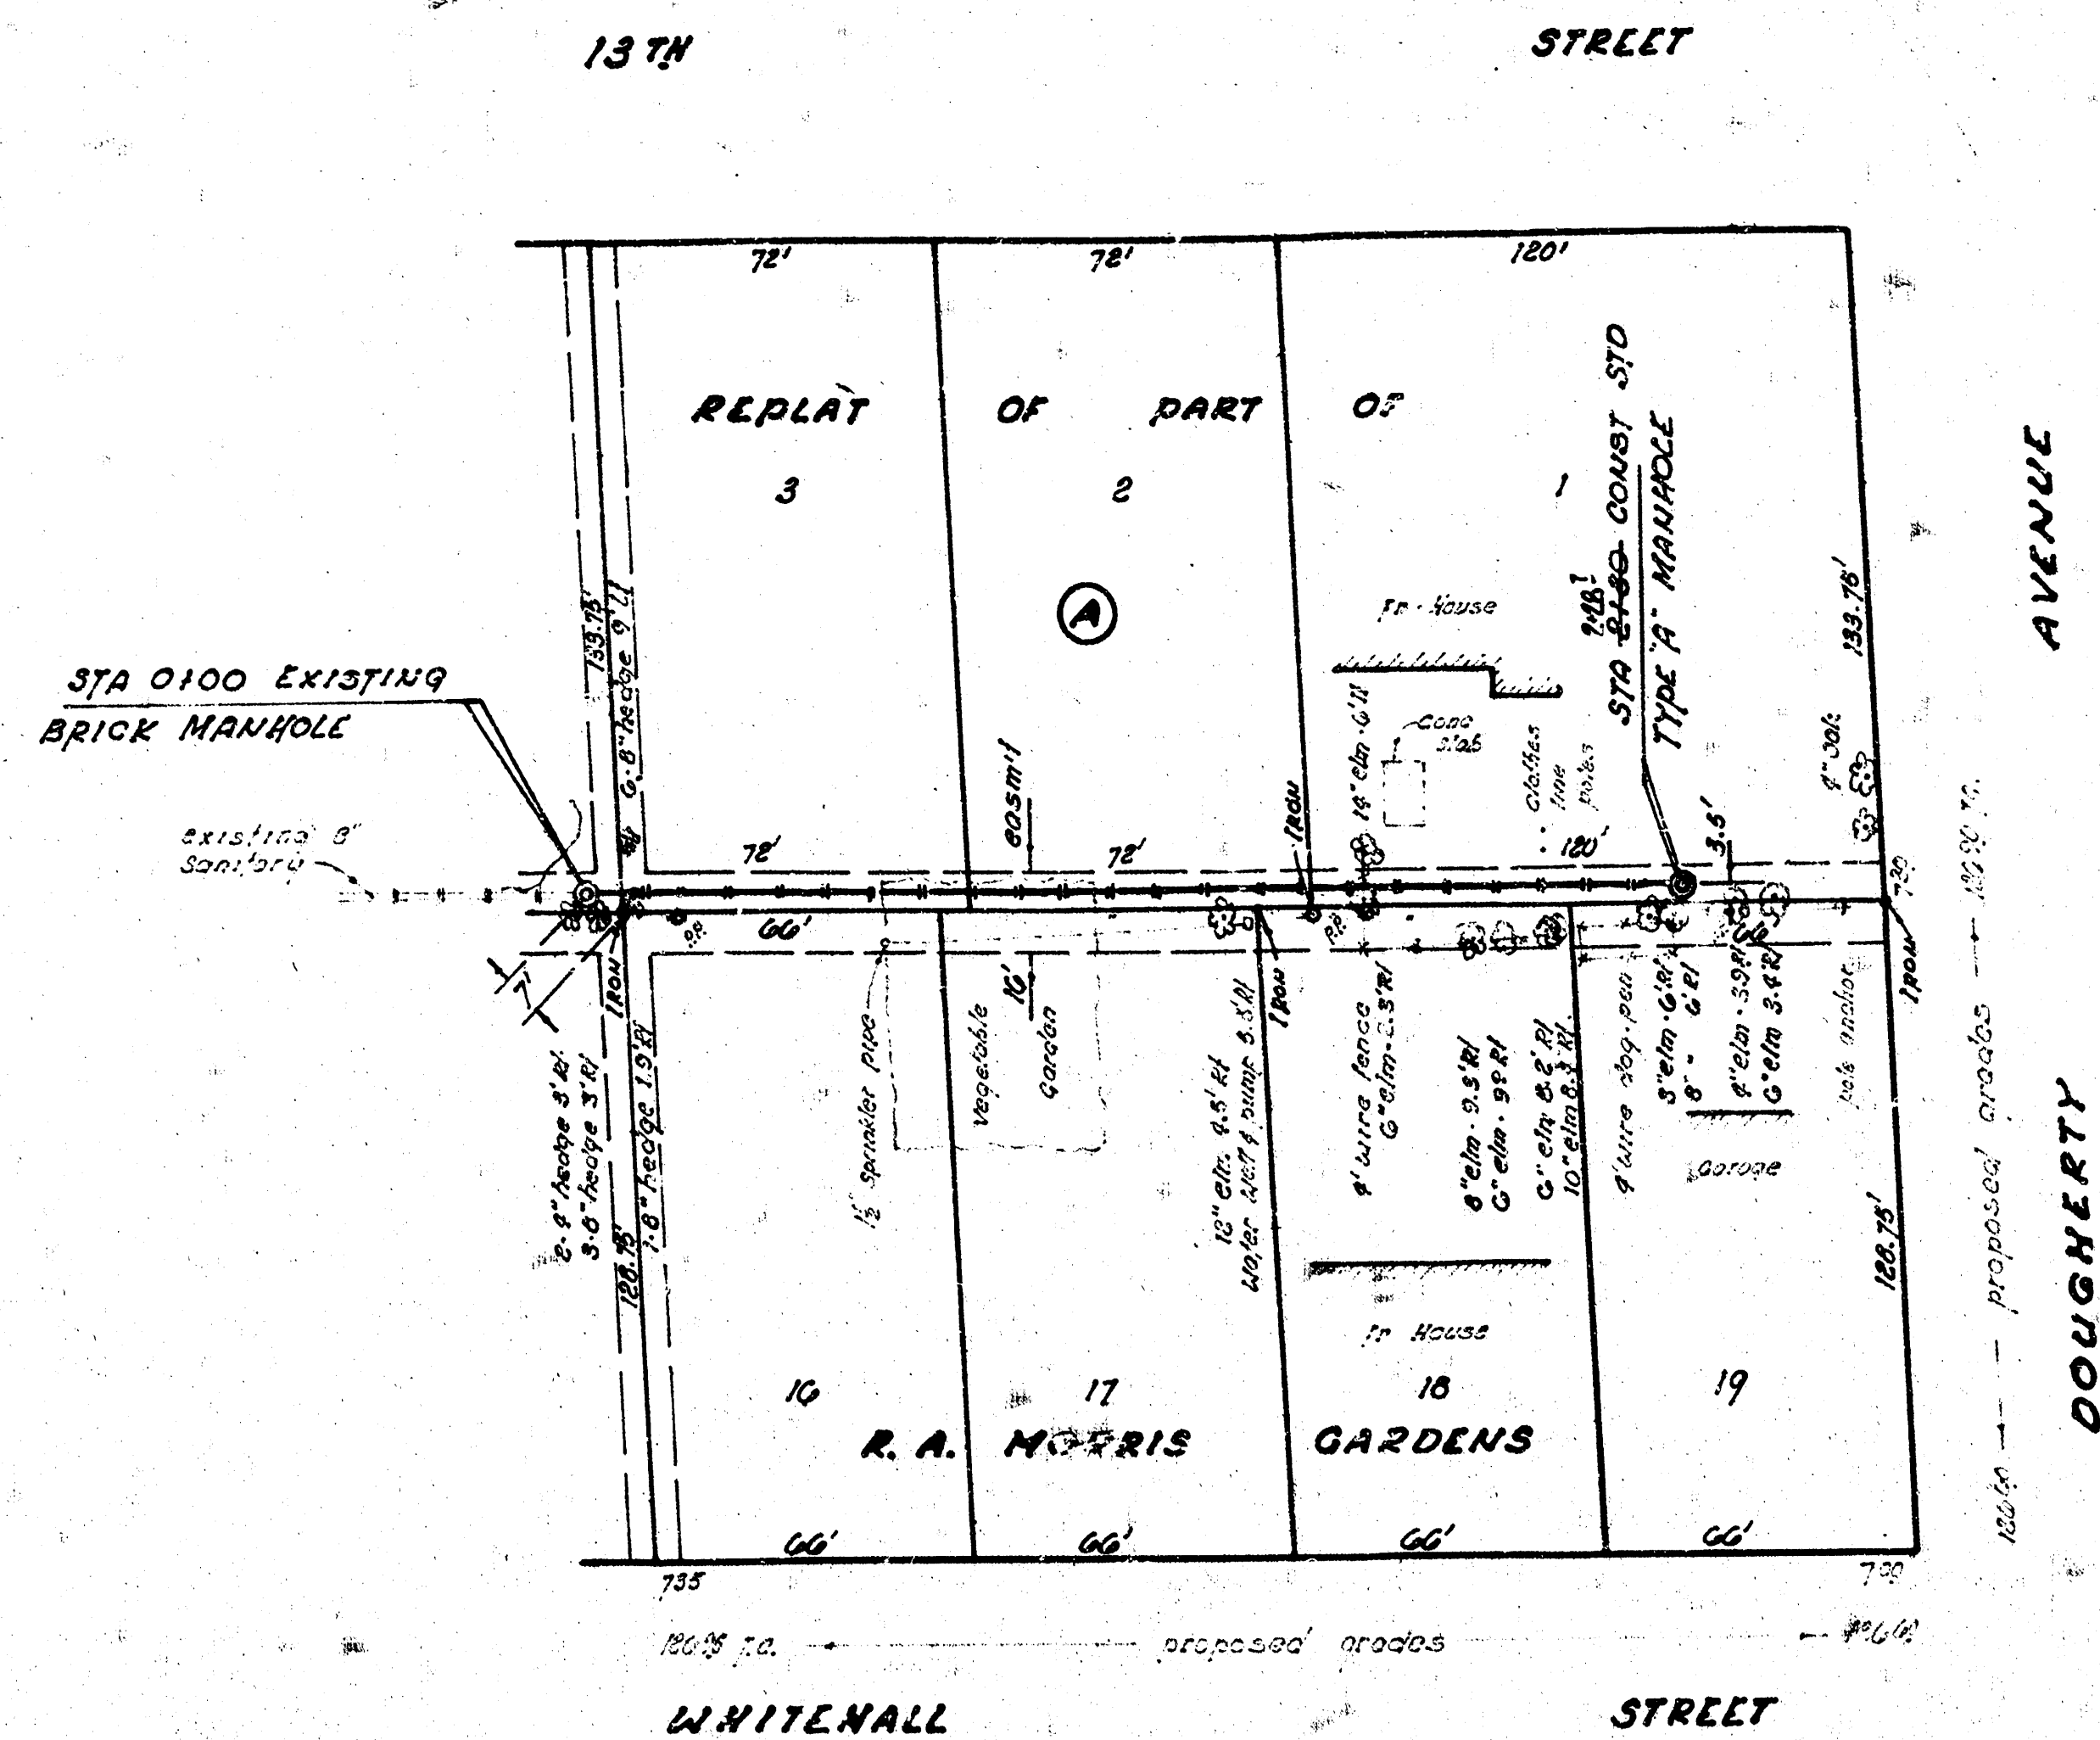


B.M. 12500 R.R. Spike on West Side P. pole on & DOUGHERTY & WHITEHALL W.
 B.M. 12900 R.R. Spike on North . . . South Side 13TH - 215' West & 13TH & BICKEL

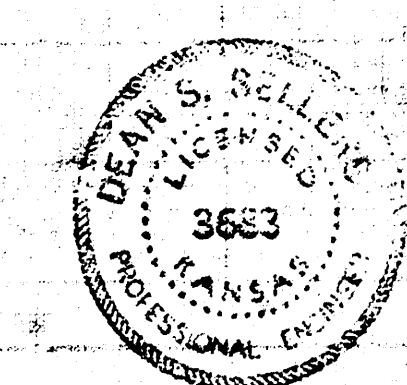

PLAN SCALE 1" = 40'
 PROFILE 1" = 40' HORIZ.
 1" = 5' VERT.

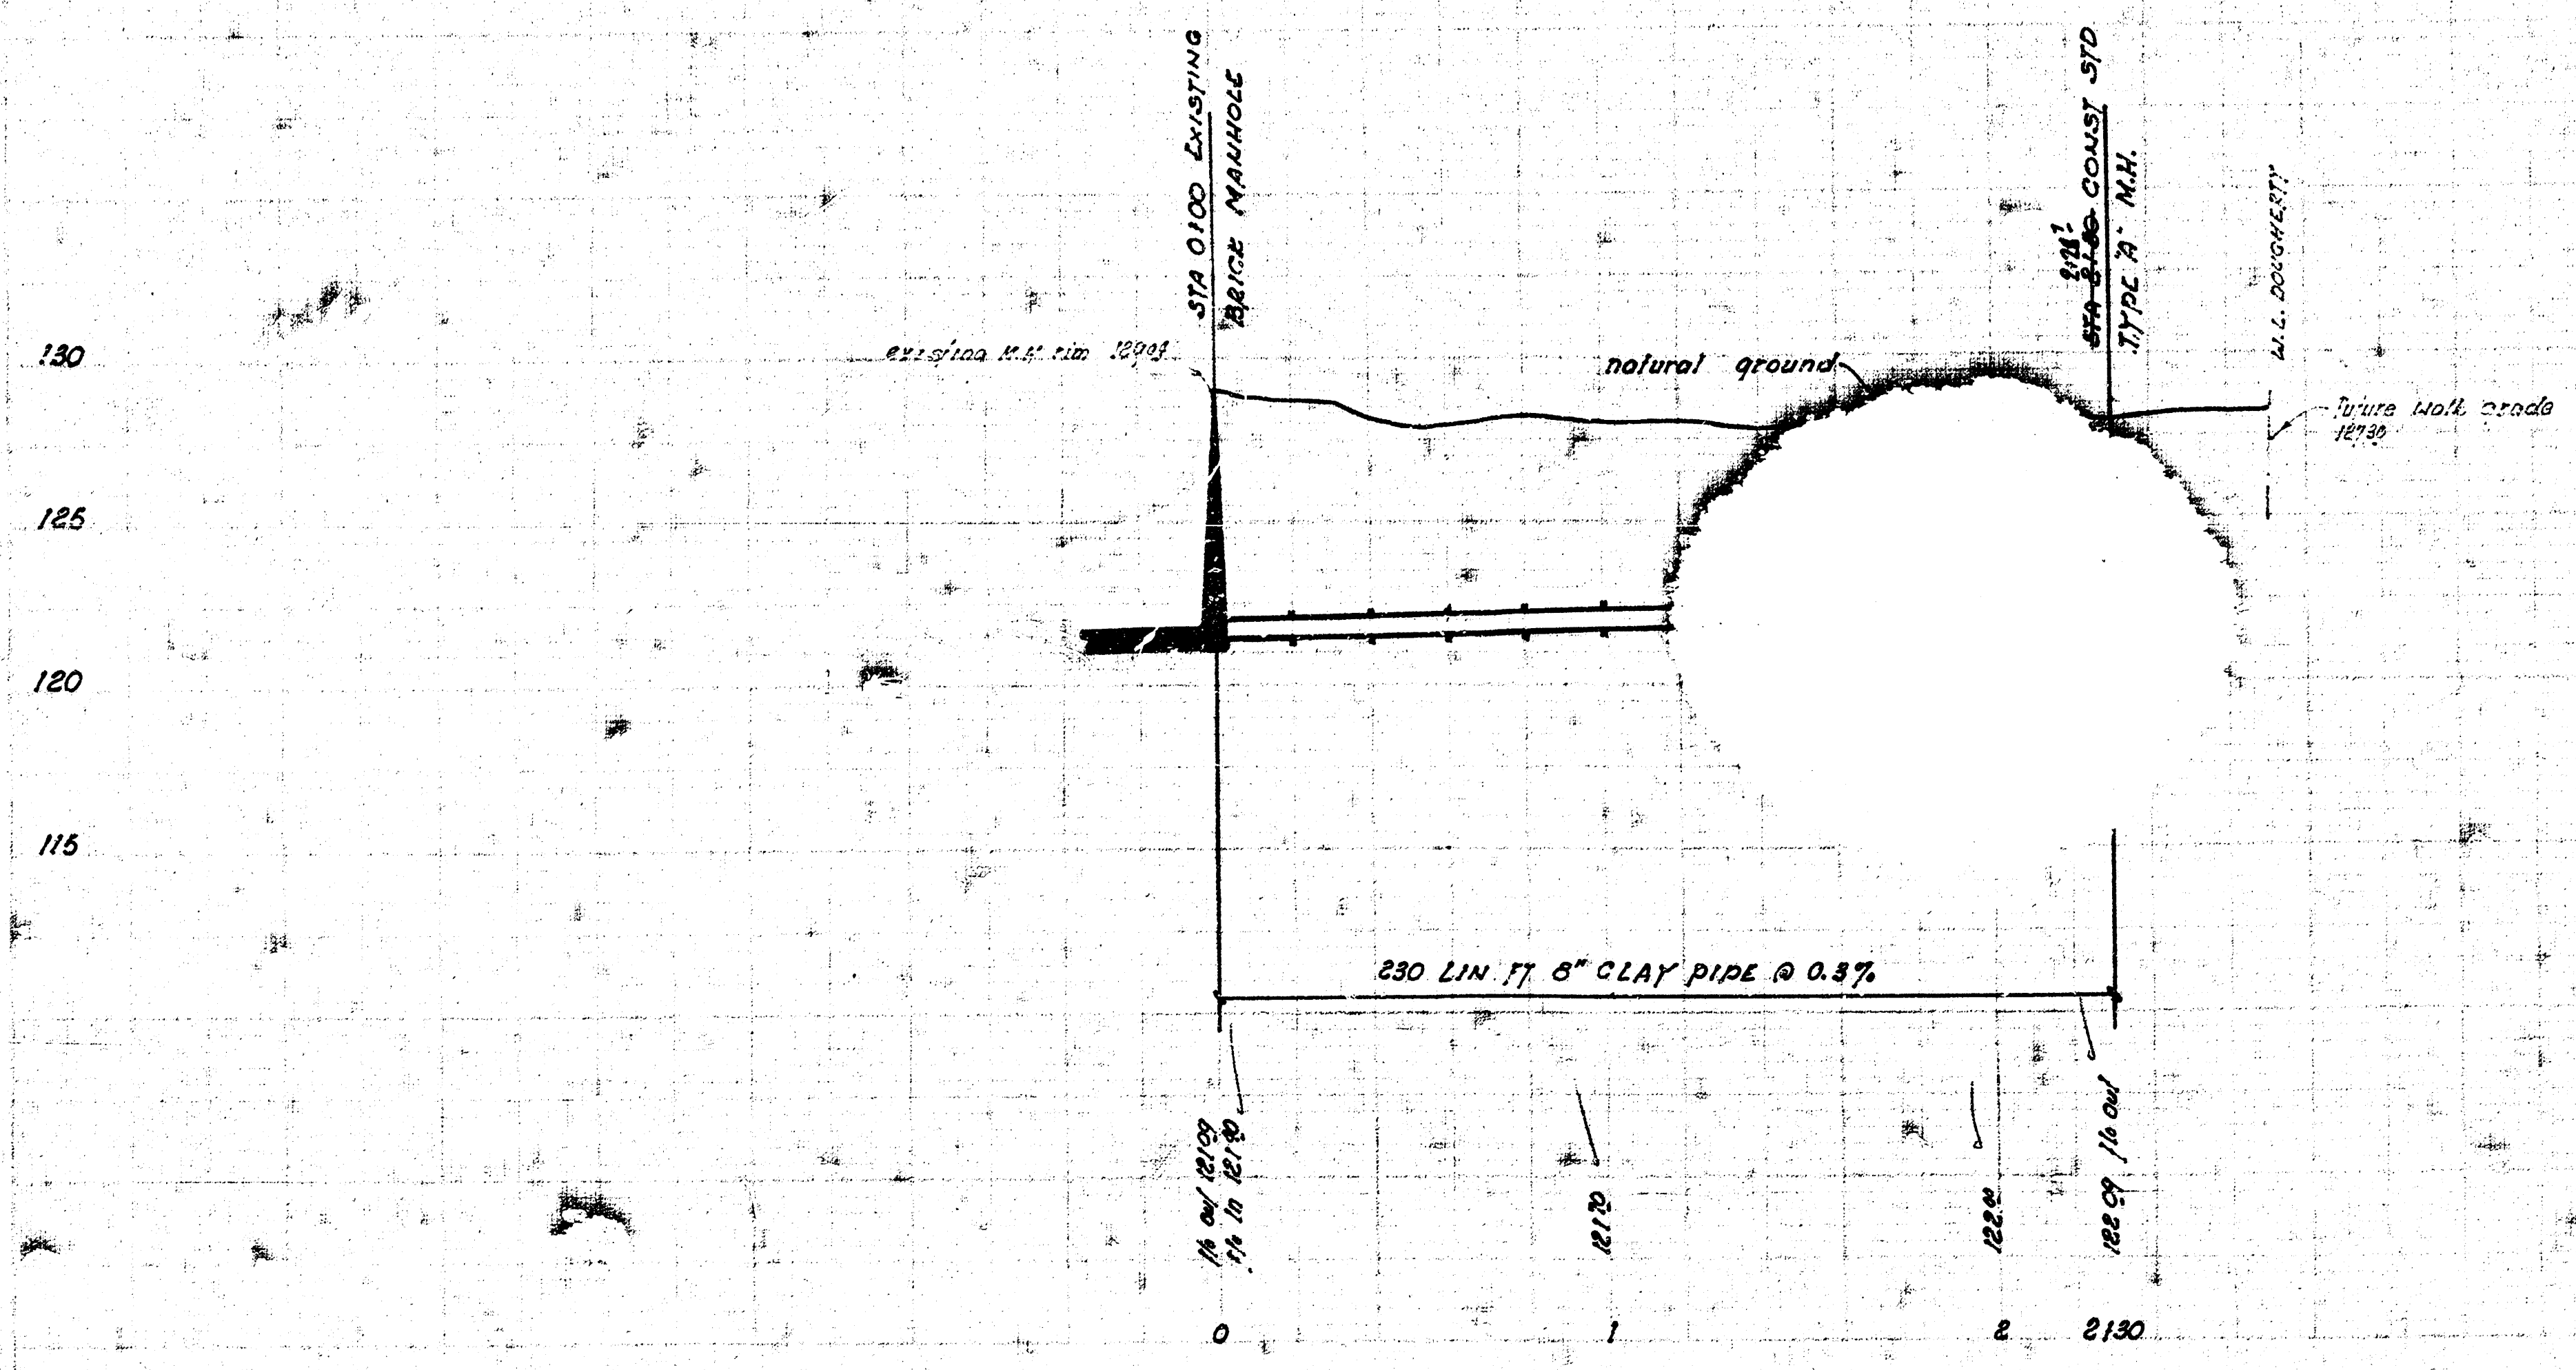

As Built 13 SEP 72 FINAL MEASUREMENT IN S.S. JK#6
LATERAL 213, MAIN 5, S.S. 22
 CITY OF WICHITA, KANSAS
 R.W. LINN CITY ENGINEER
 DATE SEPT. 1972 PROJ. NO. DBKL 572038

FILMED FROM THE BEST