


BM 126.44 City Std. Dia. 94' East & 94' North of E of West Street and 13th Street.

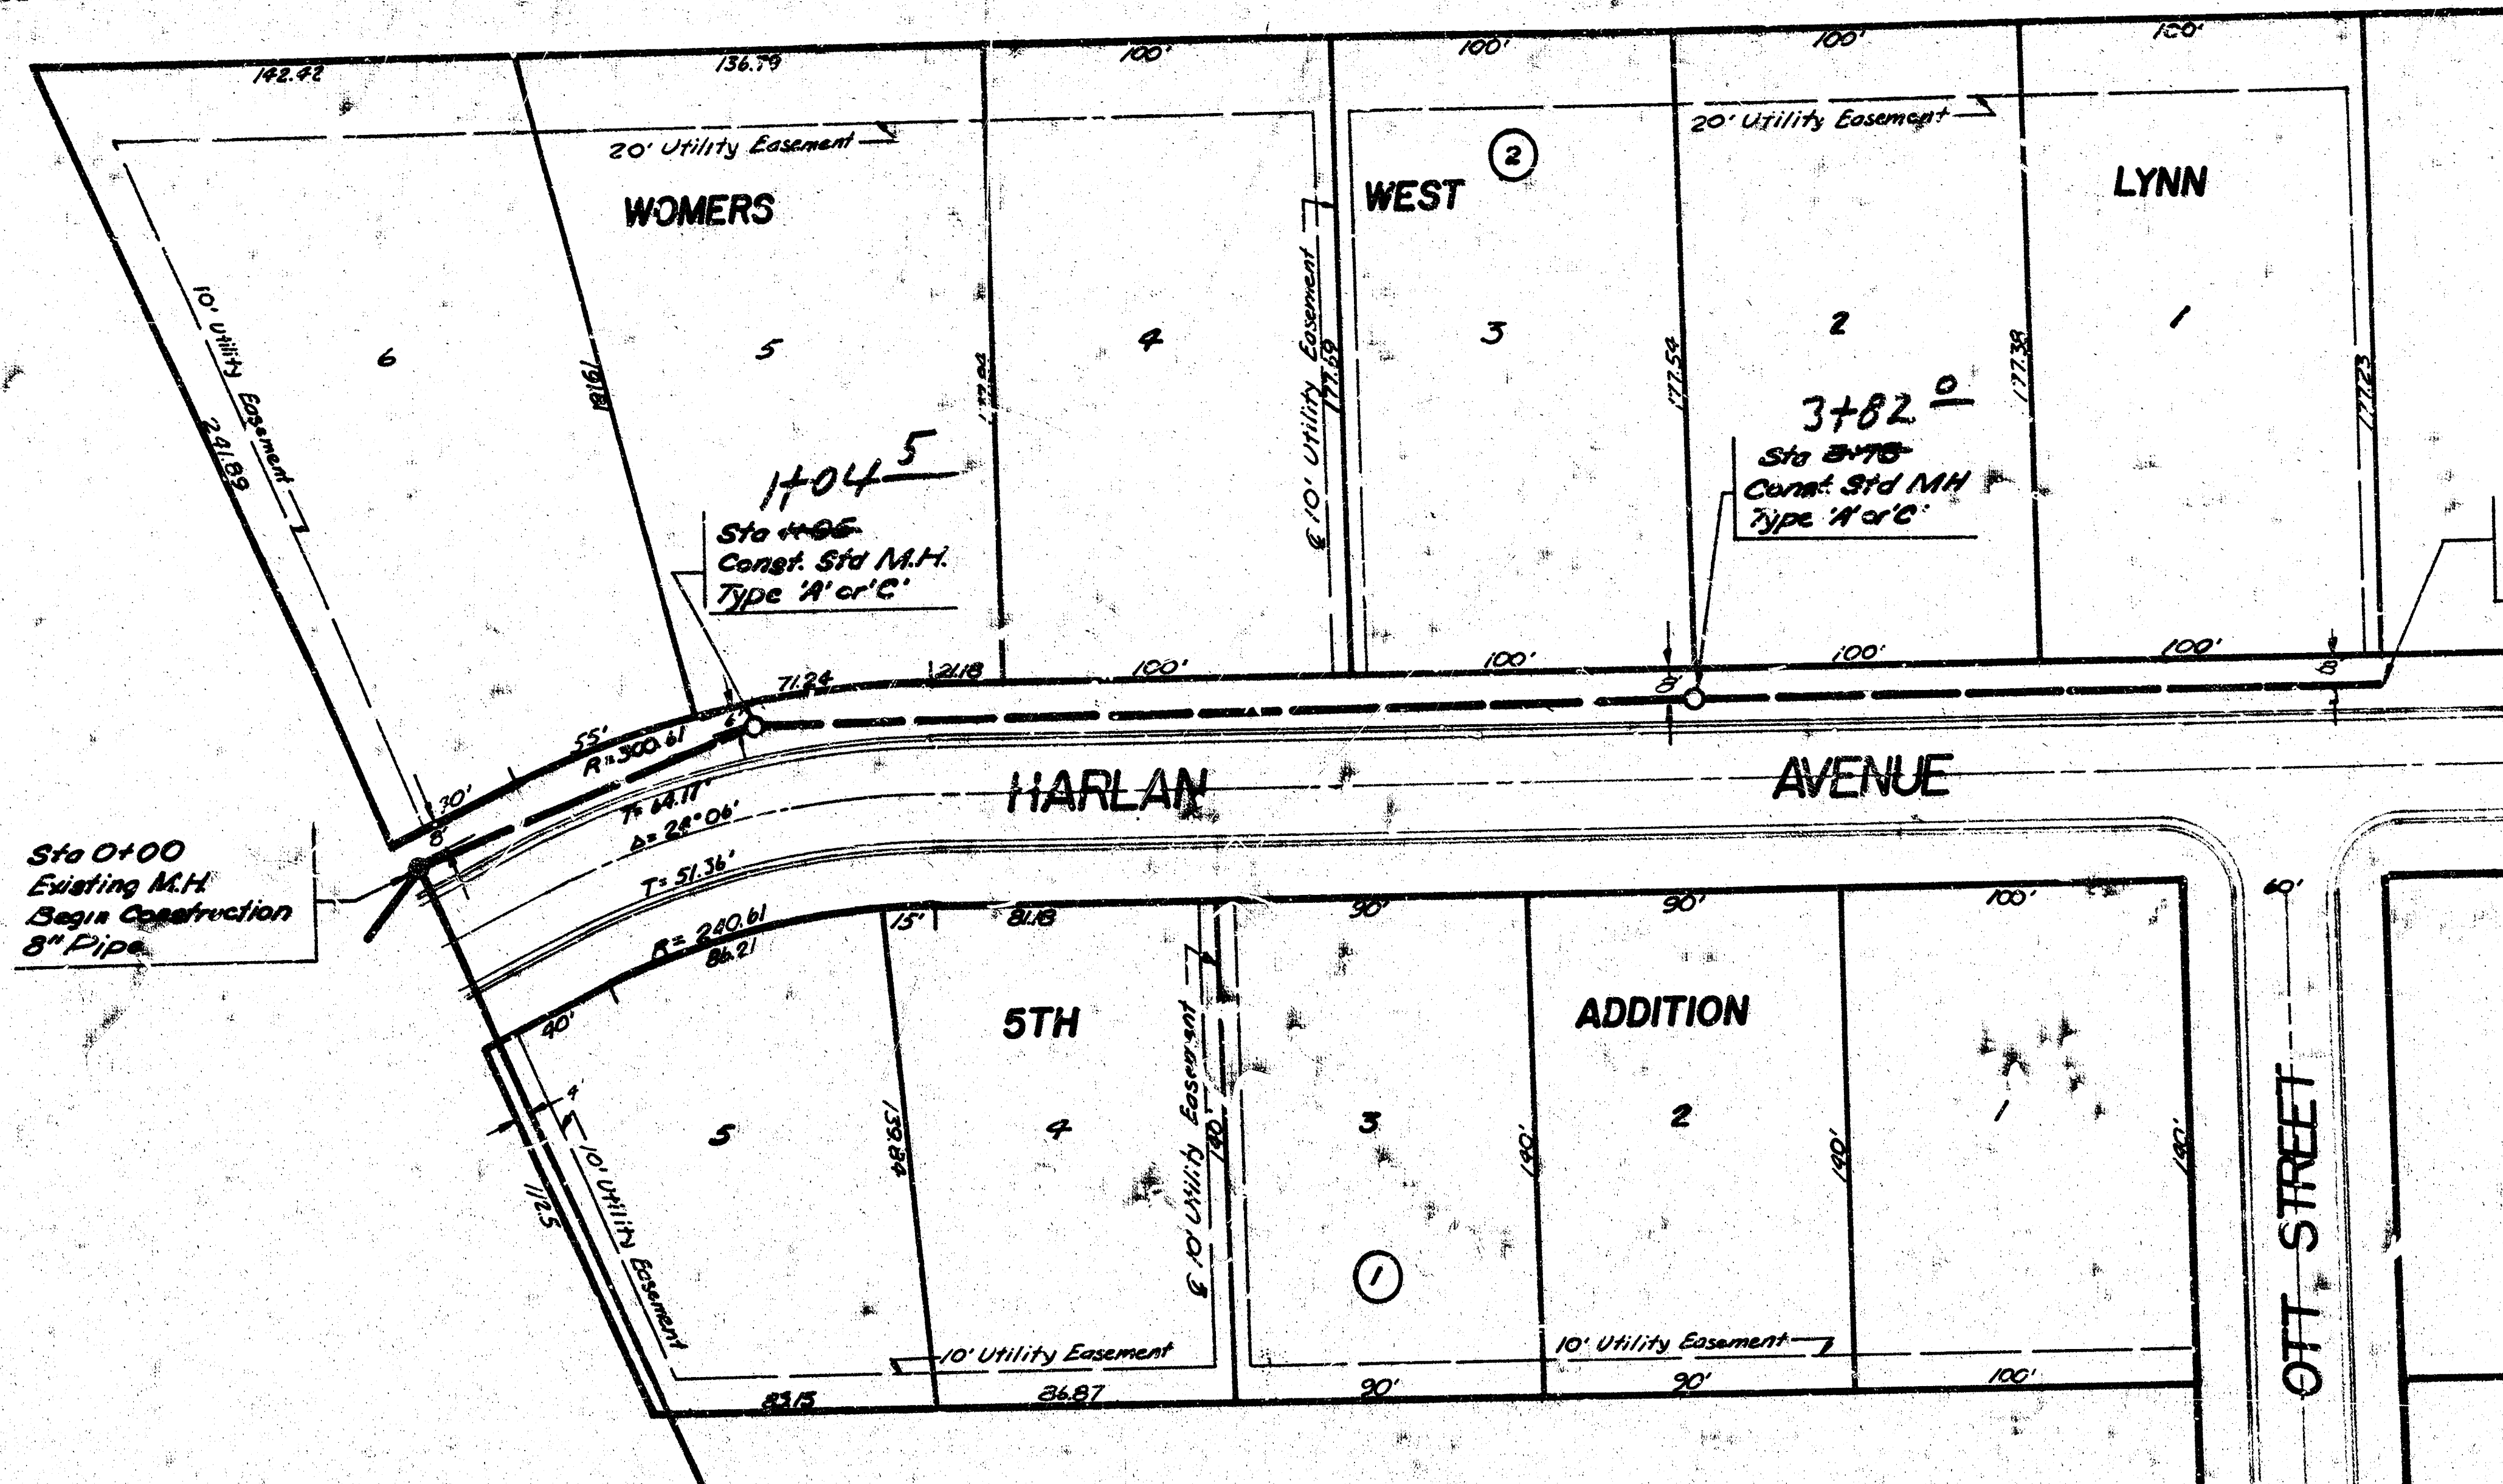


Plan Scale: 1" = 40'
Profile Scale: 1" = 40' Horiz.
1" = 5' Vert.

Note: Block 1 is not in the benefit district.

Field Engineer to make 'ties' to all irons.
Irons disturbed or destroyed are to be replaced.

NOTE: CONTRACTOR SHALL EXERCISE CAUTION SUCH THAT HIS OPERATIONS WILL PREVENT DAMAGE TO EXISTING PAVEMENT ON HARLAN AVENUE. ANY PAVEMENT DAMAGE BY THE CONTRACTOR SHALL BE REPLACED BY THE CONTRACTOR WITHOUT ADDITIONAL COMPENSATION.

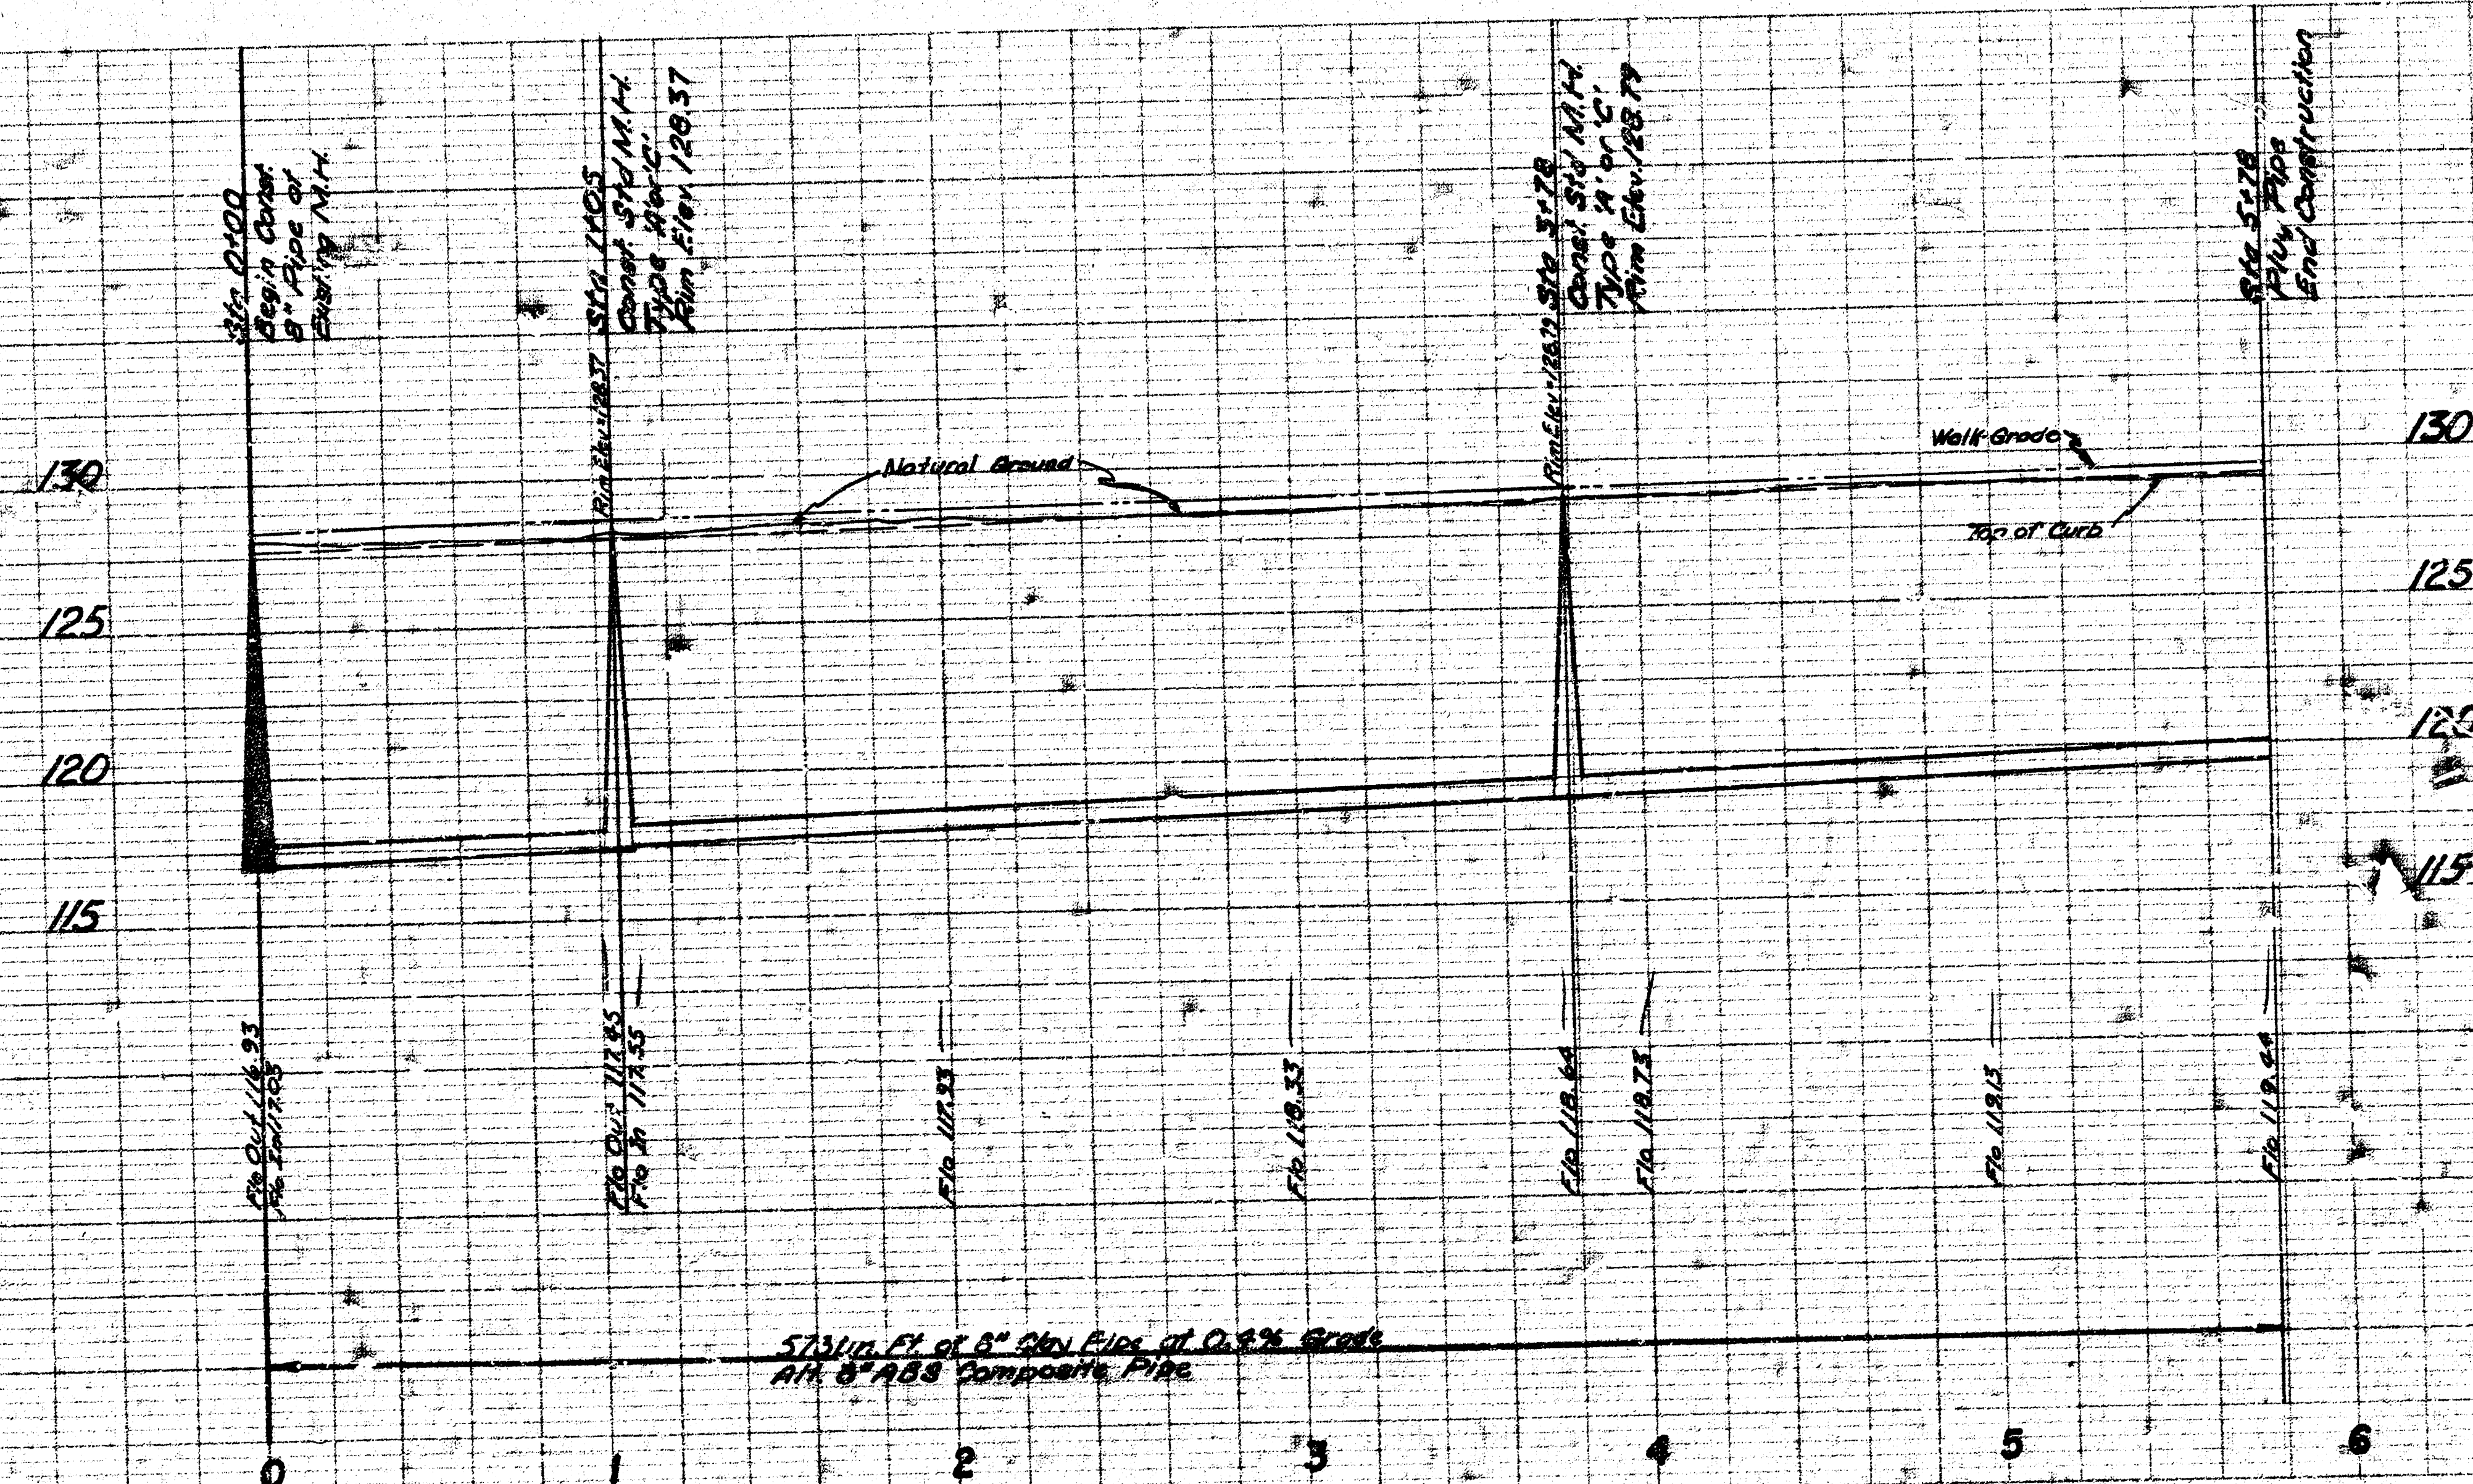

As built 9-22-77

LAT 217 MAIN 5 S.S. 22
CITY OF WICHITA, KANSAS
R.W. LINN CITY ENGINEER
DATE: 10/1/77 PROJECT NUMBER: DBKL574024

