


BM 126.15 West Side of P.P. at S.E. corner of Elder St. South & 9th St. North  
 BM 126.98 Top of R.R. Spike in E. side of PP Approx. 350 ft. East of the  
 Intersection of Curtis St. to the North & Robinson St.  
 BM 124.64 City Std. Disc. 33' W. & 42' S. of Anna & 9th St.




Plan Scale 1" = 40'  
 Profile Scale 1" = 40' Horiz.  
 1" = 5' Vert.

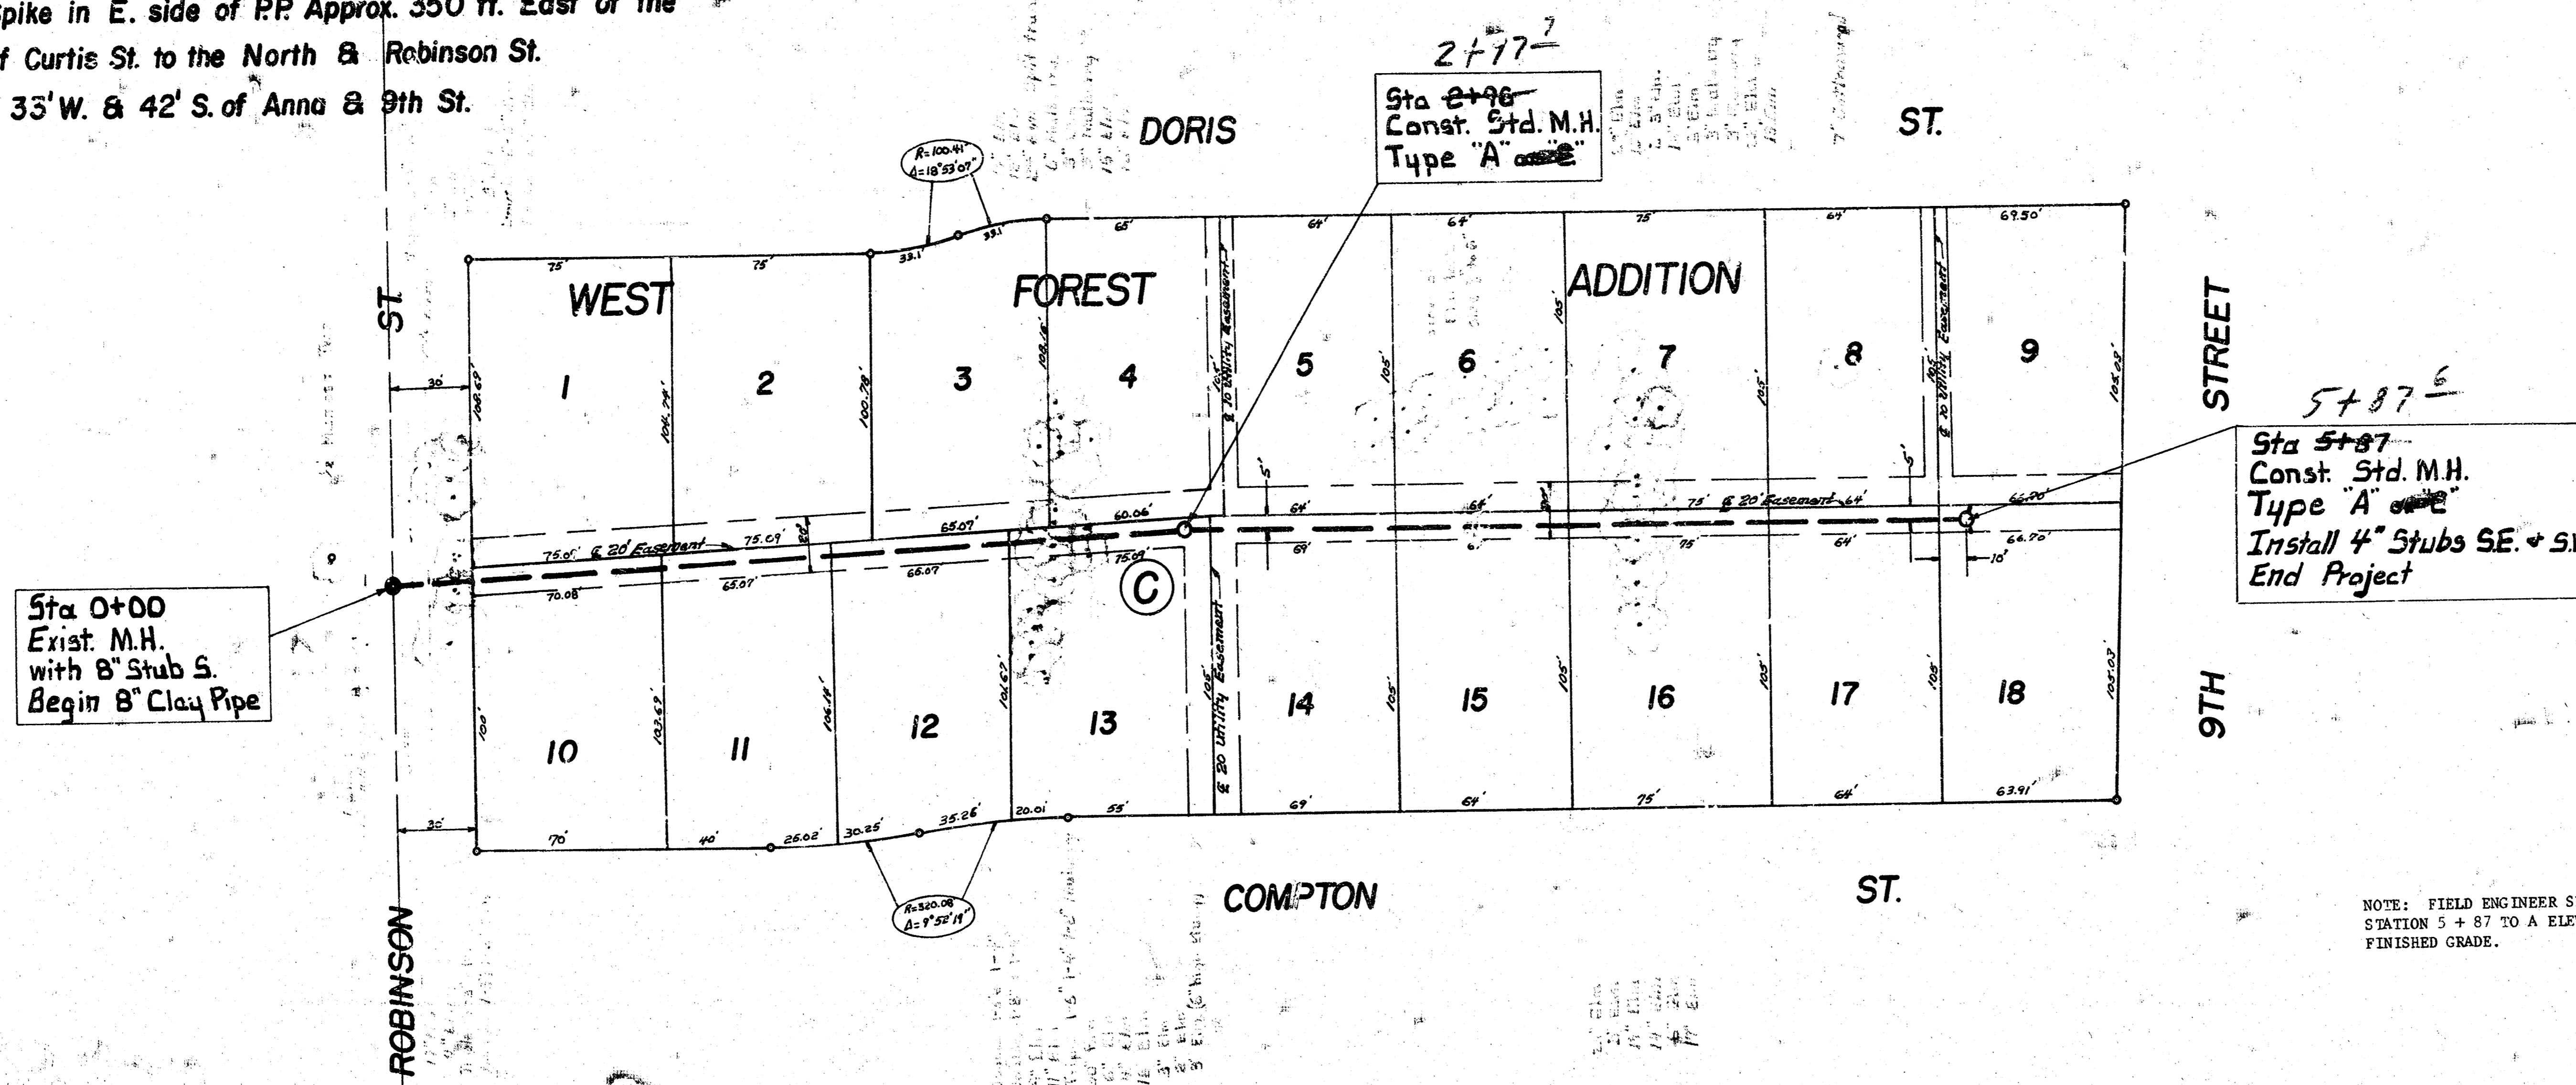

NOTE: FIELD ENGINEER SHALL SET TOP OF MANHOLE AT STATION 5 + 87 TO A ELEVATION WHICH WILL MATCH FINISHED GRADE.


130  
125  
120  
115

130  
125  
120  
115

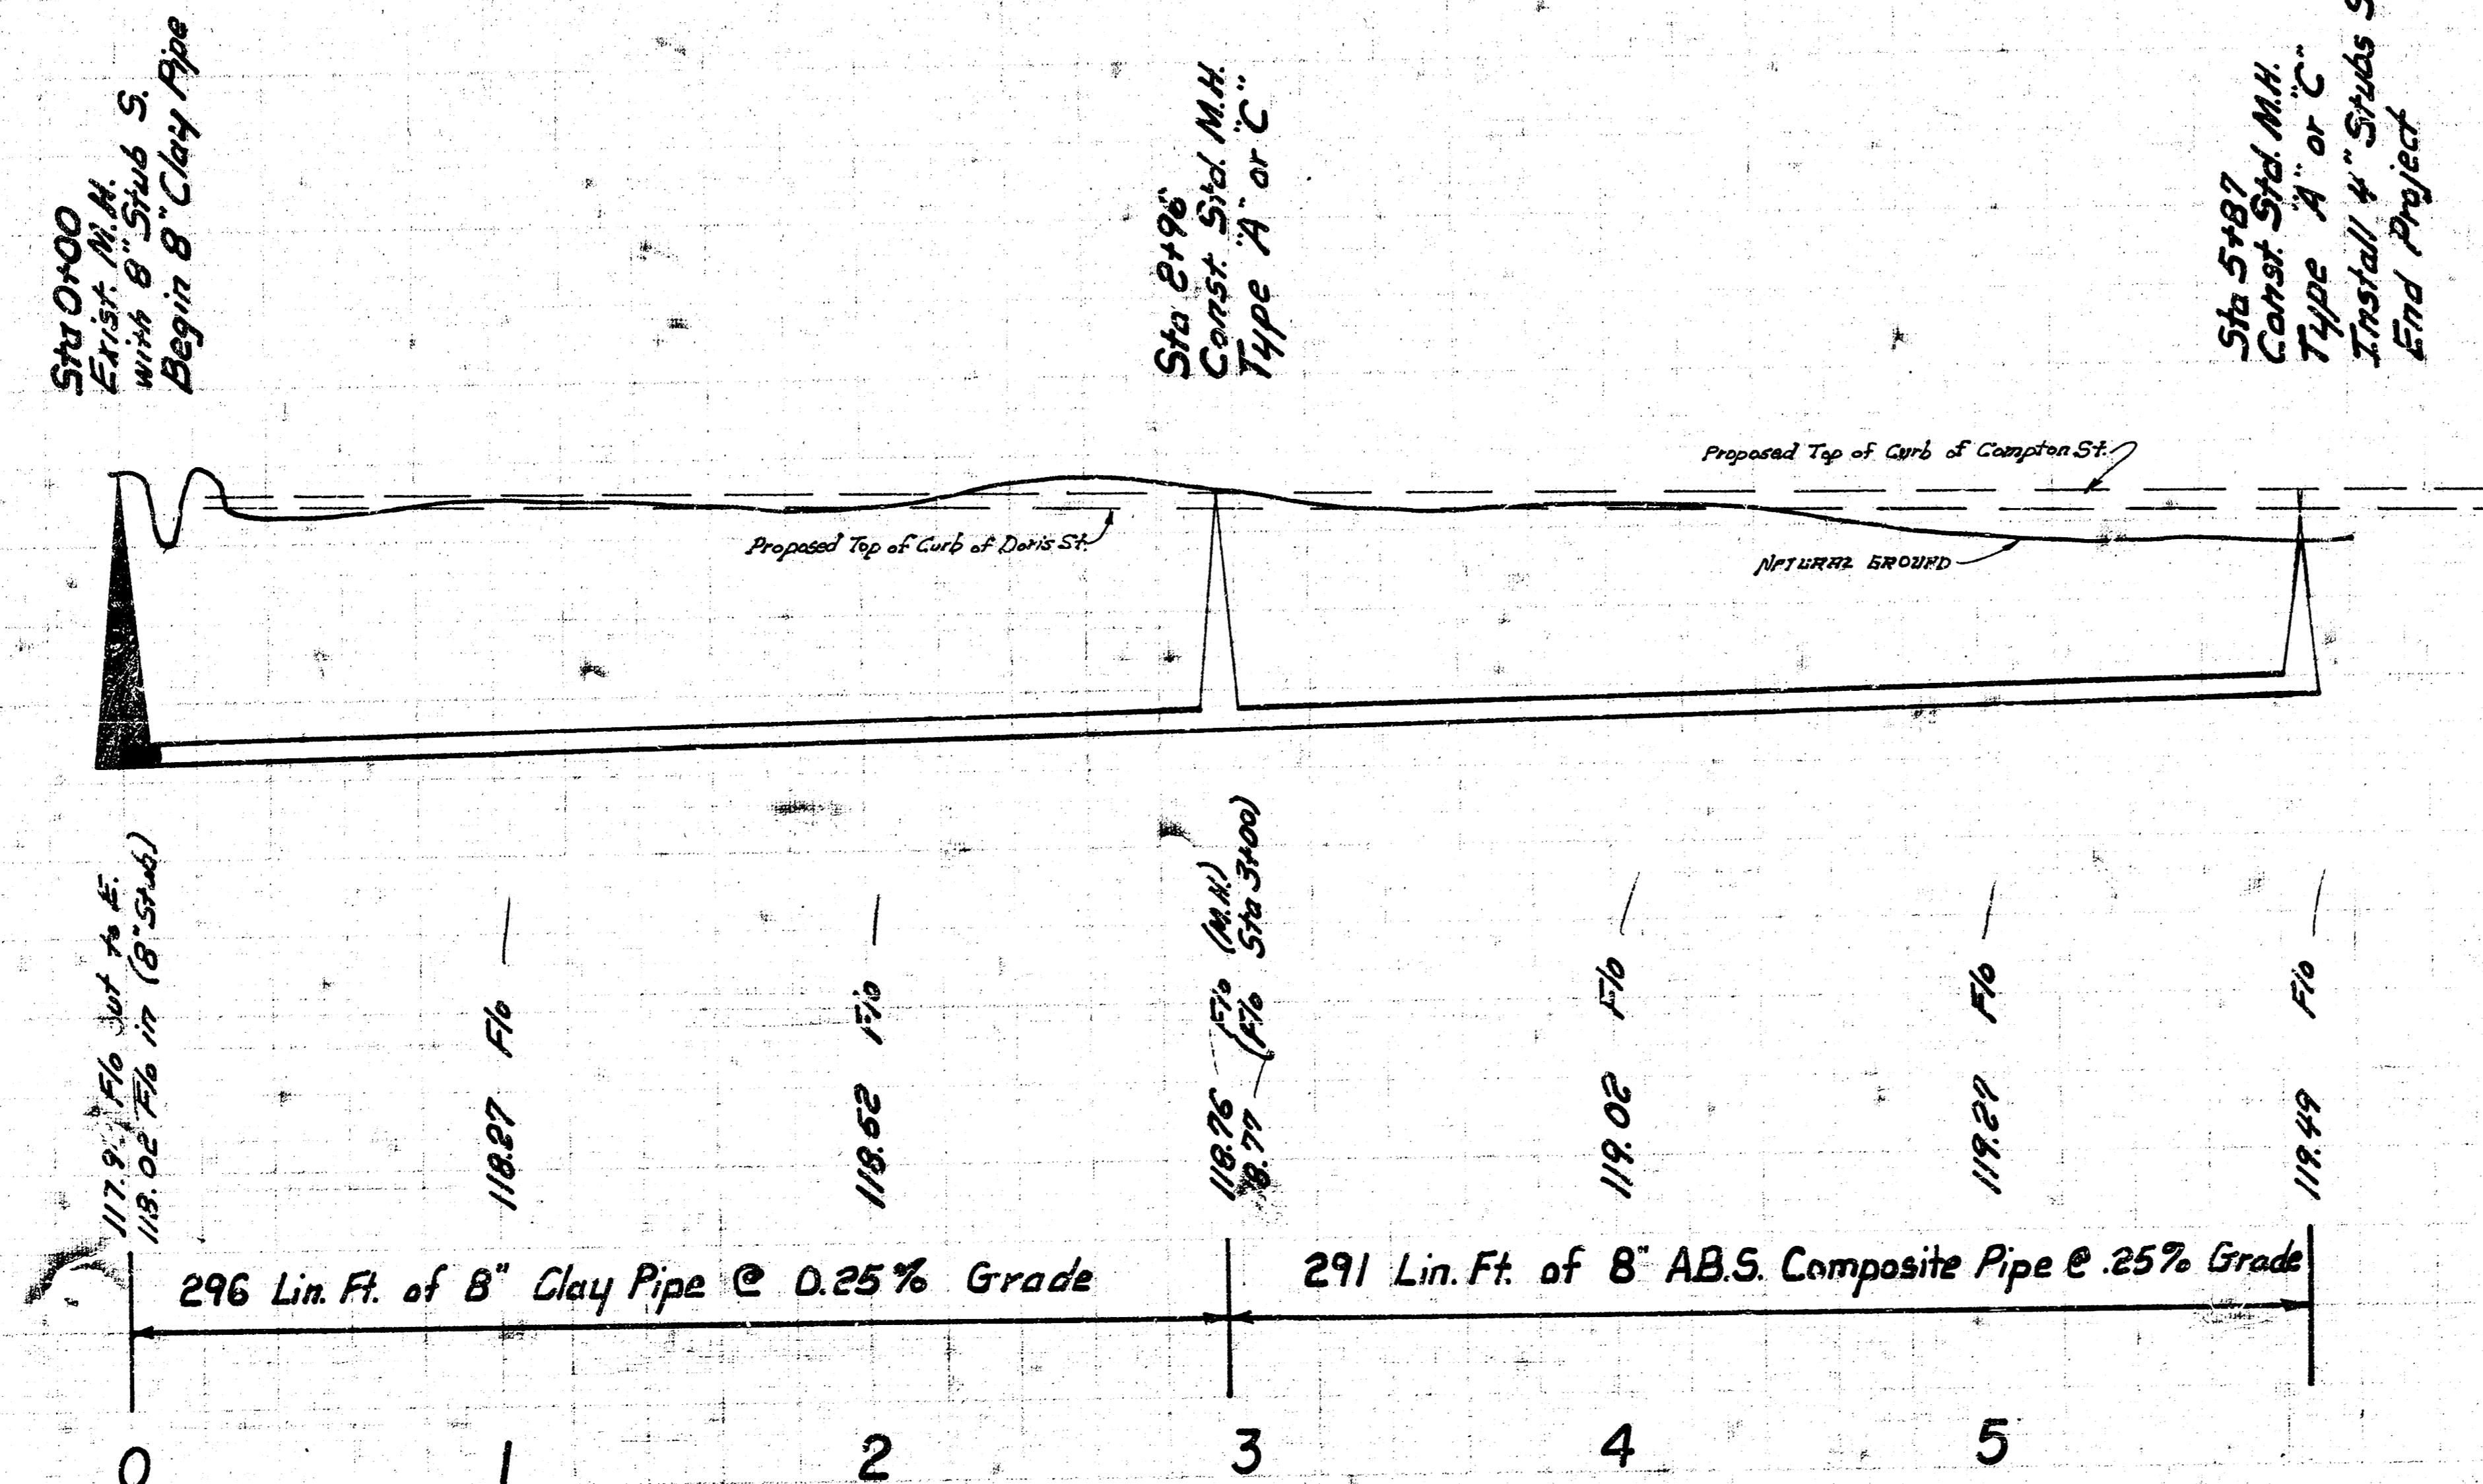

As built 11-30-77

LAT 224 MAIN 5 S.S. 22  
 CITY OF WICHITA, KANSAS  
 R.W. LINN CITY ENGINEER  
 DATE: PROJECT NUMBER: DBKL577009

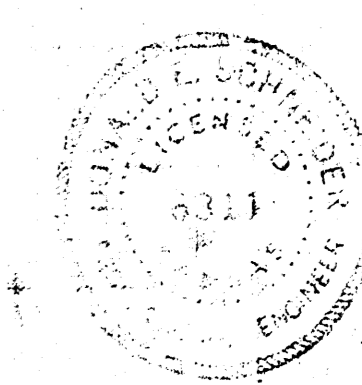

14 5 5 18