



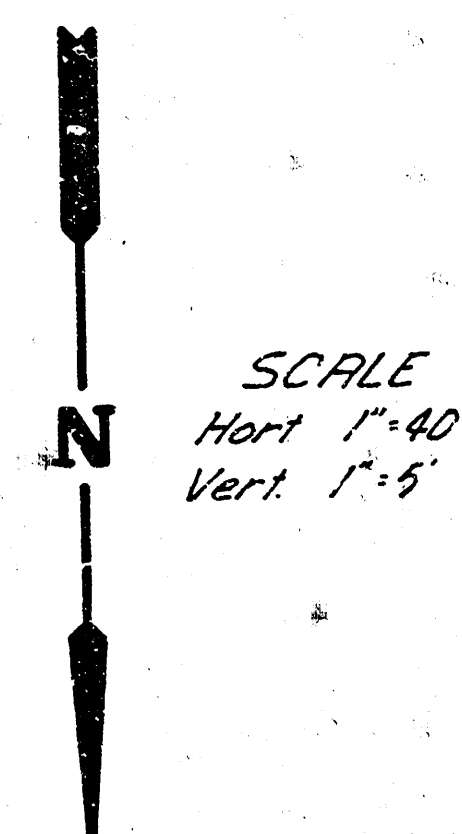

B.M. 124.64 City Sid. 33' W. & 42' S. of Q's
9th & Anna

B.M. 126.31 Bridge Spk. S.W. Face P.P.
190' S. of S.L. 11th S. & 7' W. of
Bk. of Ch. W.S. of Smith.


Smith

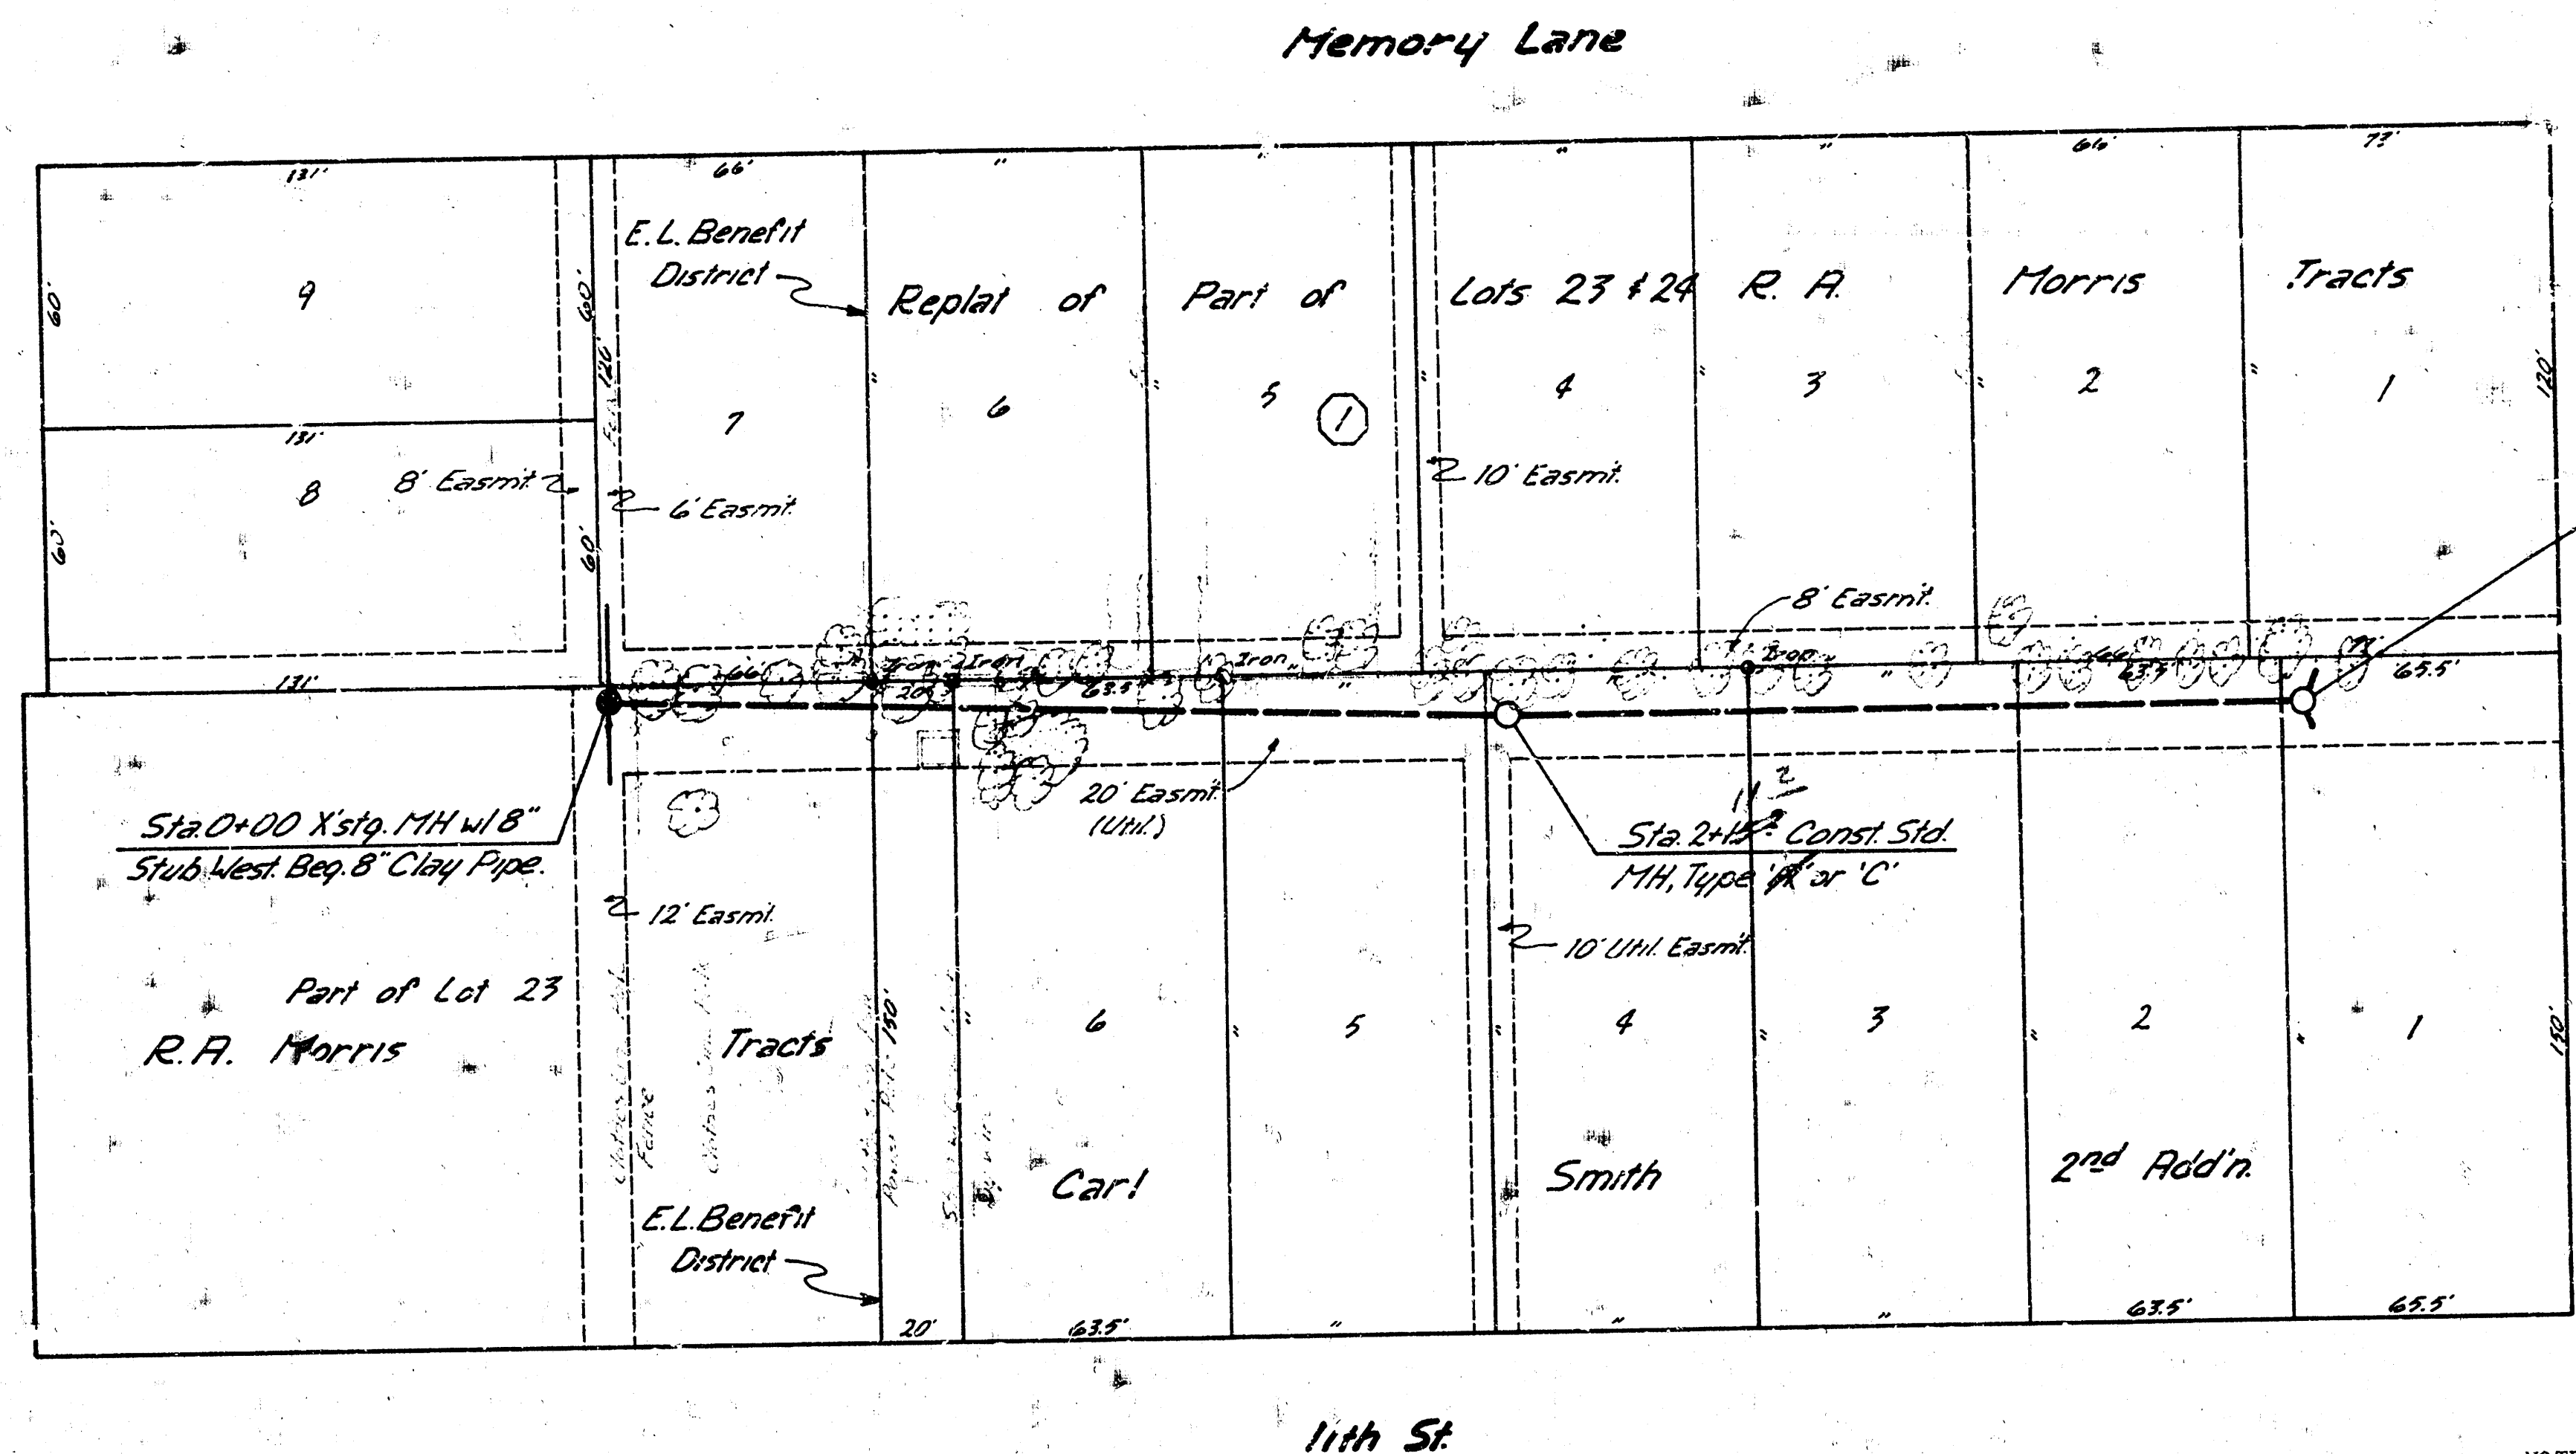

Sta 0+00 Const Sid
MH Type A or C
Install 4 Stubs NW & SW

- General Notes
1. Field Engineer to Verify Flo Elev. of 8" Stubs before Beg. Construction
 2. Field Engineer to Set Top of Manholes to Finish Grade as Determined by the Developer.

NOTE: CONTRACTOR SHALL GIVE OWNERS AND OR TENANTS OF DEVELOPED PROPERTY NOTIFIED BY THE CONSTRUCTION OF THIS PROJECT A MINIMUM ADVANCE NOTICE OF 2 HOURS PRIOR TO STARTING CONSTRUCTION ON THIS PROJECT.

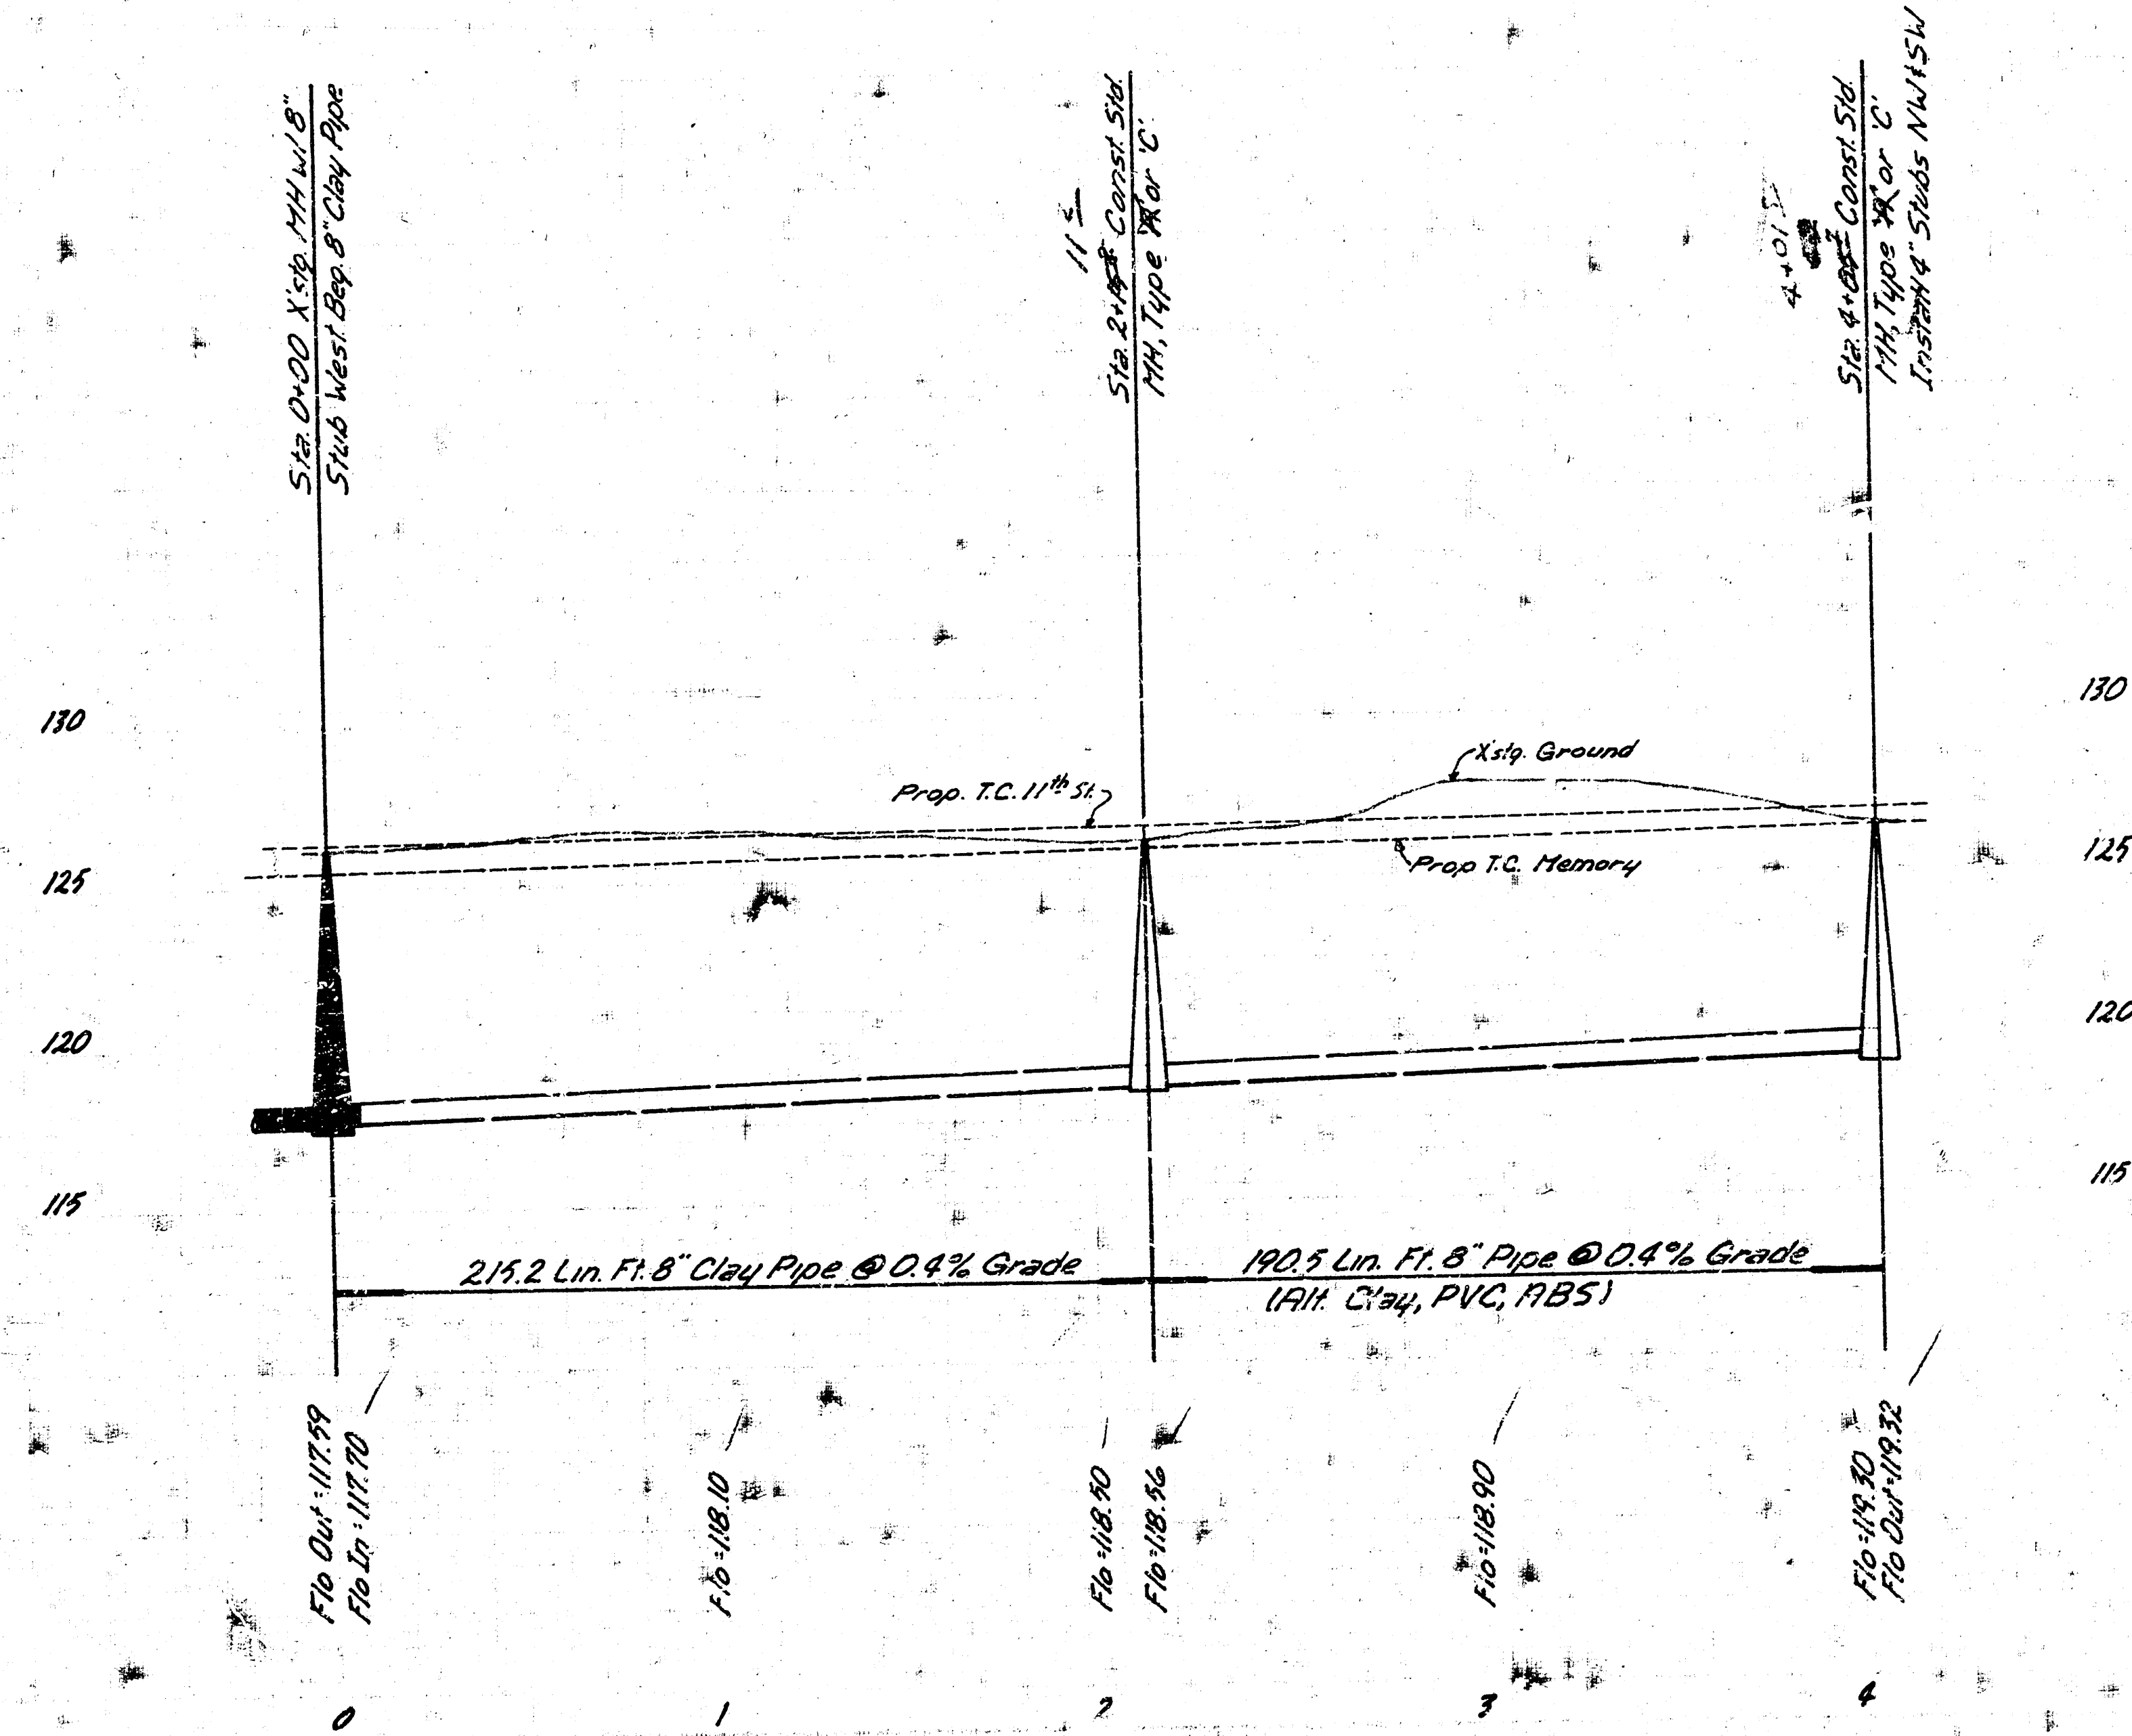

As Built 9/13/22

Lat. 230, Main 5, S.S. #22
468-76-245-80910-000-000-001
City of Wichita, Kansas
Dept. of Public Works-Eng. Div.
Dean S. Sellers-Acting City Engineer
Date