

LATERAL 240, MAIN 5, S.S. 22



CITY OF WICHITA, KANSAS

M.E. LINDEBAK CITY ENGINEER

PROJECT NO. 468-76-245-81328-000-000-001


DATE: JANUARY 1984


As Built
JHL
4-84

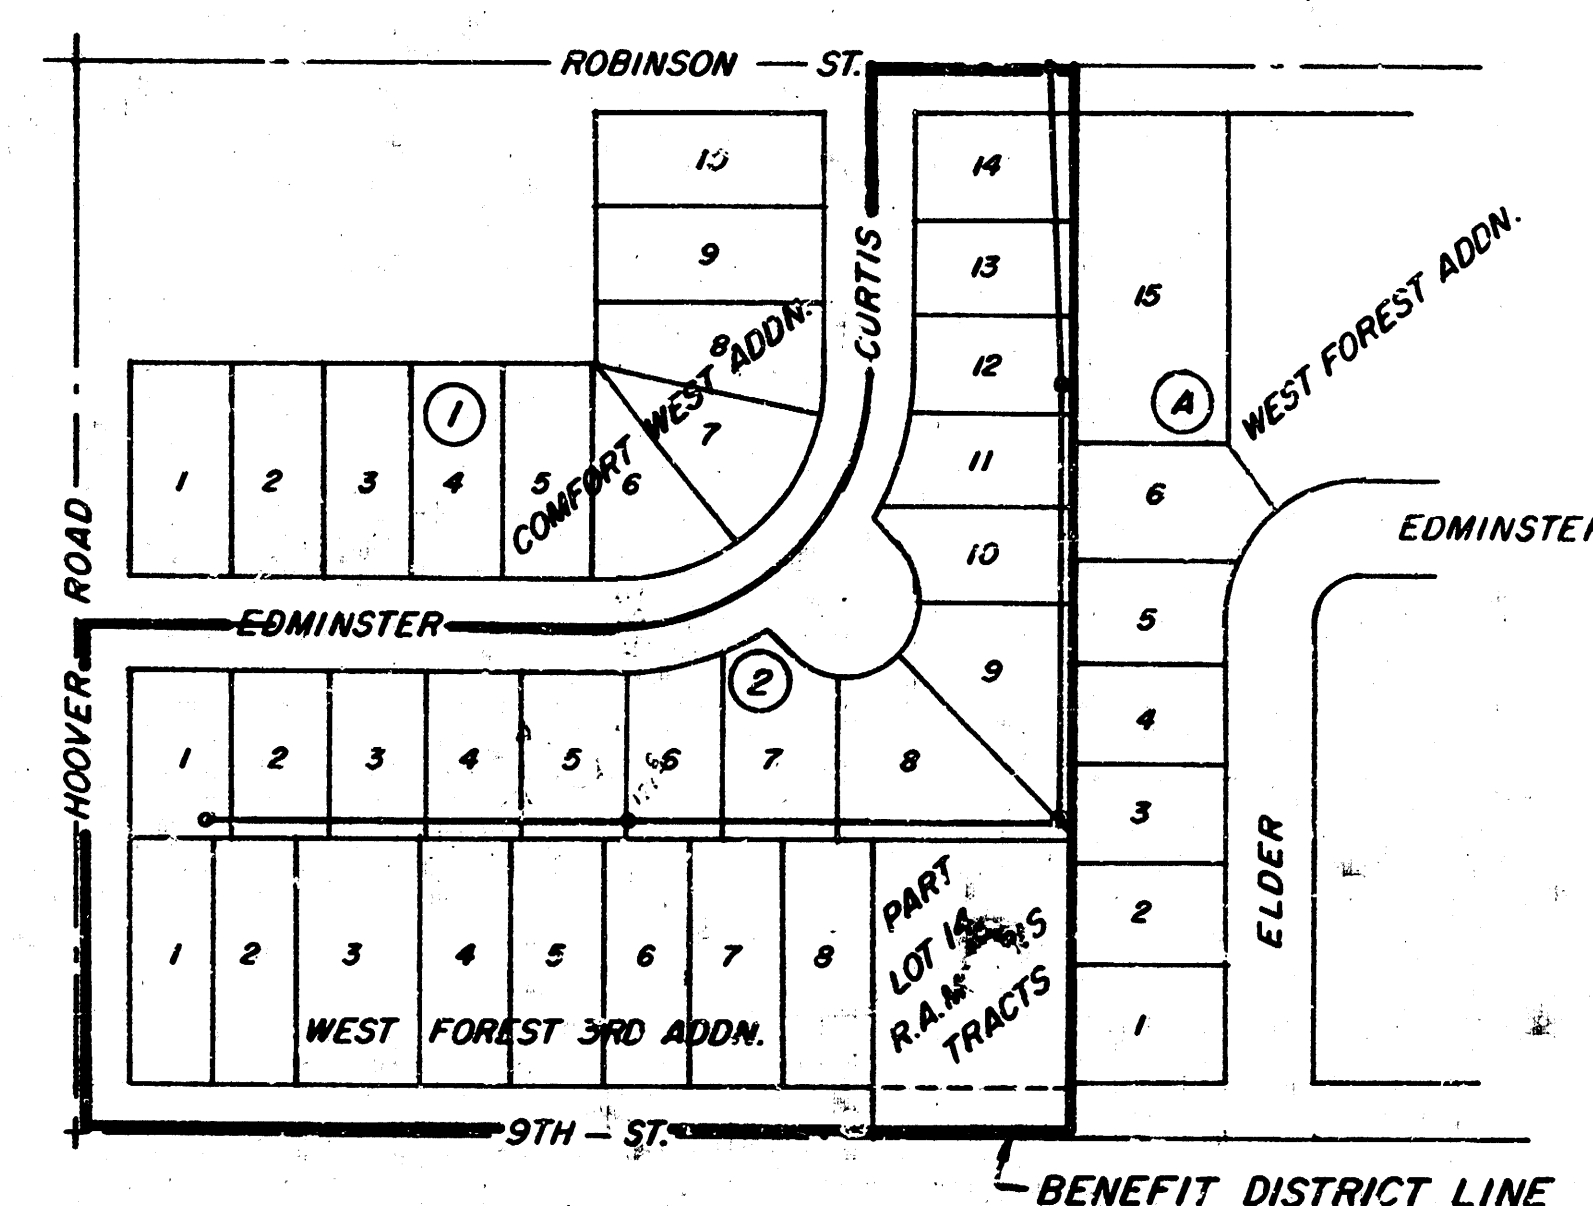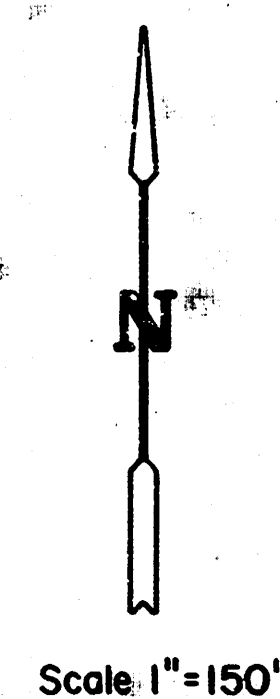

LOCATION MAP

MOEHRING & ASSOCIATES
CONSULTING ENGINEERS
WICHITA

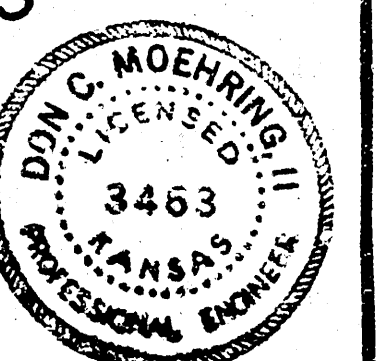


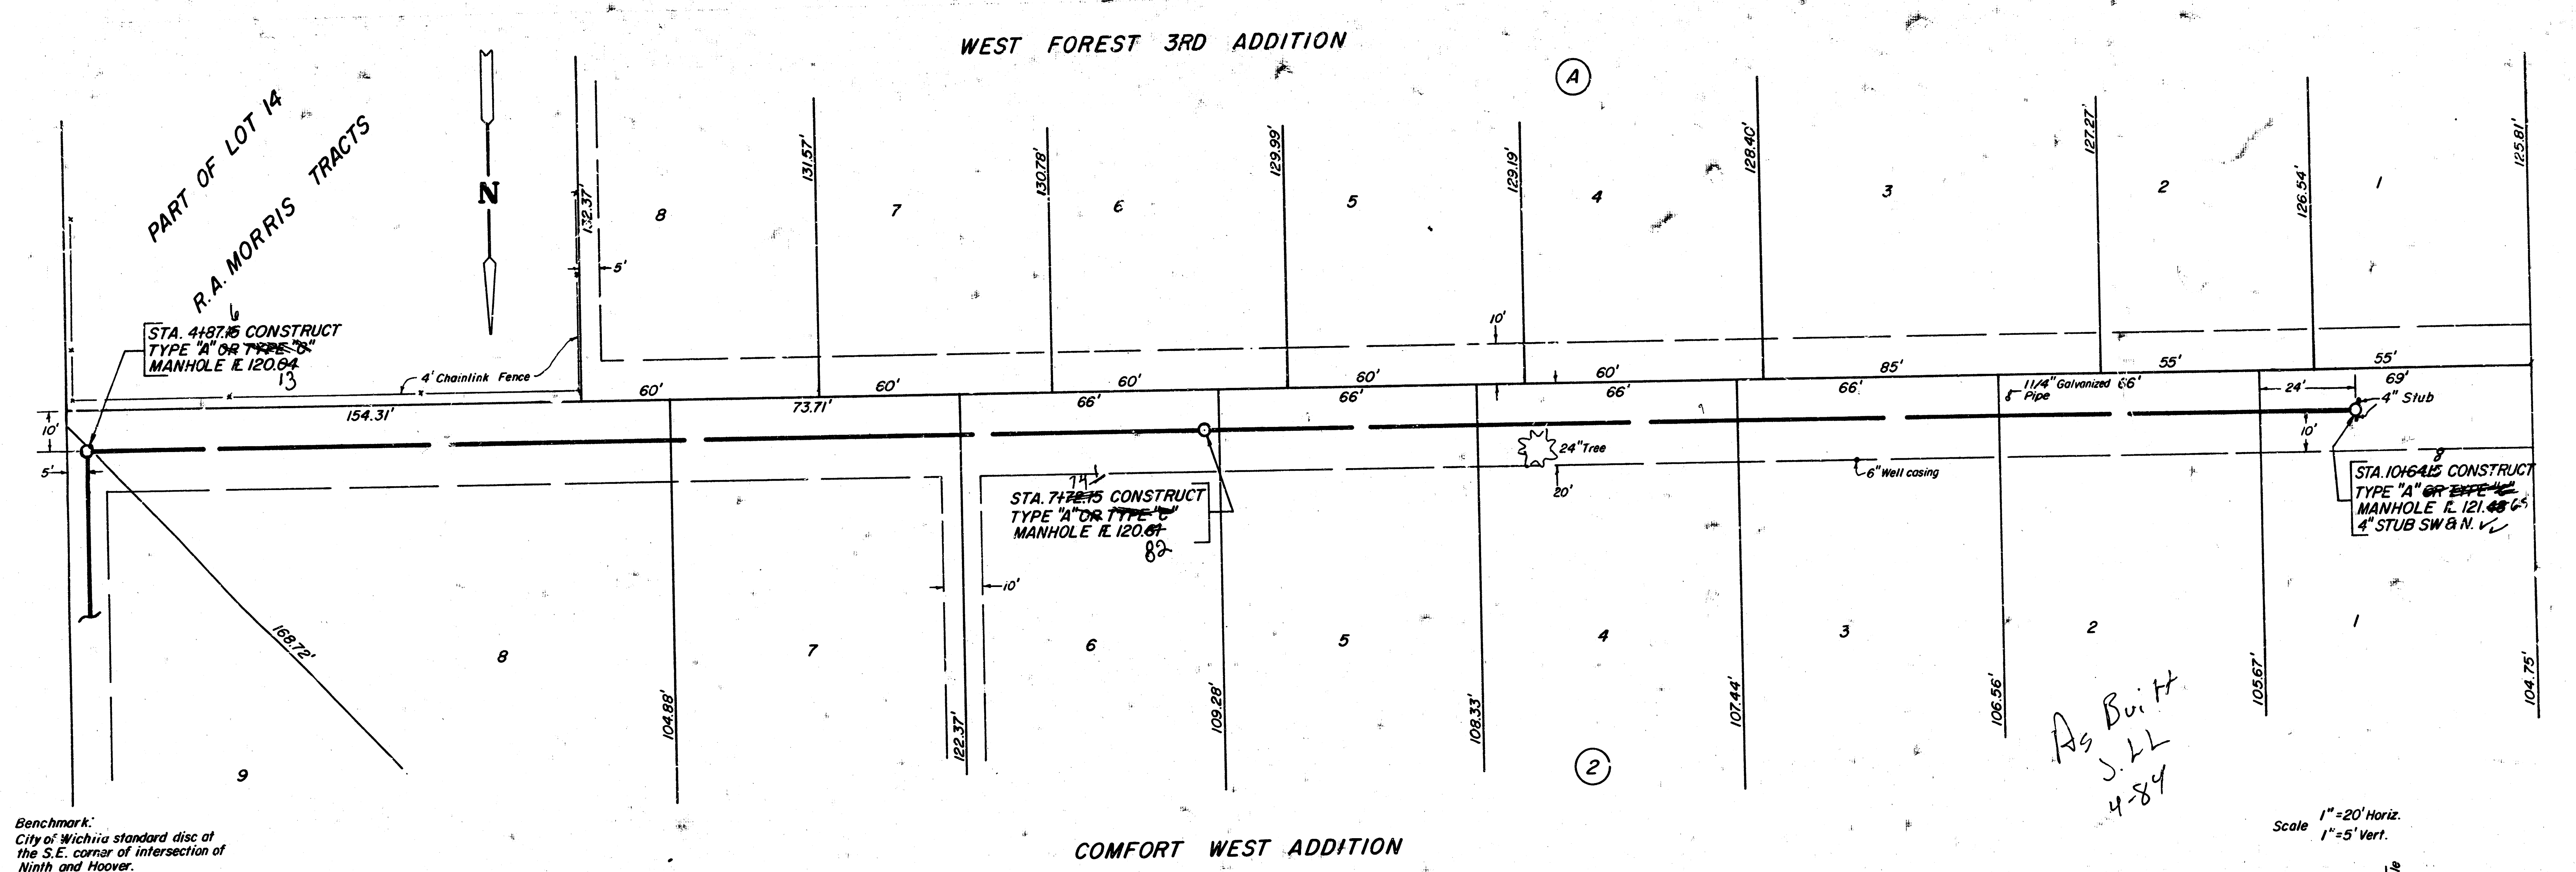

Benchmark:
City of Wichita standard disc at
the S.E. corner of intersection of
Ninth and Hoover.
Elev. 126.29

Scale
1"=20' Horiz.
1"=5' Vert.

As Built
JLL
4-84

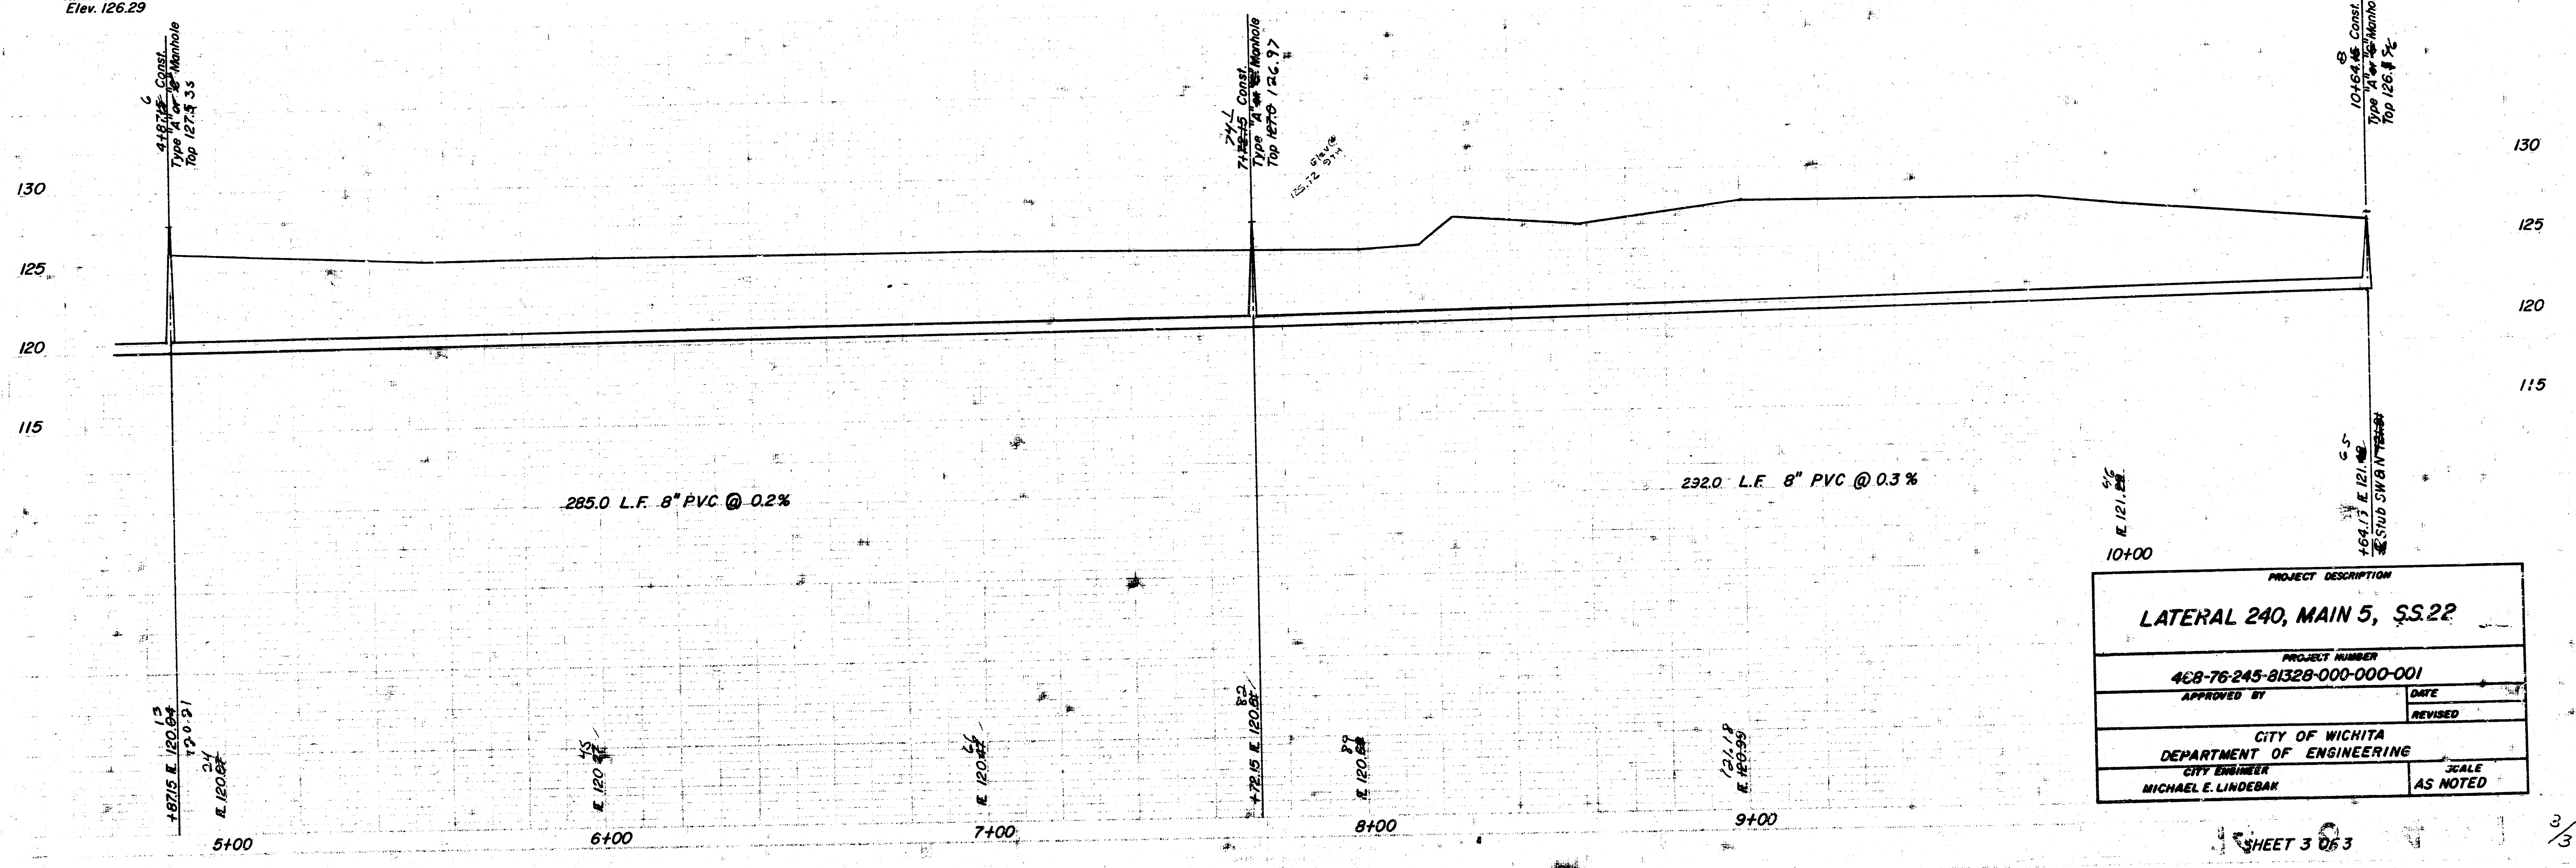

PROJECT DESCRIPTION	
LATERAL 240, MAIN 5, SS.22	
PROJECT NUMBER 468-76-245-81328-000-000-001	
APPROVED BY	DATE
CITY OF WICHITA DEPARTMENT OF ENGINEERING CITY ENGINEER MICHAEL E. LINDEBAK	REVISOR
SCALE AS NOTED	

SHEET 3 OF 3

FILMED FROM THE BEST
AVAILABLE COPY....