



B.M. 121.66 City Std. 10' N and 2' E of S.E. Cor. (30' S. and 92nd E. of SHERIDAN and CENTRAL)

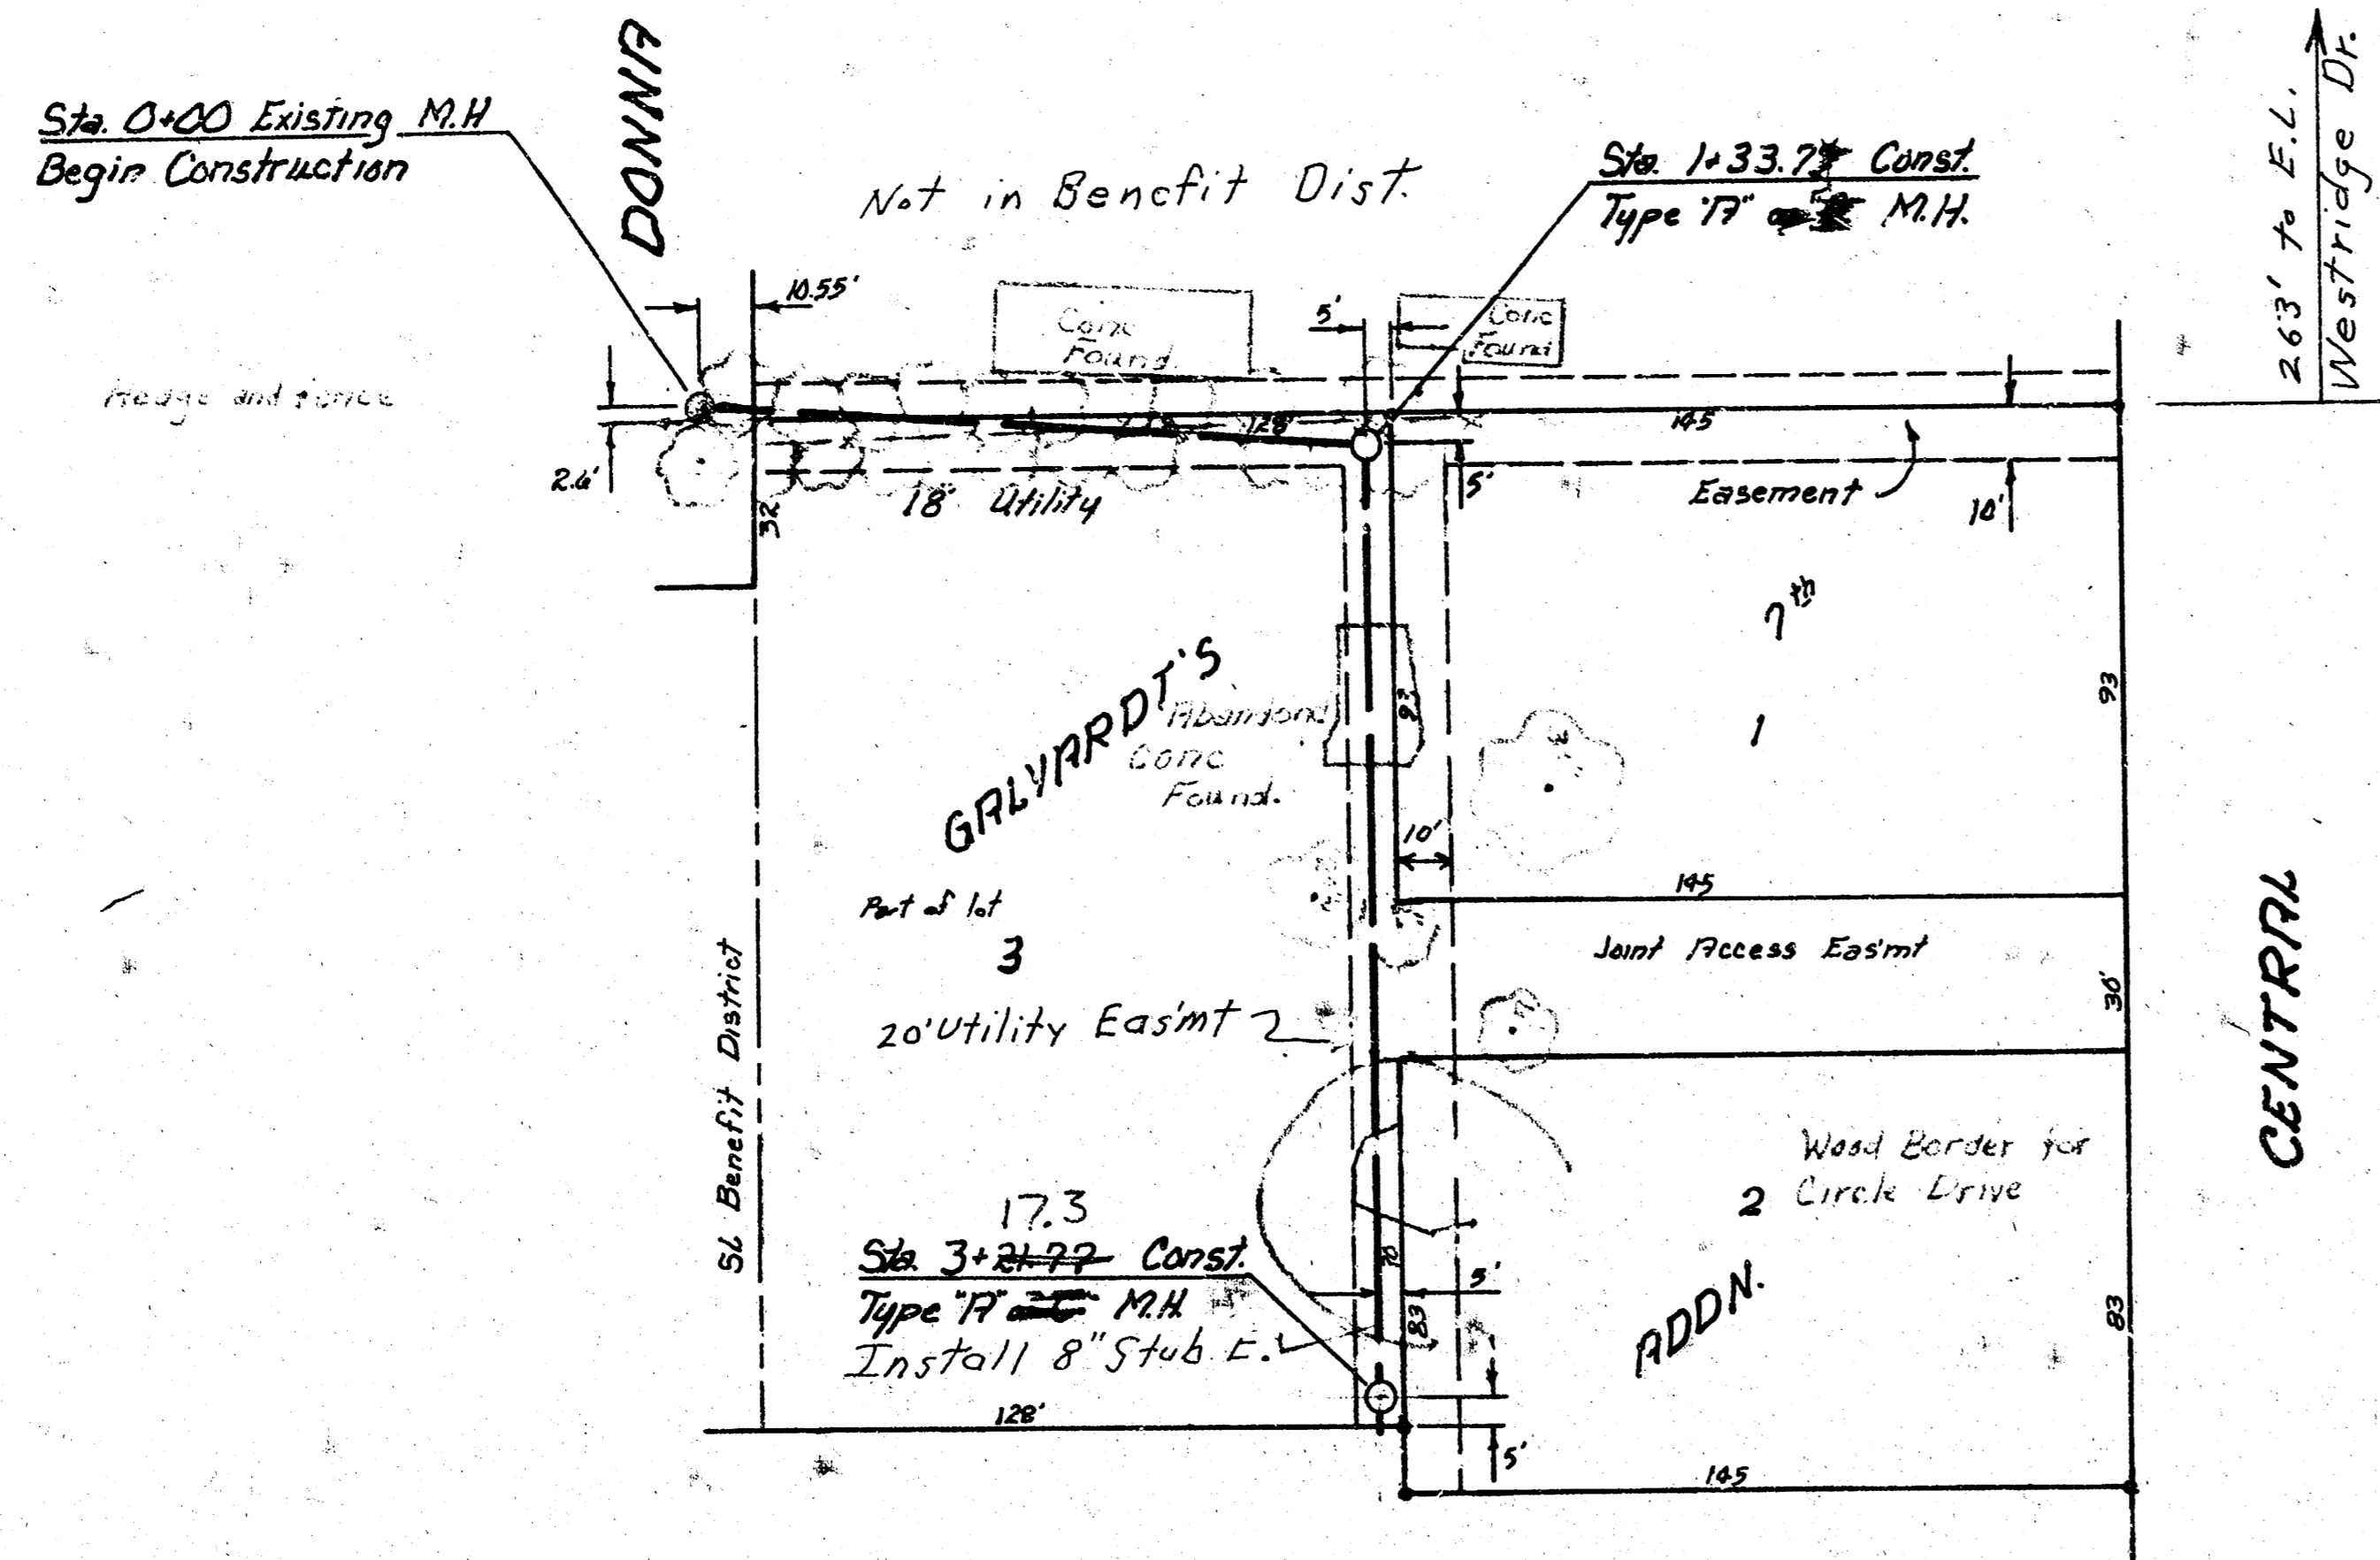

SCALE
 PLAN 1" = 40'
 PROFILE 1" = 40'
 Vert. 1" = 5'

NOTE: CONTRACTOR SHALL REPLACE WOOD BORDER FOR CIRCLE DRIVE. THIS WORK WILL NOT BE PAID FOR DIRECTLY AND SHALL BE CONSIDERED AS SUBSIDIARY TO THE OTHER ITEMS OF WORK.

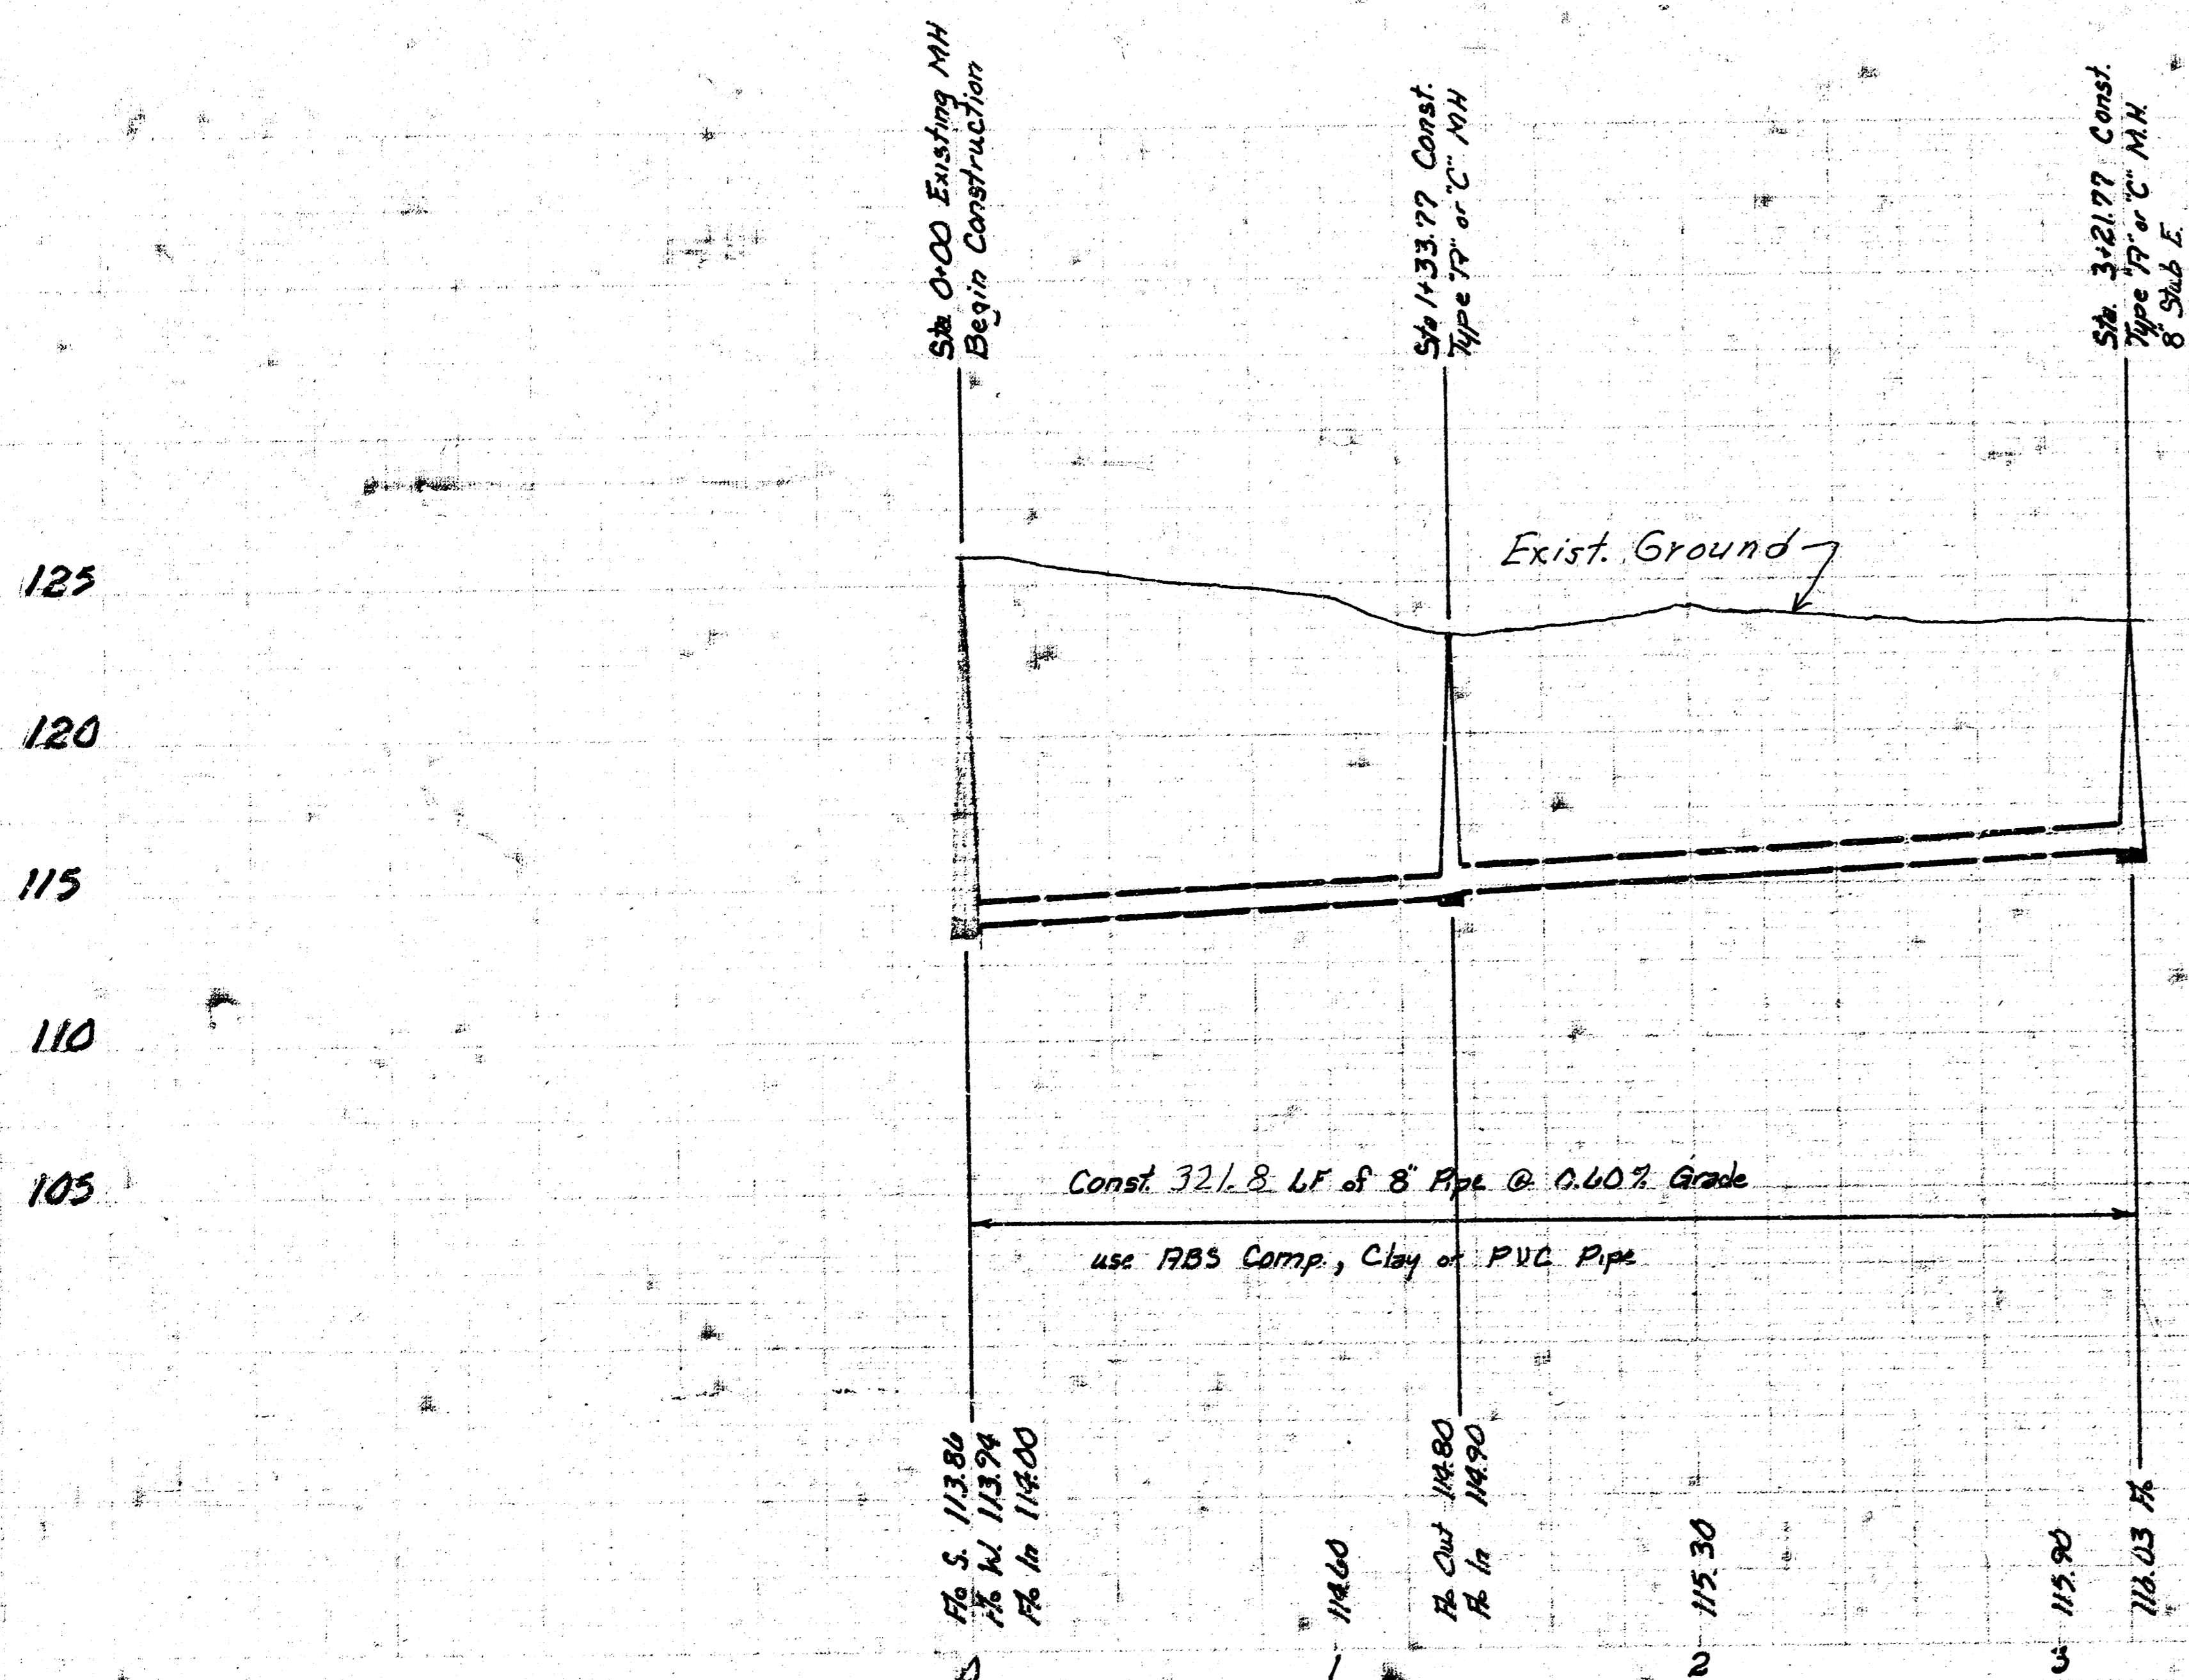

As Built
 1/01
 JSS



1. MATERIAL II, MAIN 8, SANITARY SEWER No. 22
 Project No. 448-74-245-80878-000-000-001
 DERN SELLERS ~ Acting City ENGINEER
 WICHITA, KANSAS
 Date: _____