



BM 135.05 R.R. Spike on West Side of PP on N.E. corner of 39th St. N. & Charles St.
 BM 137.49 R.R. Spike on West Side of PP Approx. 5 ft North & 5' East of the SW
 corner of Lot 6, Block 2, Womers Sherwood Glen Addition

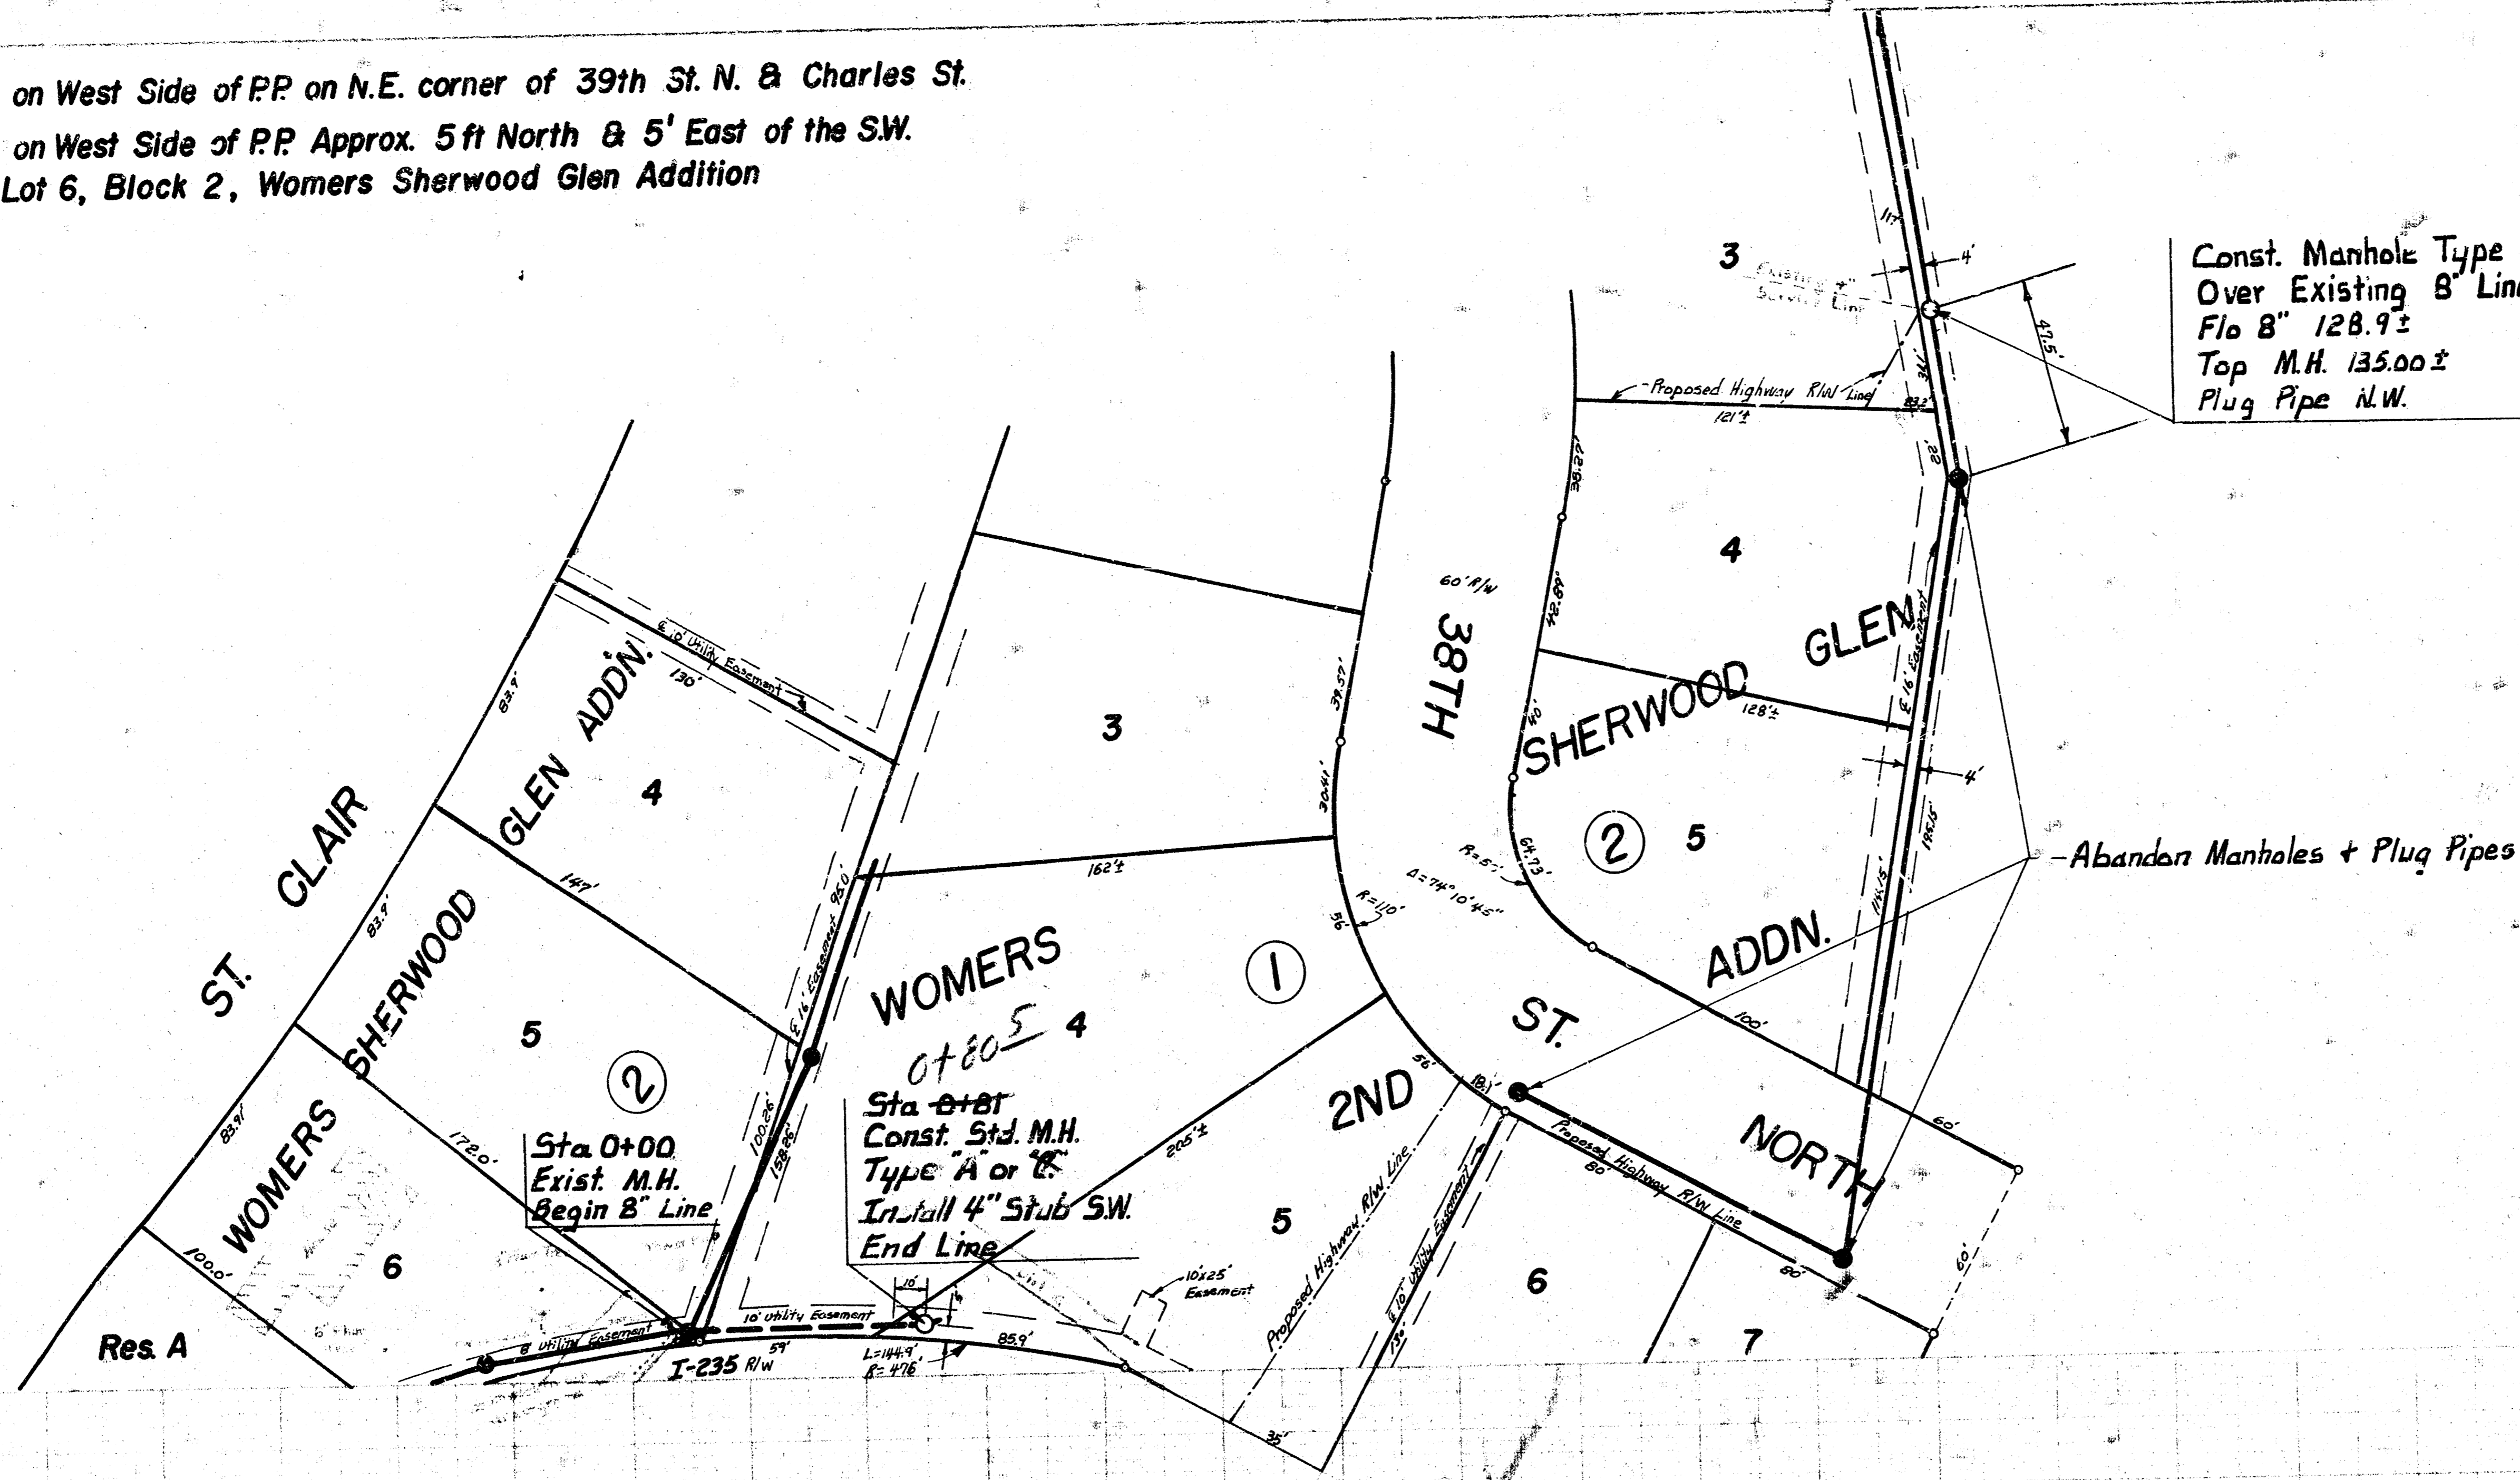

Const. Manhole Type "A" or "B" and connect 4" service line
 Over Existing 8" Line
 Flo 8" 128.9±
 Top M.H. 135.00±
 Plug Pipe N.W.

Plan Scale 1" = 40'
 Profile Scale 1" = 40' Horz.
 1" = 5' Vert.

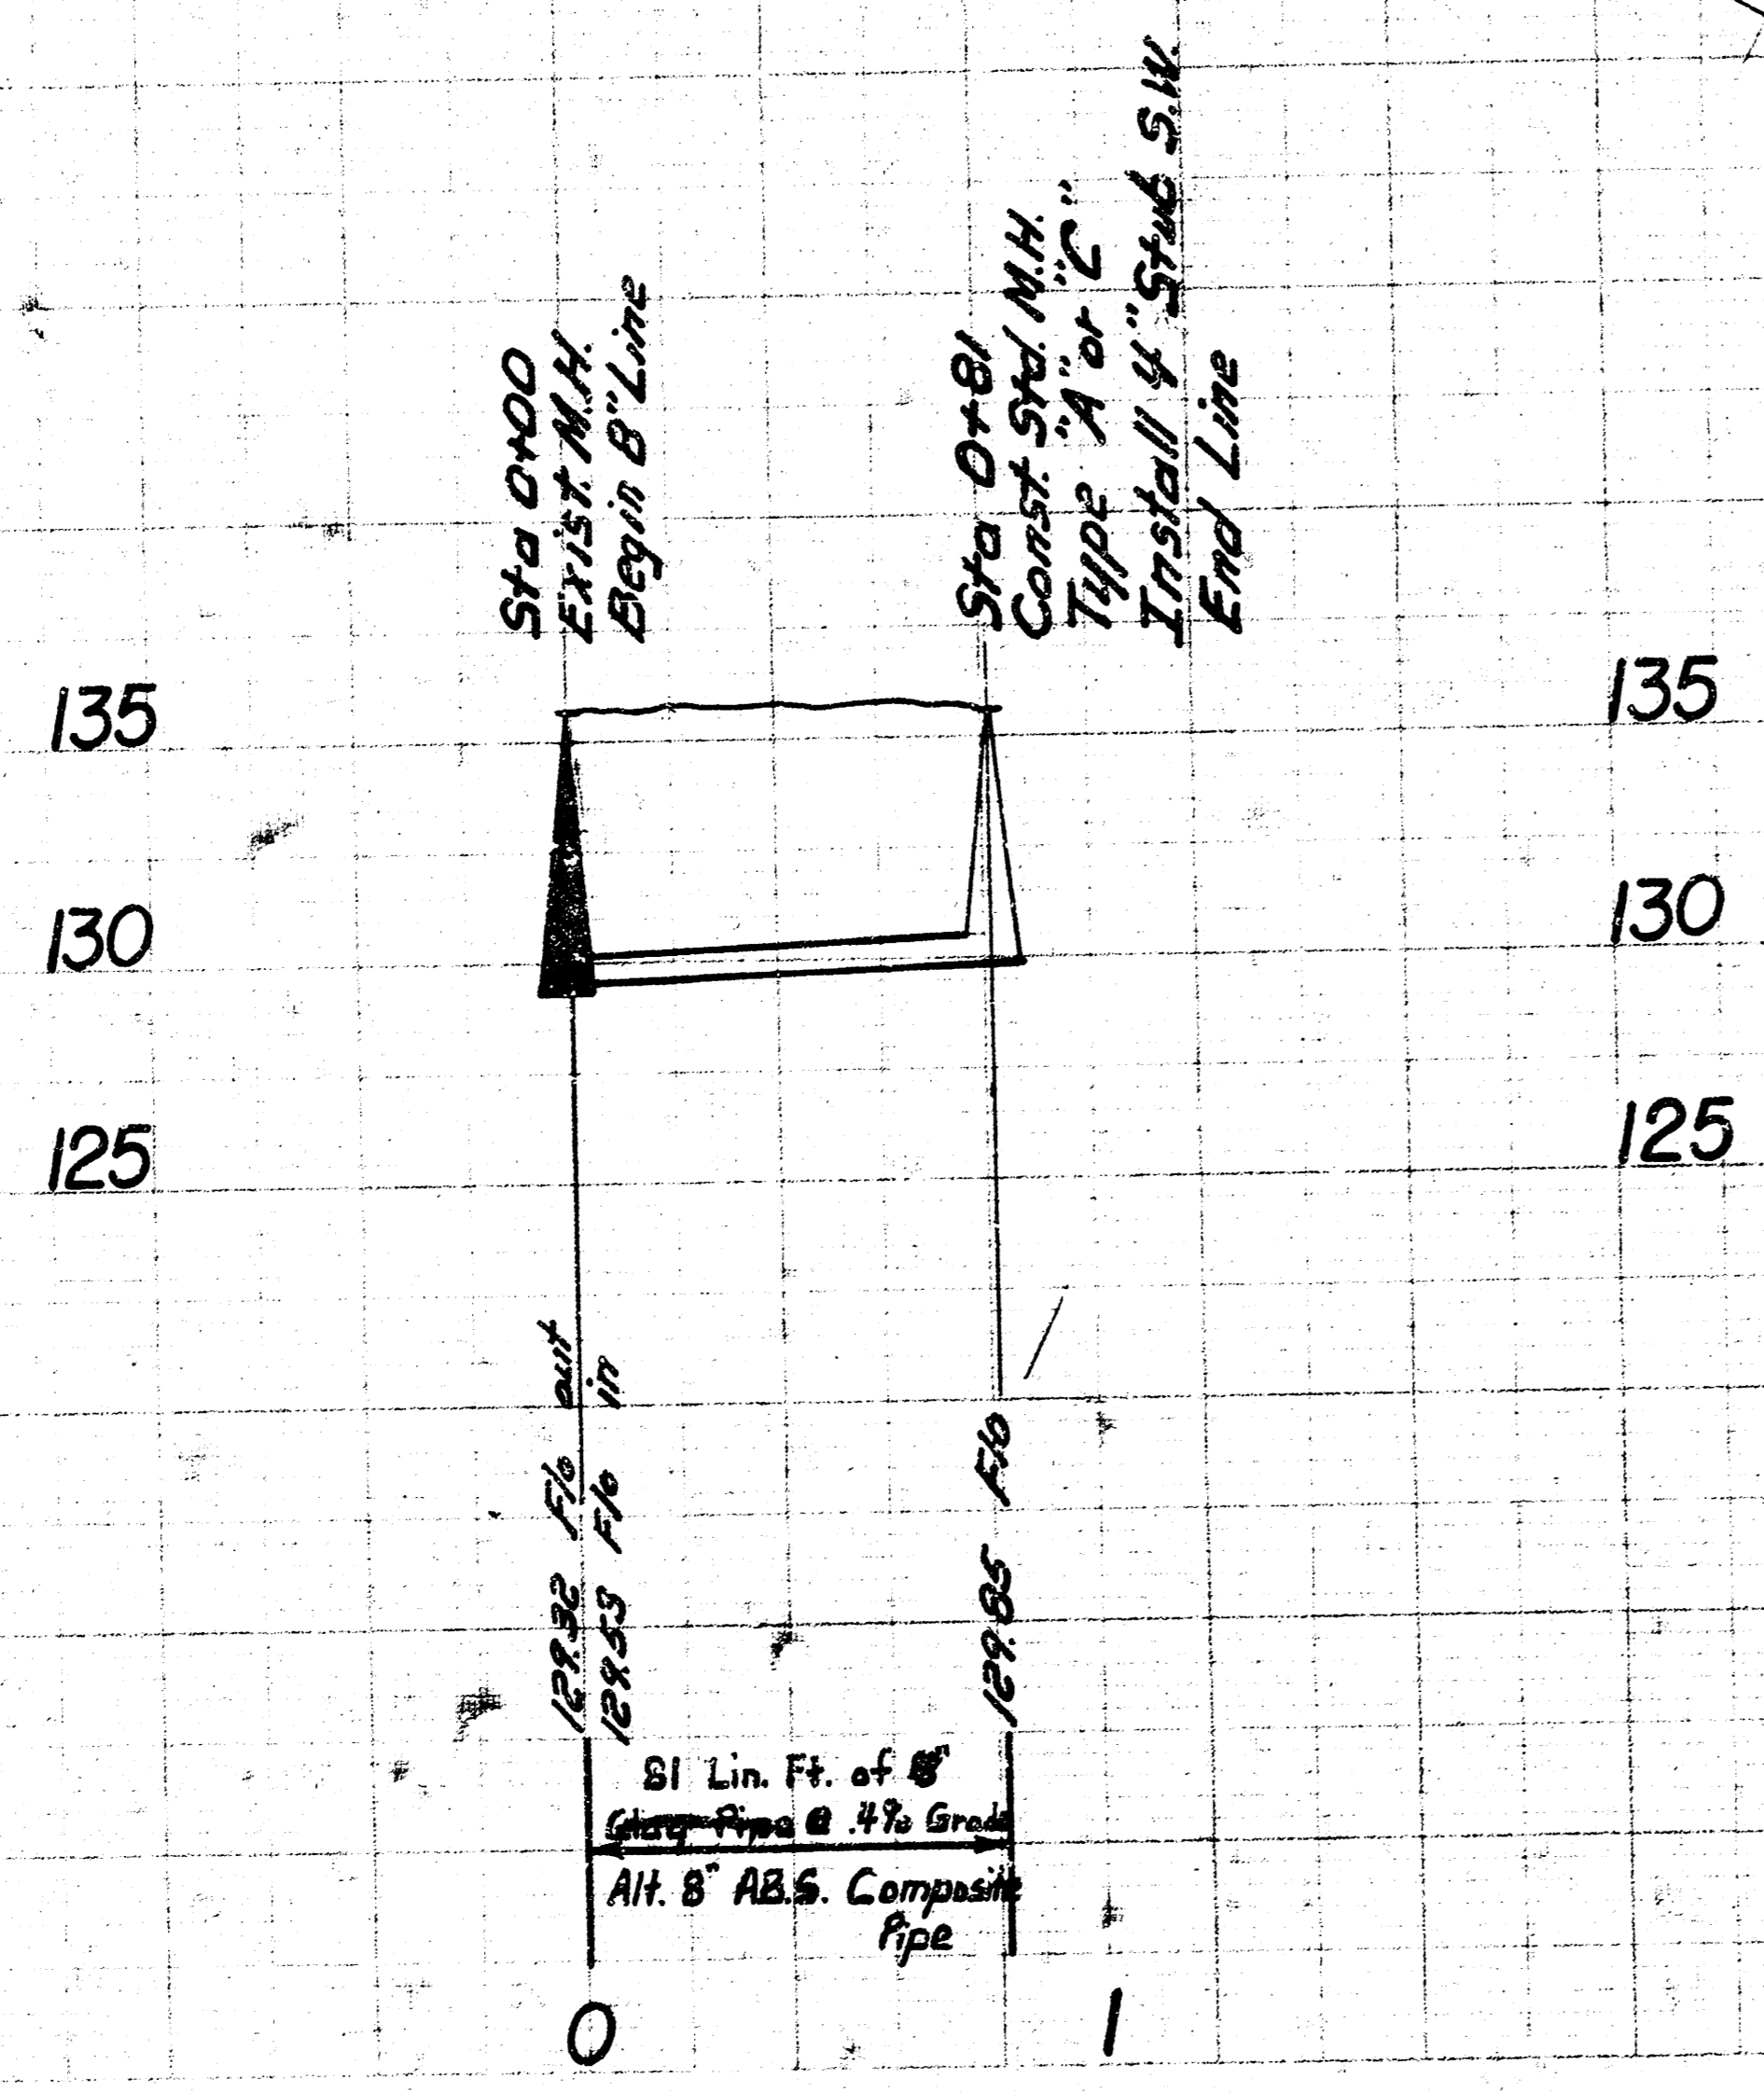

As built 4-21-78

Relocation of a portion of Lat. 29 Main 10 S.S. 22
 CITY OF WICHITA, KANSAS
 R.W. LINN CITY ENGINEER
 DATE: _____ PROJECT NO. DAKR500580

14 5 3 1 1/2