


SEWERAGE & WATERWORKS DEPARTMENT

11-82

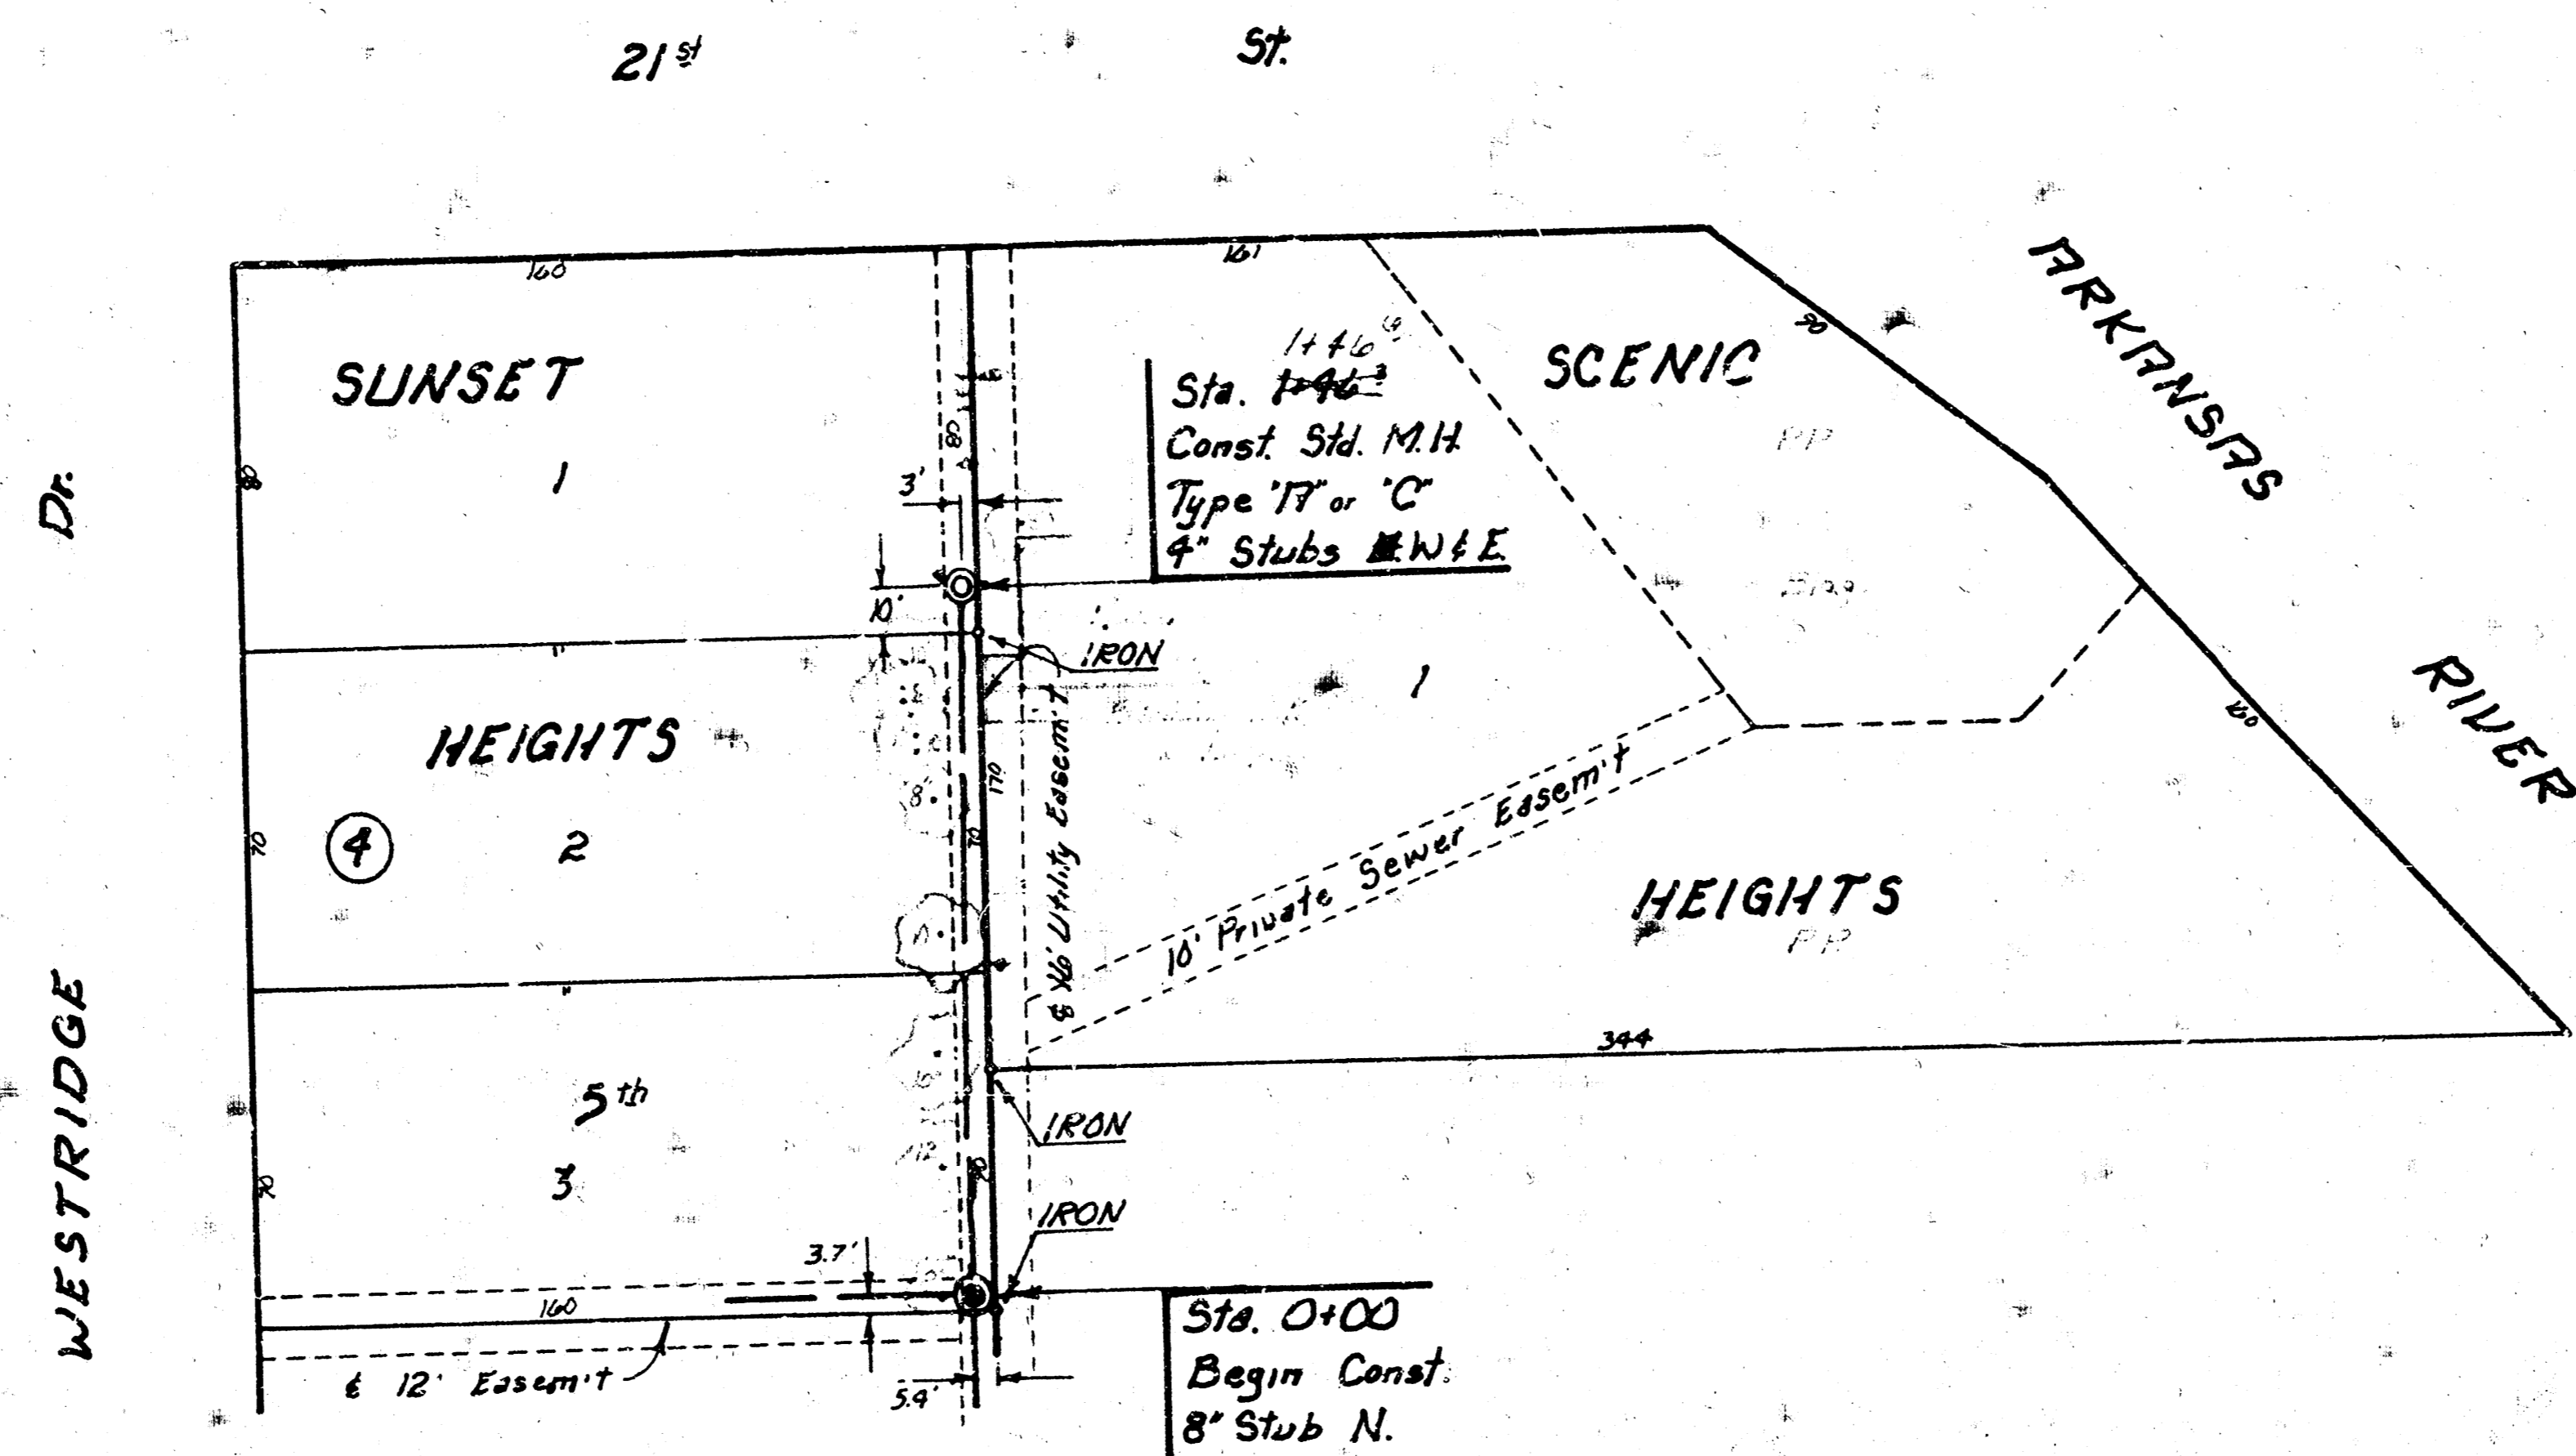


NOTE: CONTRACTORS METHODS FOR CONSTRUCTING THIS PROJECT SHALL BE SUCH THAT WILL PREVENT DAMAGE OF ANY TREES AND RETAINING WALL.

SCALE

Plan	1" = 40'
Profile	1" = 40'
Horz	1" = 40'
Vert	1" = 5'

B.M. 132.91 N.E. Cor. Can. Porch  
2117 W. RIDGE Dr.


135  
130  
125  
120

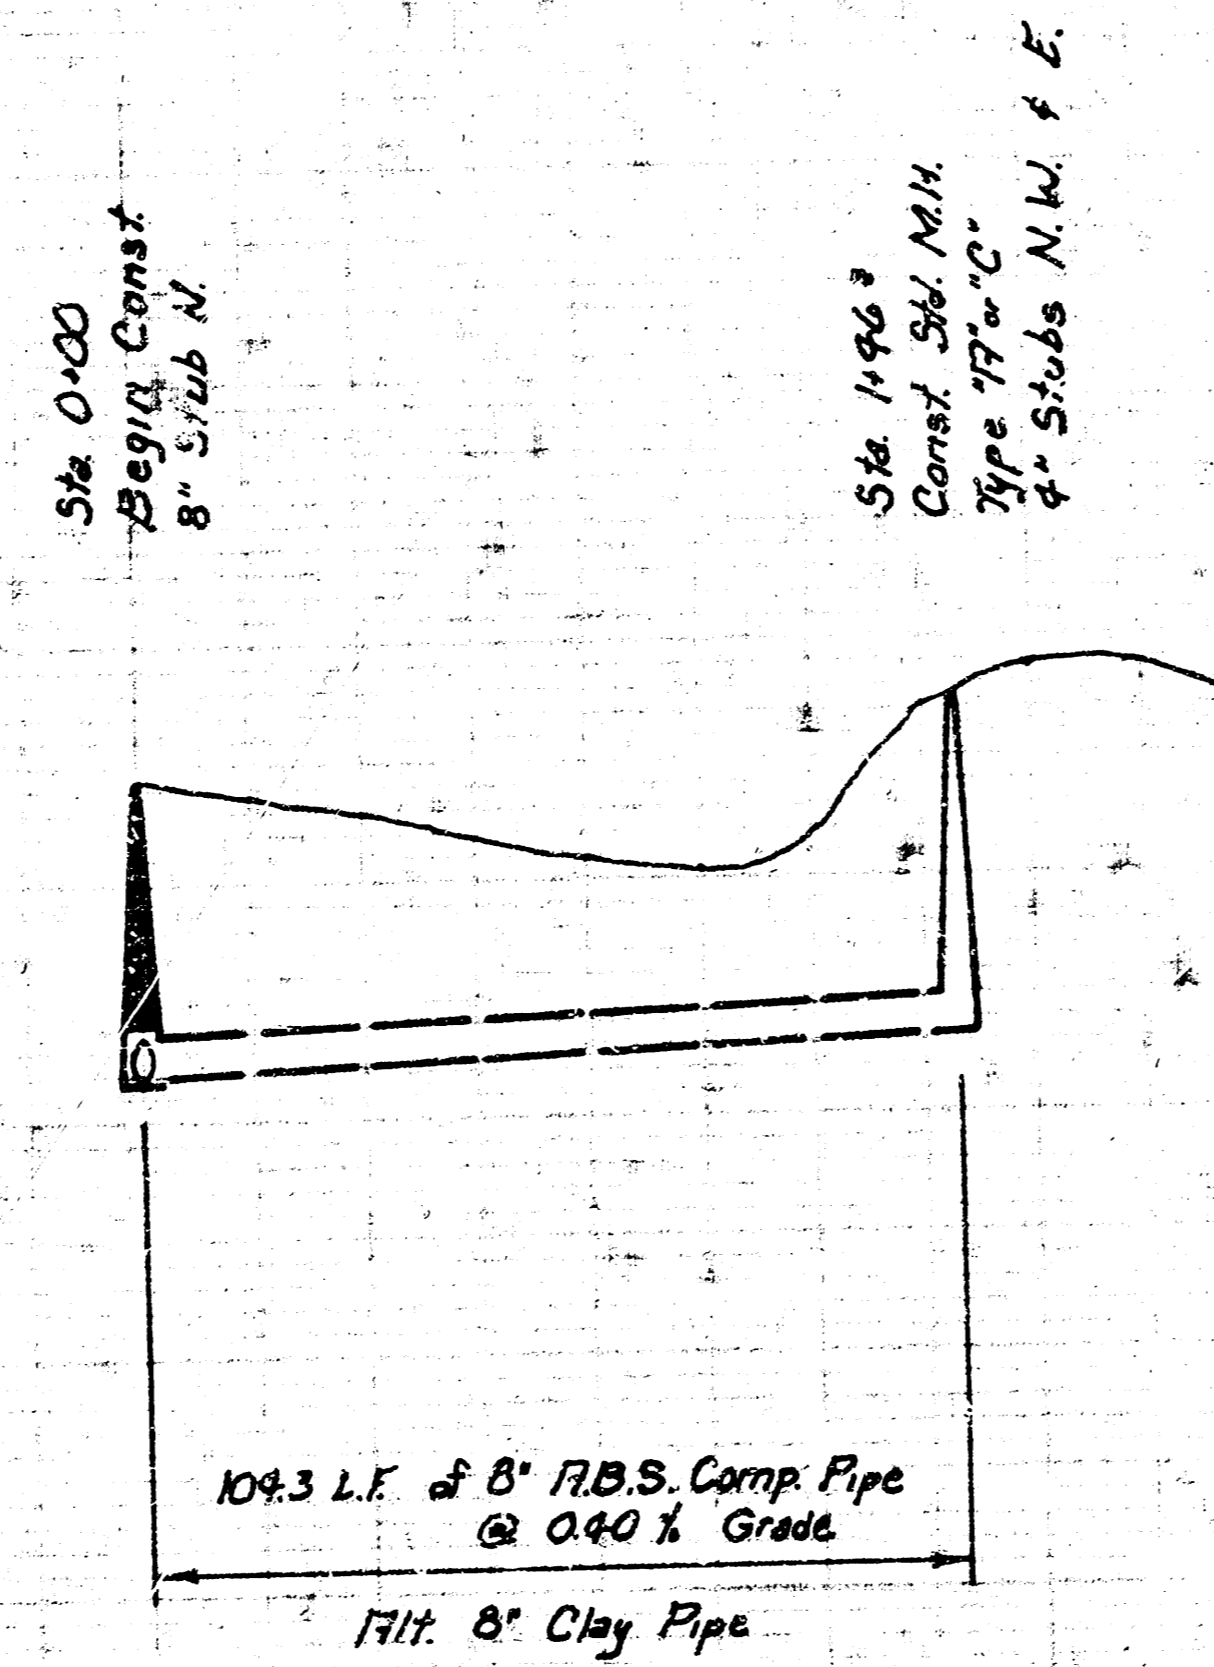

123.8' 8\"/>

120.0'

120.0'

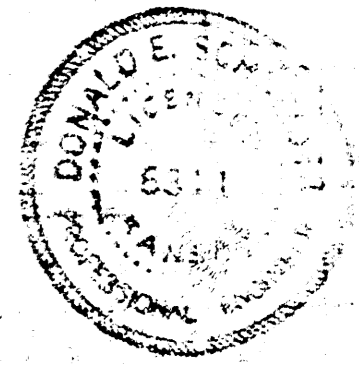

As Built  
9/20/97  
R.W. Linn

Lat. 37, Main 10, S.S. No. 22  
City of WICHITA, KANSAS  
R.W. LINN CITY ENGINEER  
PROJ. NO. 468-76-245-80732-000-000-001  
DATE: