
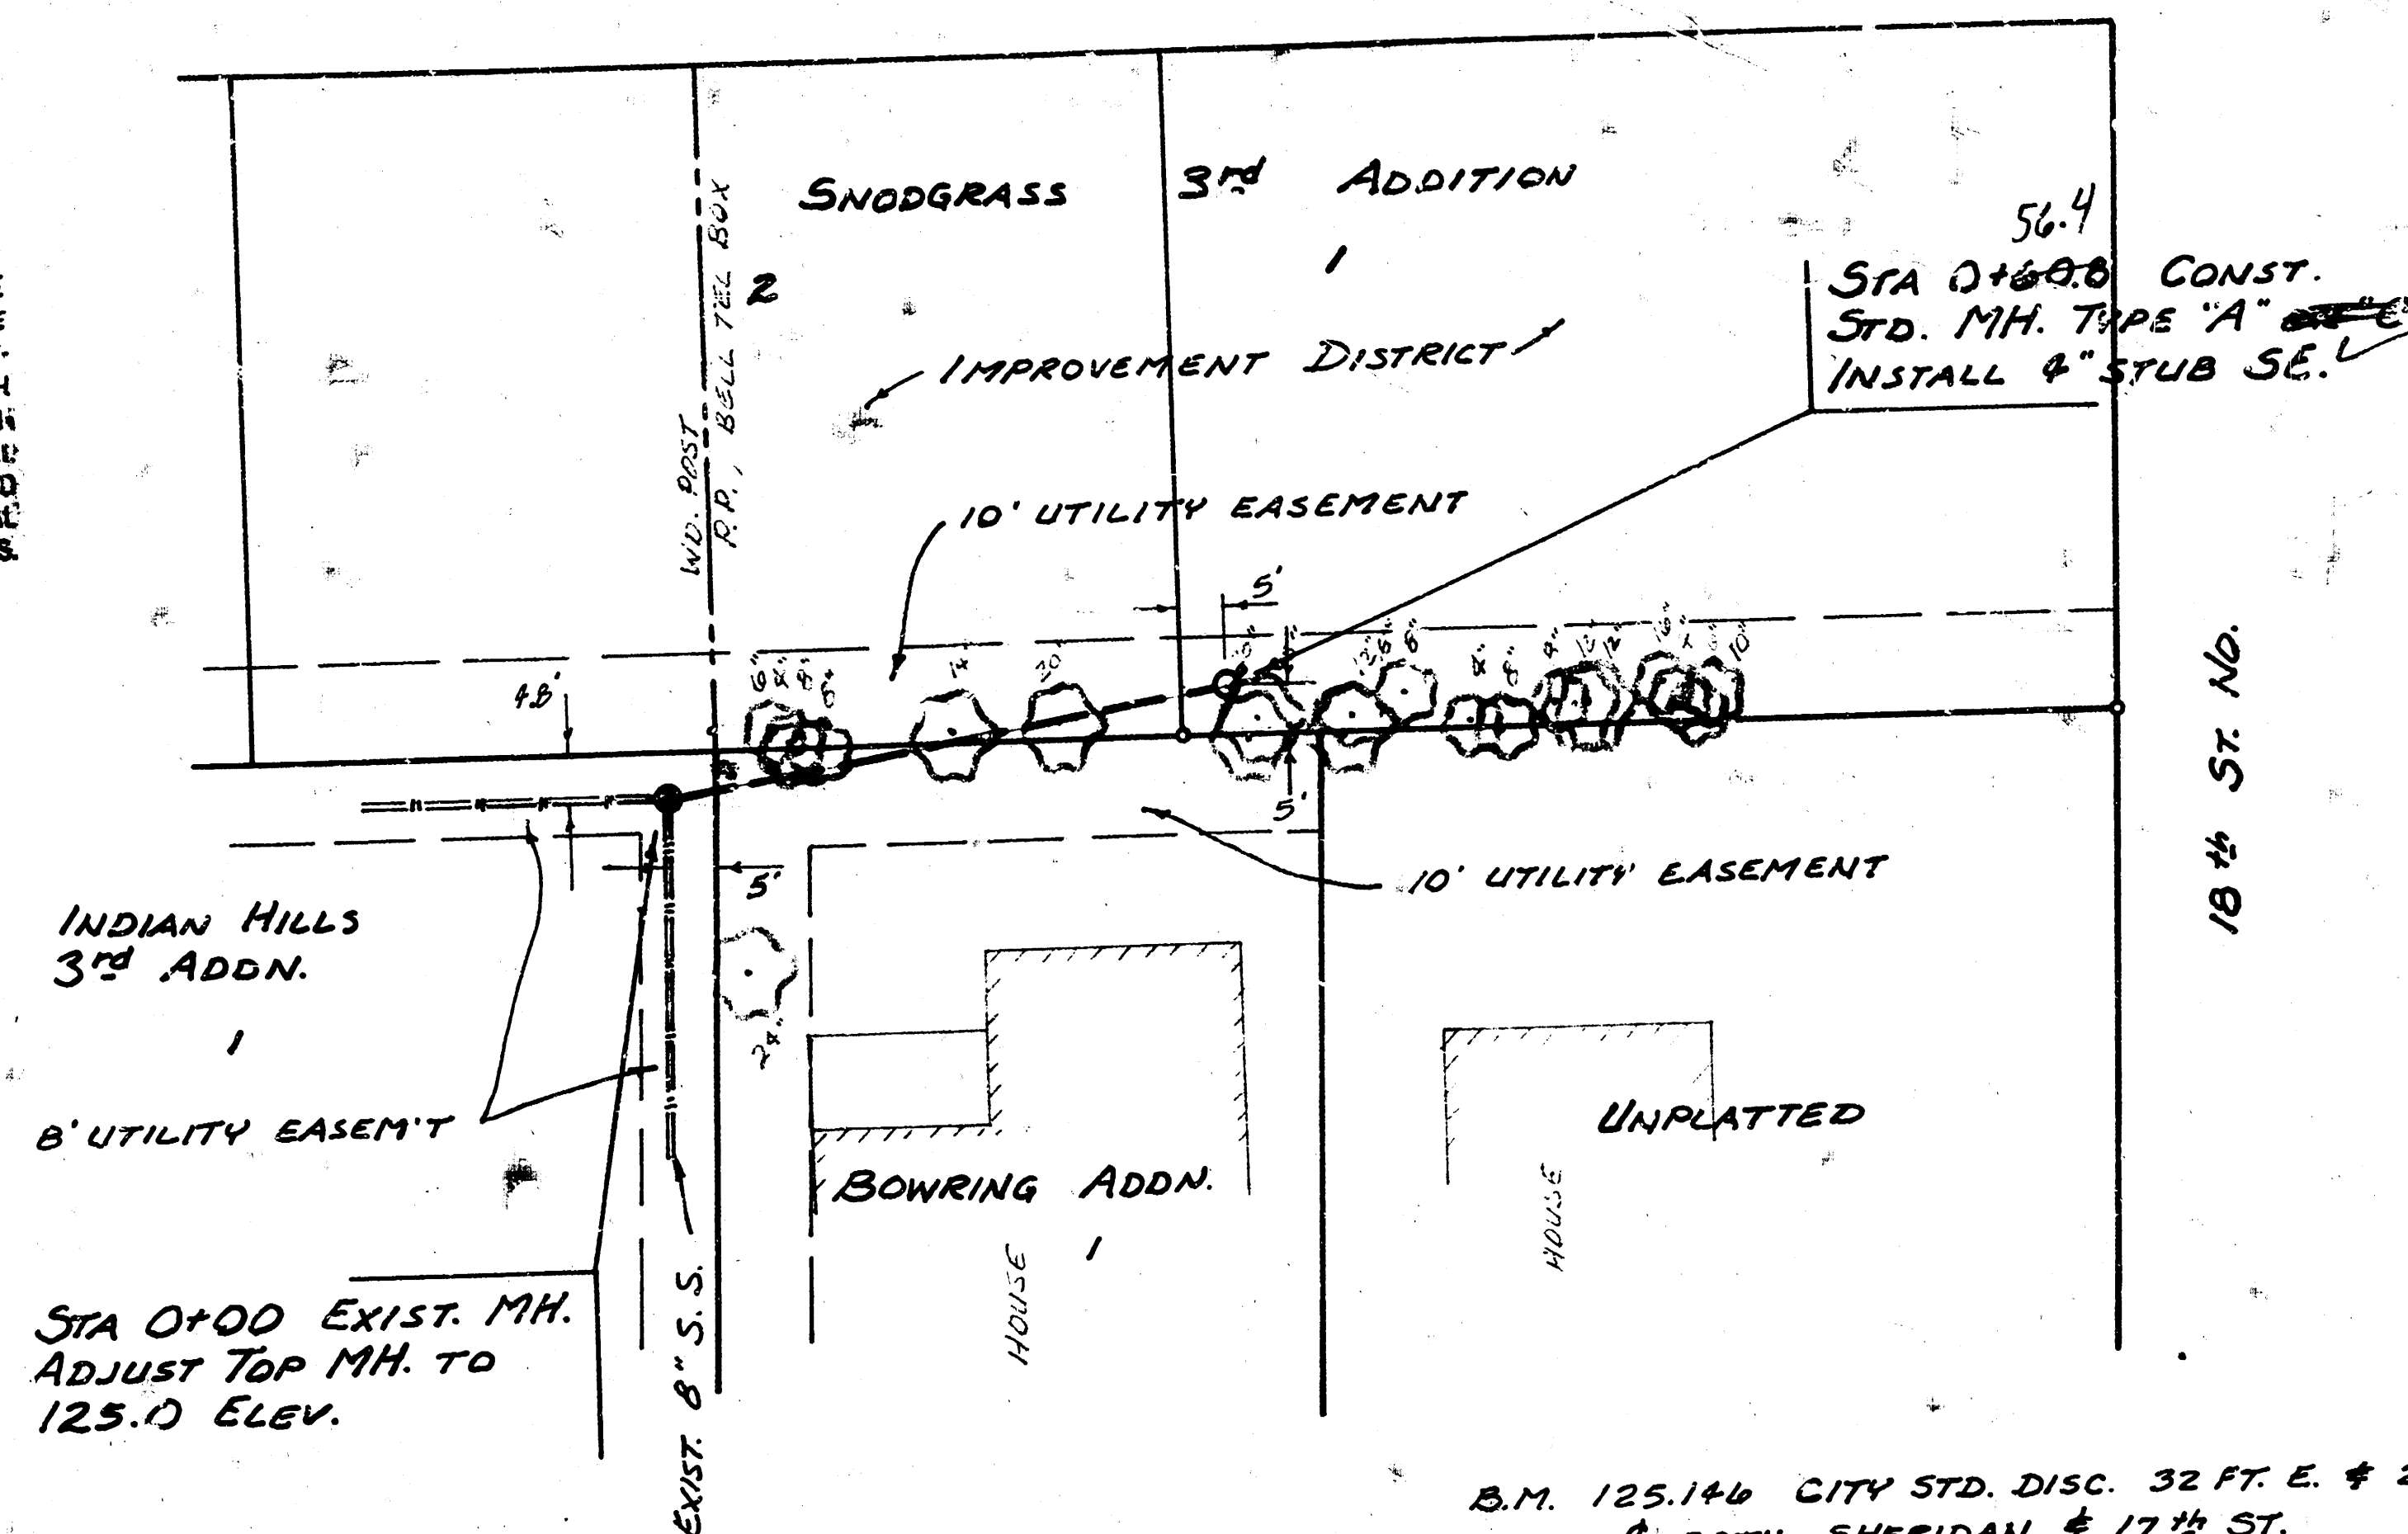


SCALE PLAN 1" = 20'
 PROFILE 1" = 20' HORIZ
 1" = 5' VERT.

**CAUTION
 UNDERGROUND
 UTILITIES**
 Please check with K & K or
 Southwestern Bell
 Telephone Co. for Location



THE CONTRACTOR SHALL BE RESPONSIBLE
 FOR PRESERVING PROPERTY IRONS. THE
 CONTRACTOR SHALL BE REQUIRED TO RE-
 ESTABLISH ANY PROPERTY IRONS WHICH
 ARE DAMAGED OR DESTROYED BY HIS CON-
 STRUCTION OPERATIONS. SUCH IRONS SHALL
 BE RE-ESTABLISHED BY A LICENSED LAND
 SURVEYOR OR A LICENSED PROFESSIONAL
 ENGINEER IN ACCORDANCE WITH STATE LAWS.

PLEASANTVIEW CIRCLE

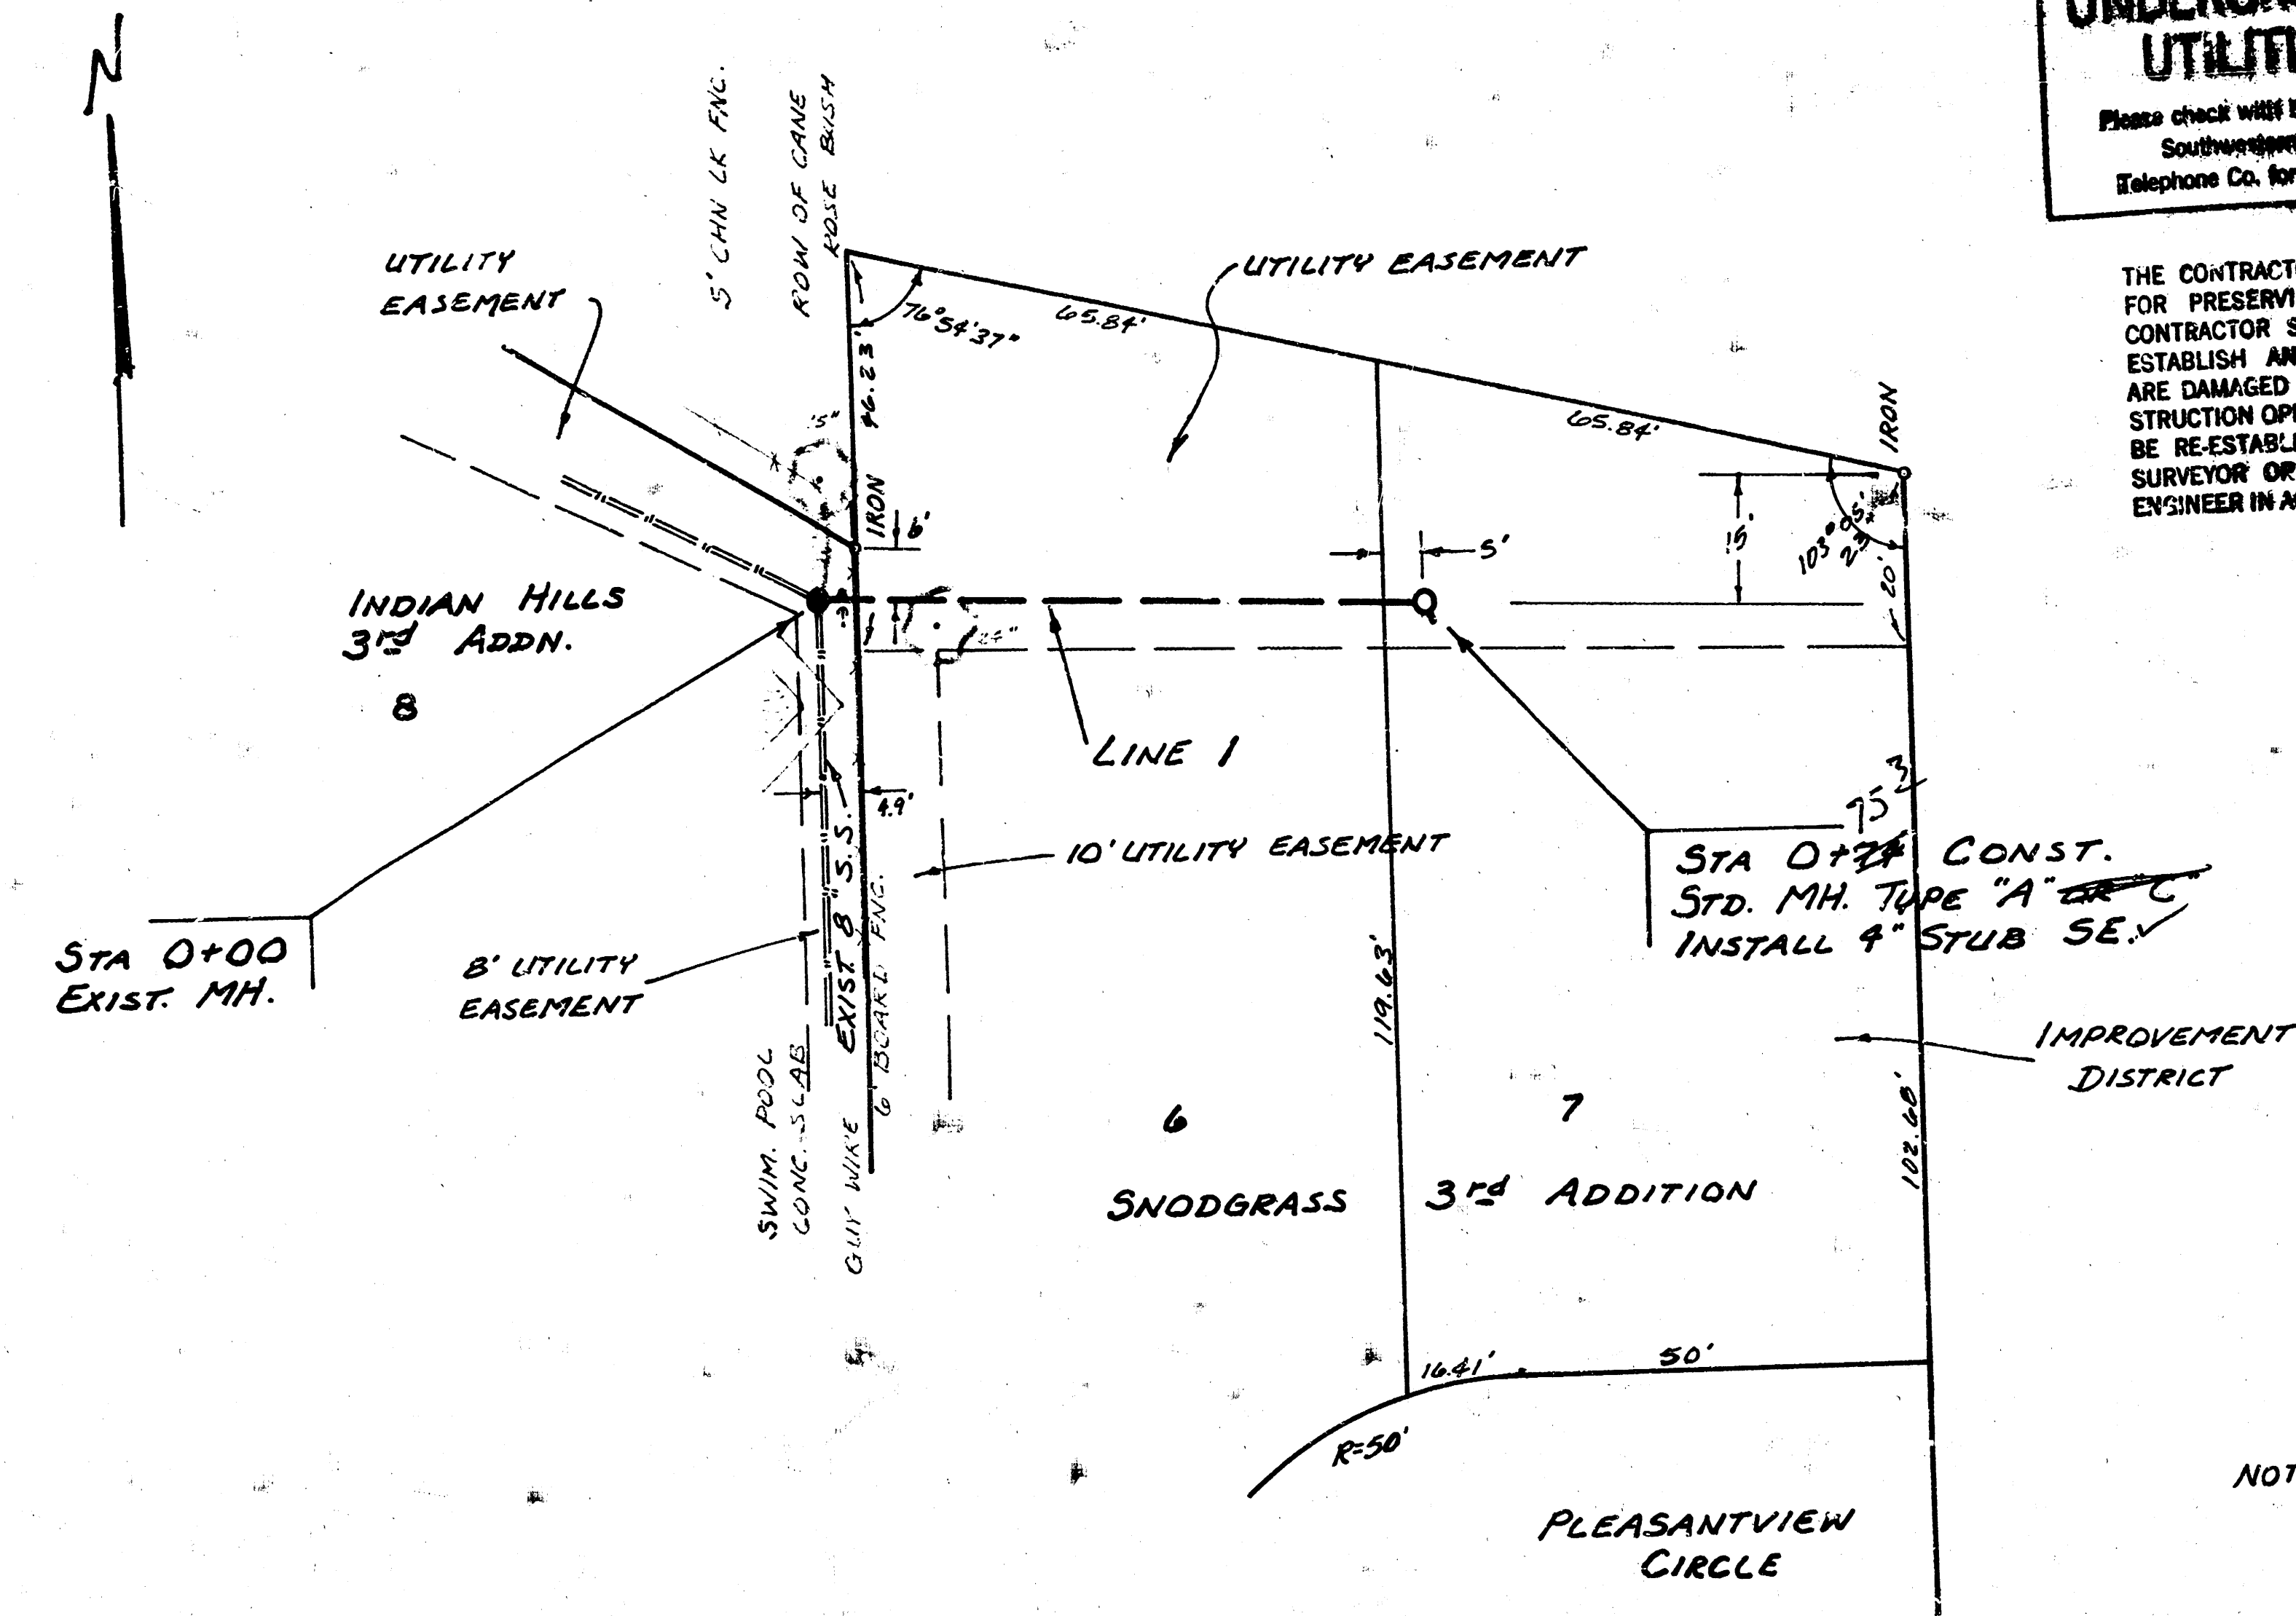


NOTE: Field Engineer shall approval removal
 any tree on this Project. Contractor
 shall coordinate removal of trees with
 the property owners and Field Engineer.

B.M. 125.146 CITY STD. DISC. 32 FT. E. & 23.5 FT. S.
 OF E. BOTH SHERIDAN & 17TH ST.
 B.M. 124.79 R.R. SPIKE W. FACE TRANSFORMER P.P.
 AT NW CORNER 18TH ST. AND PLEASANTVIEW.

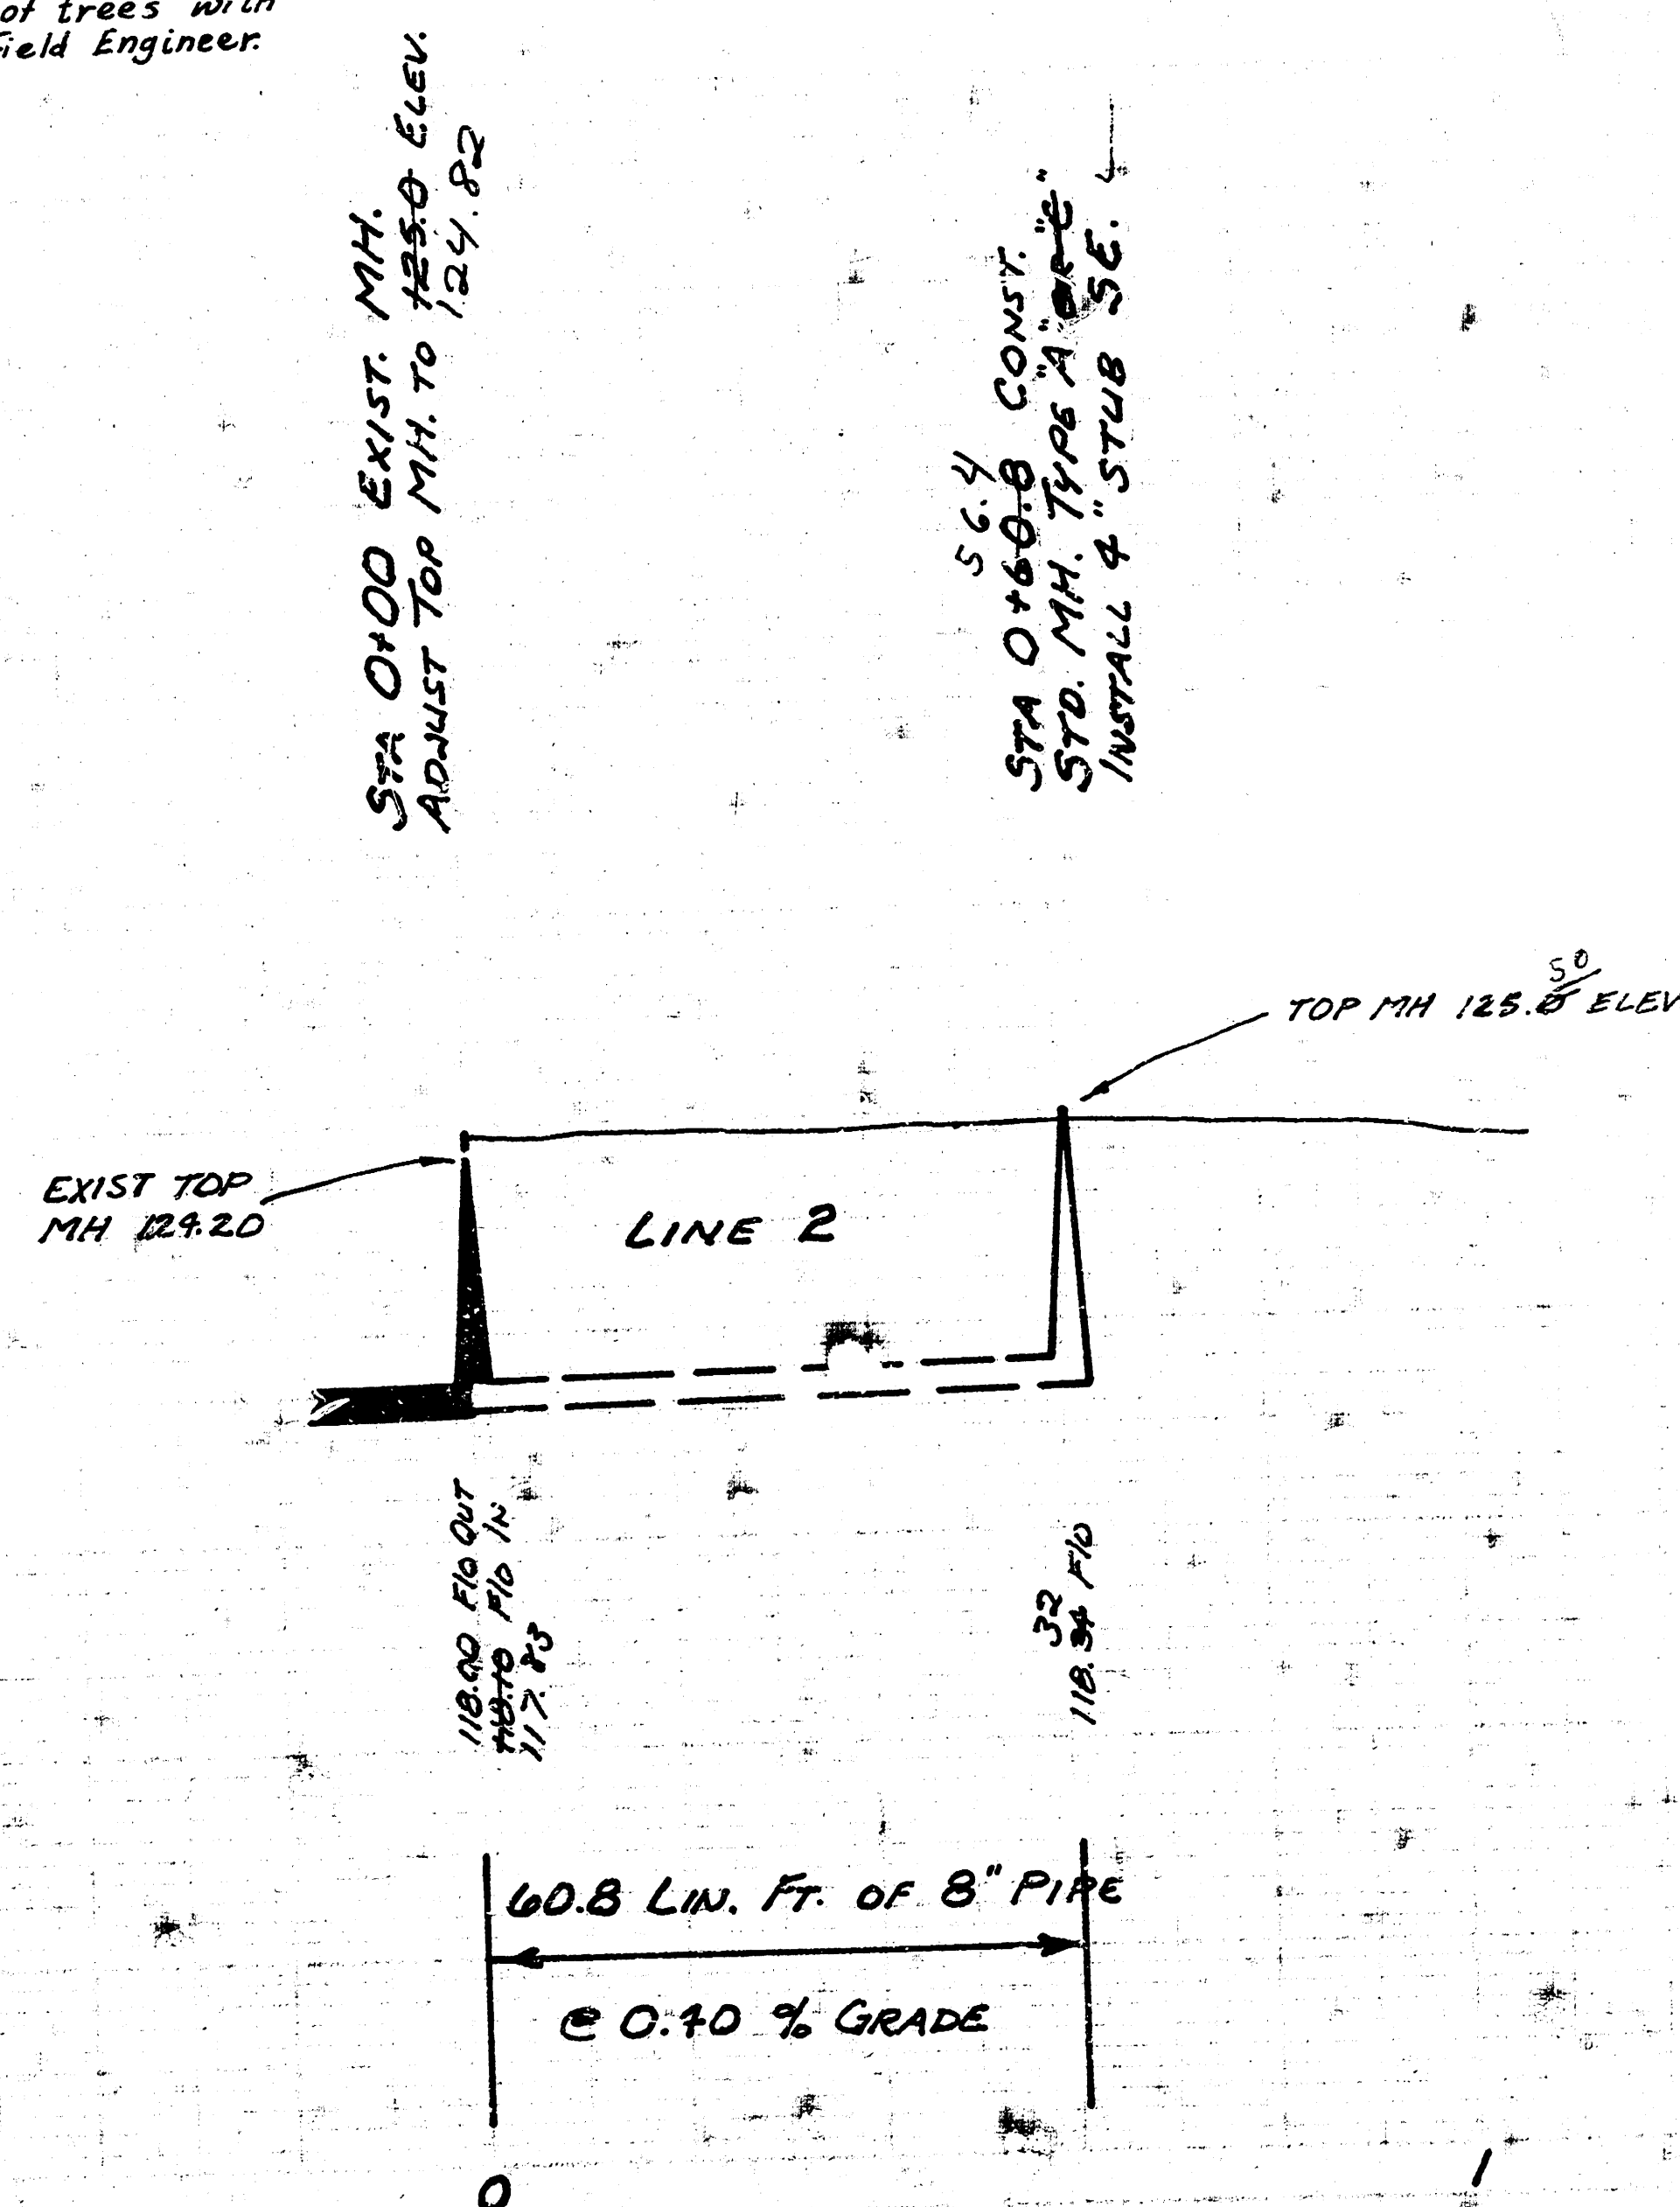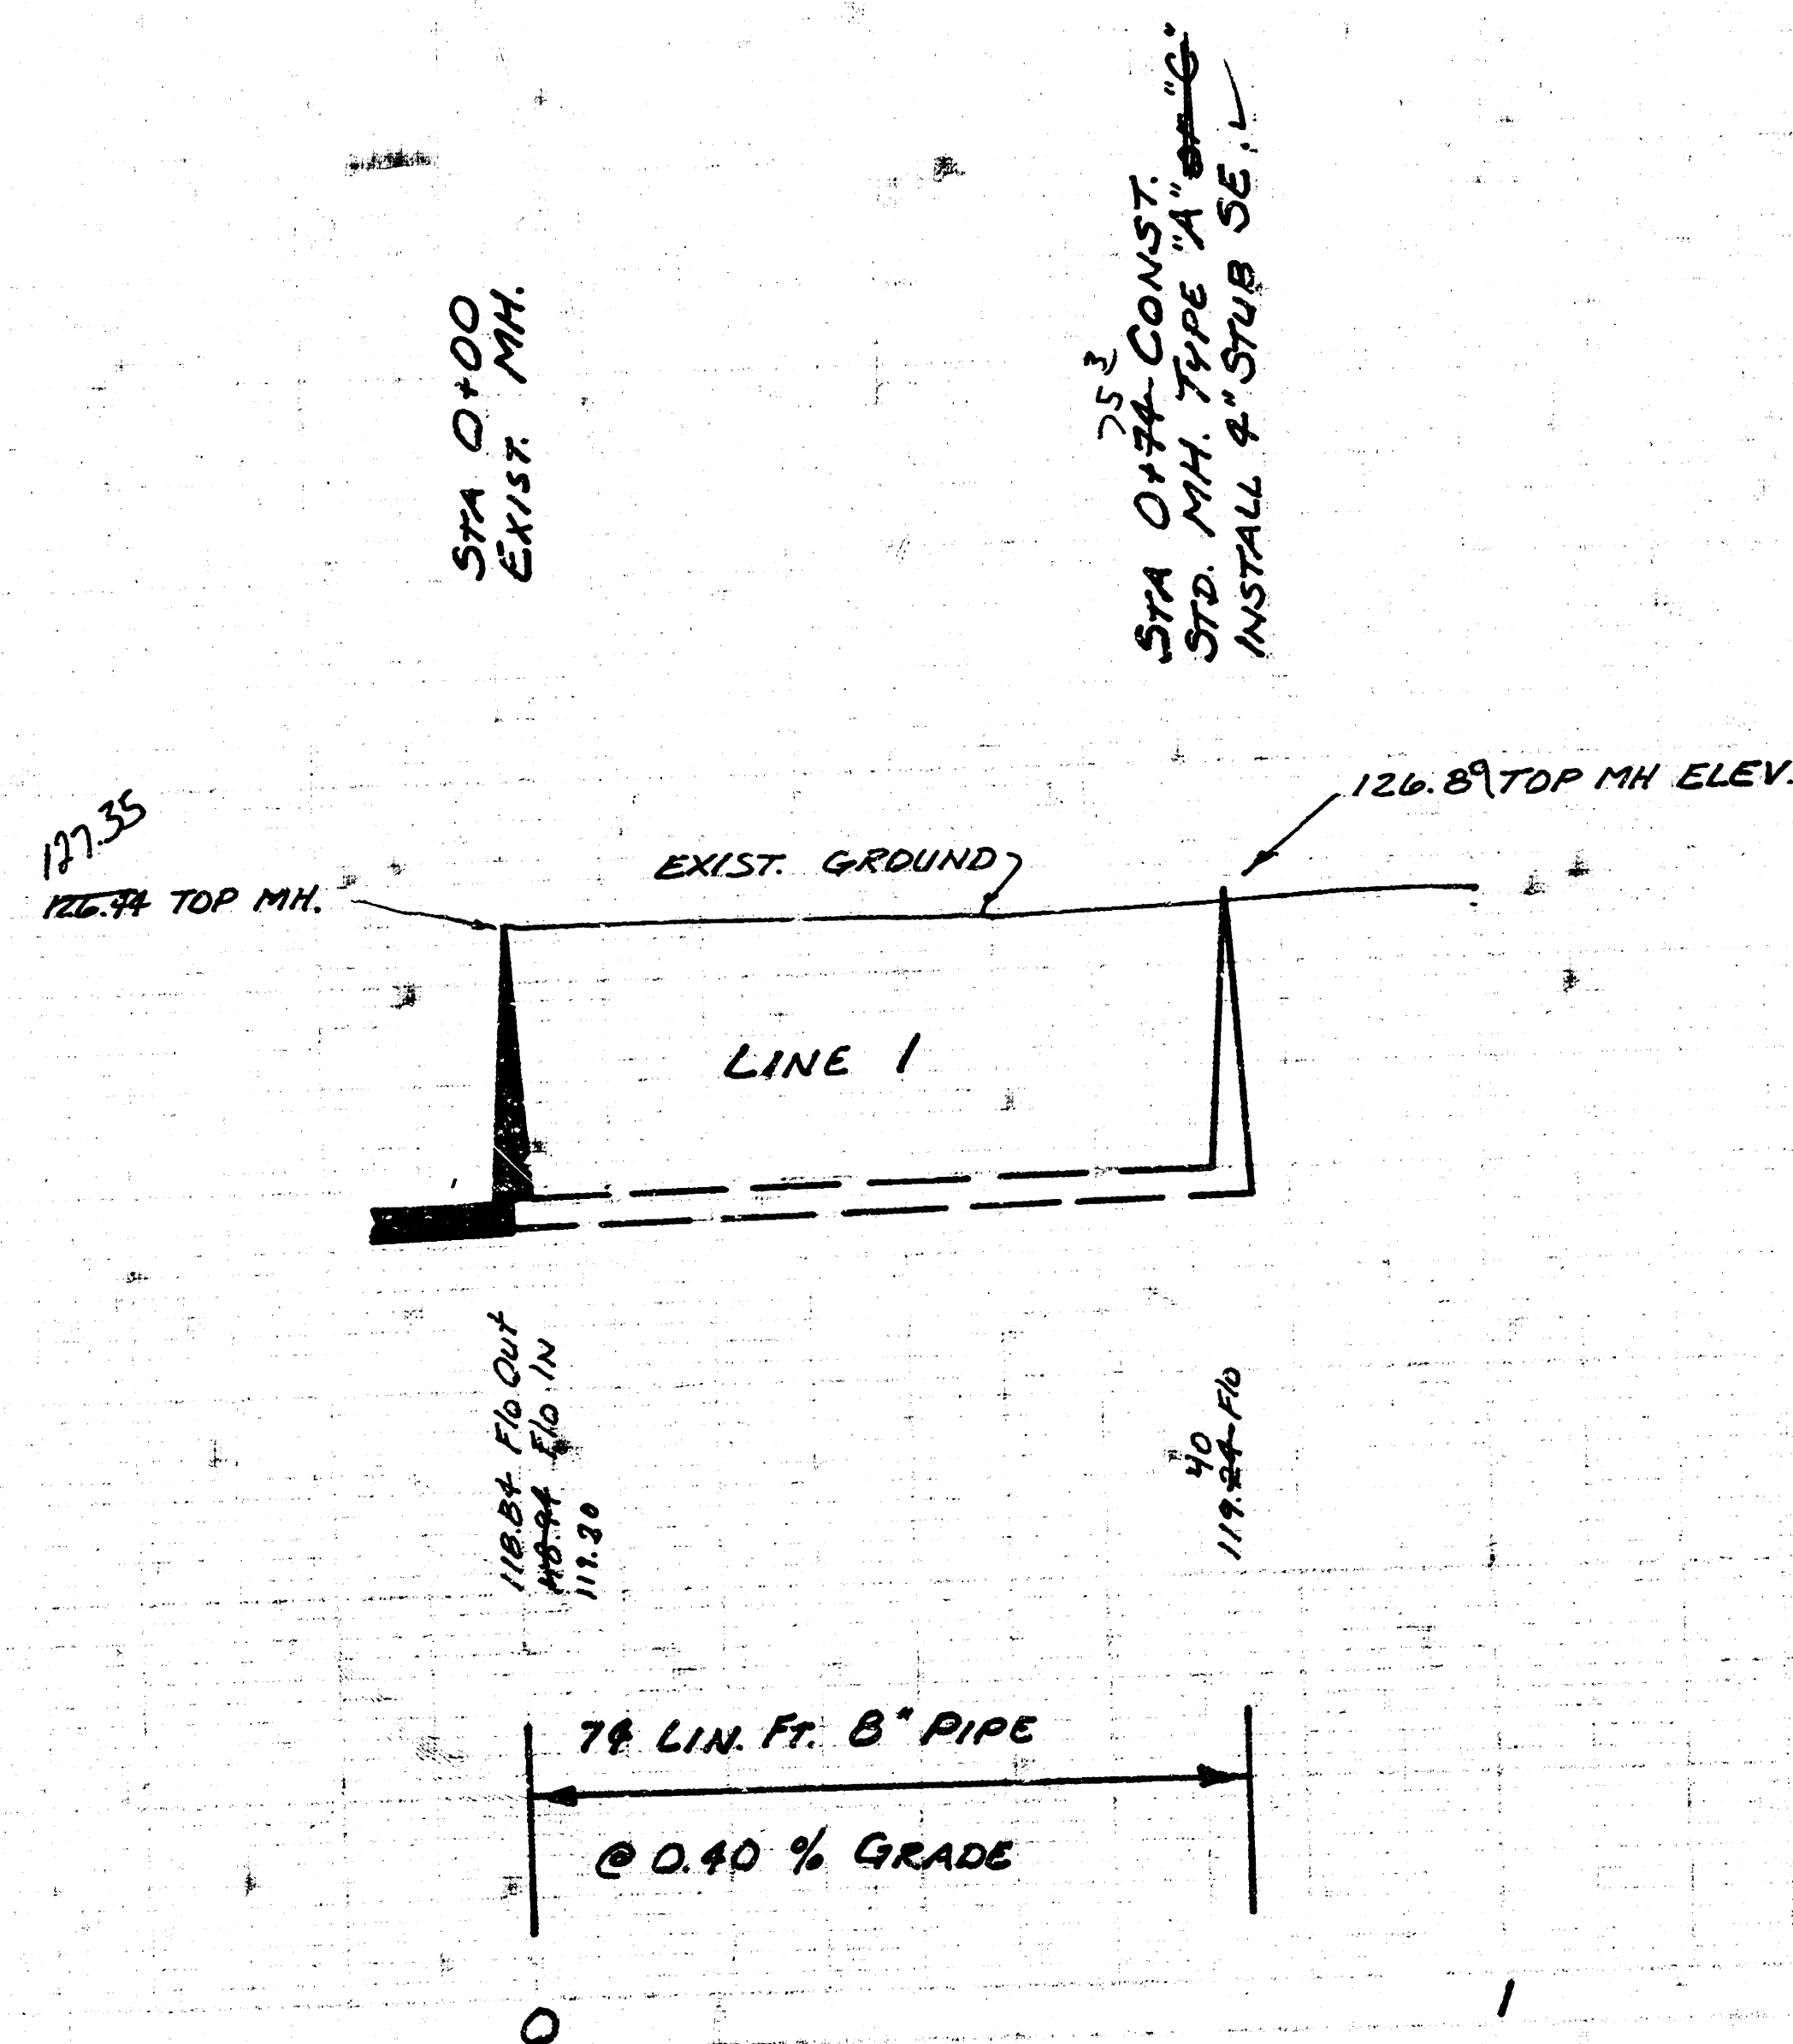

As Built
 13-83
 J.S.

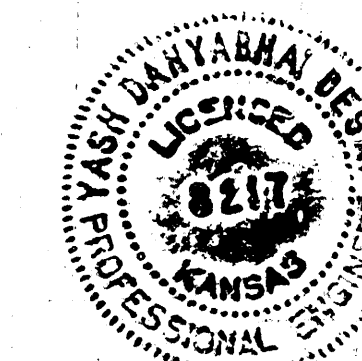

PROJECT DESCRIPTION	
LAT 38, MAIN 10, S.S. NO. 22	
PROJECT NUMBER 468-76-245-80858-000-000-001	
BOOK NO. DCD-MB	APPROVED BY
DRAWN BY LOOMIS	DATE
CITY OF WICHITA DEPARTMENT OF ENGINEERING	
DIRECTOR OF ENCLITY ENGINEER R. W. BRUGGEMAN	SCALE 1/4"