


*4
B. M. 110.27 R. R. Spk. N. face R.R.
30'± E. of EL Kessler 30'±
S. of South Line West Warehouse
Addition.

D. L. K.
J. H. W.
PLAN CHECKED 1/13



Plan Scale 1" = 40'
Profile Scale 1" = 40' Horiz.
1" = 5' Vert.

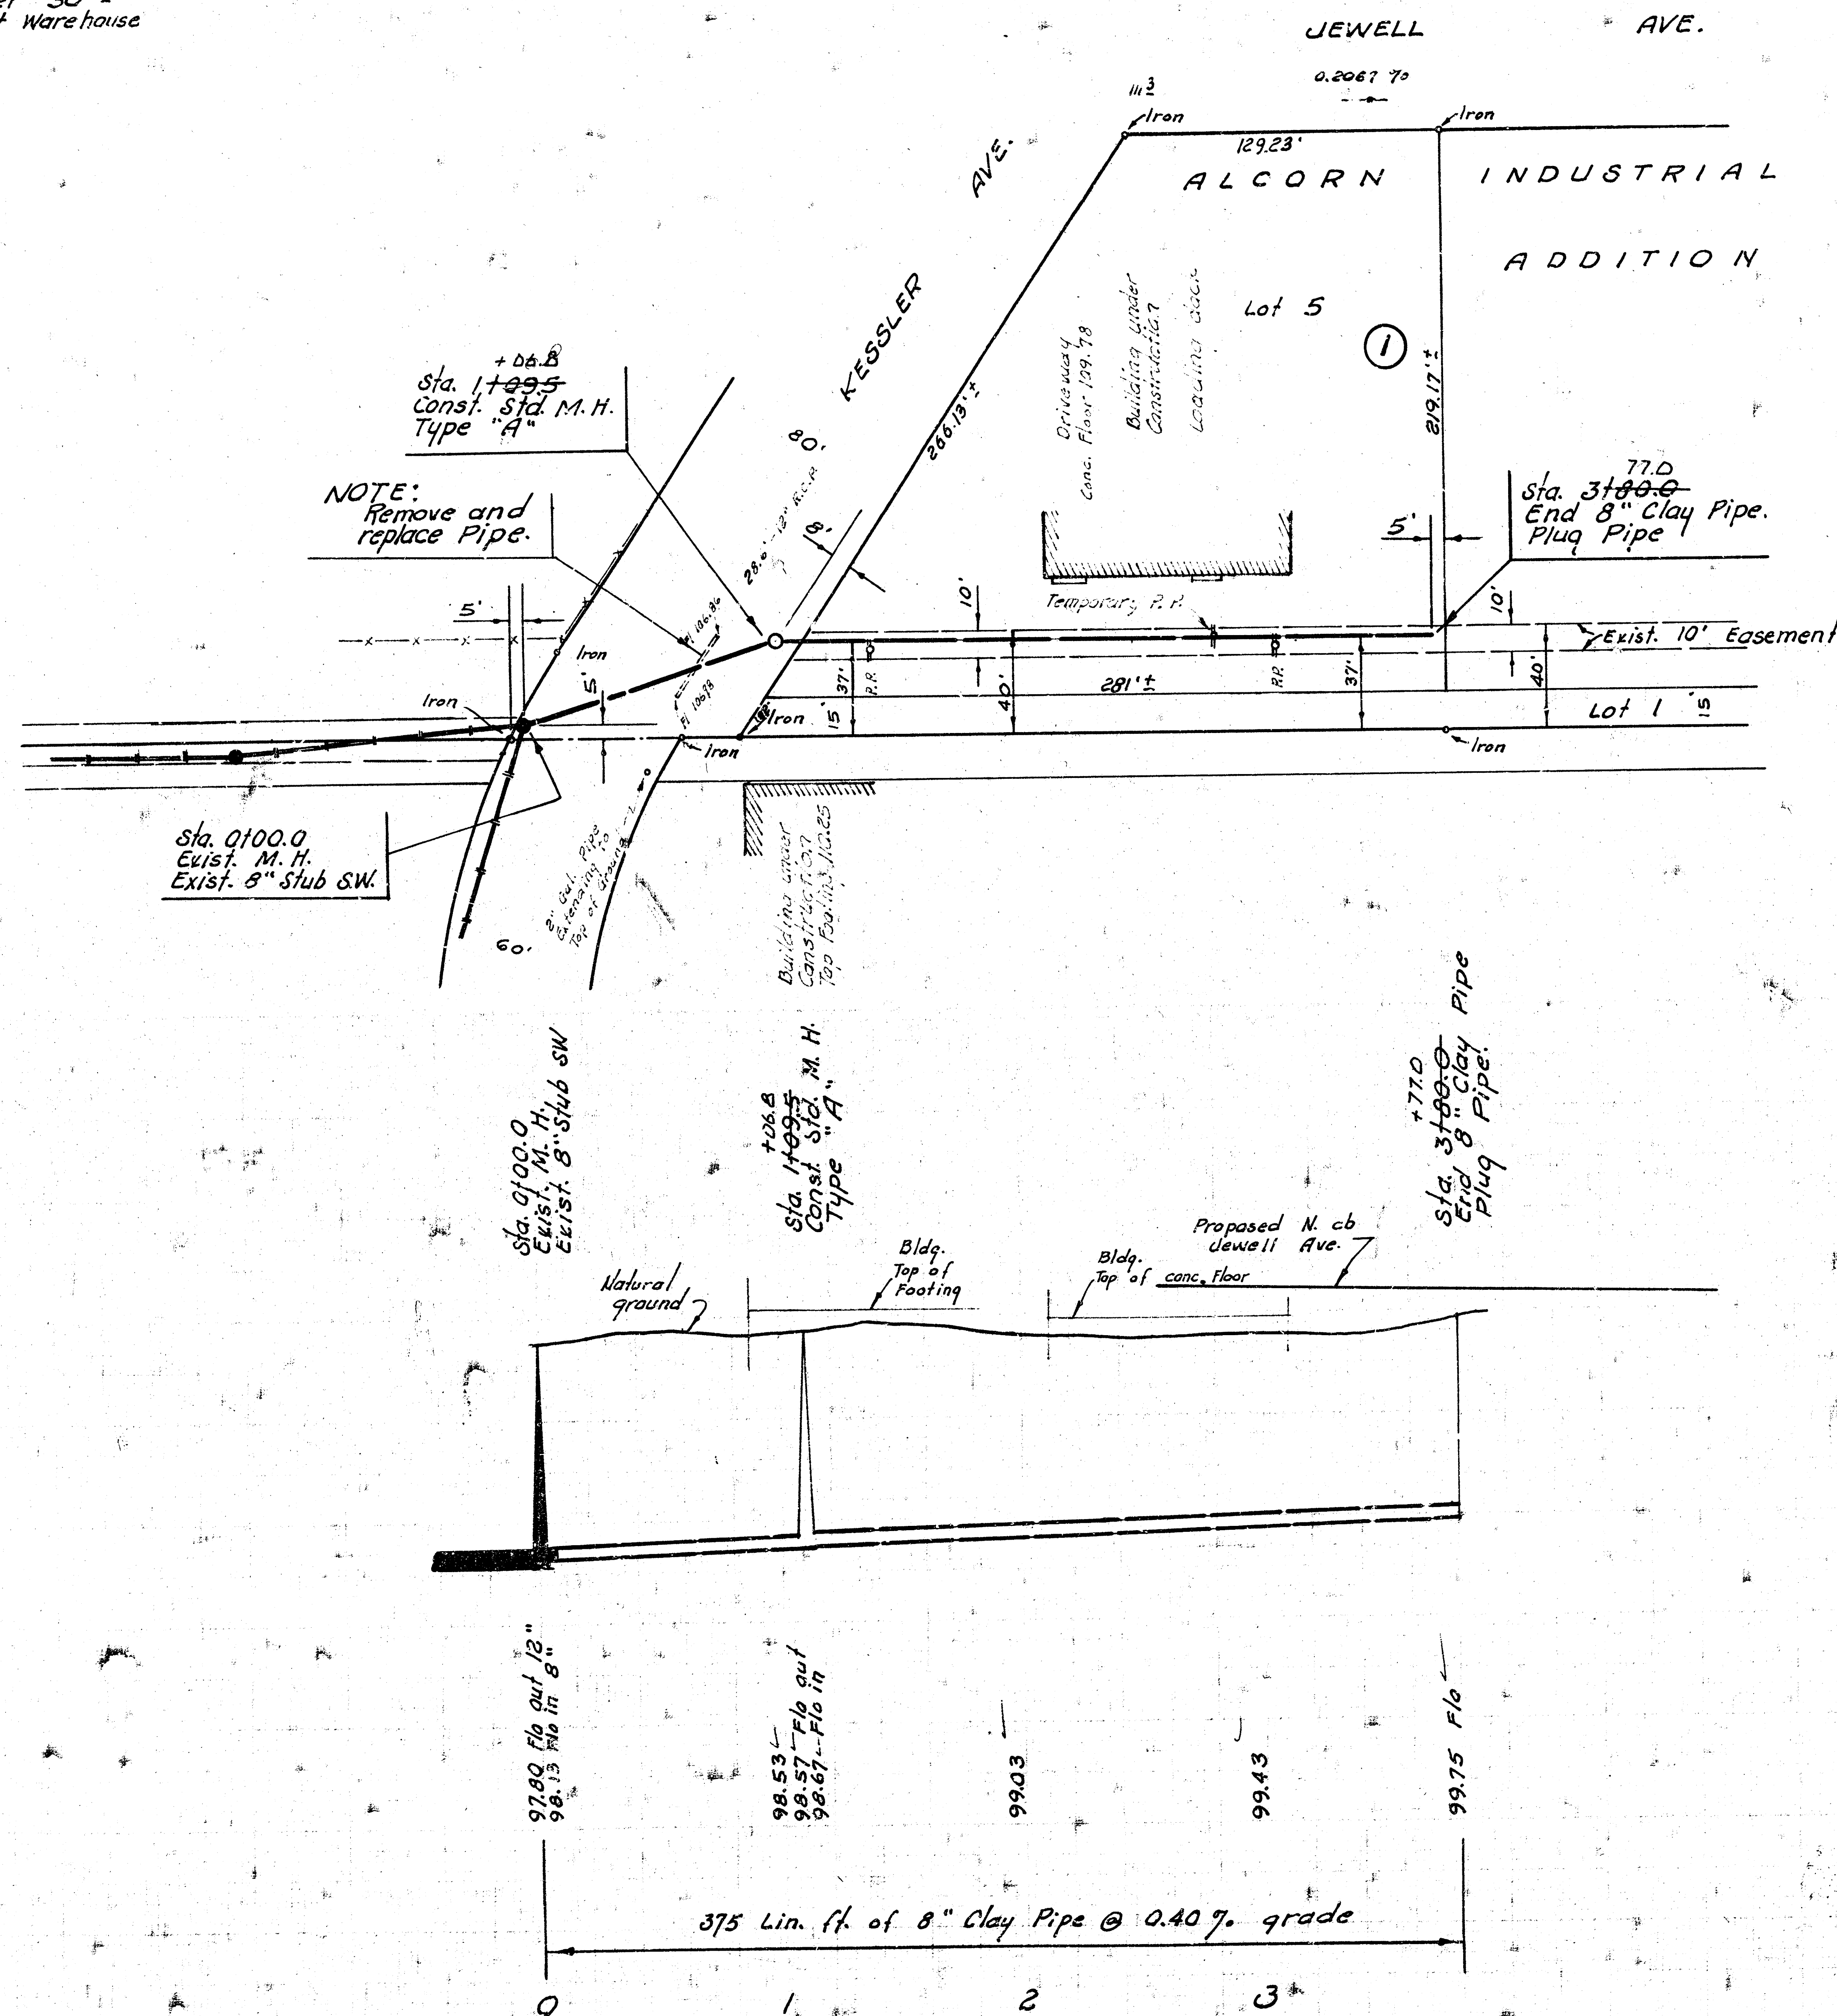

"As Built" Final Measurements L.H.-78

LAT. 6 MAIN 14, S.S. NO. 22
CITY OF WICHITA, KANSAS
R. W. LINN — CITY ENGINEER
NOV. 1972 PROJECT NO. DBKL572060

FILMED FROM THE BEST