



#4
B. M. 110.27 R.R. Spk. N. face R.P.
30'± E. of EL Kessler 30'±
S. of South Line West Warehouse
Addition.

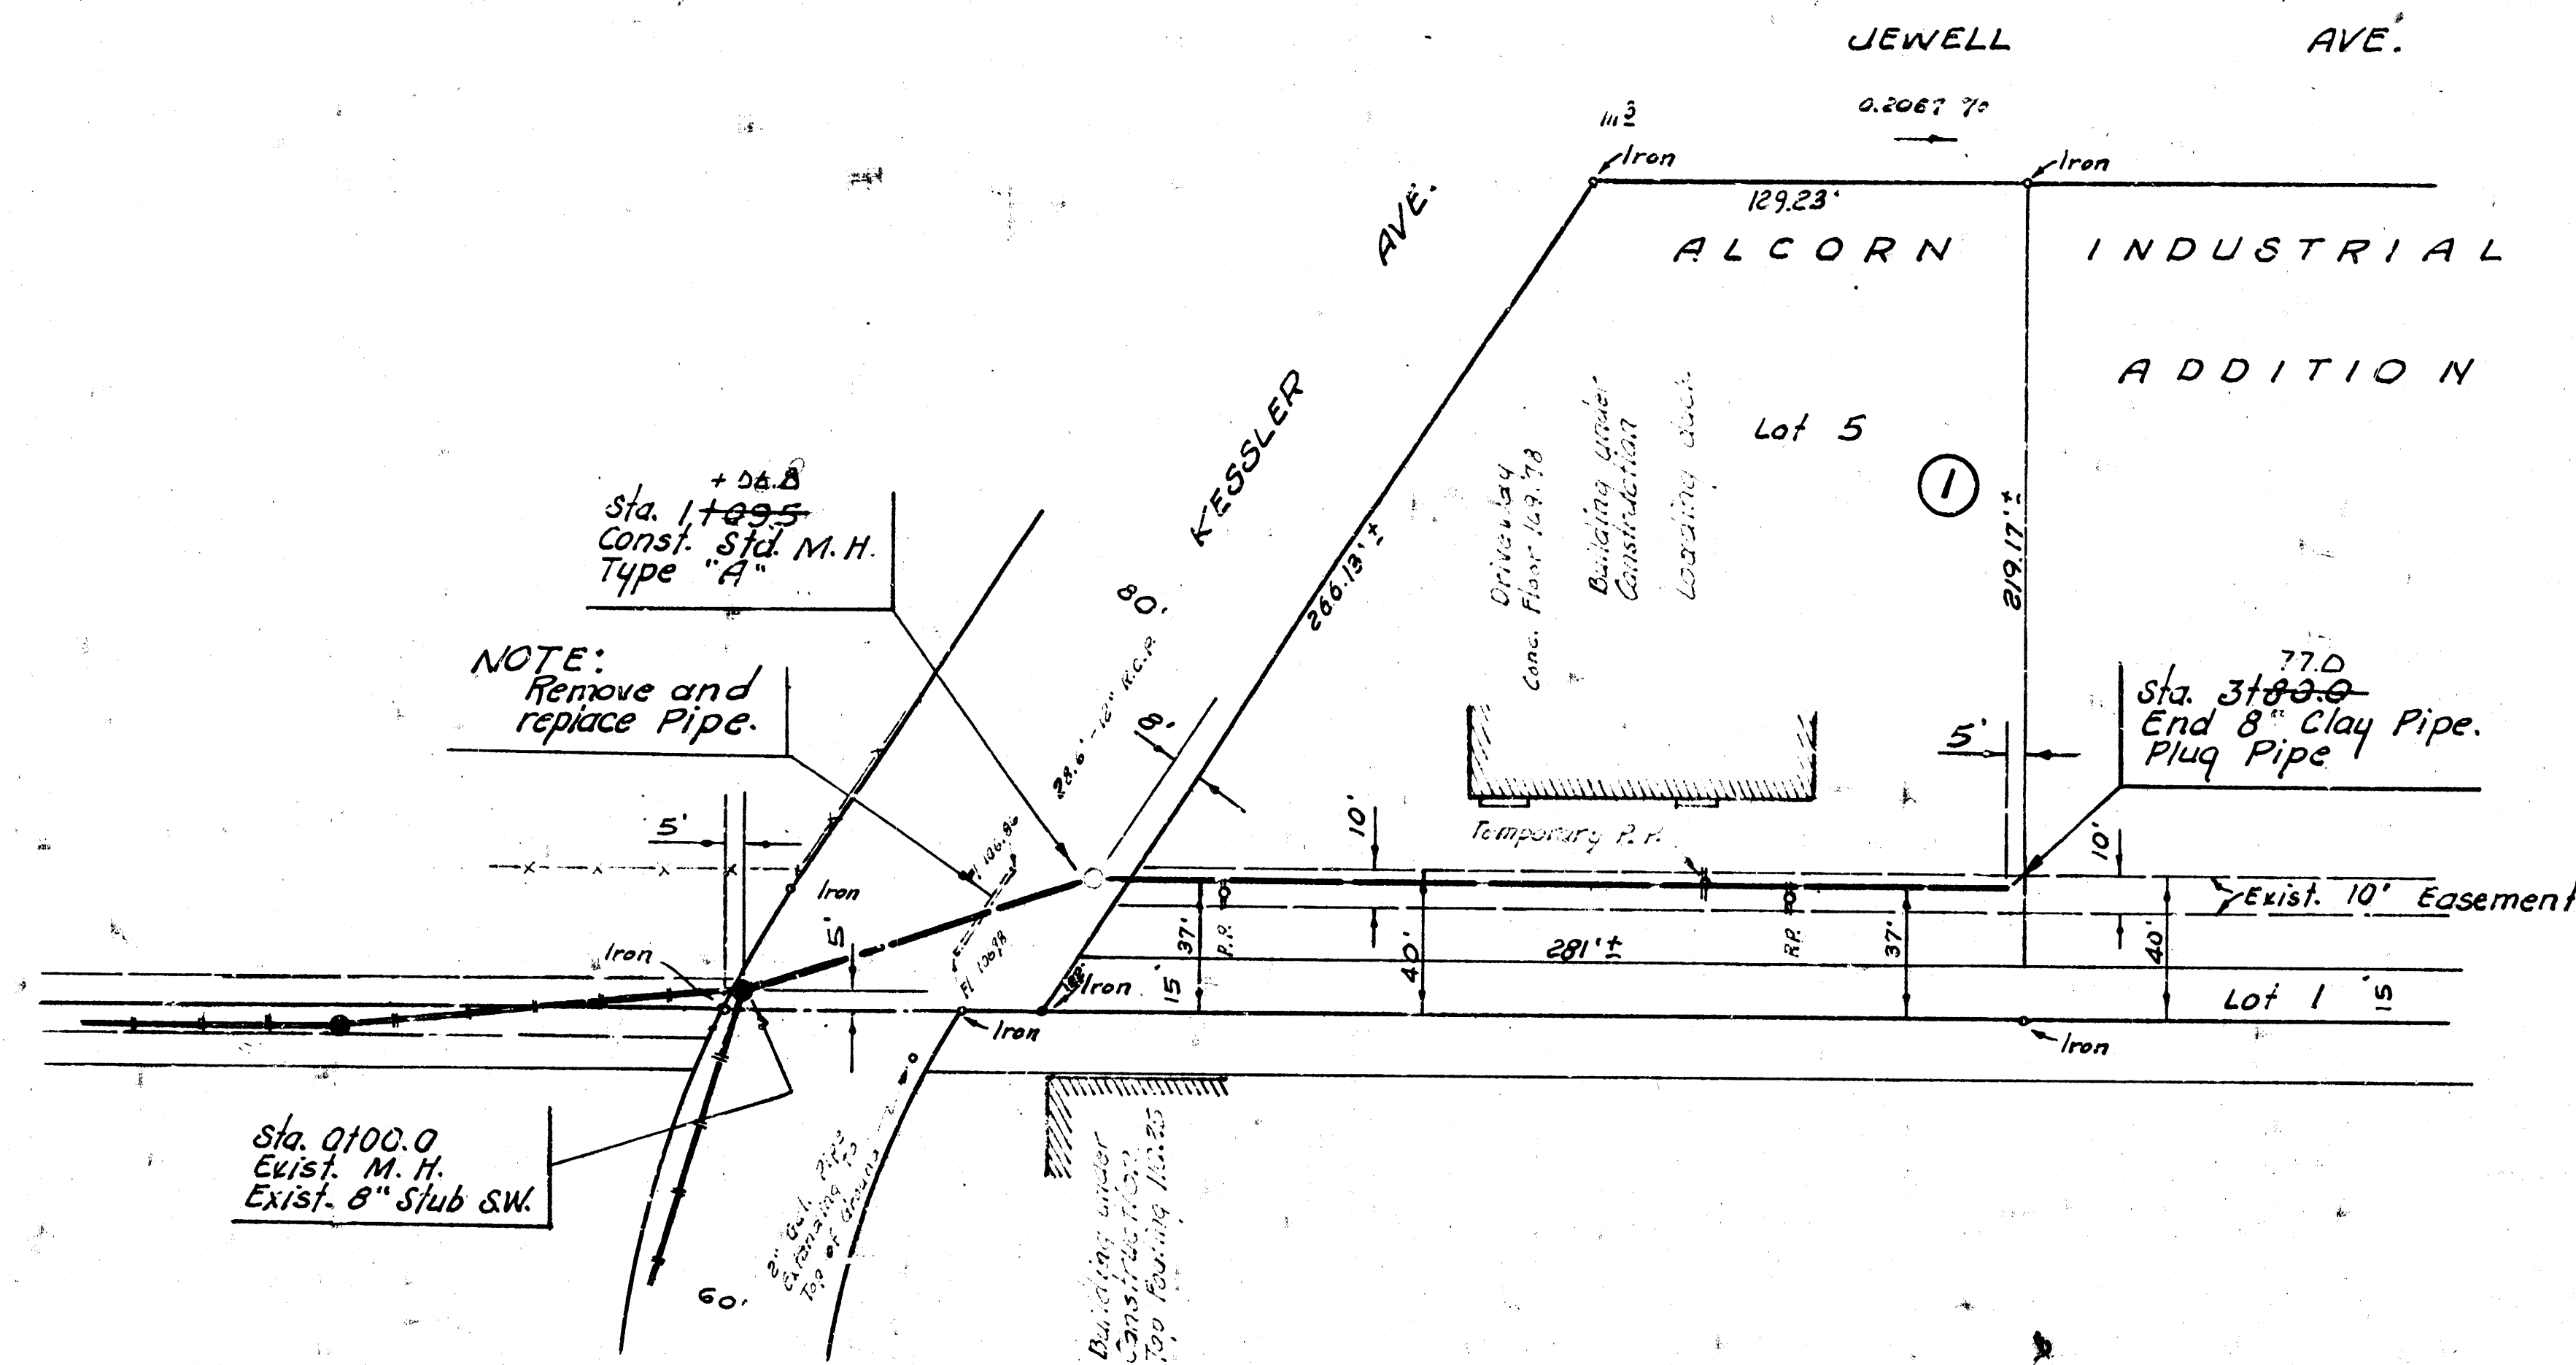

Plan Scale 1" = 40'
Profile Scale 1" = 40' Horiz.
1" = 5' Vert.

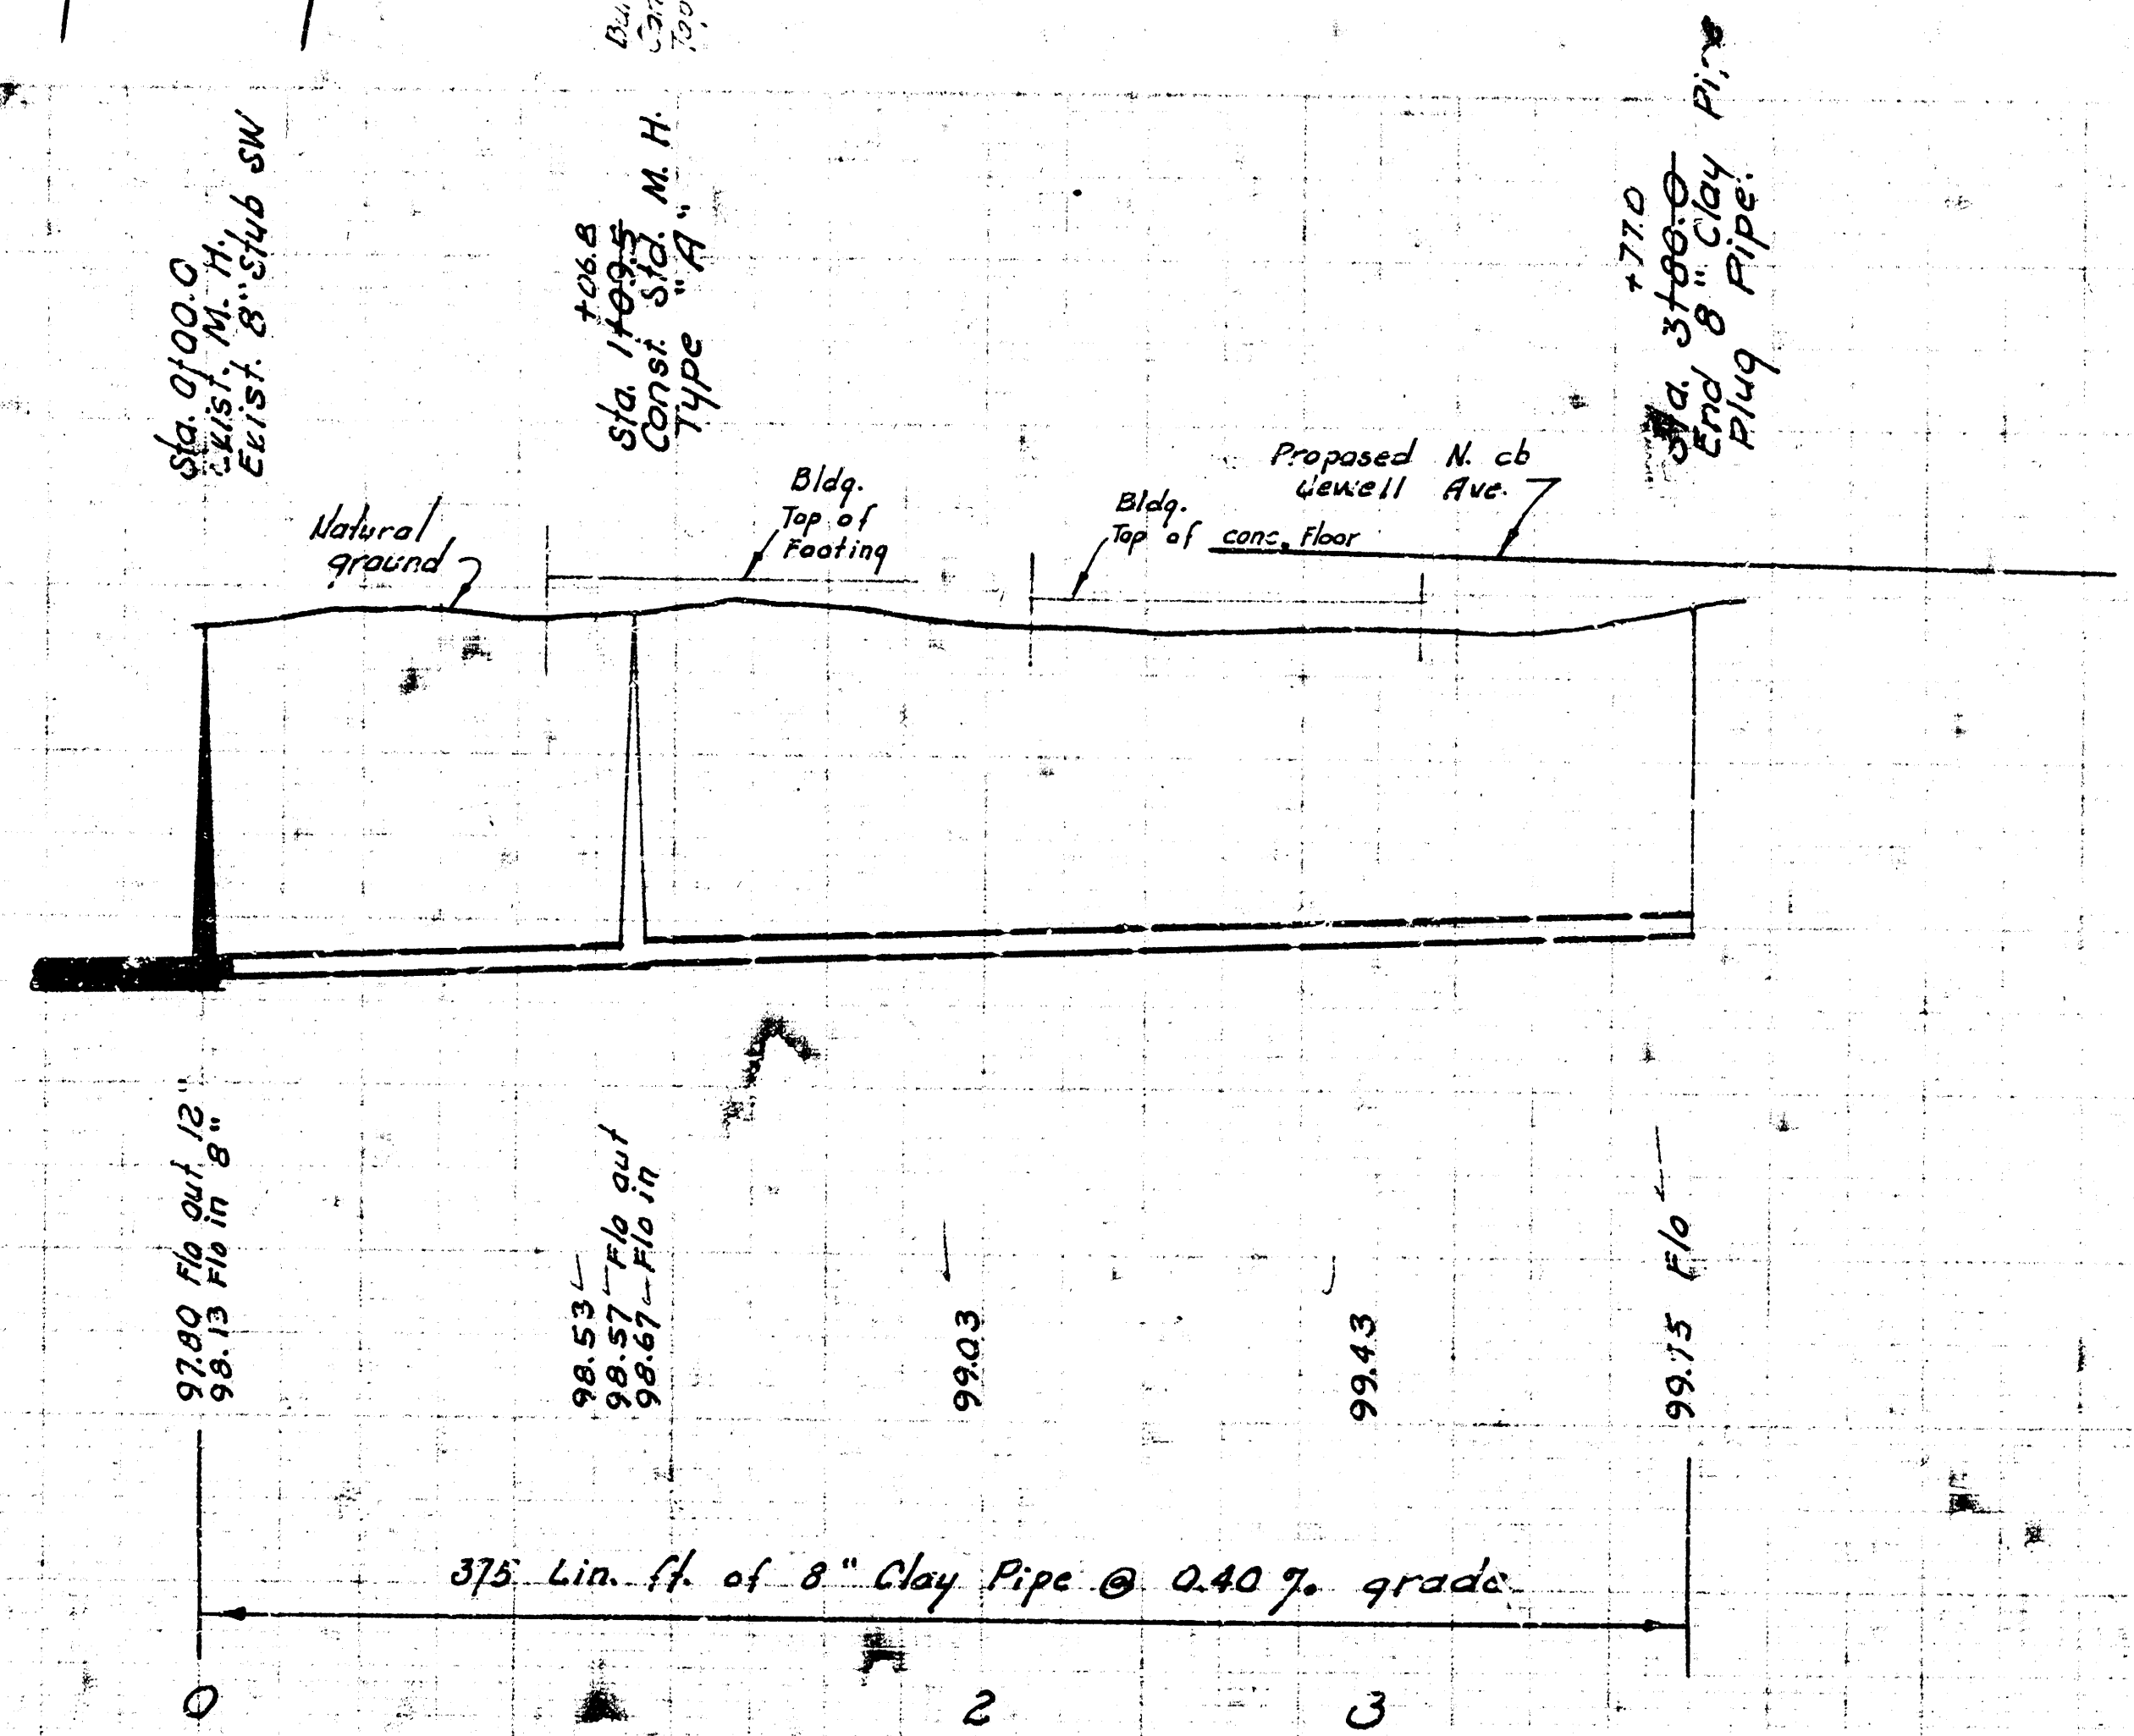

As Built Final Measurements 1.H-76
LAT. 6 MAIN 14, S.S. NO. 22
CITY OF WICHITA, KANSAS
R. W. LINN — CITY ENGINEER
NOV. 1972 PROJECT NO. DBKLS72060