



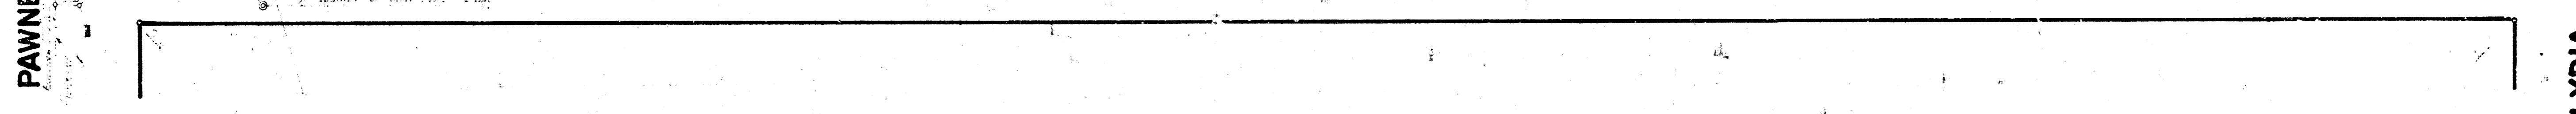


BM 111.43 R.R. Spike N. Face P.P. S. Side Pawnee 25' E of E.L. Edwards.

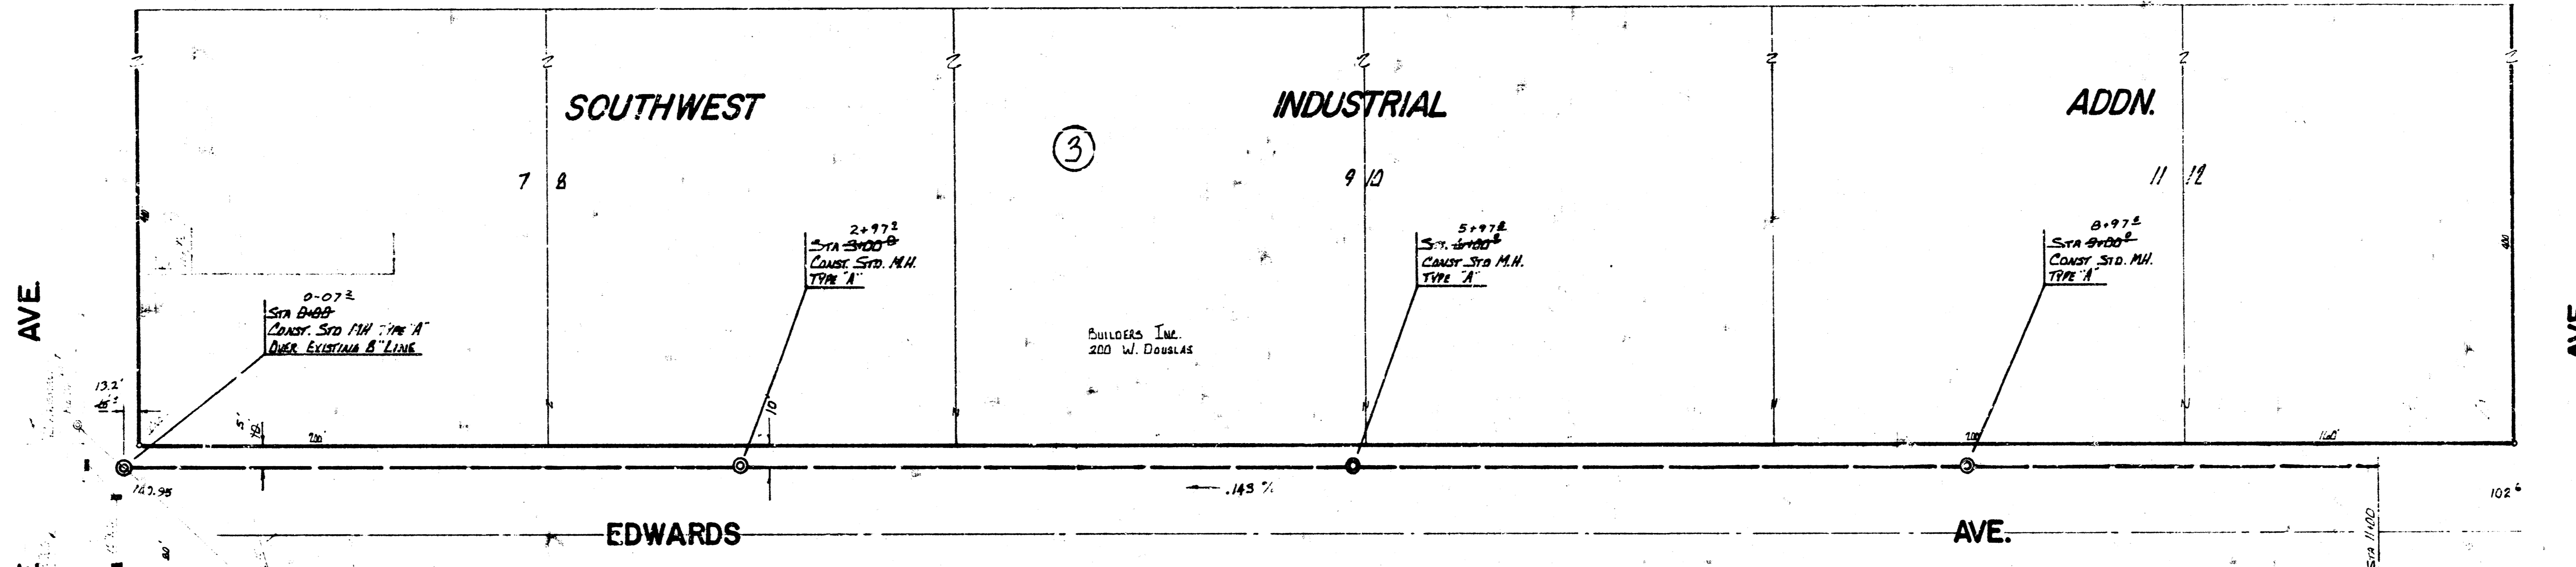

NOTE: ALL EXCESS MATERIAL SEPARATED FROM TRUCKS FOR REMOVAL SHALL BE Hauled OVER THE ROAD TO PROVIDE ADDITIONAL COVER.

NOTE: MINIMUM COVER OF 2.5' TO BE MAINTAINED THROUGHOUT PROJECT.

PLAN SCALE 1"=40'  
PROFILE SCALE 1"=4' VERT

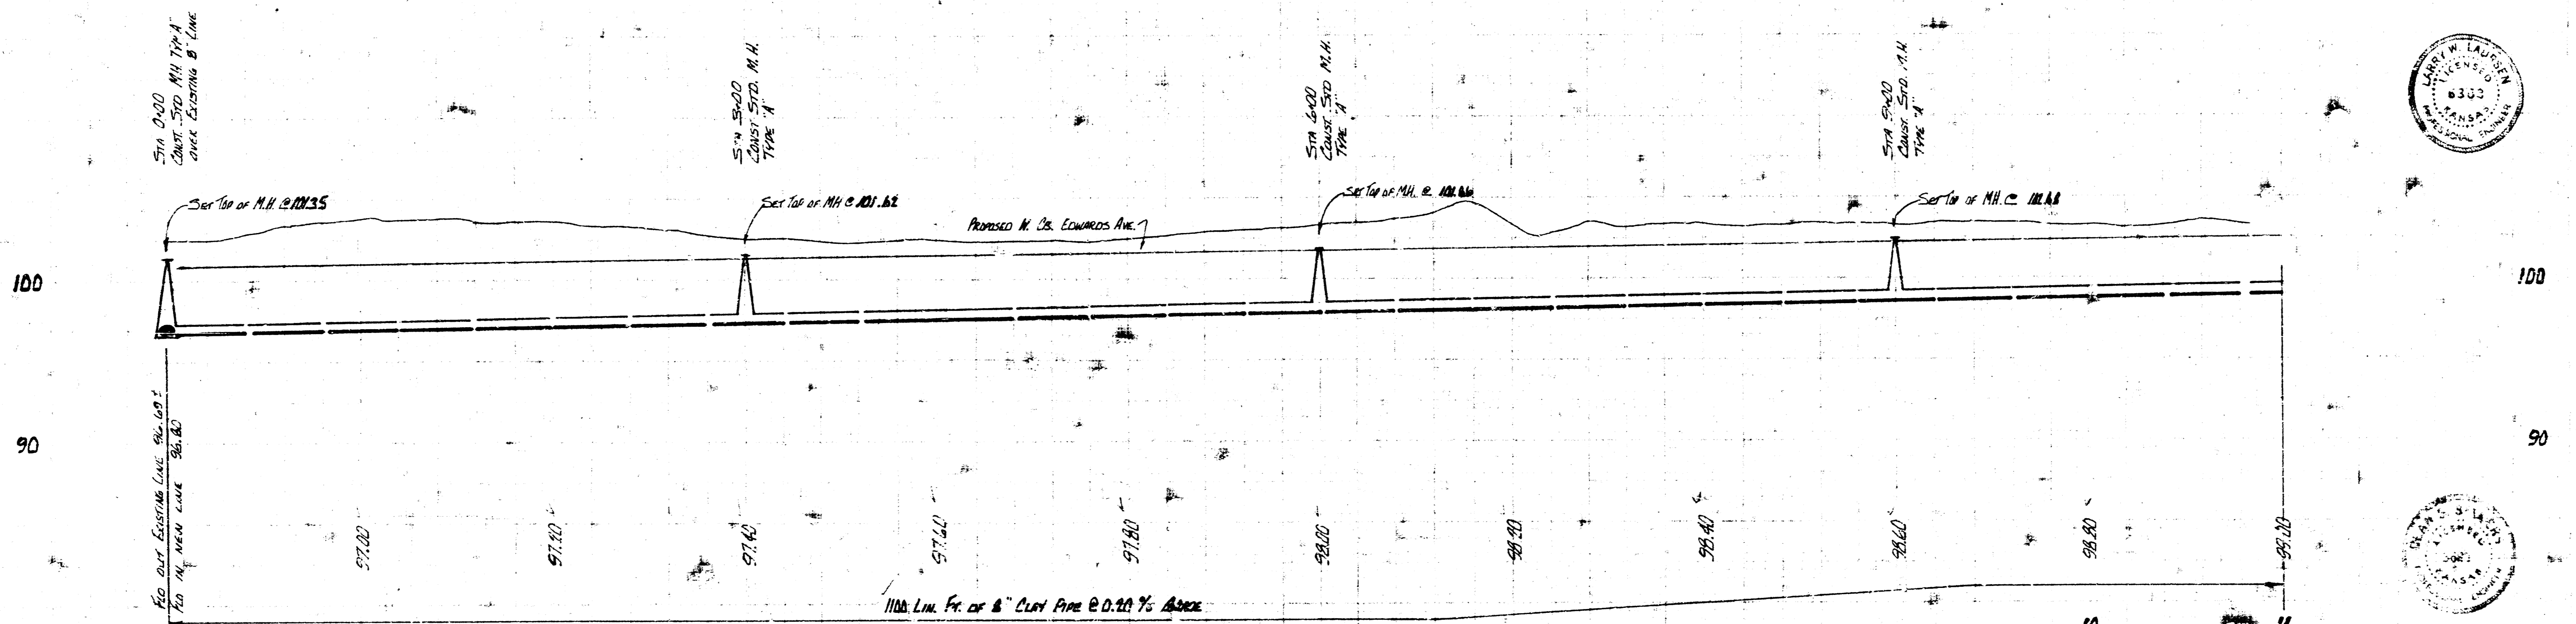


LAT 5, MAIN 16, S.S. No. 22  
CITY OF WICHITA, KANSAS  
R.W. LINN CITY ENGINEER  
DATE: JAN. 1973 SHEET 1 OF 3  
PROJECT No. DSKL 5720 55

As Built Final Meas. 55' 12" LL






BM 105.15 R.R. SPIKE S-SIDE HLT. S-SIDE MAY 125' E OF EL EDWARDS

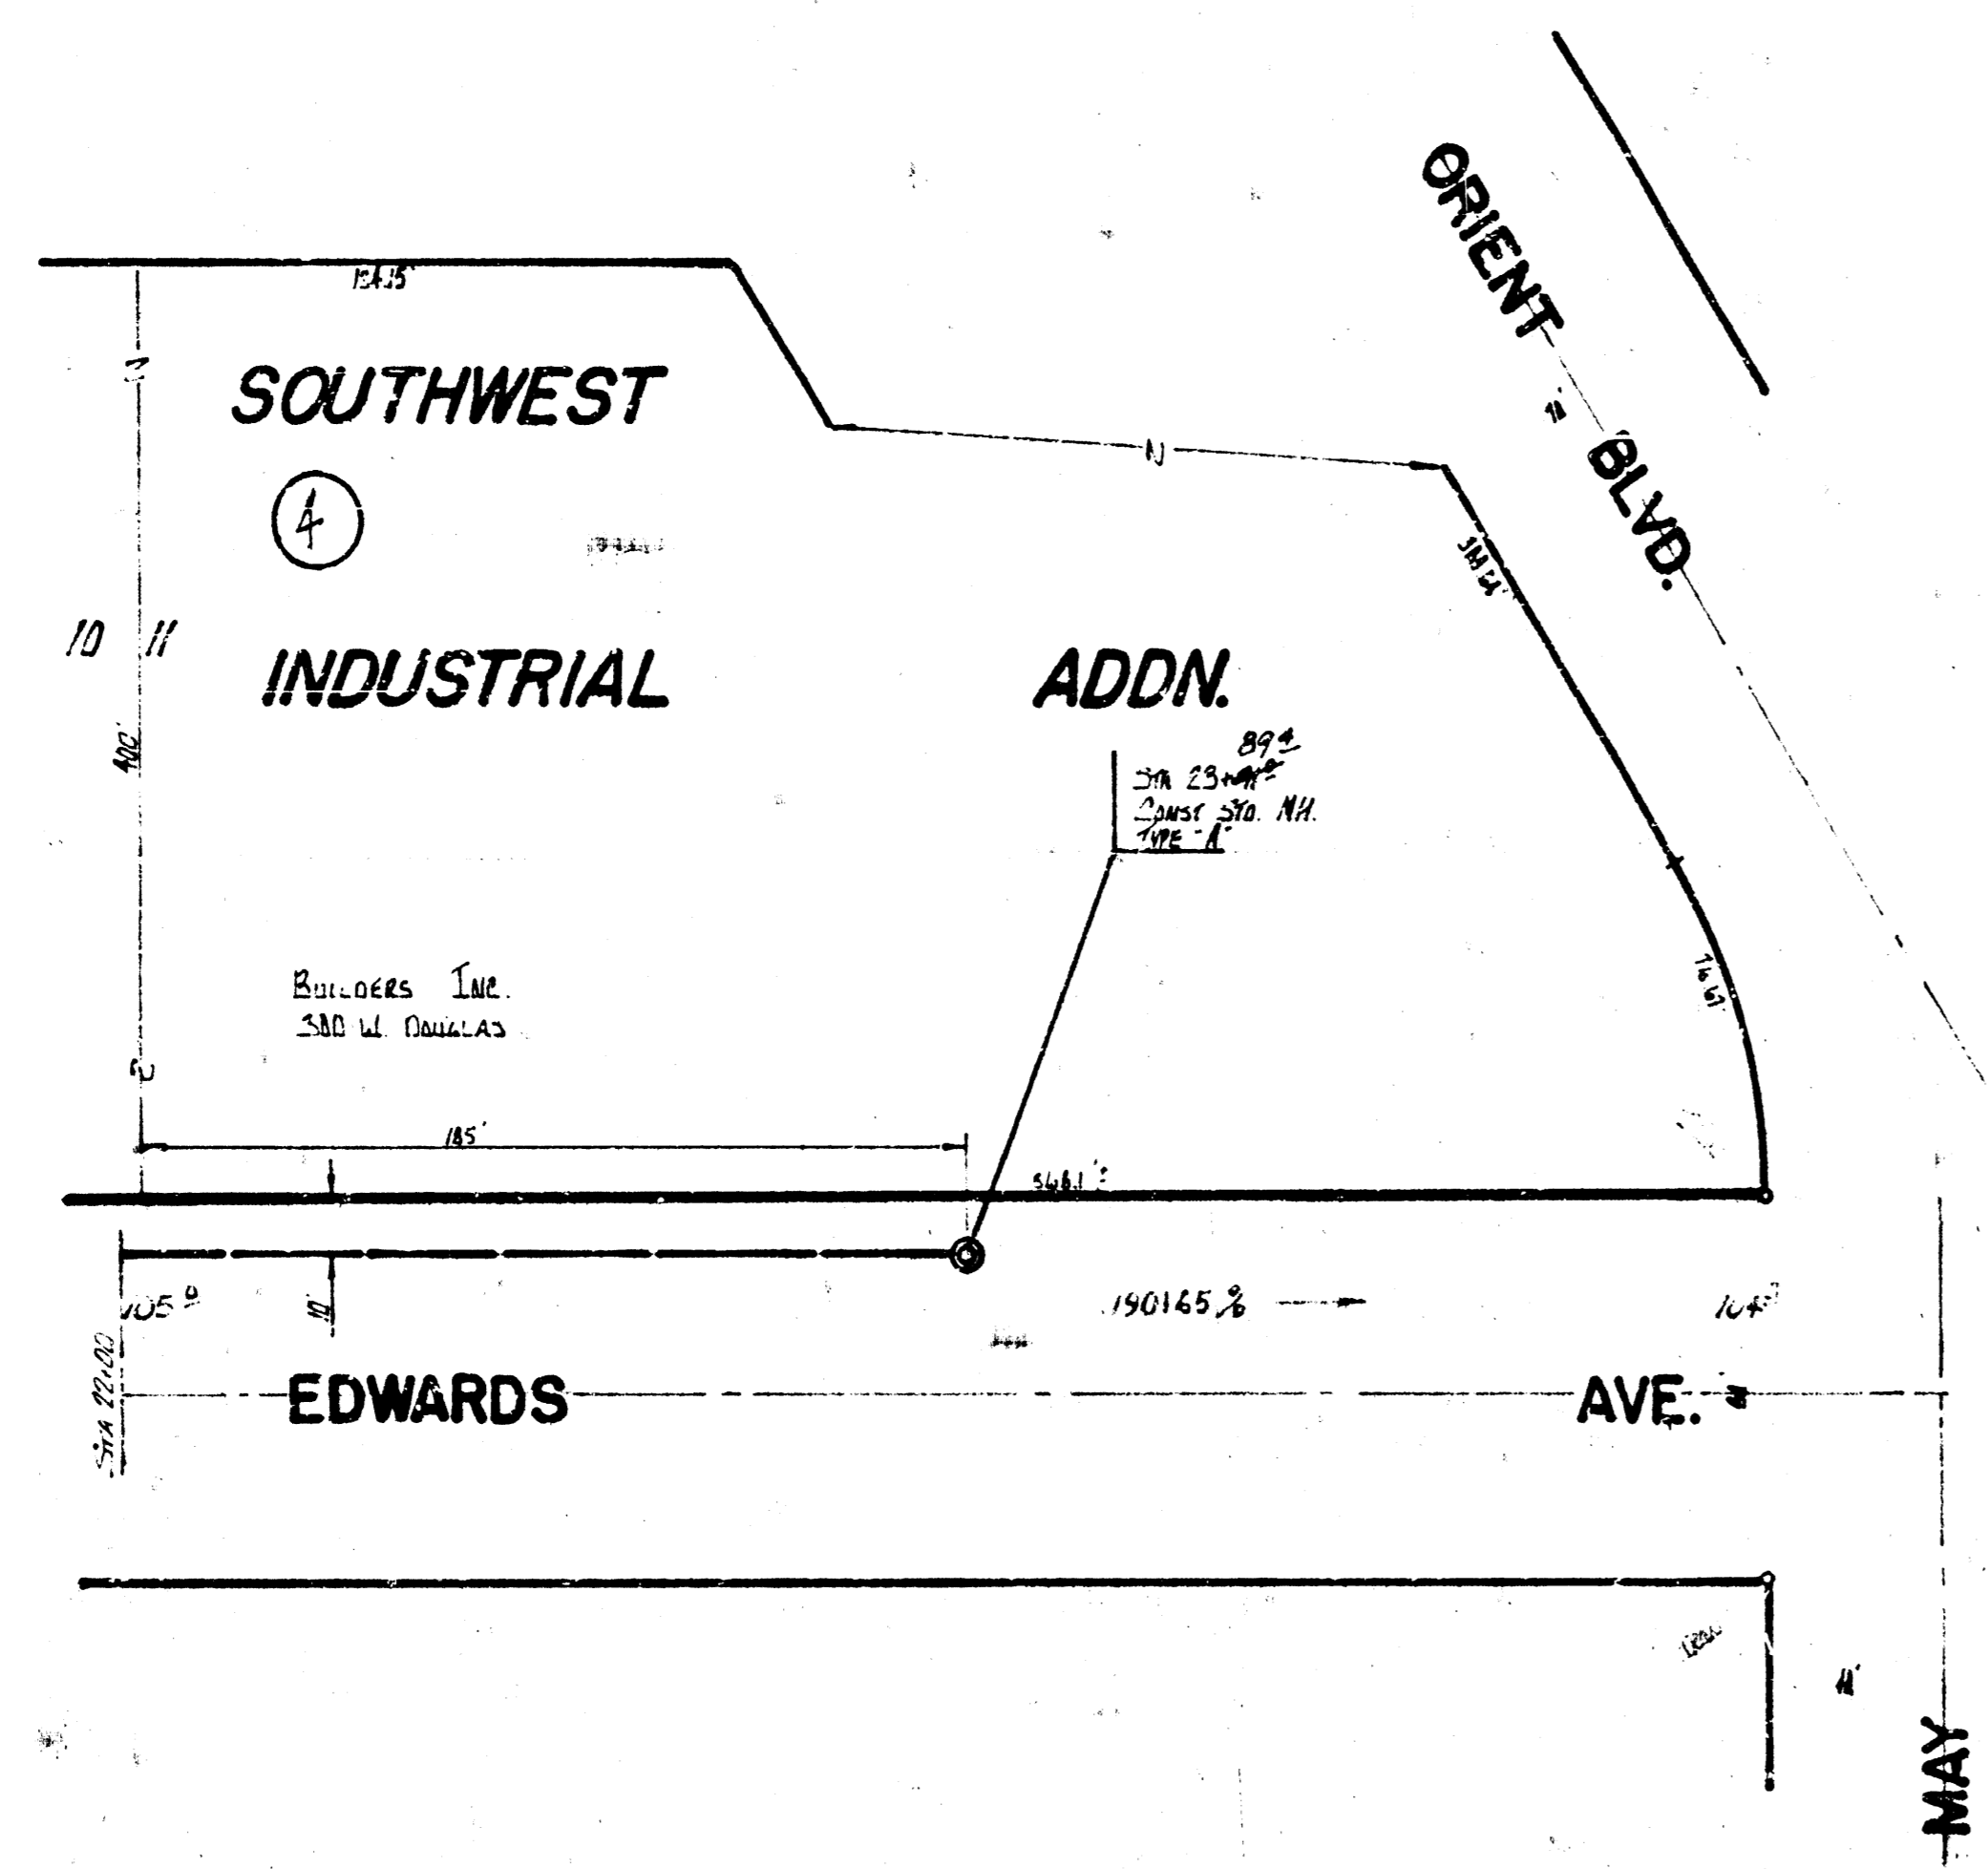

PLAN SCALE 1"=40'  
 HOUSE SCALE 1"=40' HORIZ.  
 1"=5' VERT.

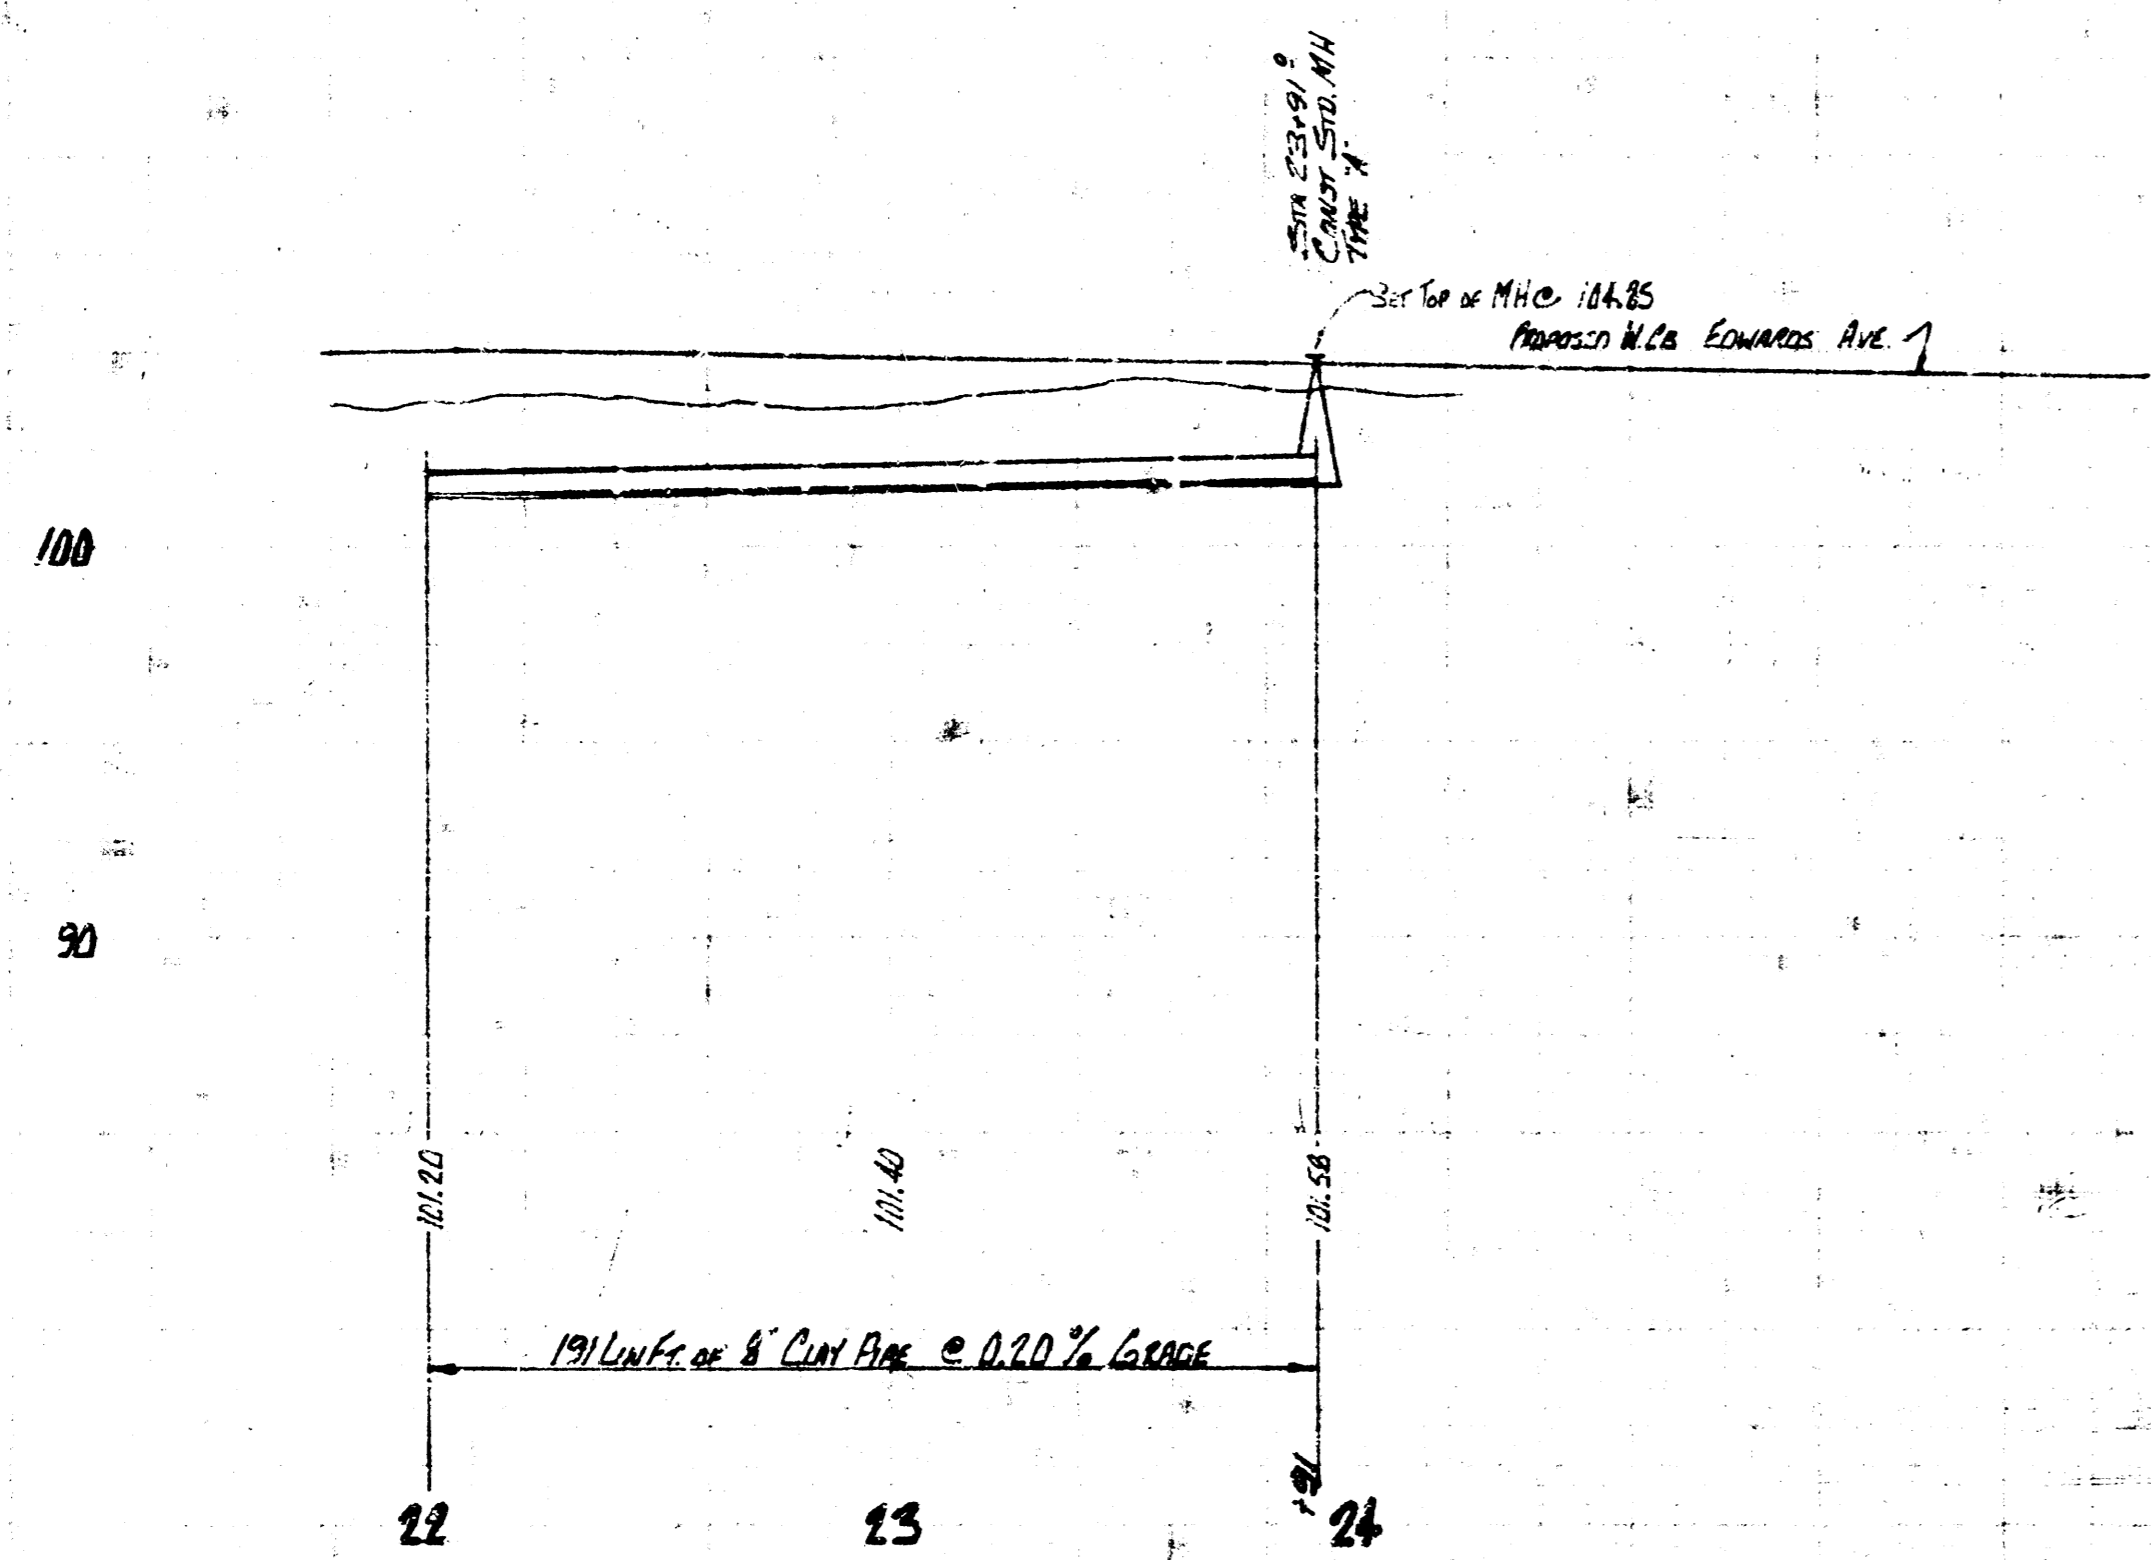

LAT 5, MAIN 10, S.S. No. 22  
 PROJECT 14 DBKLS 72055 SHEET 3 OF 3