


Plan Scale 1" = 40'
 Profile Scale 1" = 5' Vert.

B.M. 104.49' on east curb of Edwards 552' south of St. May

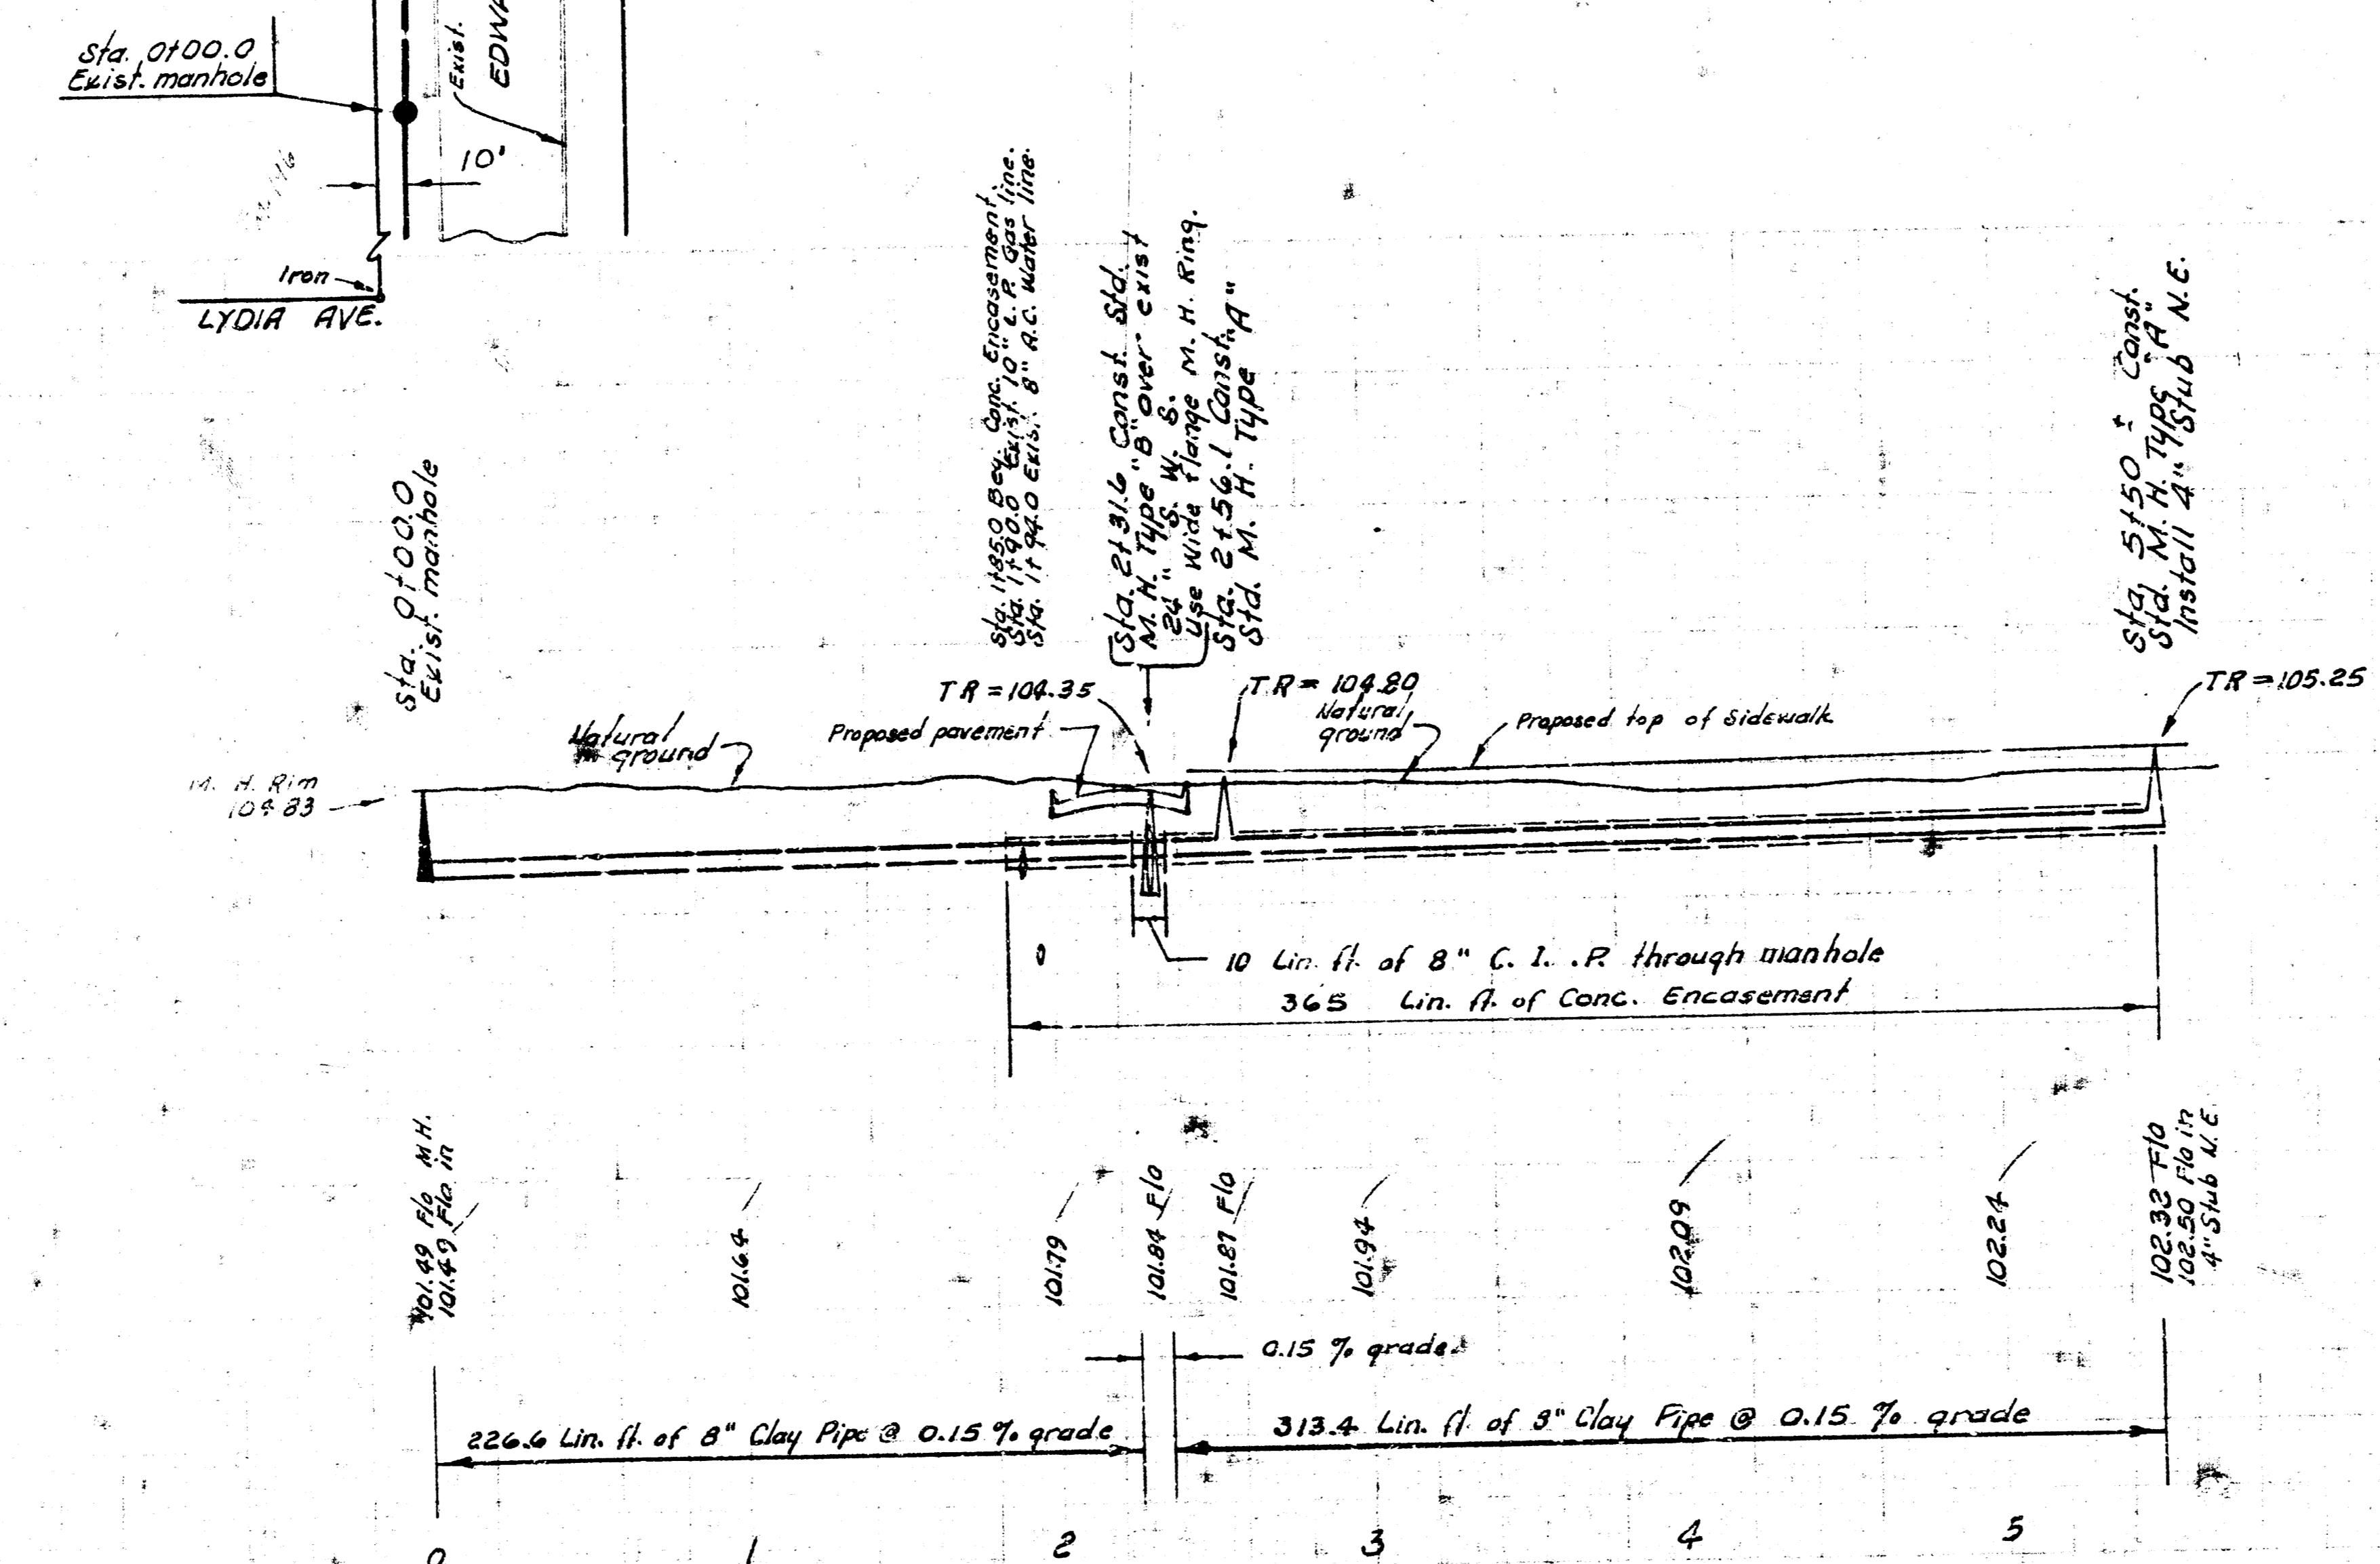

As Built Final Map S.S. 16-22

LAT. 6, MAIN 16, S. S. NO. 22
 CITY OF WICHITA, KANSAS
 R. W. LINN — CITY ENGINEER
 DEC. 1973 PROJECT NO. DBKL 573053

