


Surveying
Plan
Ex
Check

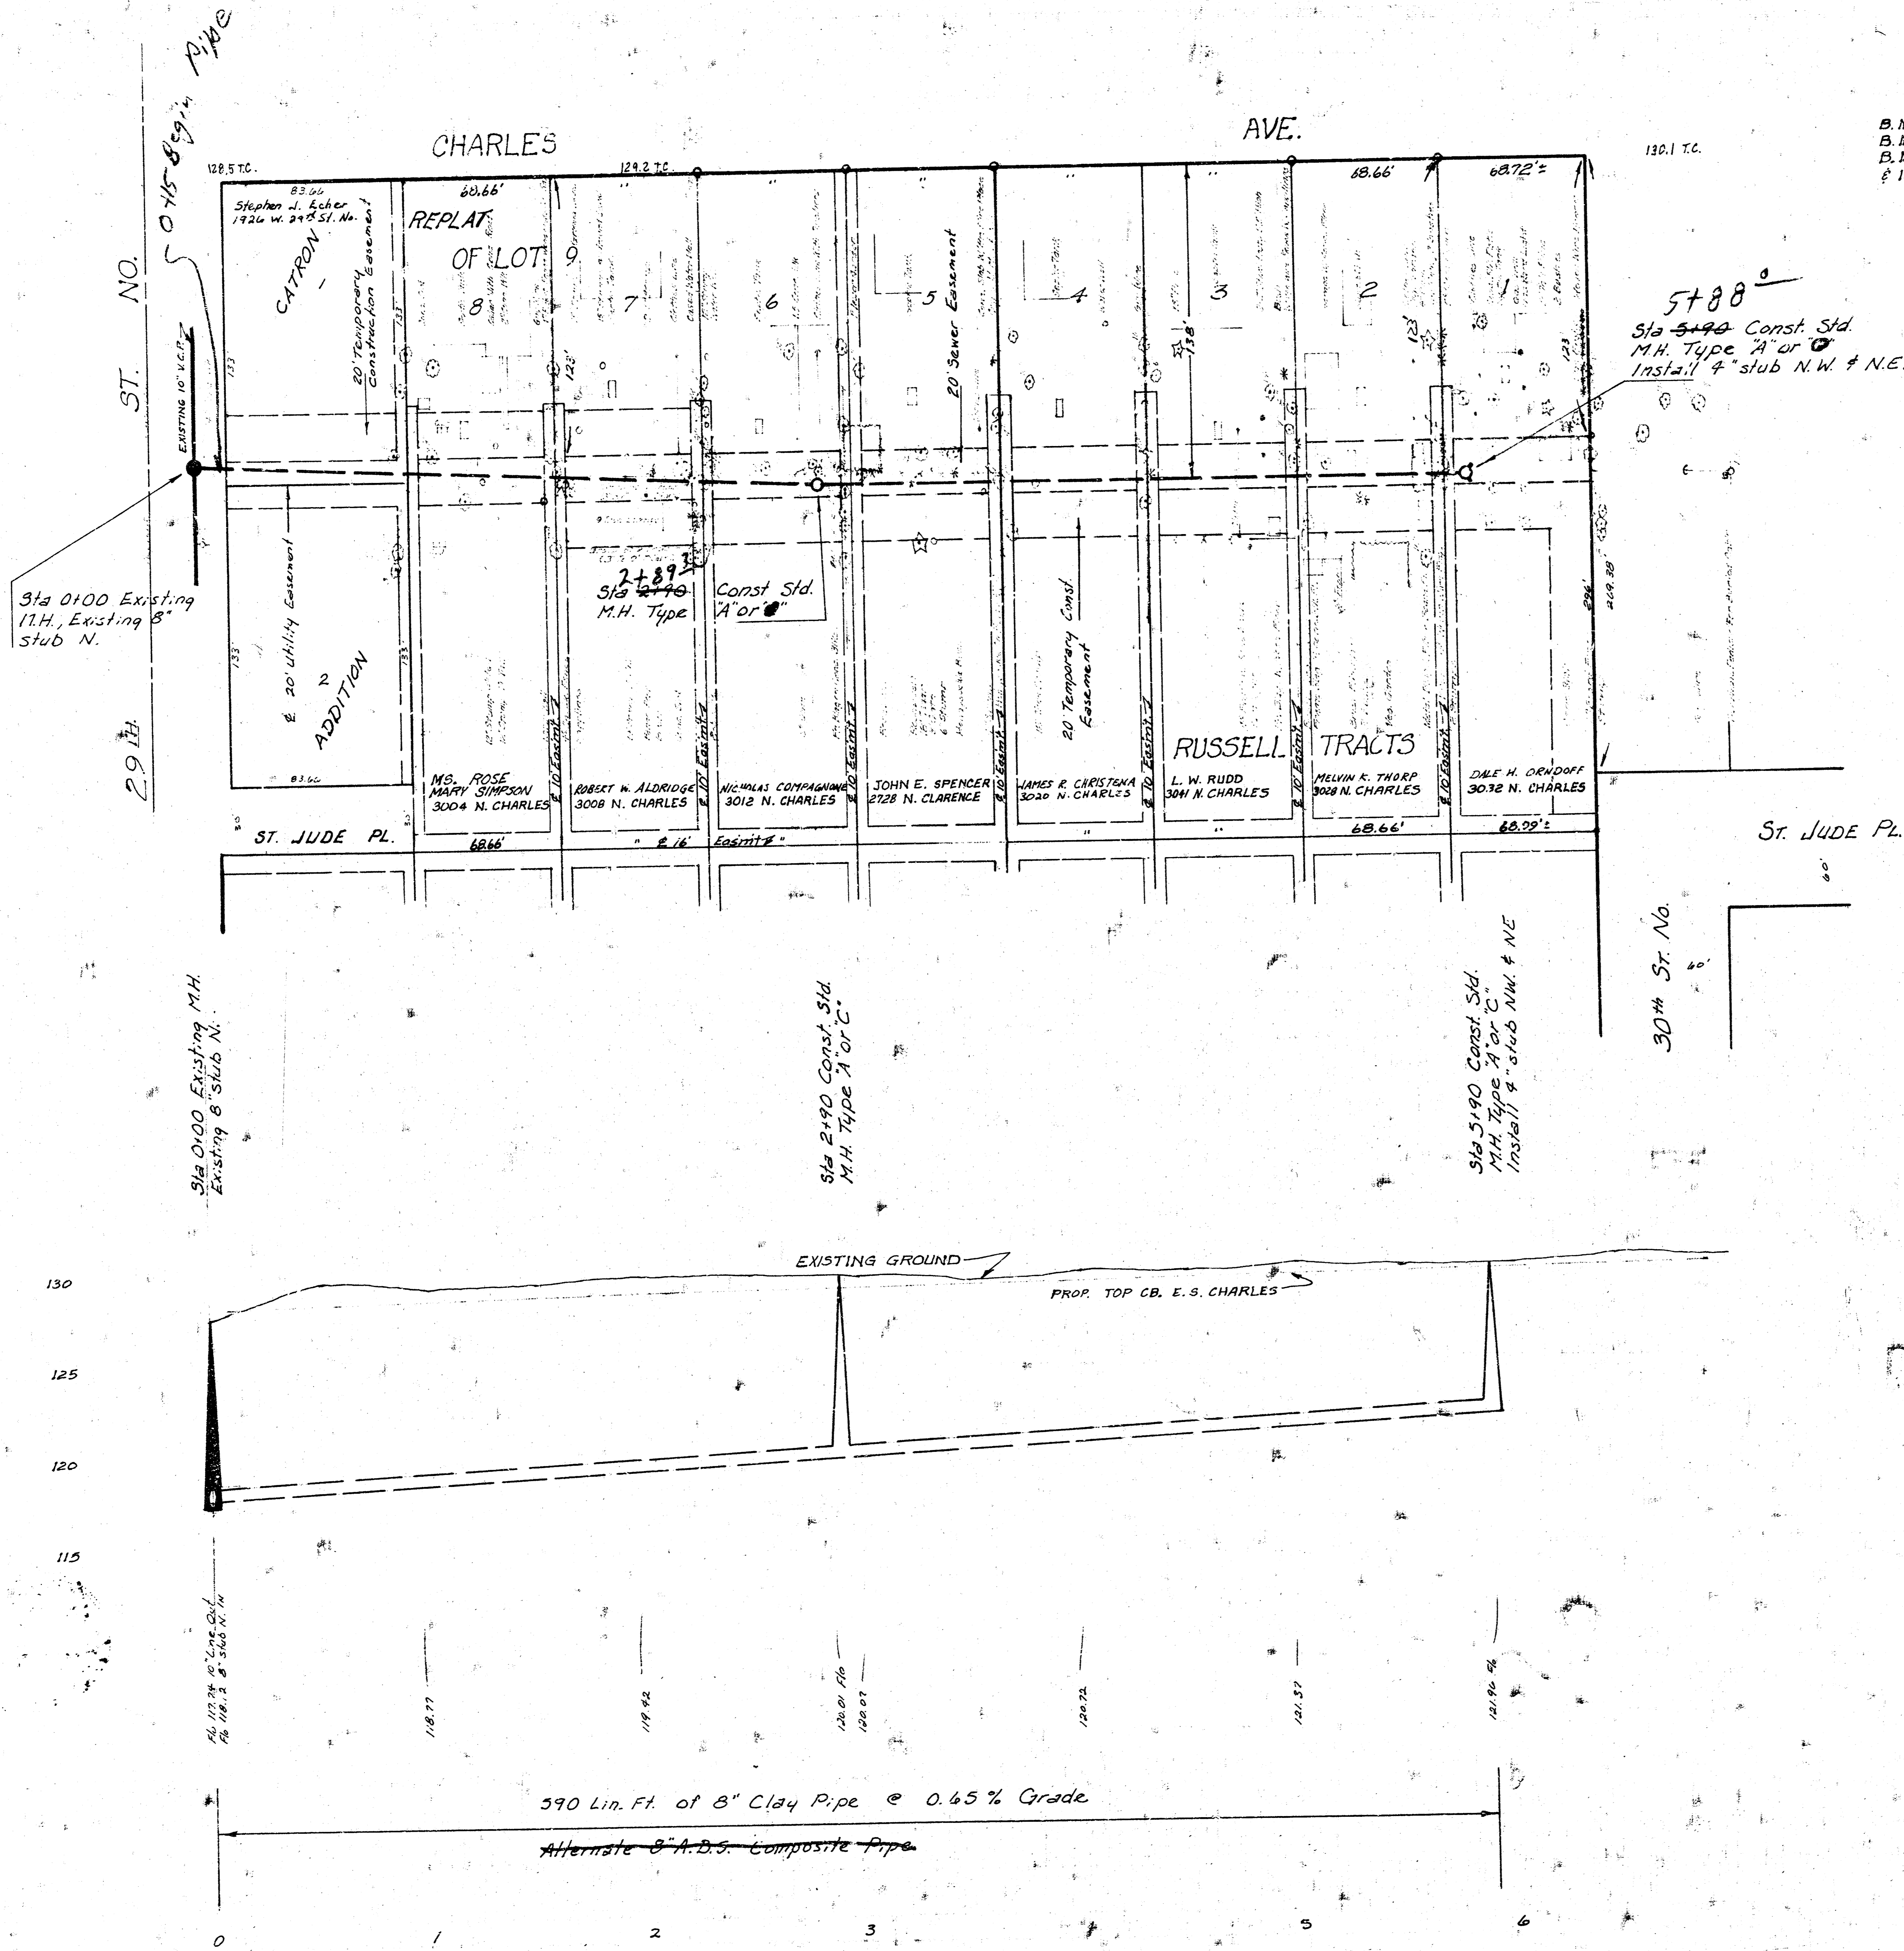

B.M. 12+22 CITY STANDARD 6' N. & 2' W. OF S.W. COR. 29TH & AMIDON.
 B.M. 128.07 R.R. SPIKE S. FACE P.P. N.S. 29TH & 397' W. OF 2 AMIDON.
 B.M. 130.49 R.R. SPIKE S. FACE P.P. 62' ± N. OF SL. 30TH ST. EXTENDED
 & 136' ± E. OF E.L. CHARLES.

Scale Plan 1"=40'
 Profile 1"=5' Vert.

GENERAL NOTES

- CONTRACTOR SHALL GIVE PROPERTY OWNERS AFFECTED BY THE CONSTRUCTION OF THIS PROJECT A MINIMUM OF 24 HOURS ADVANCE NOTICE PRIOR TO THE START OF CONSTRUCTION.
- CONDITIONS WERE MADE AS A RESULT OF RIGHT OF WAY ACQUISITION AND SHALL BE ADHERED TO BY THE CONTRACTOR AS FOLLOWS:
 - LOT 1, REPLAT OF LOT 9, RUSSELL TRACTS - CONTRACTOR TO RESET FENCE.
 - LOT 2, REPLAT OF LOT 9, RUSSELL TRACTS - CONTRACTOR TO REPLACE FENCE.
 - LOT 3, REPLAT OF LOT 9, RUSSELL TRACTS - CONTRACTOR TO RESET FENCE.
 - LOT 4, REPLAT OF LOT 9, RUSSELL TRACTS - CONTRACTOR TO RESET FENCE.
 - LOT 5, REPLAT OF LOT 9, RUSSELL TRACTS - CONTRACTOR TO RESET FENCE.
 - LOT 6, REPLAT OF LOT 9, RUSSELL TRACTS - CONTRACTOR TO RESET FENCE AND CLOTHESLINE POLE.
 - LOT 7, REPLAT OF LOT 9, RUSSELL TRACTS - CONTRACTOR TO RESET FENCE AND HAND DIG AROUND STORAGE BUILDING.
 - LOT 8, REPLAT OF LOT 9, RUSSELL TRACTS - CONTRACTOR TO RESET FENCE.
 - LOT 9, CATRON ADDITION - CONTRACTOR TO RESET FENCE.



As built 10-27-77

LAT. 56, MAIN 17, S. S. 22
 CITY OF WICHITA, KANSAS
 R. W. LINN, CITY ENGINEER
 PROJ. NO. DBKL 572027
 DATE: *June 1977*