



Pian Scale 1" = 40'
 Profile Scale 1" = 40' Horz.
 1" = 5' Vert.


NOTE: CONTRACTOR WILL BE REQUIRED TO GIVE A MINIMUM 24 HOUR NOTICE TO DEVELOPED PROPERTIES EFFECTED BY THE CONSTRUCTION OF THIS PROJECT.

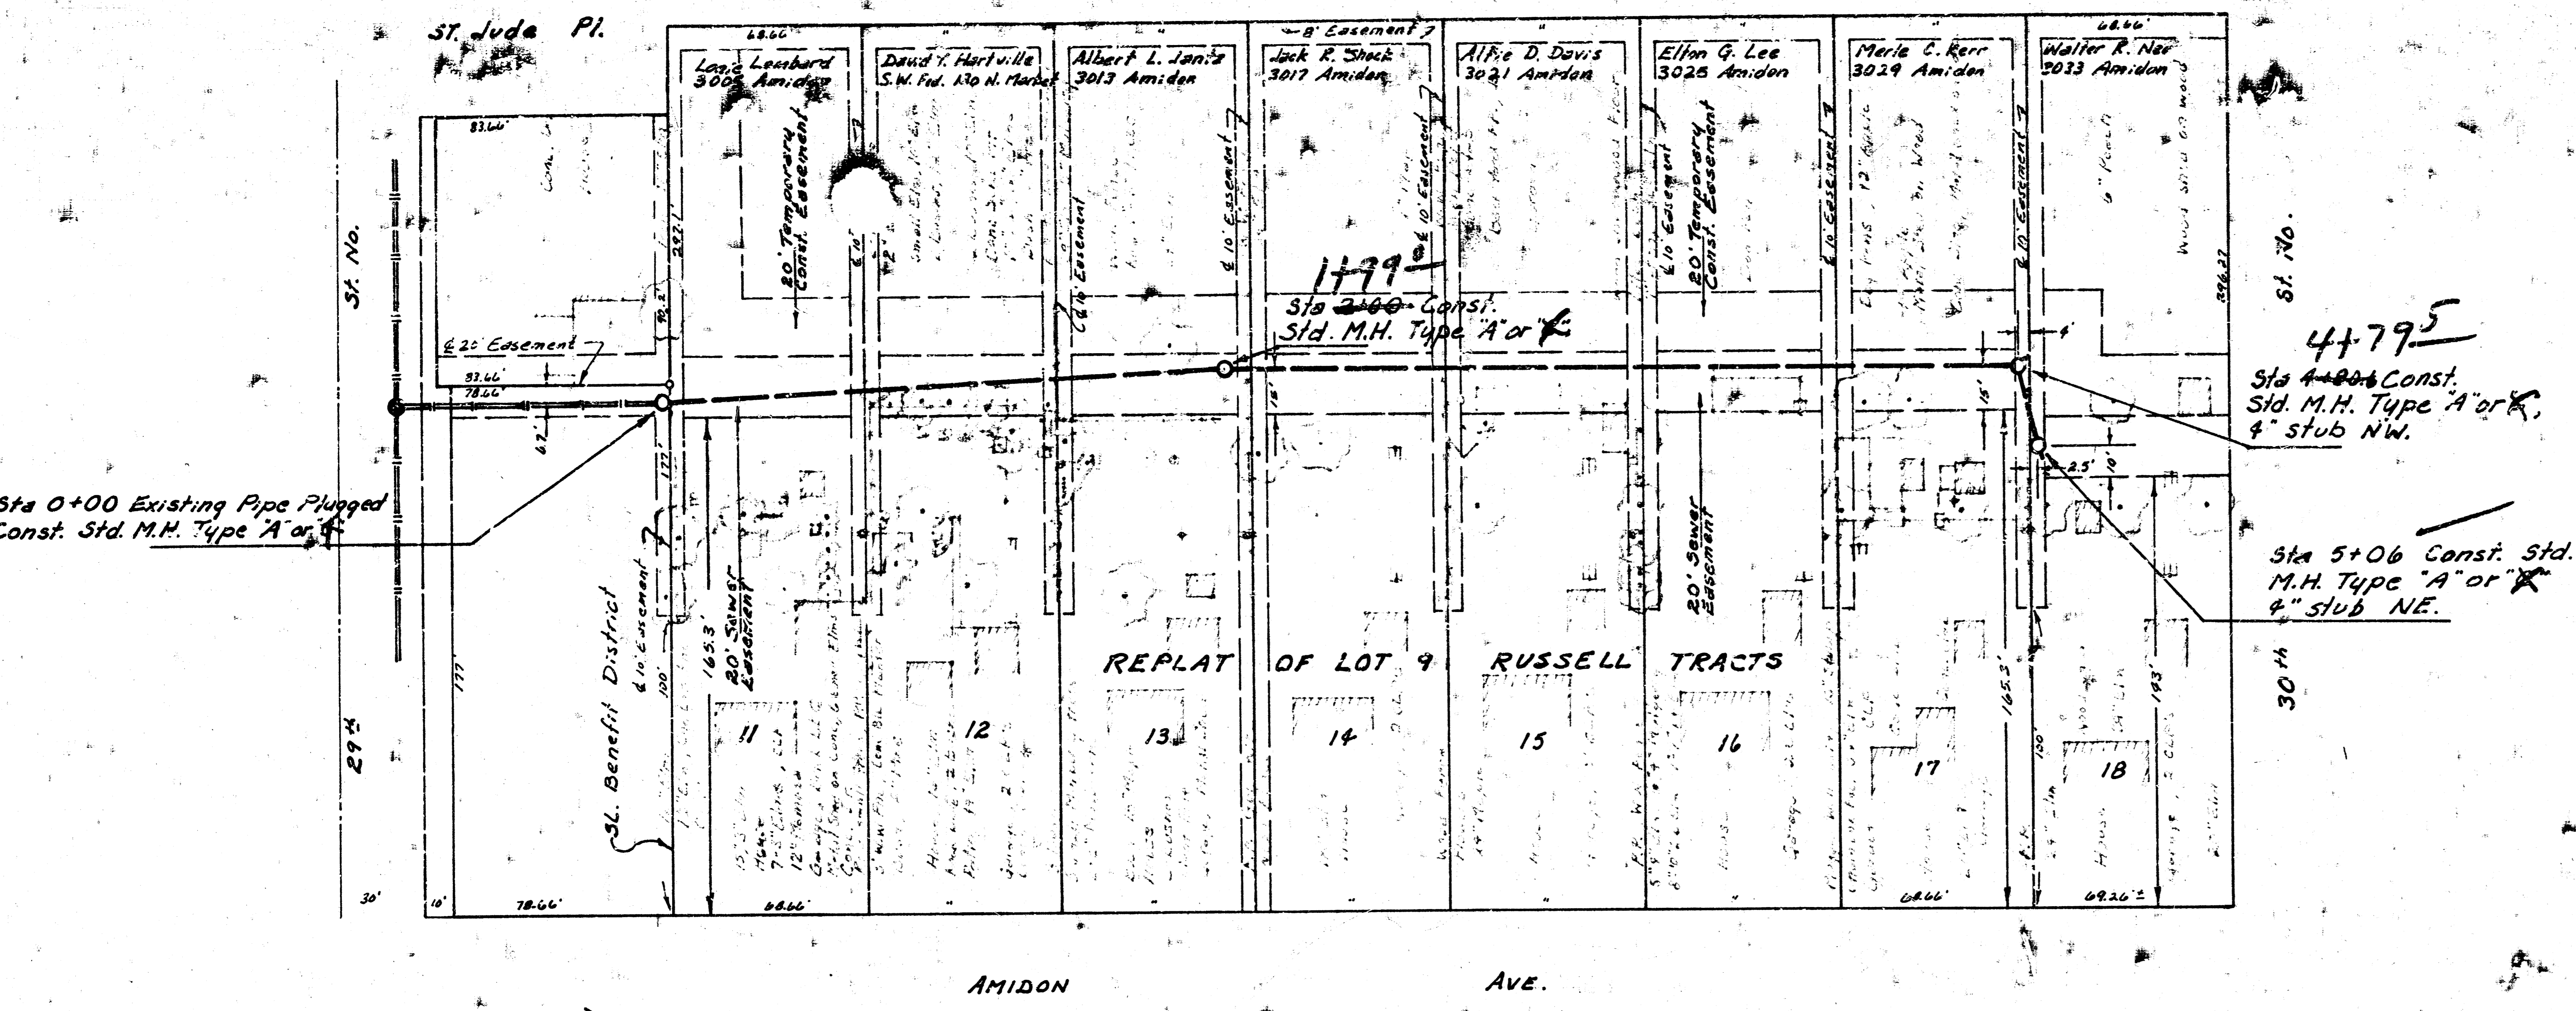

B.M. 12722 City Std. Disc 44.5'S and 40.8' W. of E. of Amidon & 29th St. No.

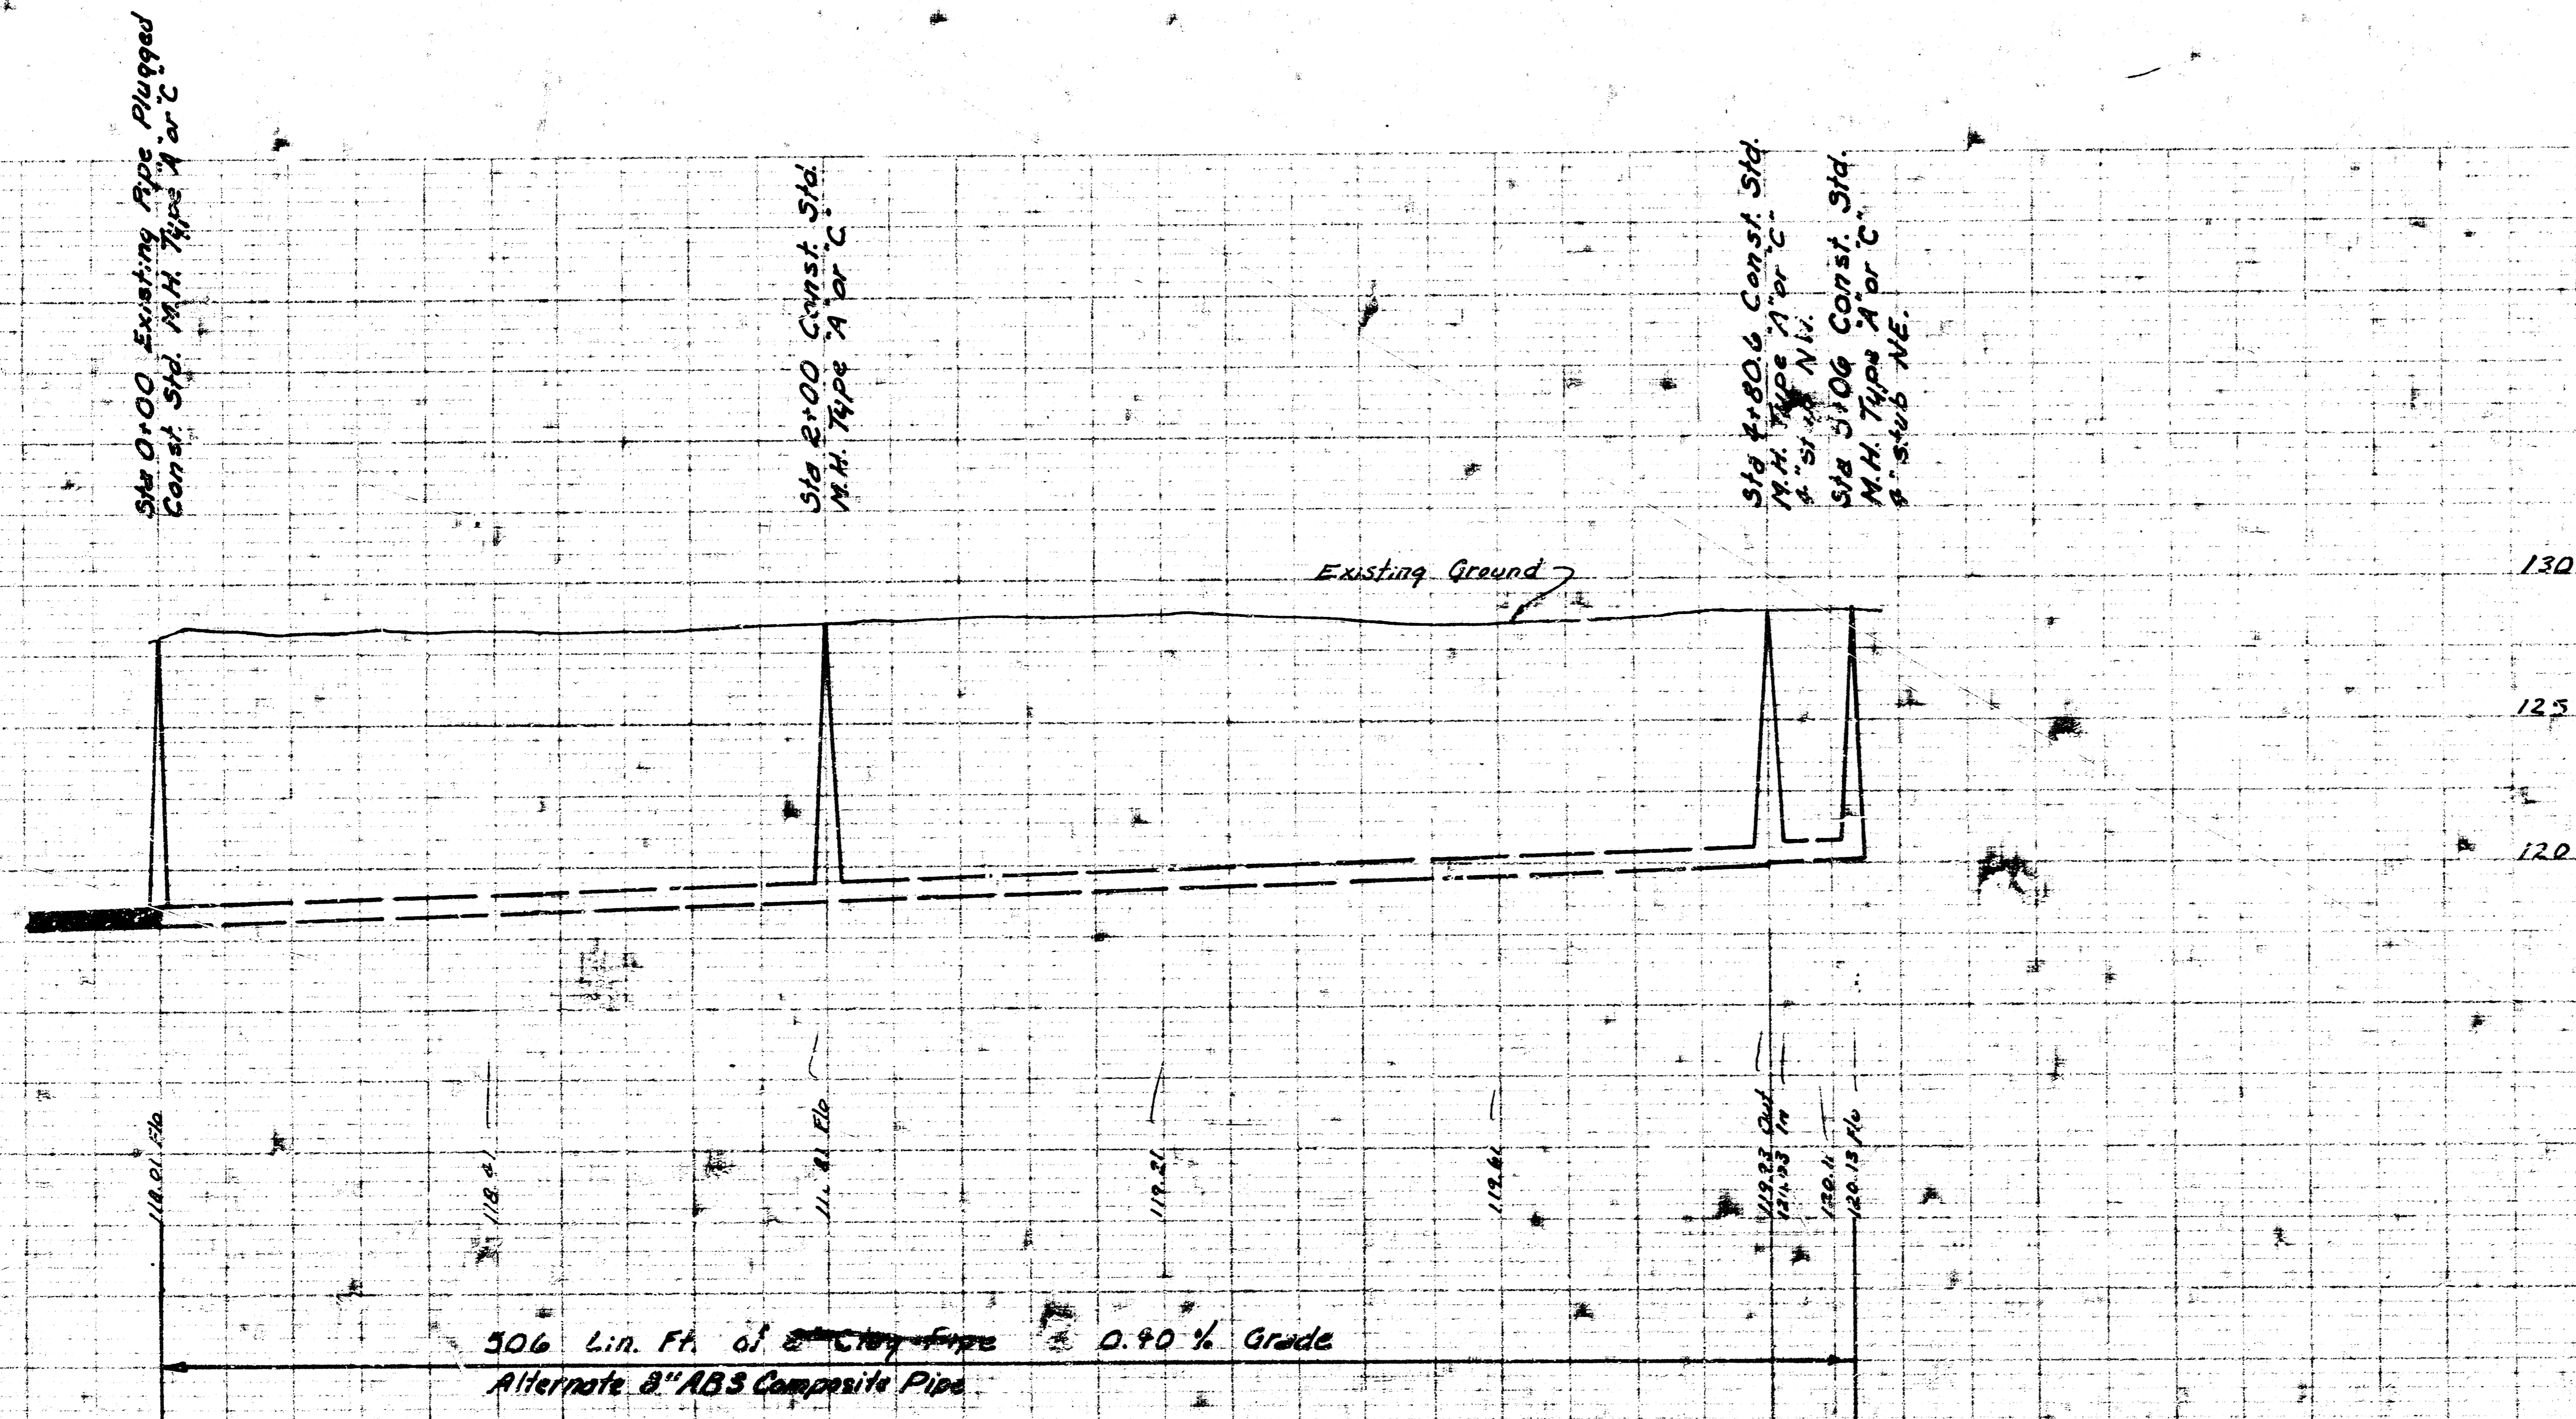

As built 4-27-78

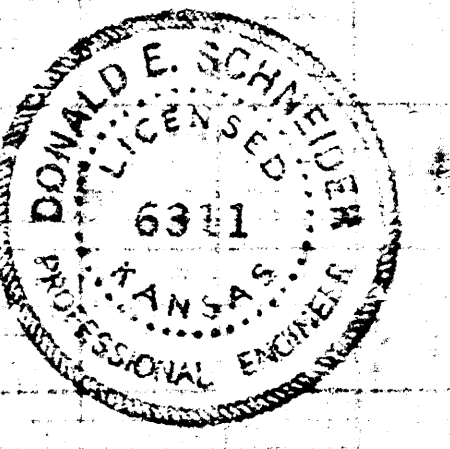

LAT 61, MAIN 17, S.S. NO. 22
 CITY OF WICHITA, KANSAS
 R. W. LINN — CITY ENGINEER
 PROJECT NO. DBKL577024