


BM 135.05 R.R. Spike W.S. Wooden St. Power Pole on N.E. Corner 39th St. N. & Charles
 BM 133.81 R.R. Spike S. Side P. Pole, center of Amidon R/W on North Side Nottingham
 BM 133.39 City Std. Disc 39'E. & 52'S. of C. of Amidon & 37th St. North

Robert Ulrich, 408 N. Charles, Phone No. 838-8606,
 wants the contractor for this project to contact him
 about connecting his house to the sewer at the same
 time work on this project is being completed.

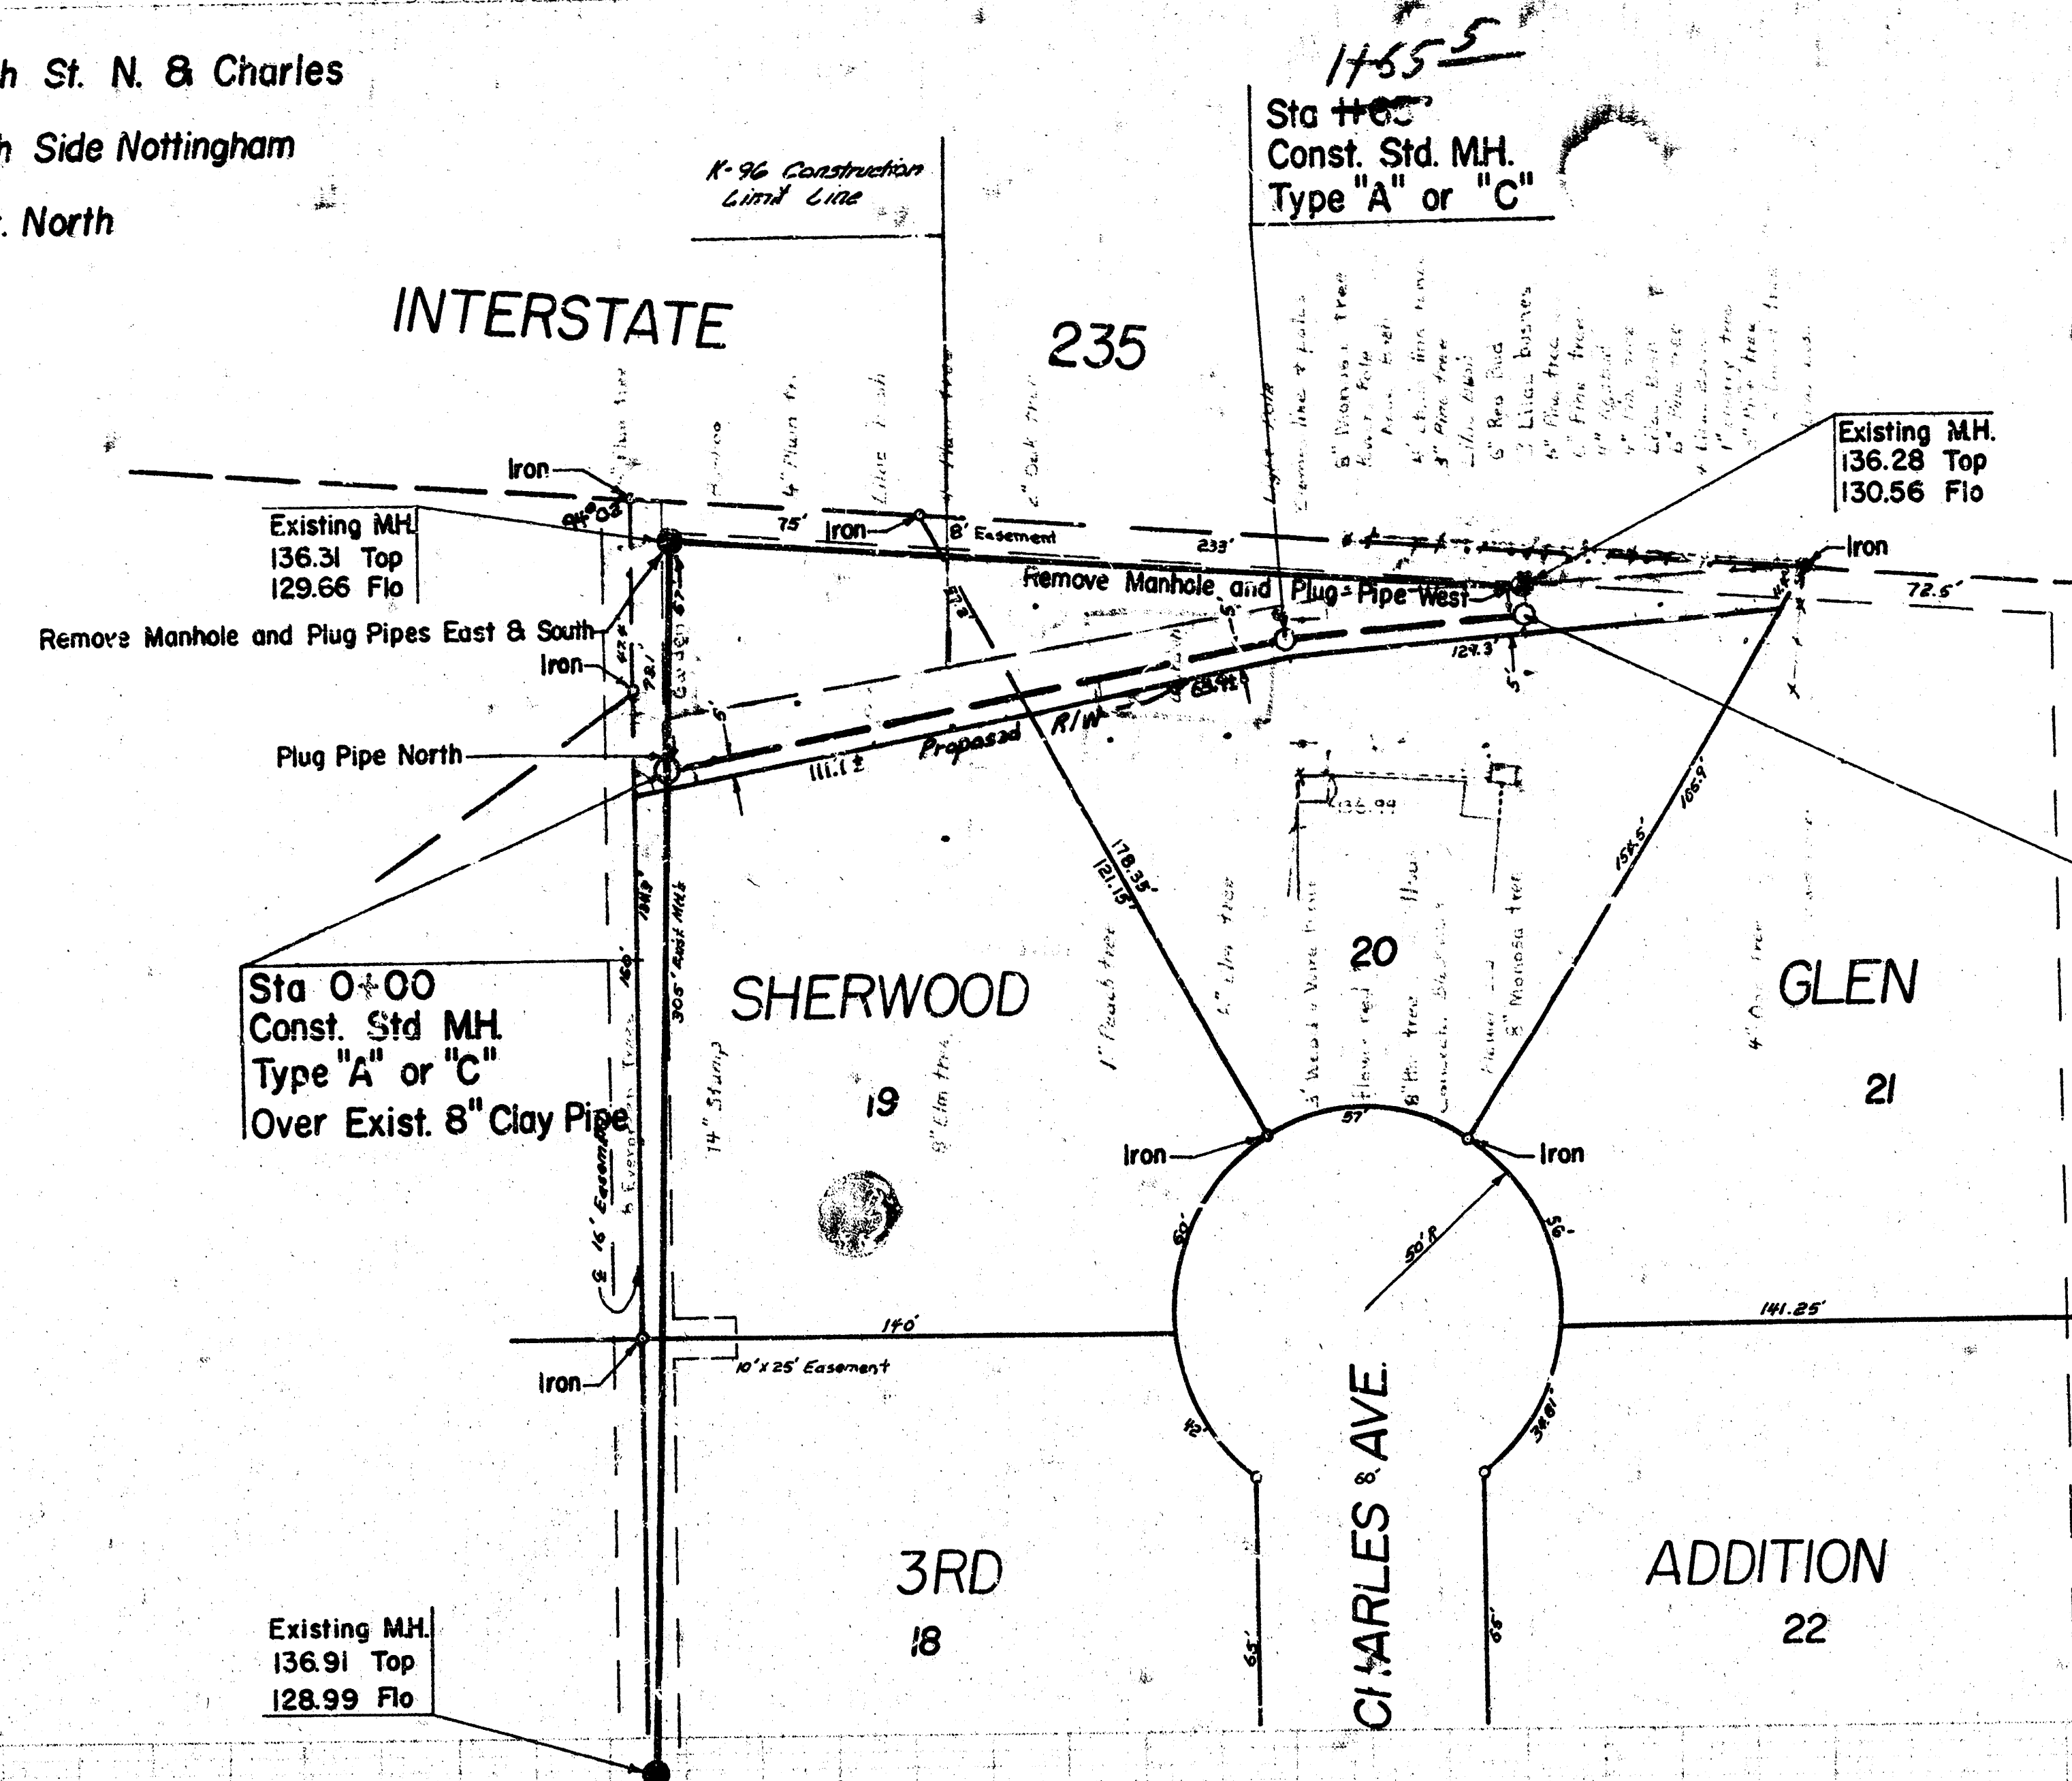

Highway R/W to be staked by State Highway Personnel

Plan Scale 1" = 40'
 Profile Scale 1" = 40' Horz.
 1" = 5' Vert.

NOTE: CONSTRUCTION OF THIS PROJECT SHALL BE
 COORDINATED WITH THE PURCHASE AND CLEARING OF
 RIGHT-OF-WAY FOR THE KANSAS DEPARTMENT OF
 TRANSPORTATION PROJECT FOR RELOCATING K-96
 HIGHWAY.


140
 135
 130
 125

140
 135
 130
 125


Sta 0+00
 Const. Std. MH
 Type "A" or "C"
 Over Exist. 8" Clay Pipe

Sta 1+65
 Const. Std. MH
 Type "A" or "C"

Sta 2+28
 Const. Std. MH
 Type "A" or "C"
 Install 4" Stub S.

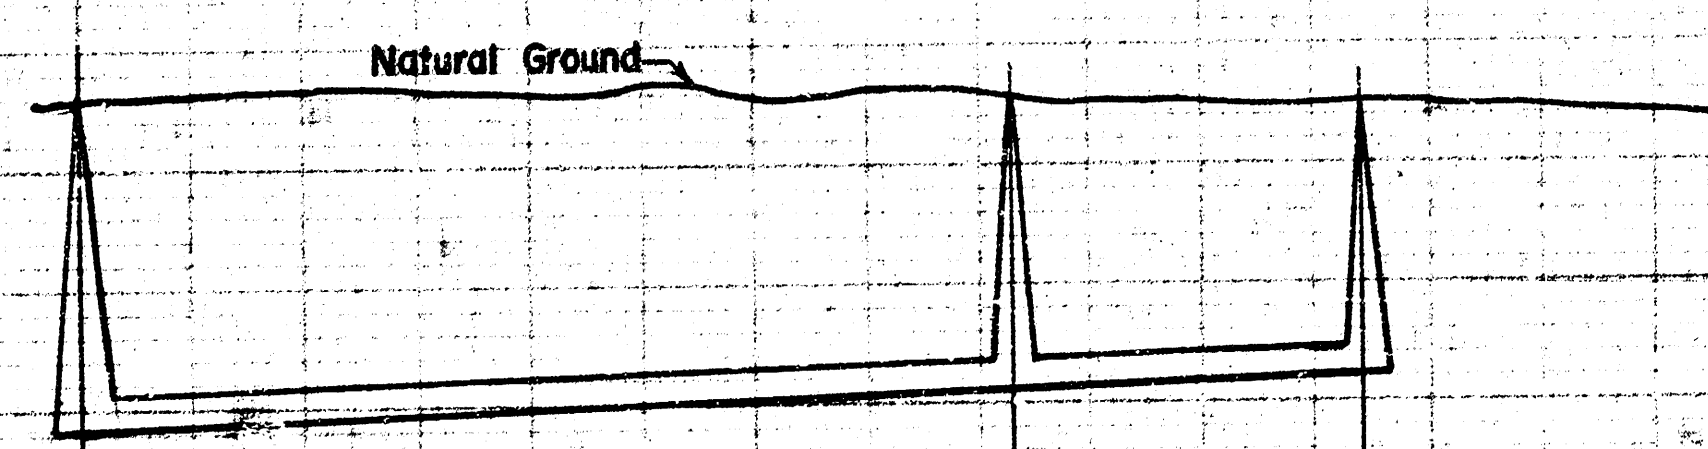


229 Lin. Ft. of 8" Clay Pipe @ 0.40% Grade
 AH. 8" ABS Composite Pipe


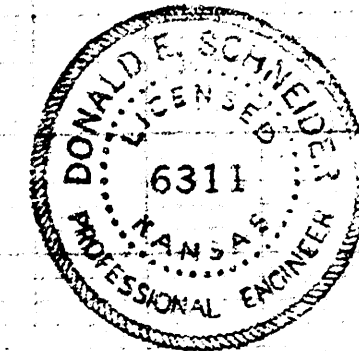


As built 4-8-77


RELOCATION OF PART OF LAT. 16
 SUBMAIN 21, S3. NO. 22
 CITY OF WICHITA, KANSAS
 R. W. LINN CITY ENGINEER
 JAN. 77 Project Number DAKR500580

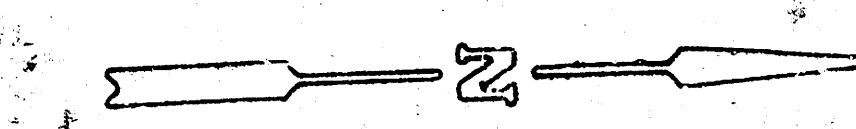

Plan Scale 1" = 40'
Profile Scale 1" = 40' Horiz.
1" = 5' Vert.

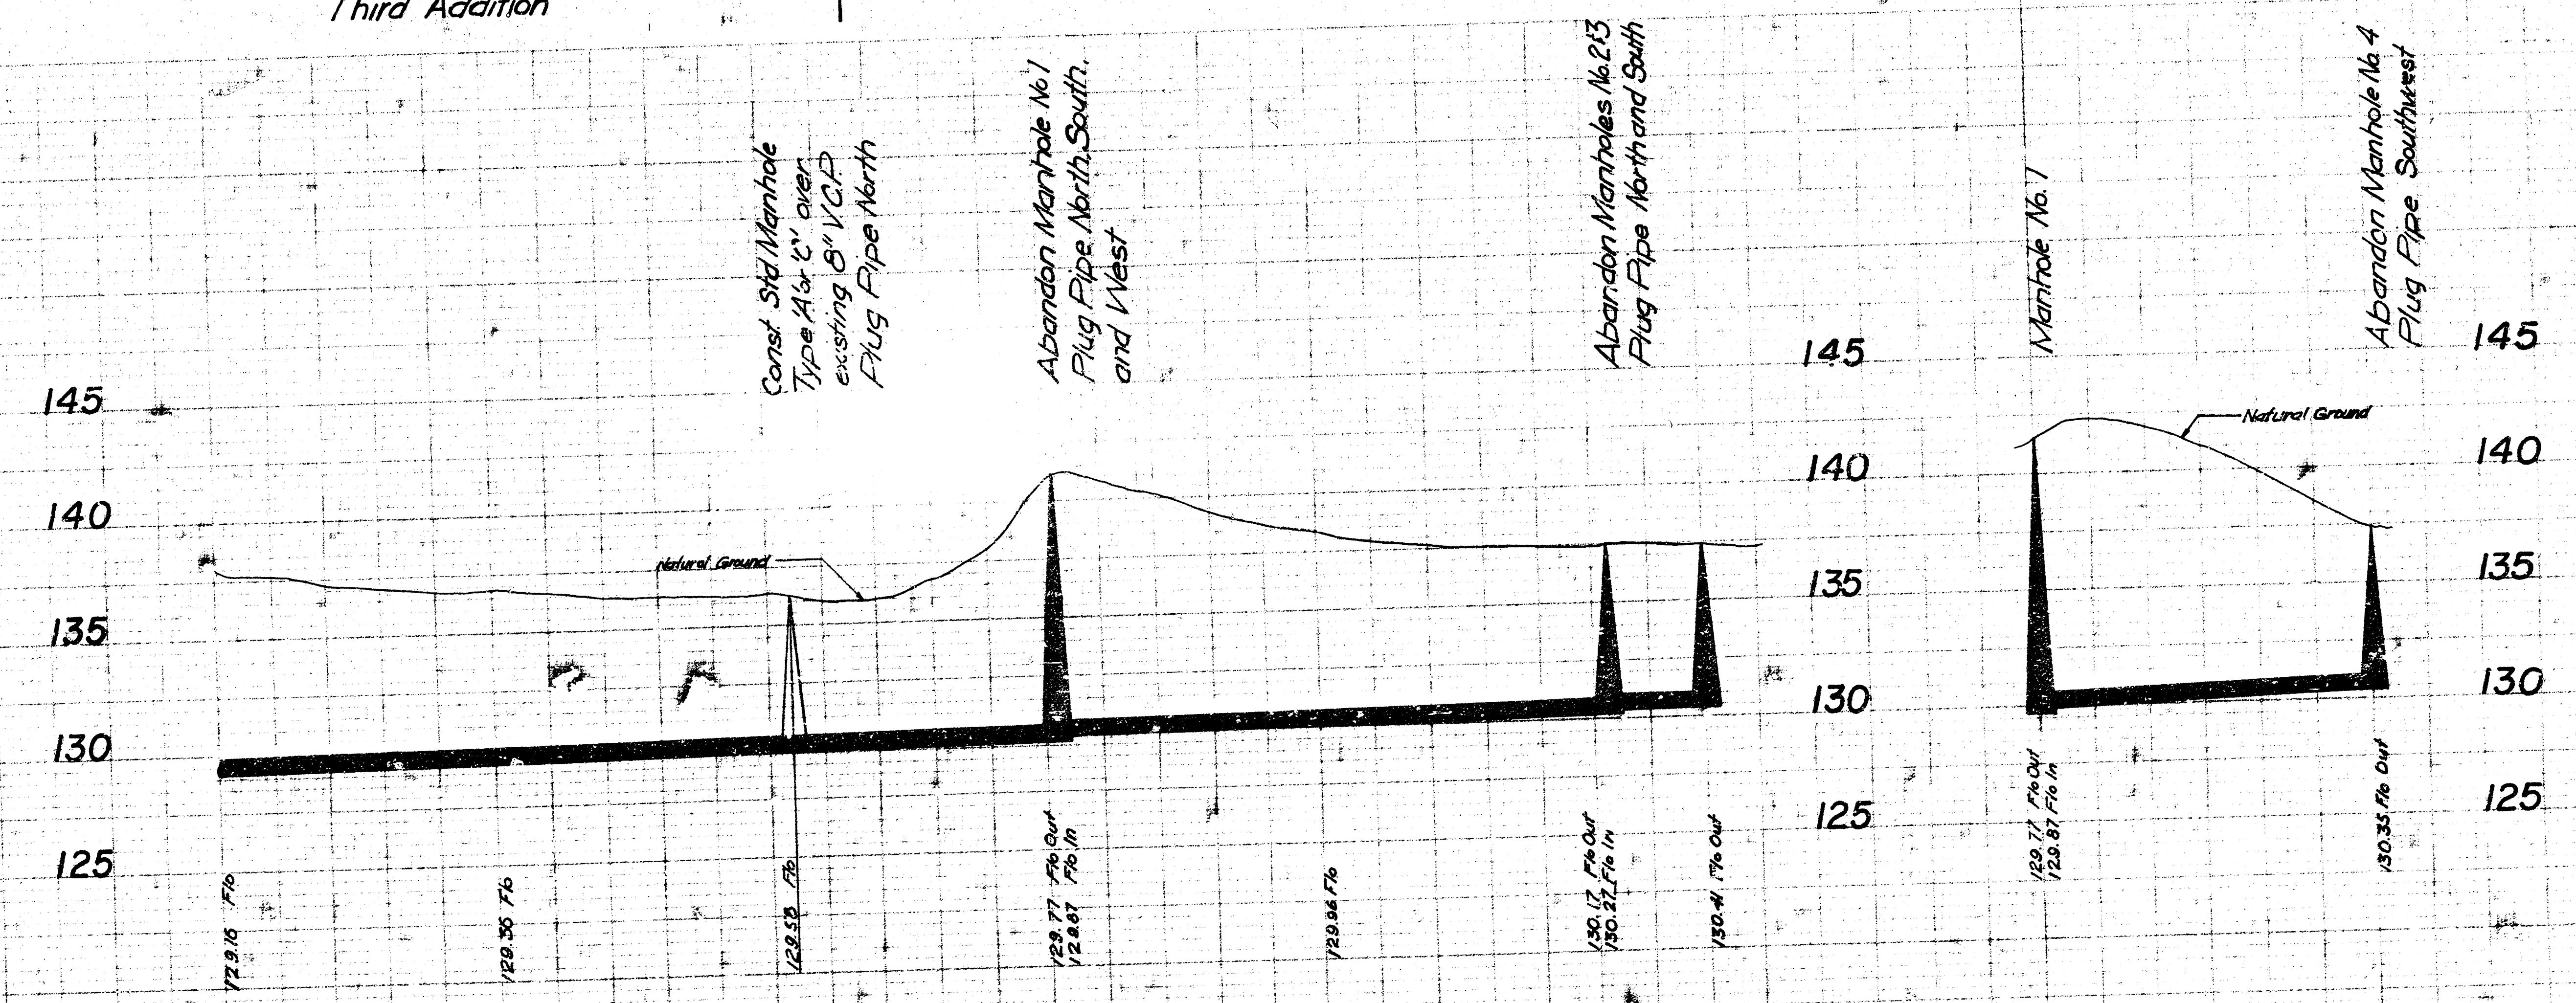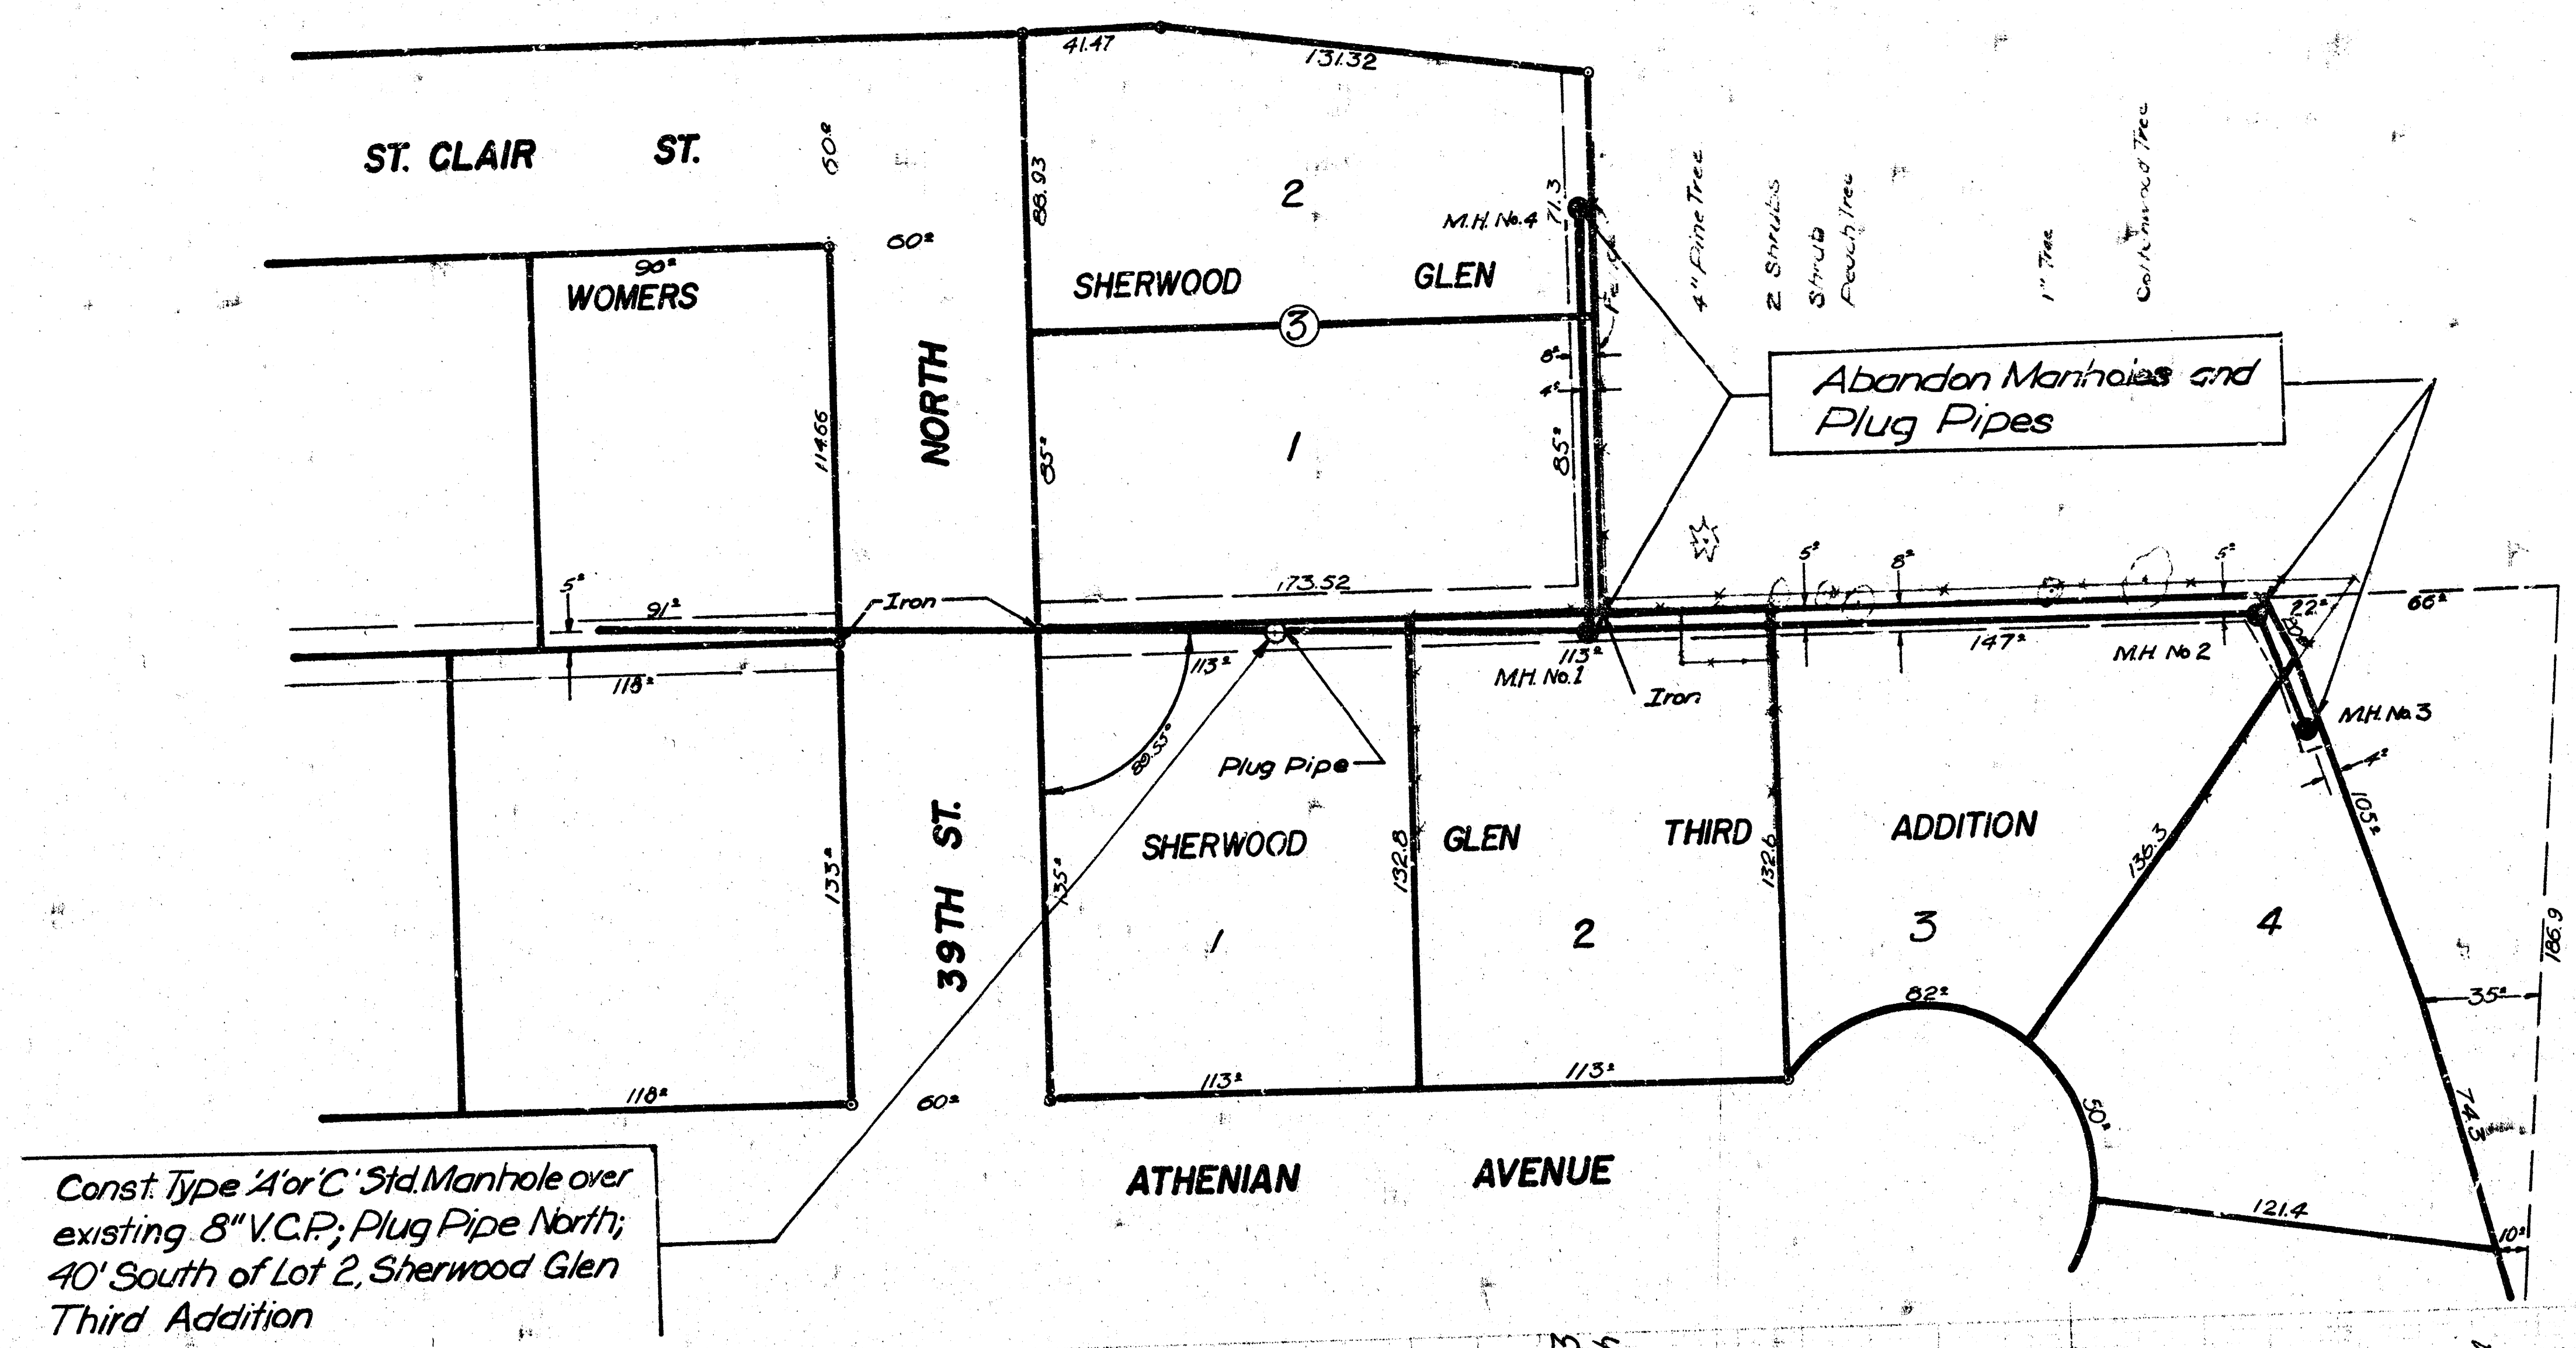


RELOCATION OF PART OF LAT 16
SUBMAIN 21, SS NO. 22
CITY OF WICHITA, KANSAS
R.W. LINN CITY ENGINEER
DATE: JAN. 17 PROJECT NO. DAKR500580

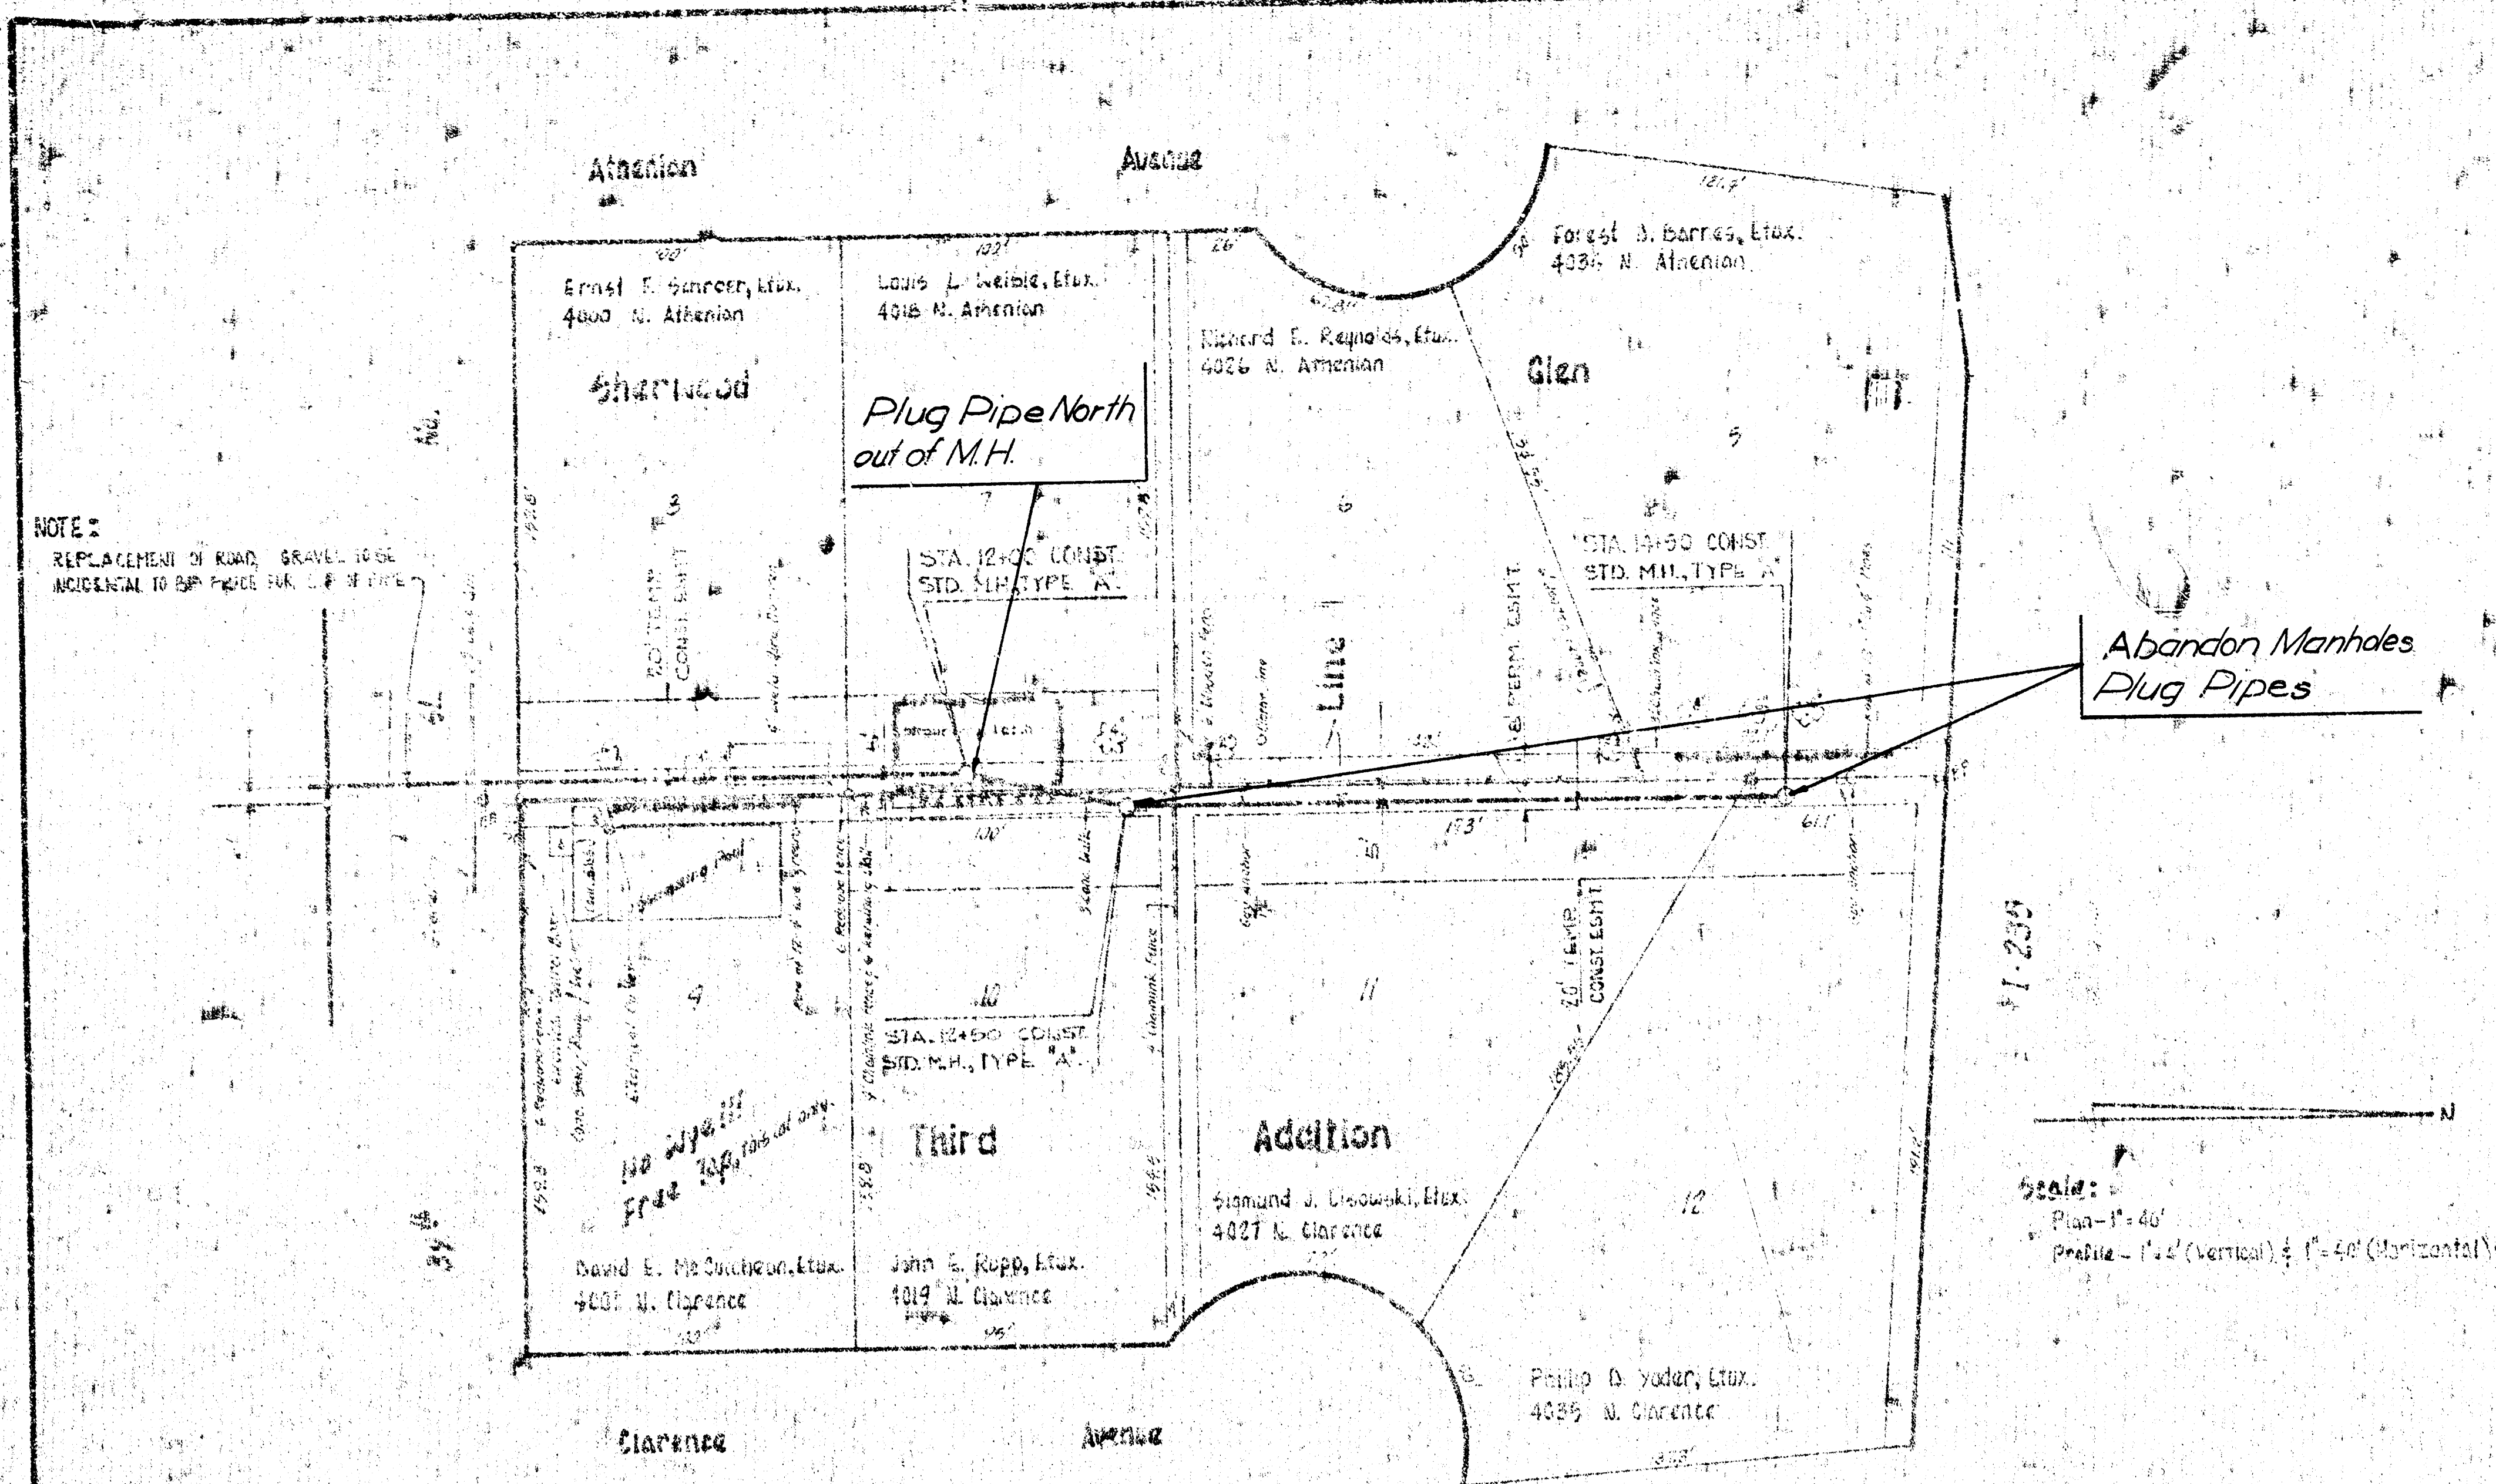

NOTE 2
REPLACEMENT OF ROAD GRAVEL SHALL BE INCIDENTAL TO THE PRICE FOR L.F. OF PIPE.

NOTE 3
COST OF REMOVAL & REPLACEMENT OF RETAINING WALL UNDER TENSE SHALL BE INCIDENTAL TO THE PRICE FOR L.F. OF PIPE REMOVED & L.F. OF PIPE REPLACED.

NOTE: THE WORK INDICATED AS MANHOLES ABANDONED SHALL CONSIST OF REMOVING THE TOP 4" OF THE MANHOLE AND FILLING THE MANHOLE WITH SAND EXCEPT FOR THE TOP TWO FEET OF THE EXCAVATION WHICH SHALL BE BACKFILLED WITH MATERIAL SIMILAR TO THE ADJACENT GROUND. ALL PIPES IN MANHOLES TO BE ABANDONED SHALL BE PLUGGED. MANHOLE CASTINGS SHALL BE SALVAGED AND DELIVERED TO THE CITY'S MATERIAL YARD.

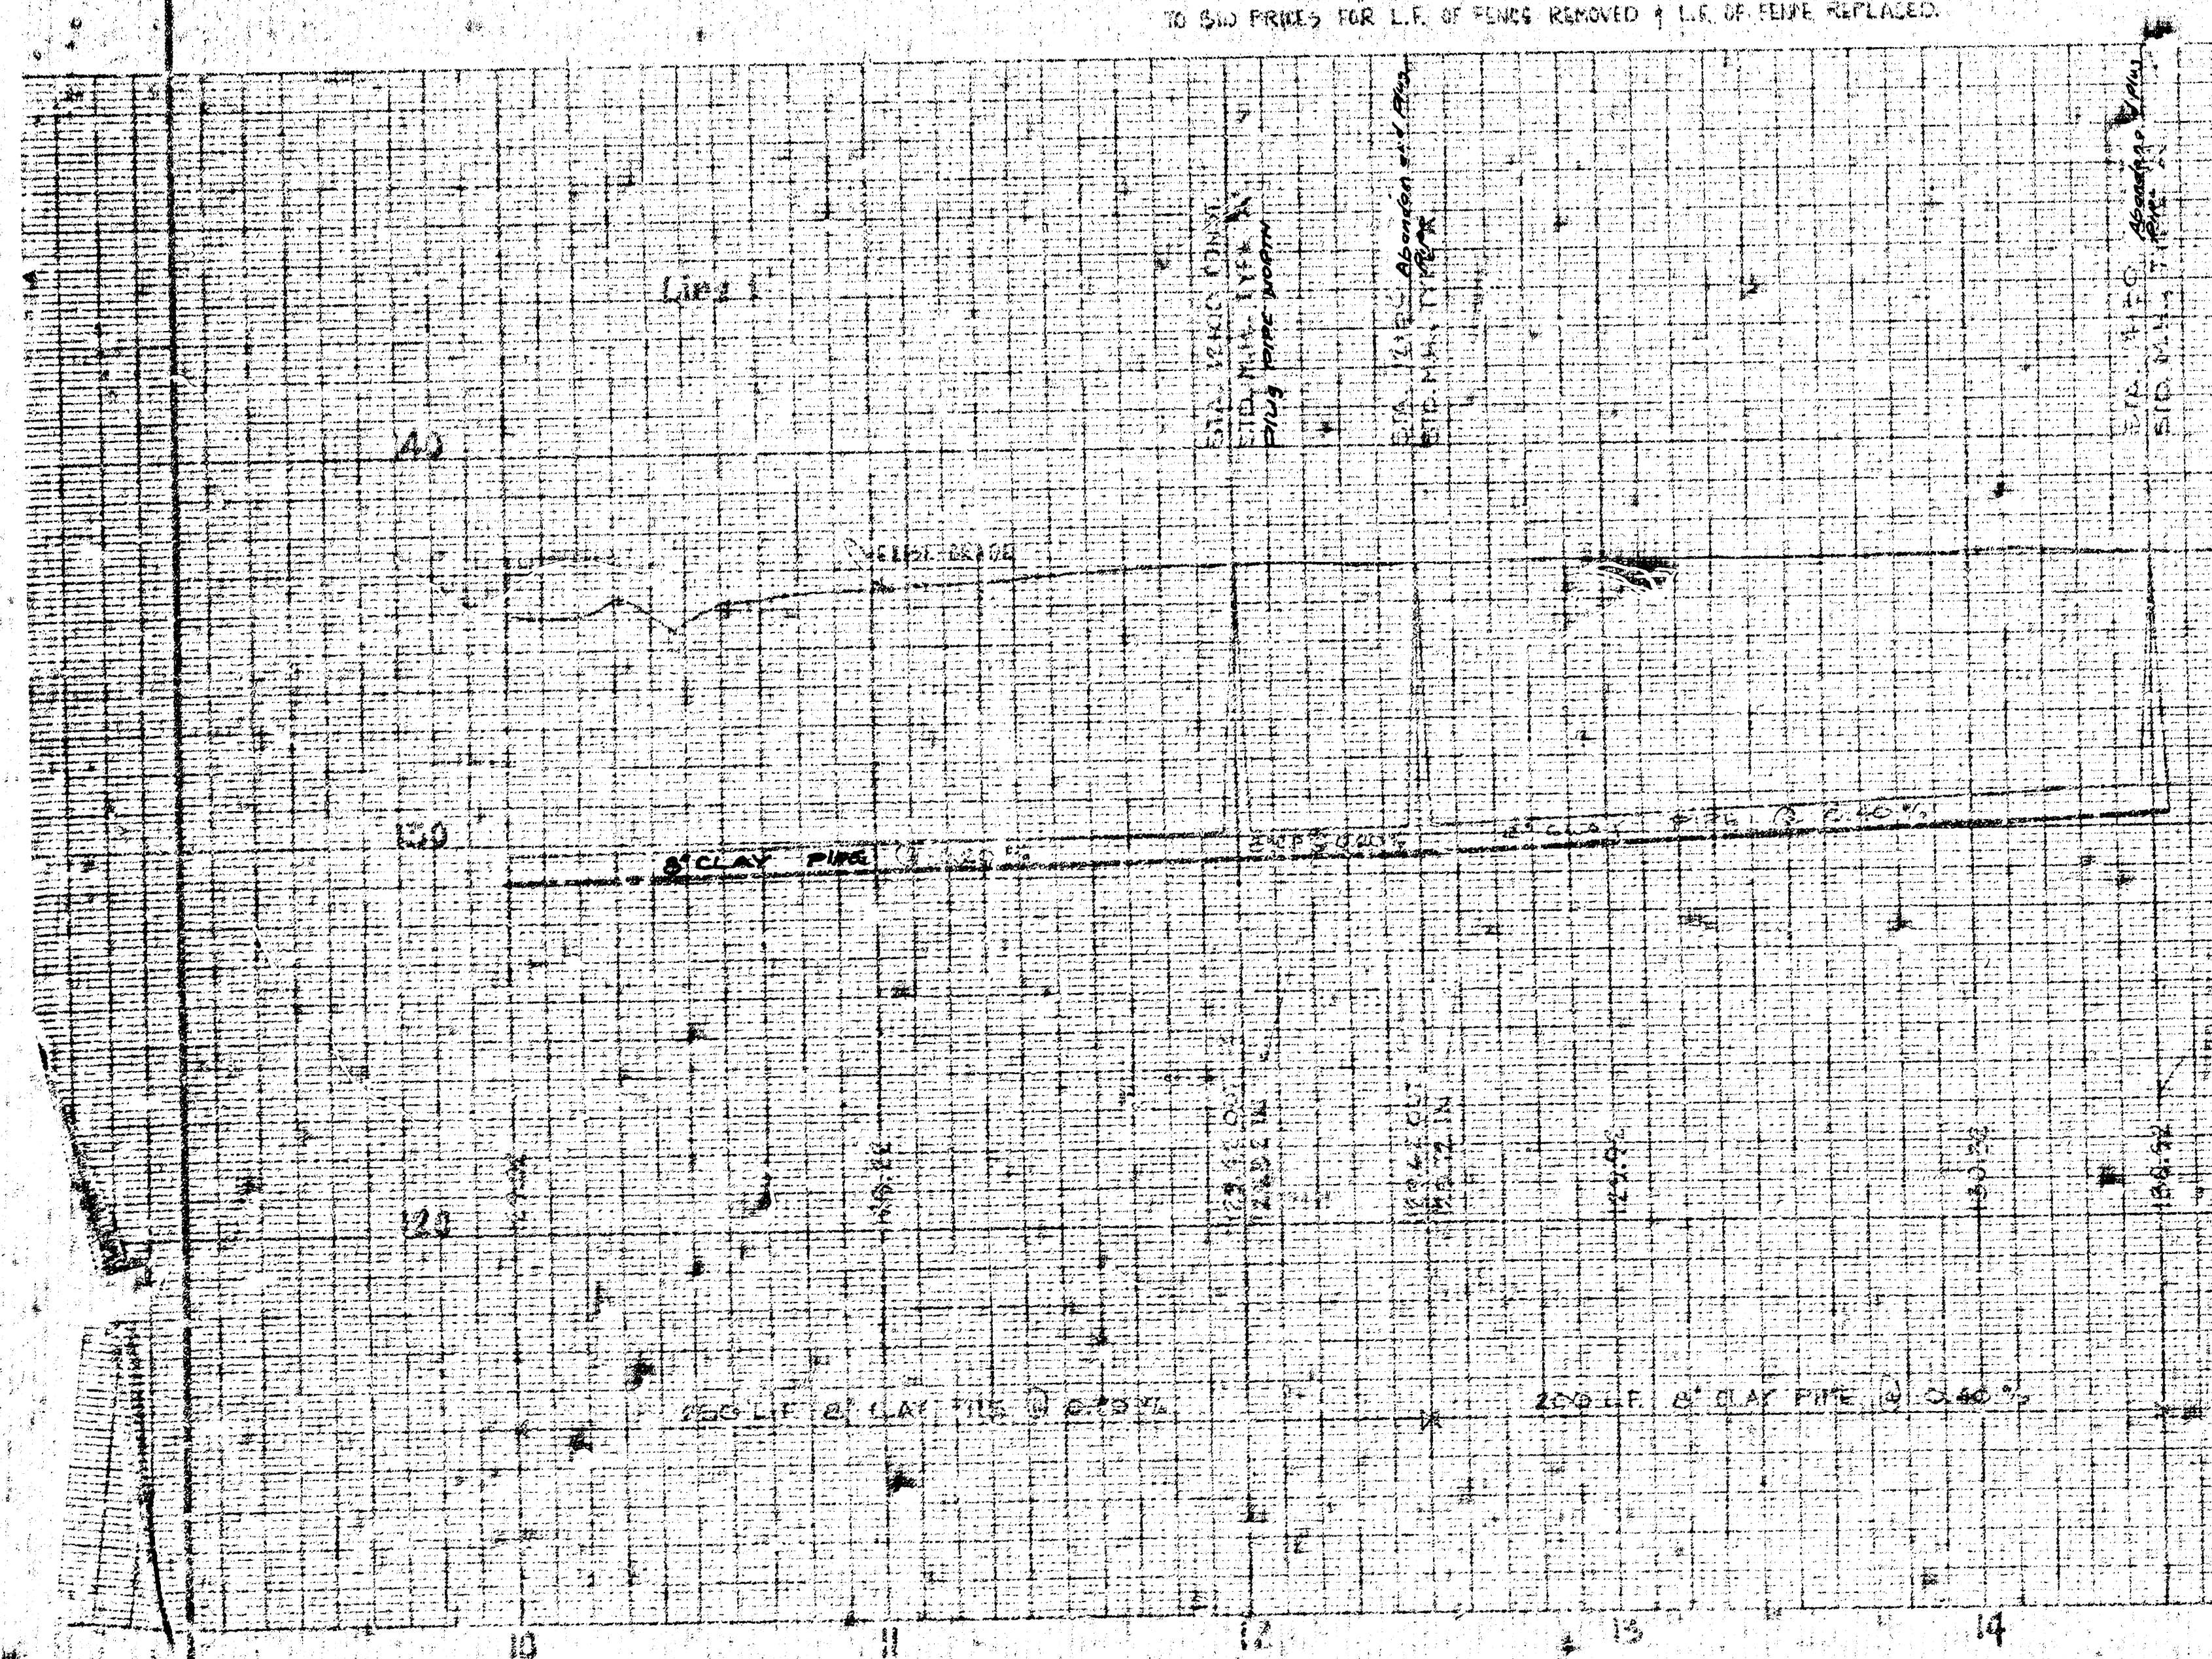

RELOCATION OF PART OF LAT 16
SUBMAIN 21, SS NO. 22
CITY OF WICHITA, KANSAS
R.W. LINN CITY ENGINEER
DATE: Jan. 77 PROJECT NO. DAKR50058C