


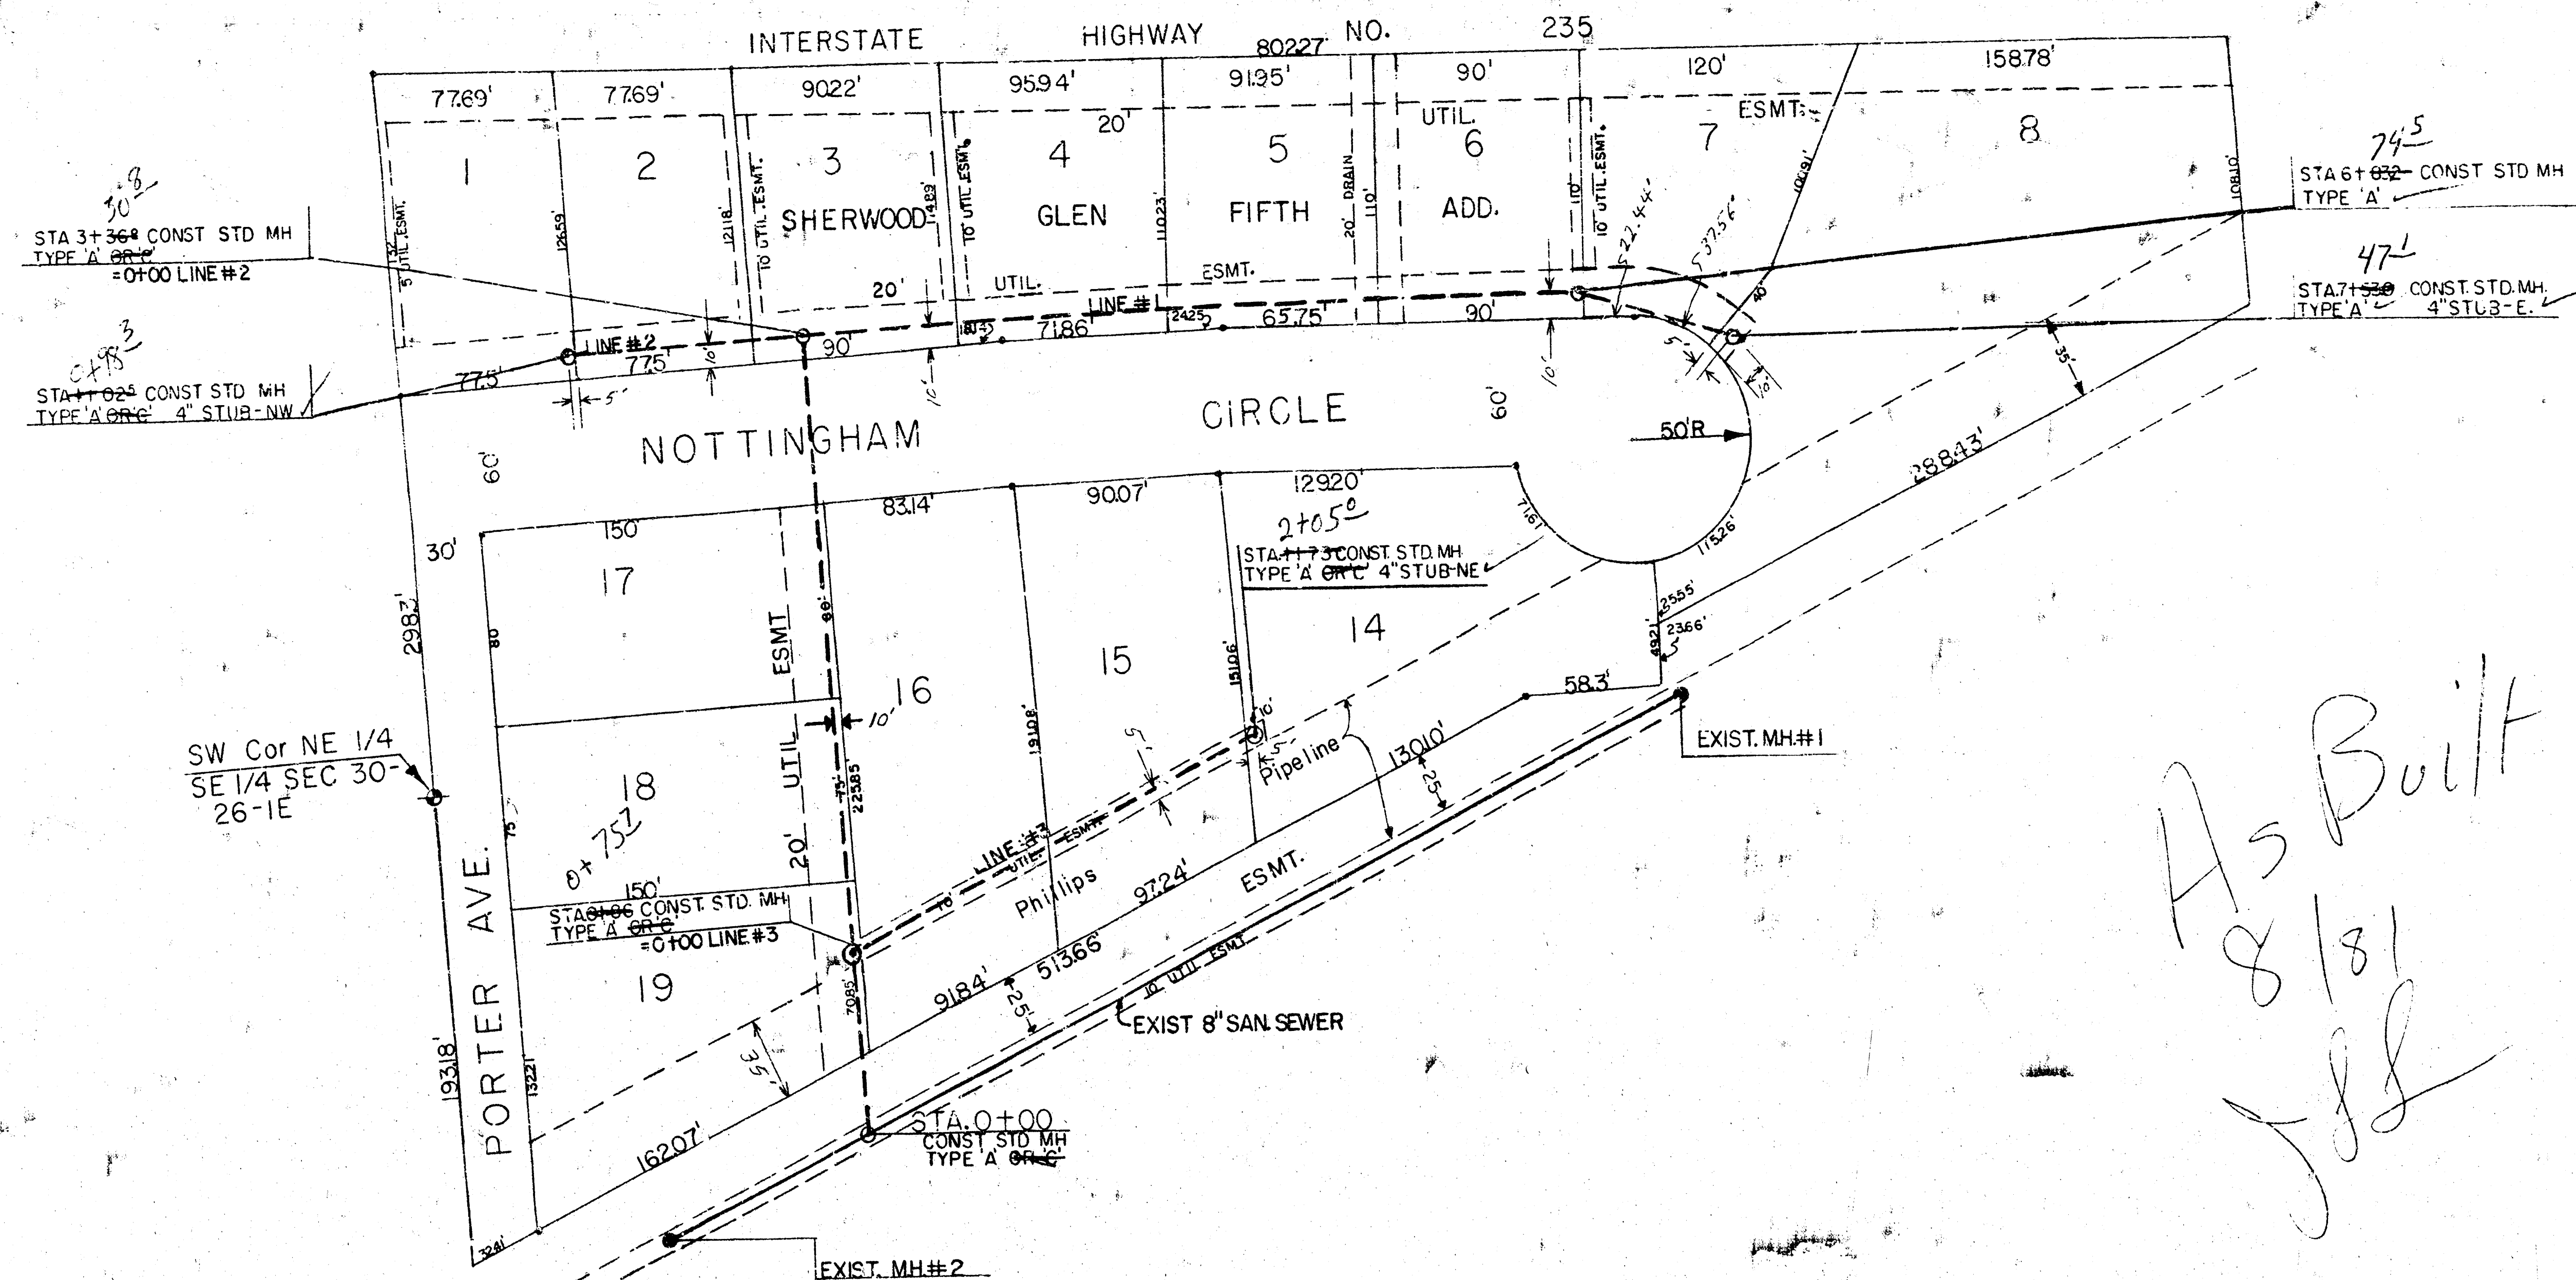


PLAN SCALE 1" = 50'
 PROFILE SCALE 1" = 50' HORZ
 1" = 5' VERT

As Built
 8/18/1
 J88

BM 13520 "M" in Muller E Side water hydrant at SW cor Nottingham & Porter.

BM 13468 "T" Top of W curb of Garland Cir approx 2' S of SL Sherwood Glen Sth Add'n.

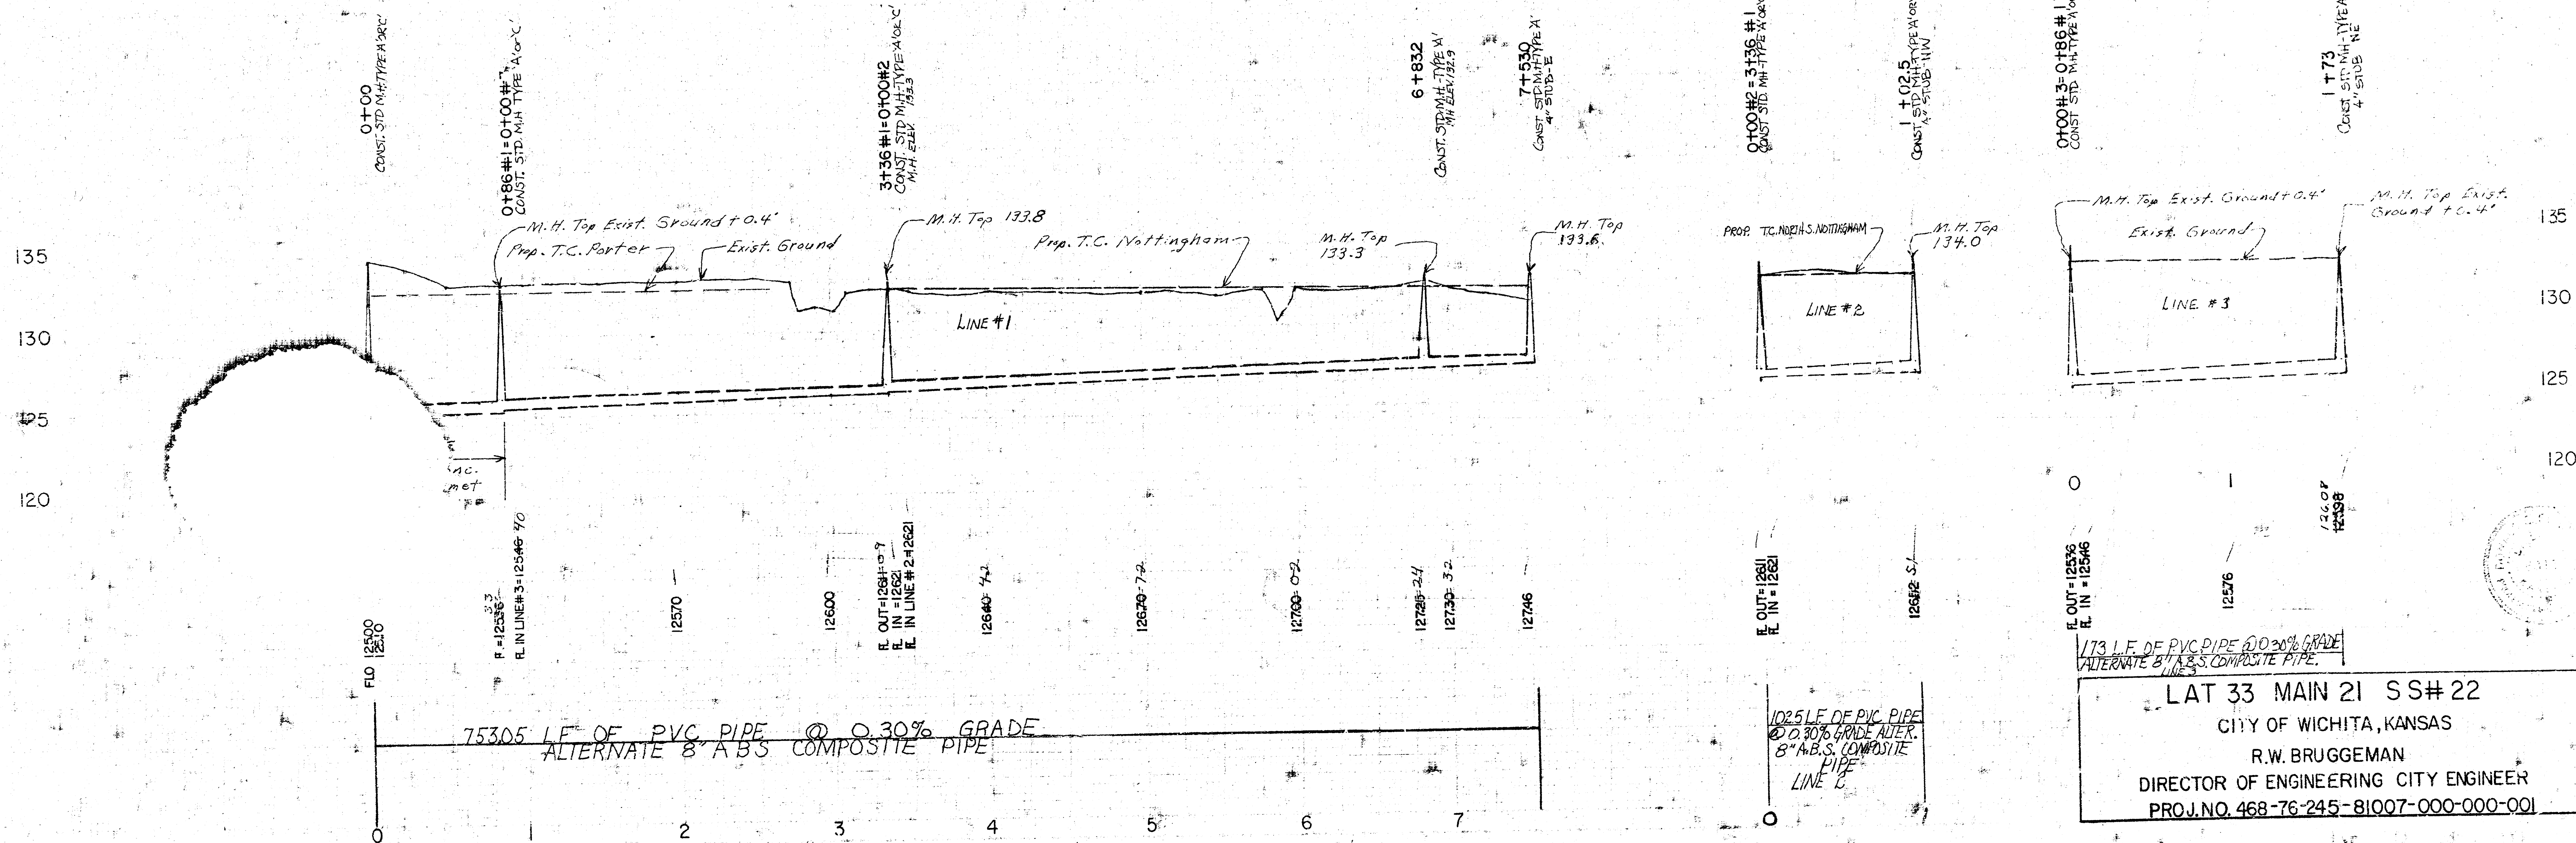

LAT 33 MAIN 21 SS# 22
 CITY OF WICHITA, KANSAS
 R.W. BRUGGEMAN
 DIRECTOR OF ENGINEERING CITY ENGINEER
 PROJ. NO. 468-76-245-81007-000-000-001