


D. DULLEA  
J. LINDSEY

D. DULLEA  
J. LINDSEY

D. DULLEA  
J. LINDSEY

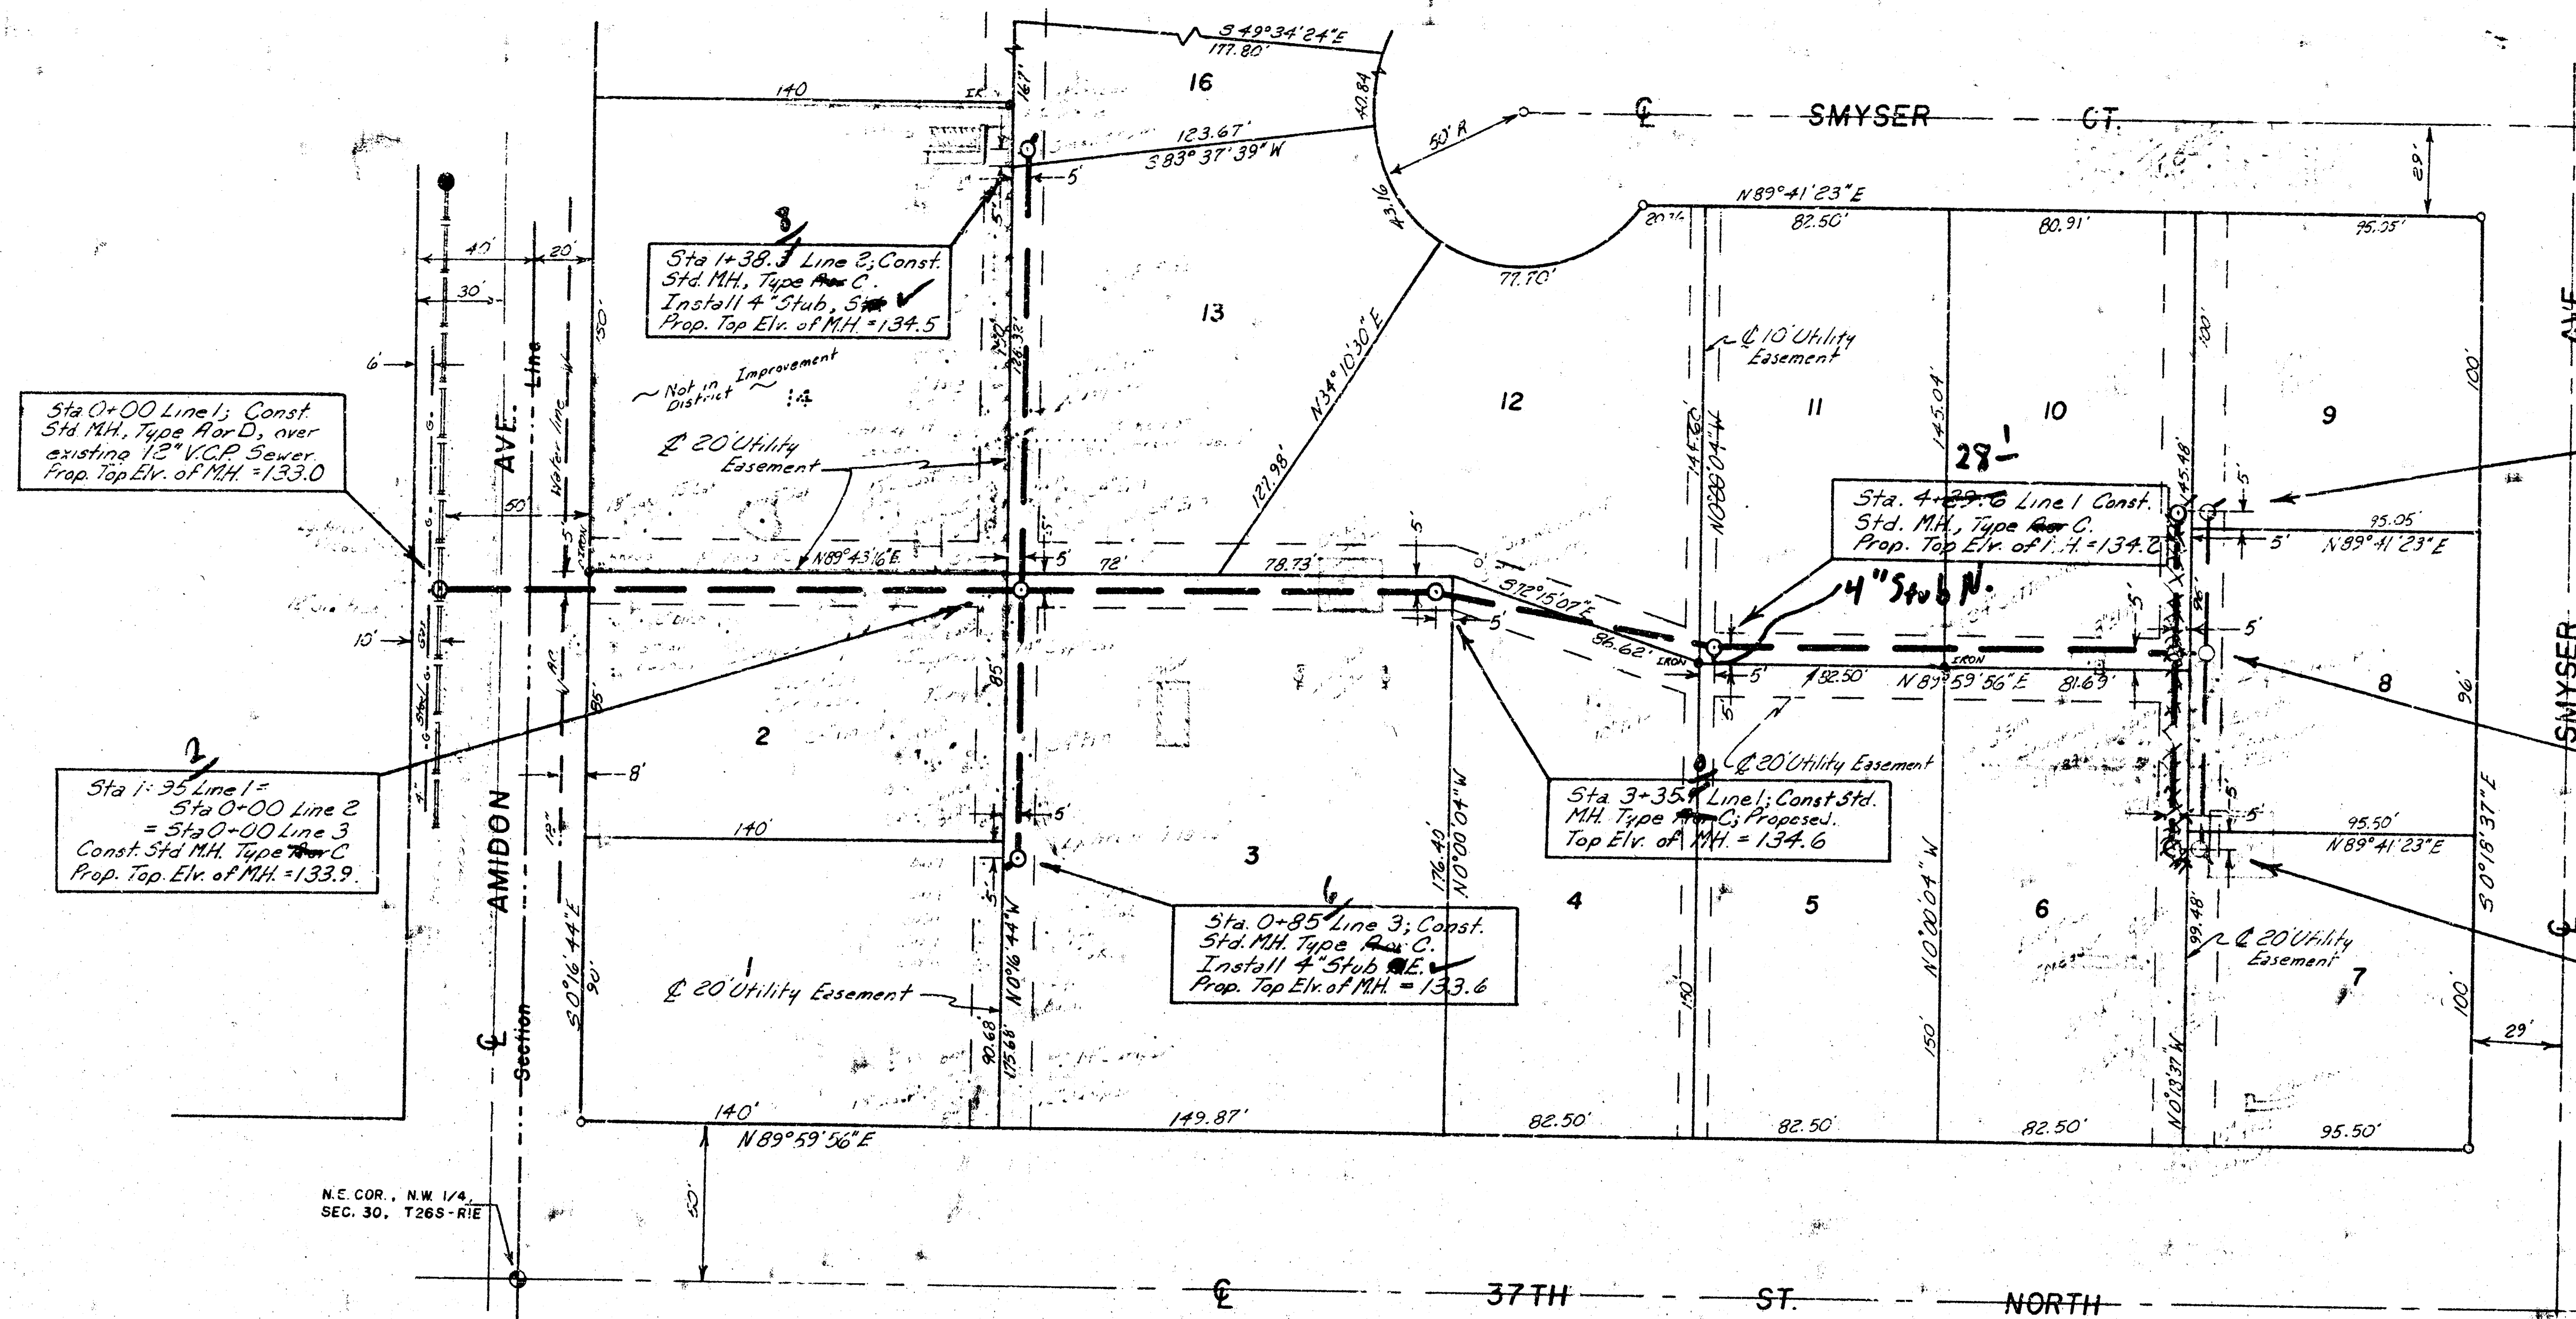

SHERWOOD ESTATES ADDITION  
10  
WICHITA, SEDGWICK COUNTY, KANSAS


Scale:  
1" = 40' Plan  
1" = 40' Horiz.  
1" = 5' Vert. Profile

Note: Any tree in which in the opinion of the engineer can be saved shall be spared.

CAUTION  
UNDERGROUND UTILITIES

THE ENGINEER SHALL BE RESPONSIBLE FOR THE LOCATION OF ALL UTILITIES. THE CONTRACTOR SHALL BE RESPONSIBLE FOR THE PROTECTION OF ALL UTILITIES. ANY DAMAGE TO UTILITIES SHALL BE REPAIRED BY THE CONTRACTOR AT HIS OWN EXPENSE. THE CONTRACTOR SHALL BE RESPONSIBLE FOR THE PROTECTION OF ALL UTILITIES. ANY DAMAGE TO UTILITIES SHALL BE REPAIRED BY THE CONTRACTOR AT HIS OWN EXPENSE.

Bench Marks: 133.39 - City Sta. 1+39.5 and 52' S. of  
Smyser St. & Amidon  
135.53 - S.E. Cor. of Front Conc. Arch at  
3501 N. Clarence

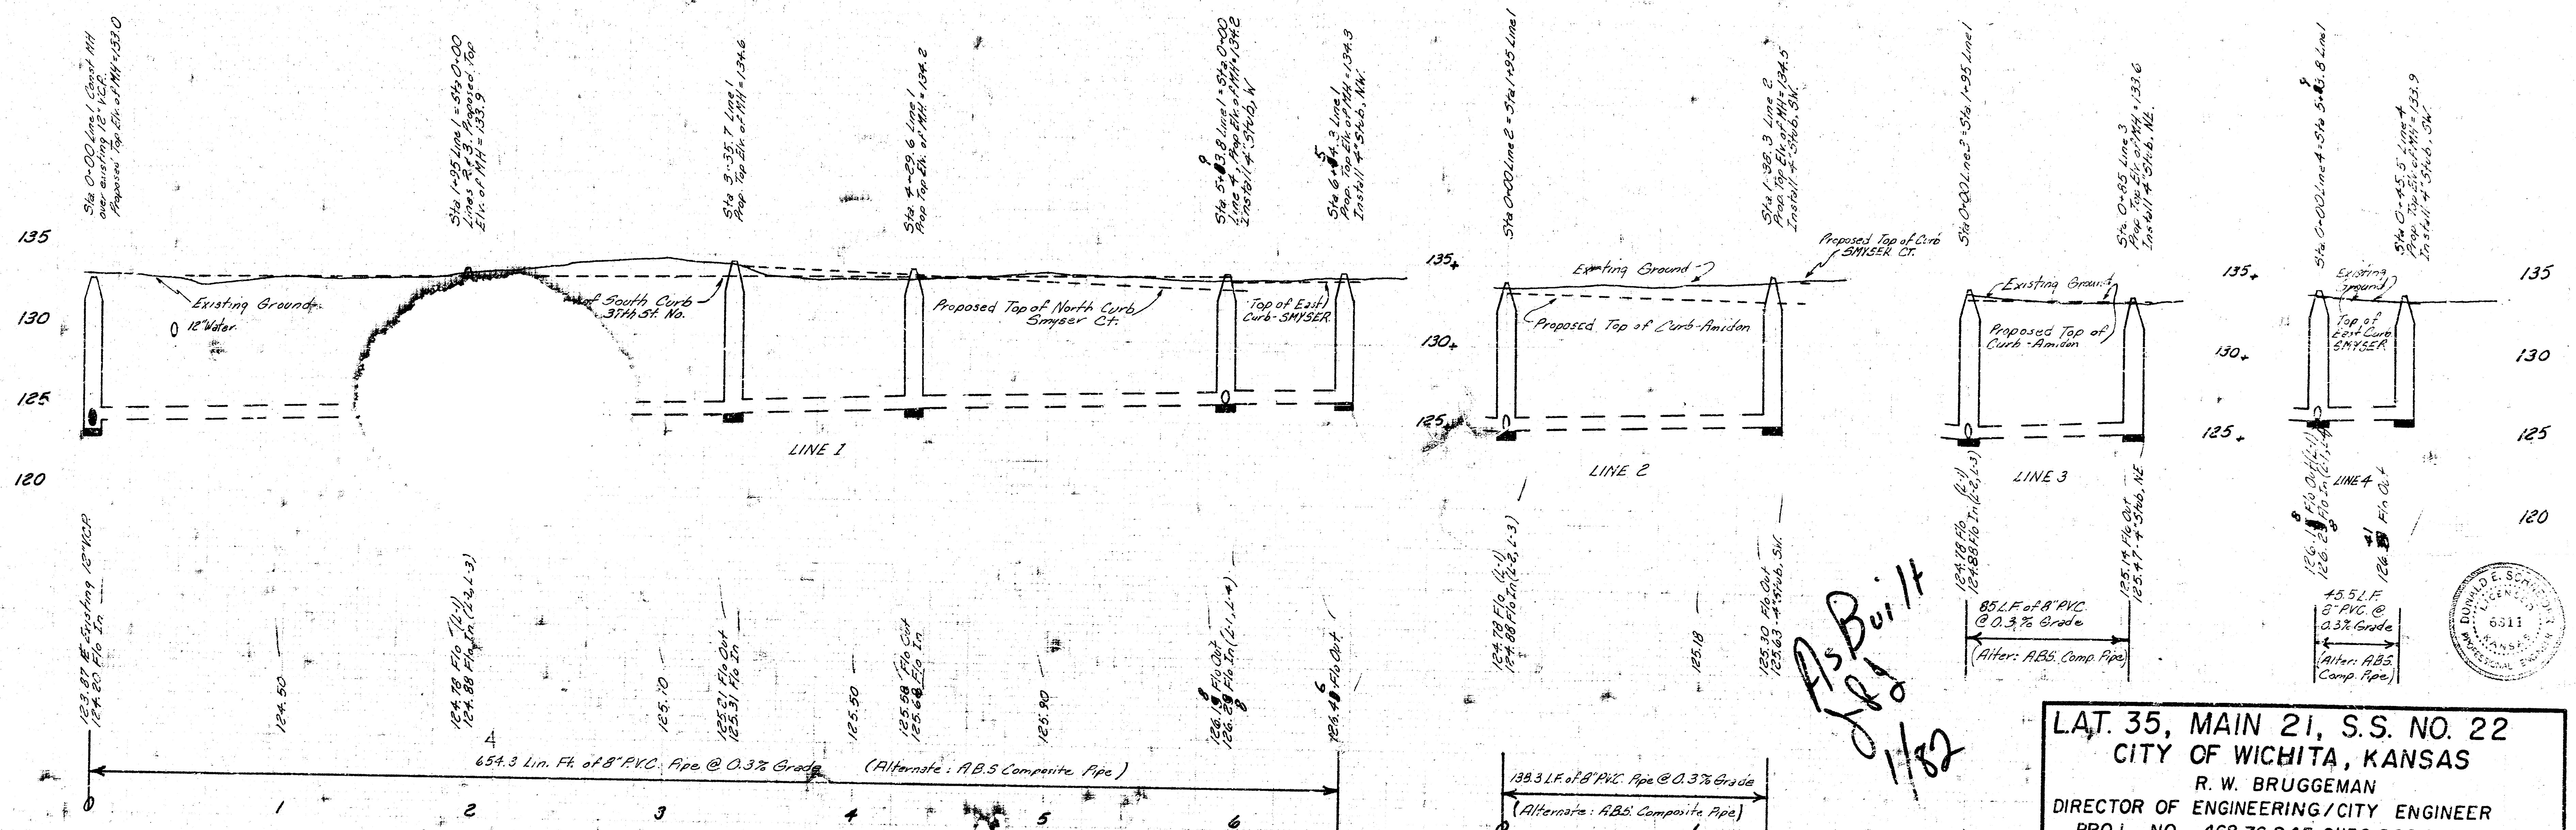

As Built  
JLB  
1/82

LAT. 35, MAIN 21, S.S. NO. 22  
CITY OF WICHITA, KANSAS  
R. W. BRUGGEMAN  
DIRECTOR OF ENGINEERING/CITY ENGINEER  
PROJ. NO. 468-75-245-81136-000-001  
DATE \_\_\_\_\_ SHEET 1 of 1