



PLAN
NOTE BOOK
156 241
2000

PROFILE
NOTE BOOK
156 241
2000

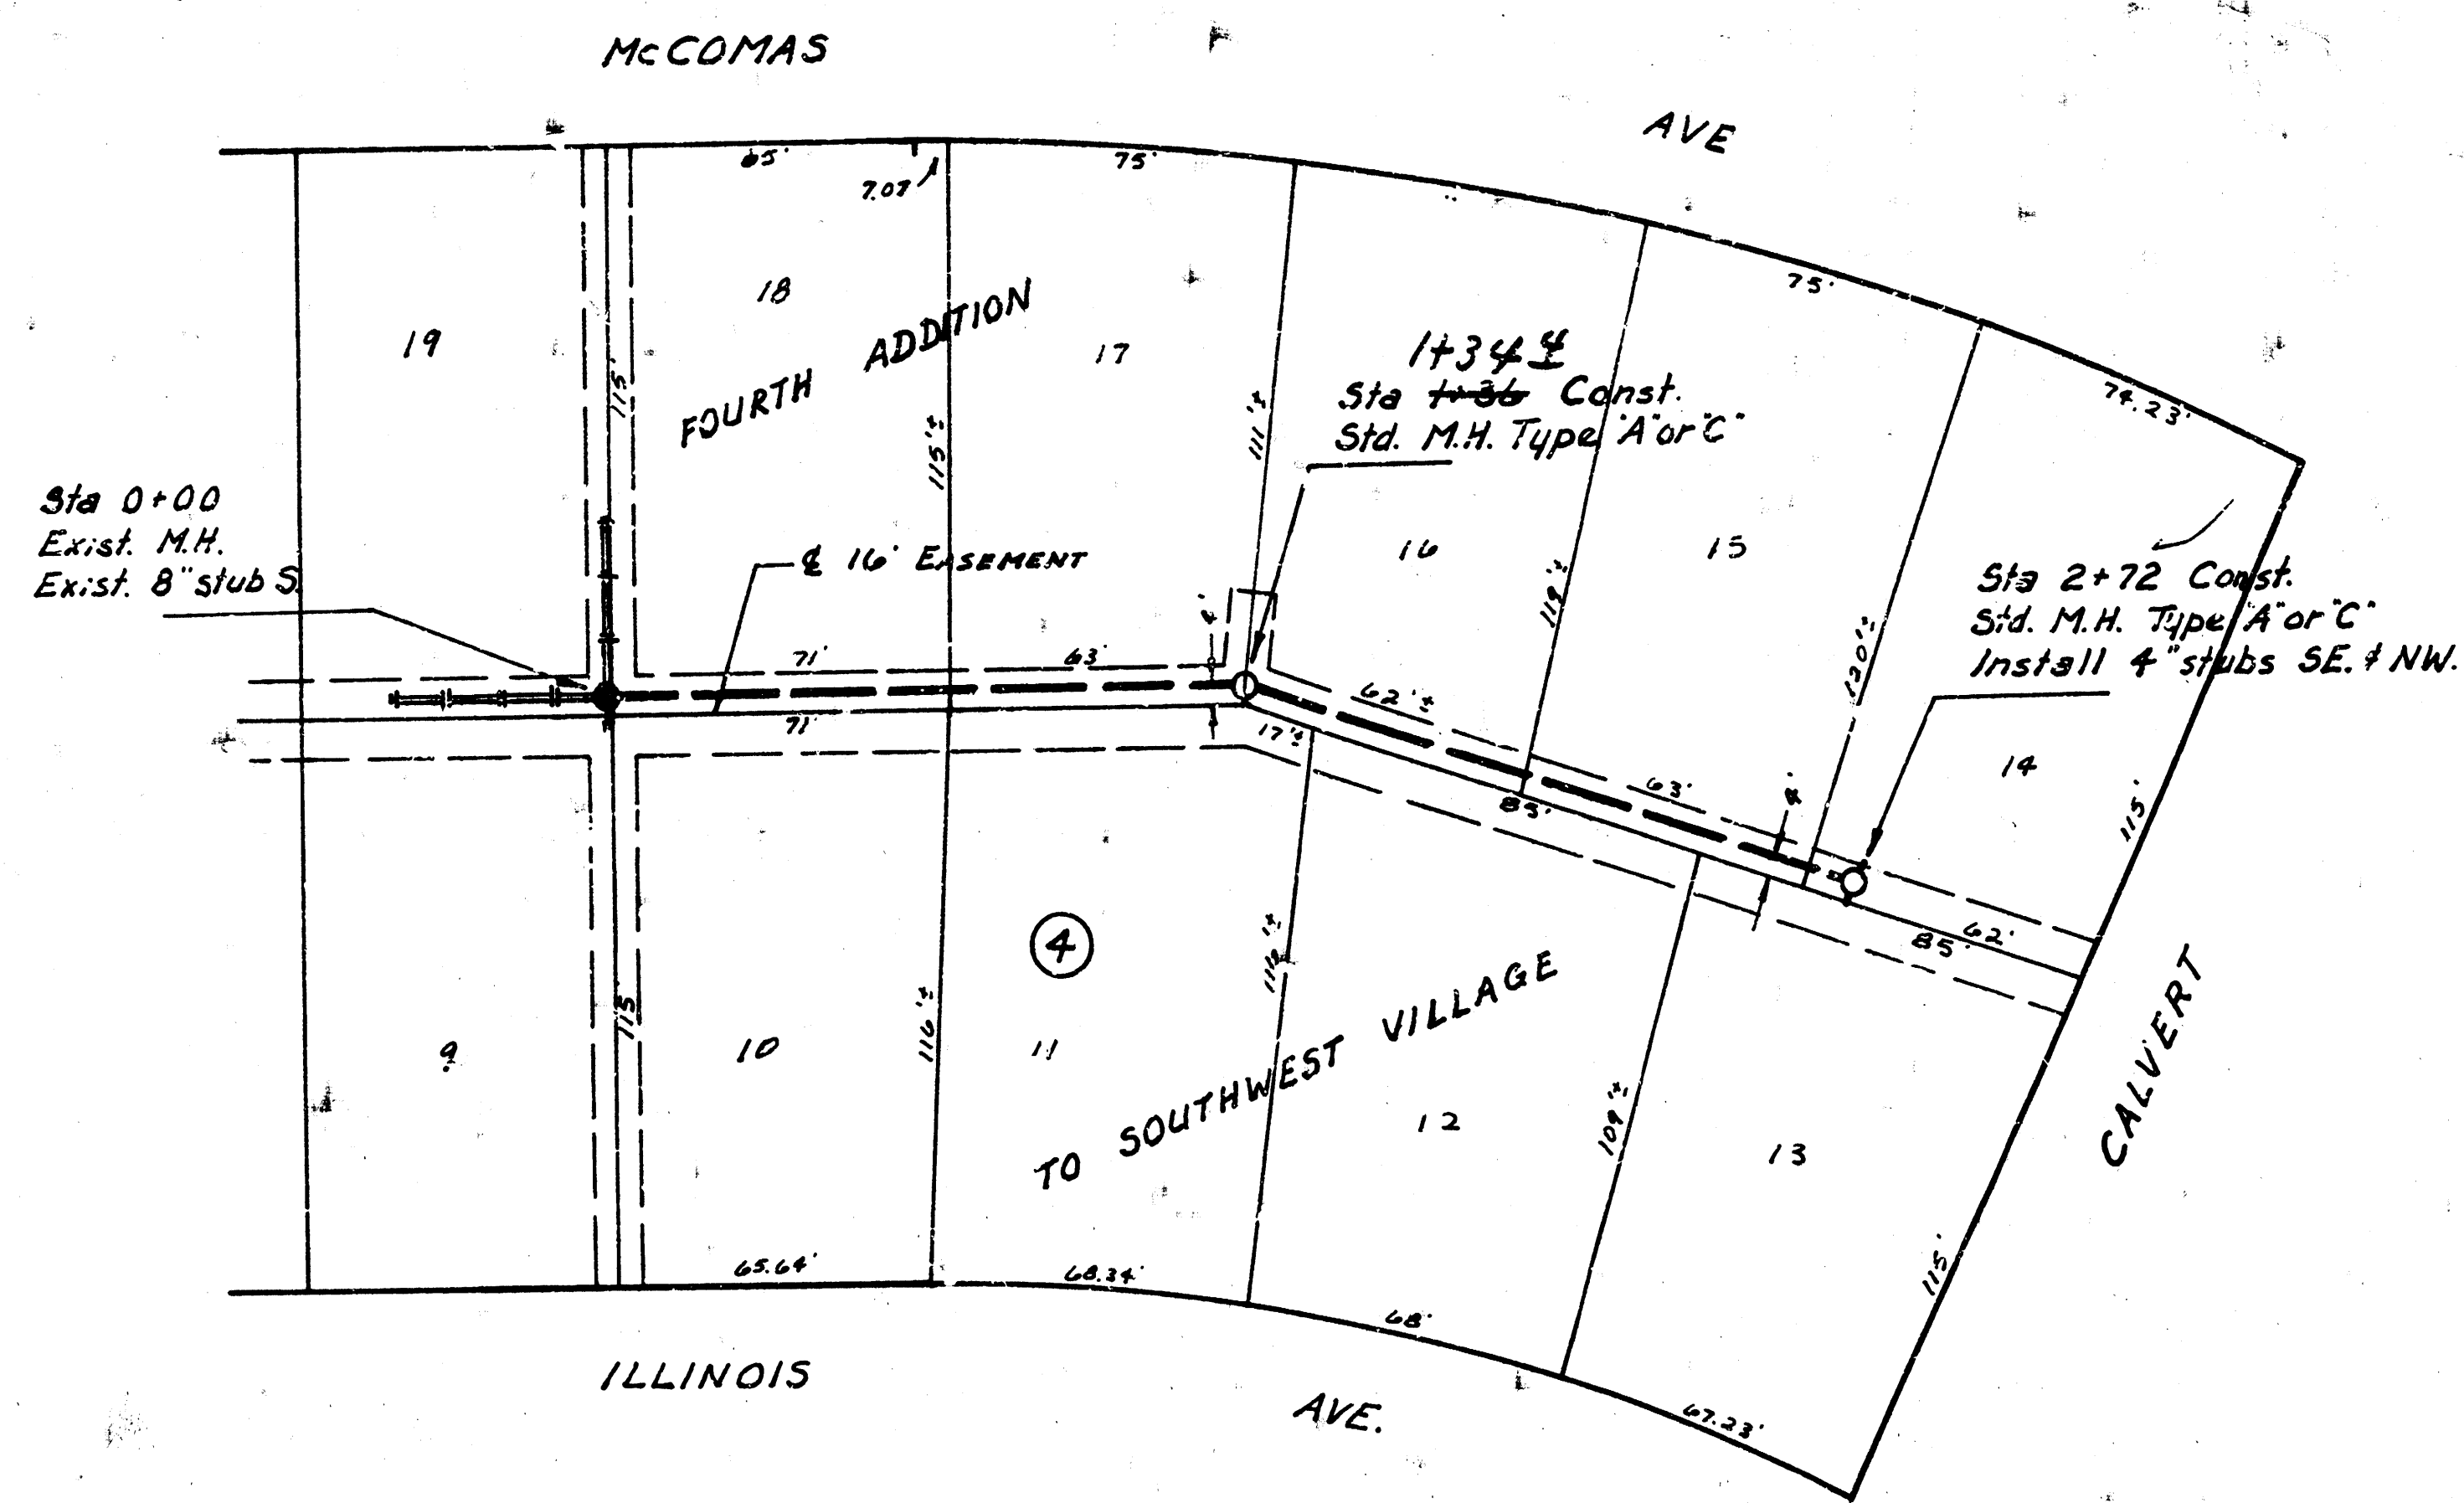

B.M. 103.47 City Sid. 53' E. & 44' S.
of & West St. & 314' St. So.

B.M. 100.80 "B" cut on NW corner of
East Headwall to R.C.B. just N. of
81' 34" Pass S. of 314' St. So. on West St.

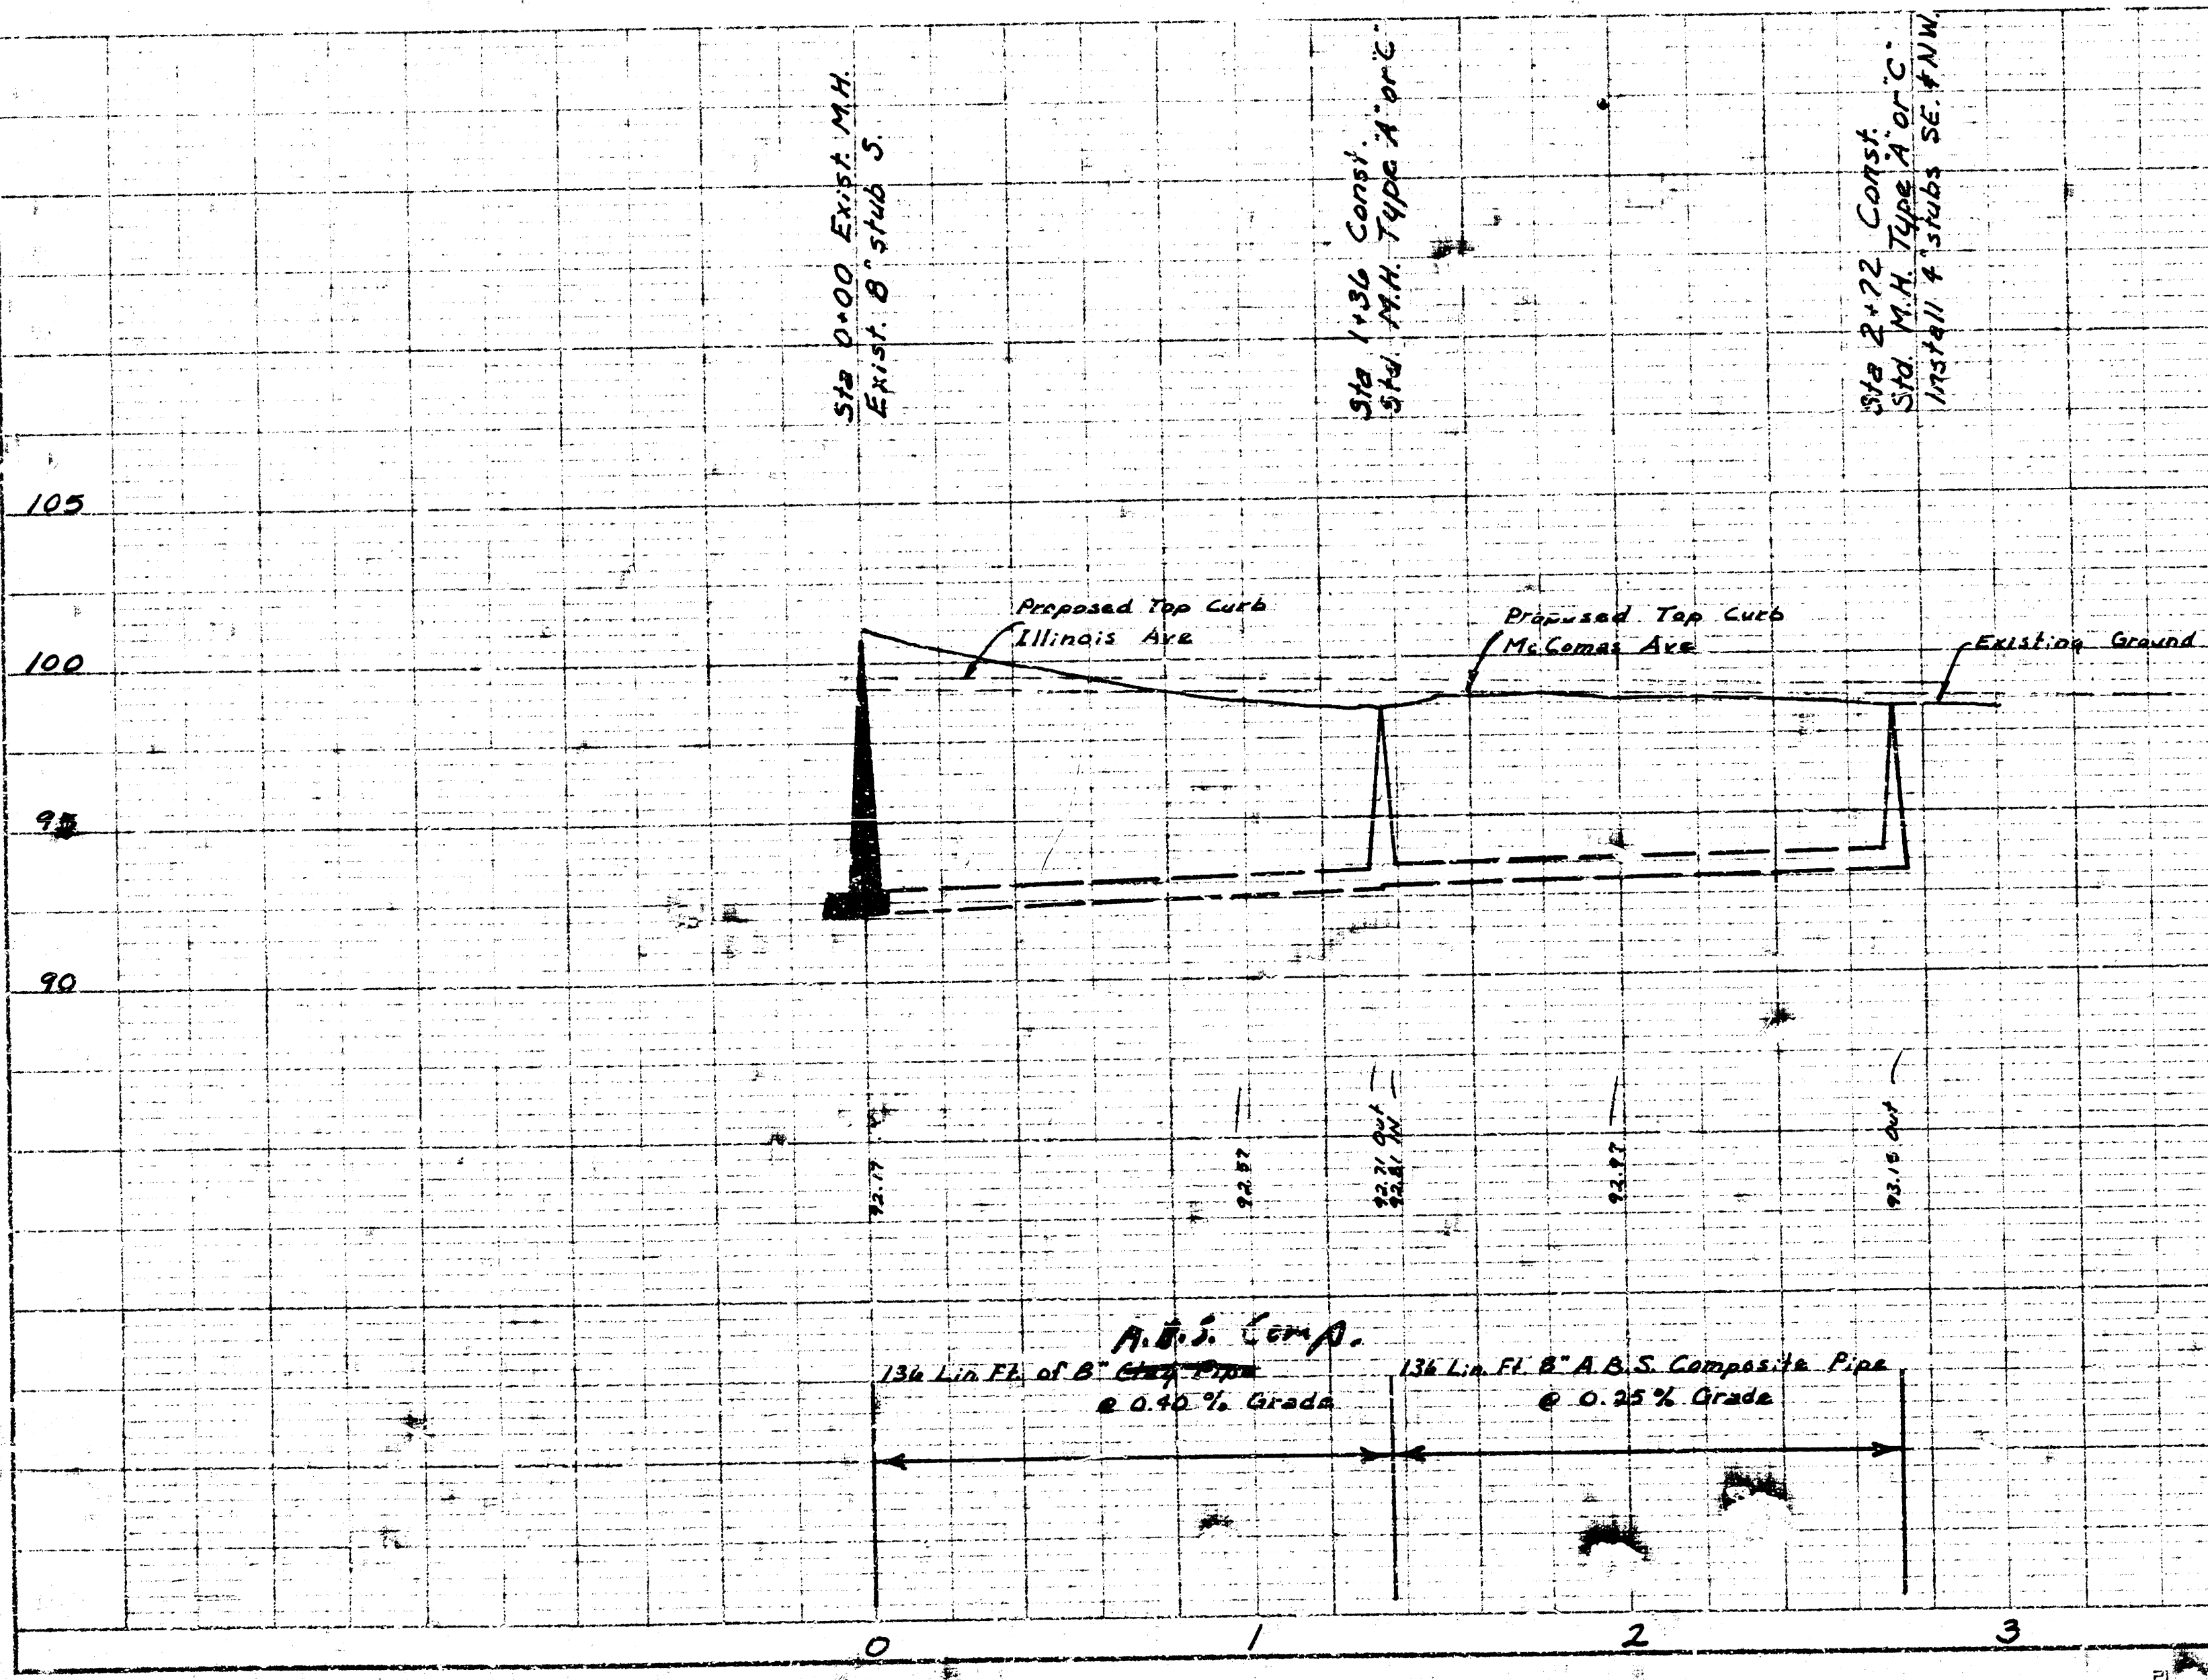

As built 7-5-77

LAT 4, MAIN 23, S.S. 22

CITY OF WICHITA, KANSAS

R. W. LINN — CITY ENGINEER

Feb. 1977

PROJECT NO. DBKL575011

