

LATERAL 37 ——— S.S. NO. 23


**PROJECT NO.
468-76-245-80595-000-000-001**

**CITY OF WICHITA, KANSAS
R.W. LINN CITY ENGINEER
SEPTEMBER, 1978**

SYCAMORE VILLAGE THIRD ADDITION

INDEX TO DRAWINGS

| SHEET NO. | DESCRIPTION |
|-----------|----------------------|
| 1 | TITLE & LOCATION MAP |
| 2 | LINE 1, 1A, 1B |
| 3 | LINE 2, 3, 1C |
| 4 | LINE 3, 4, 4A |
| 5 | LINE 4, 4B, 4C |

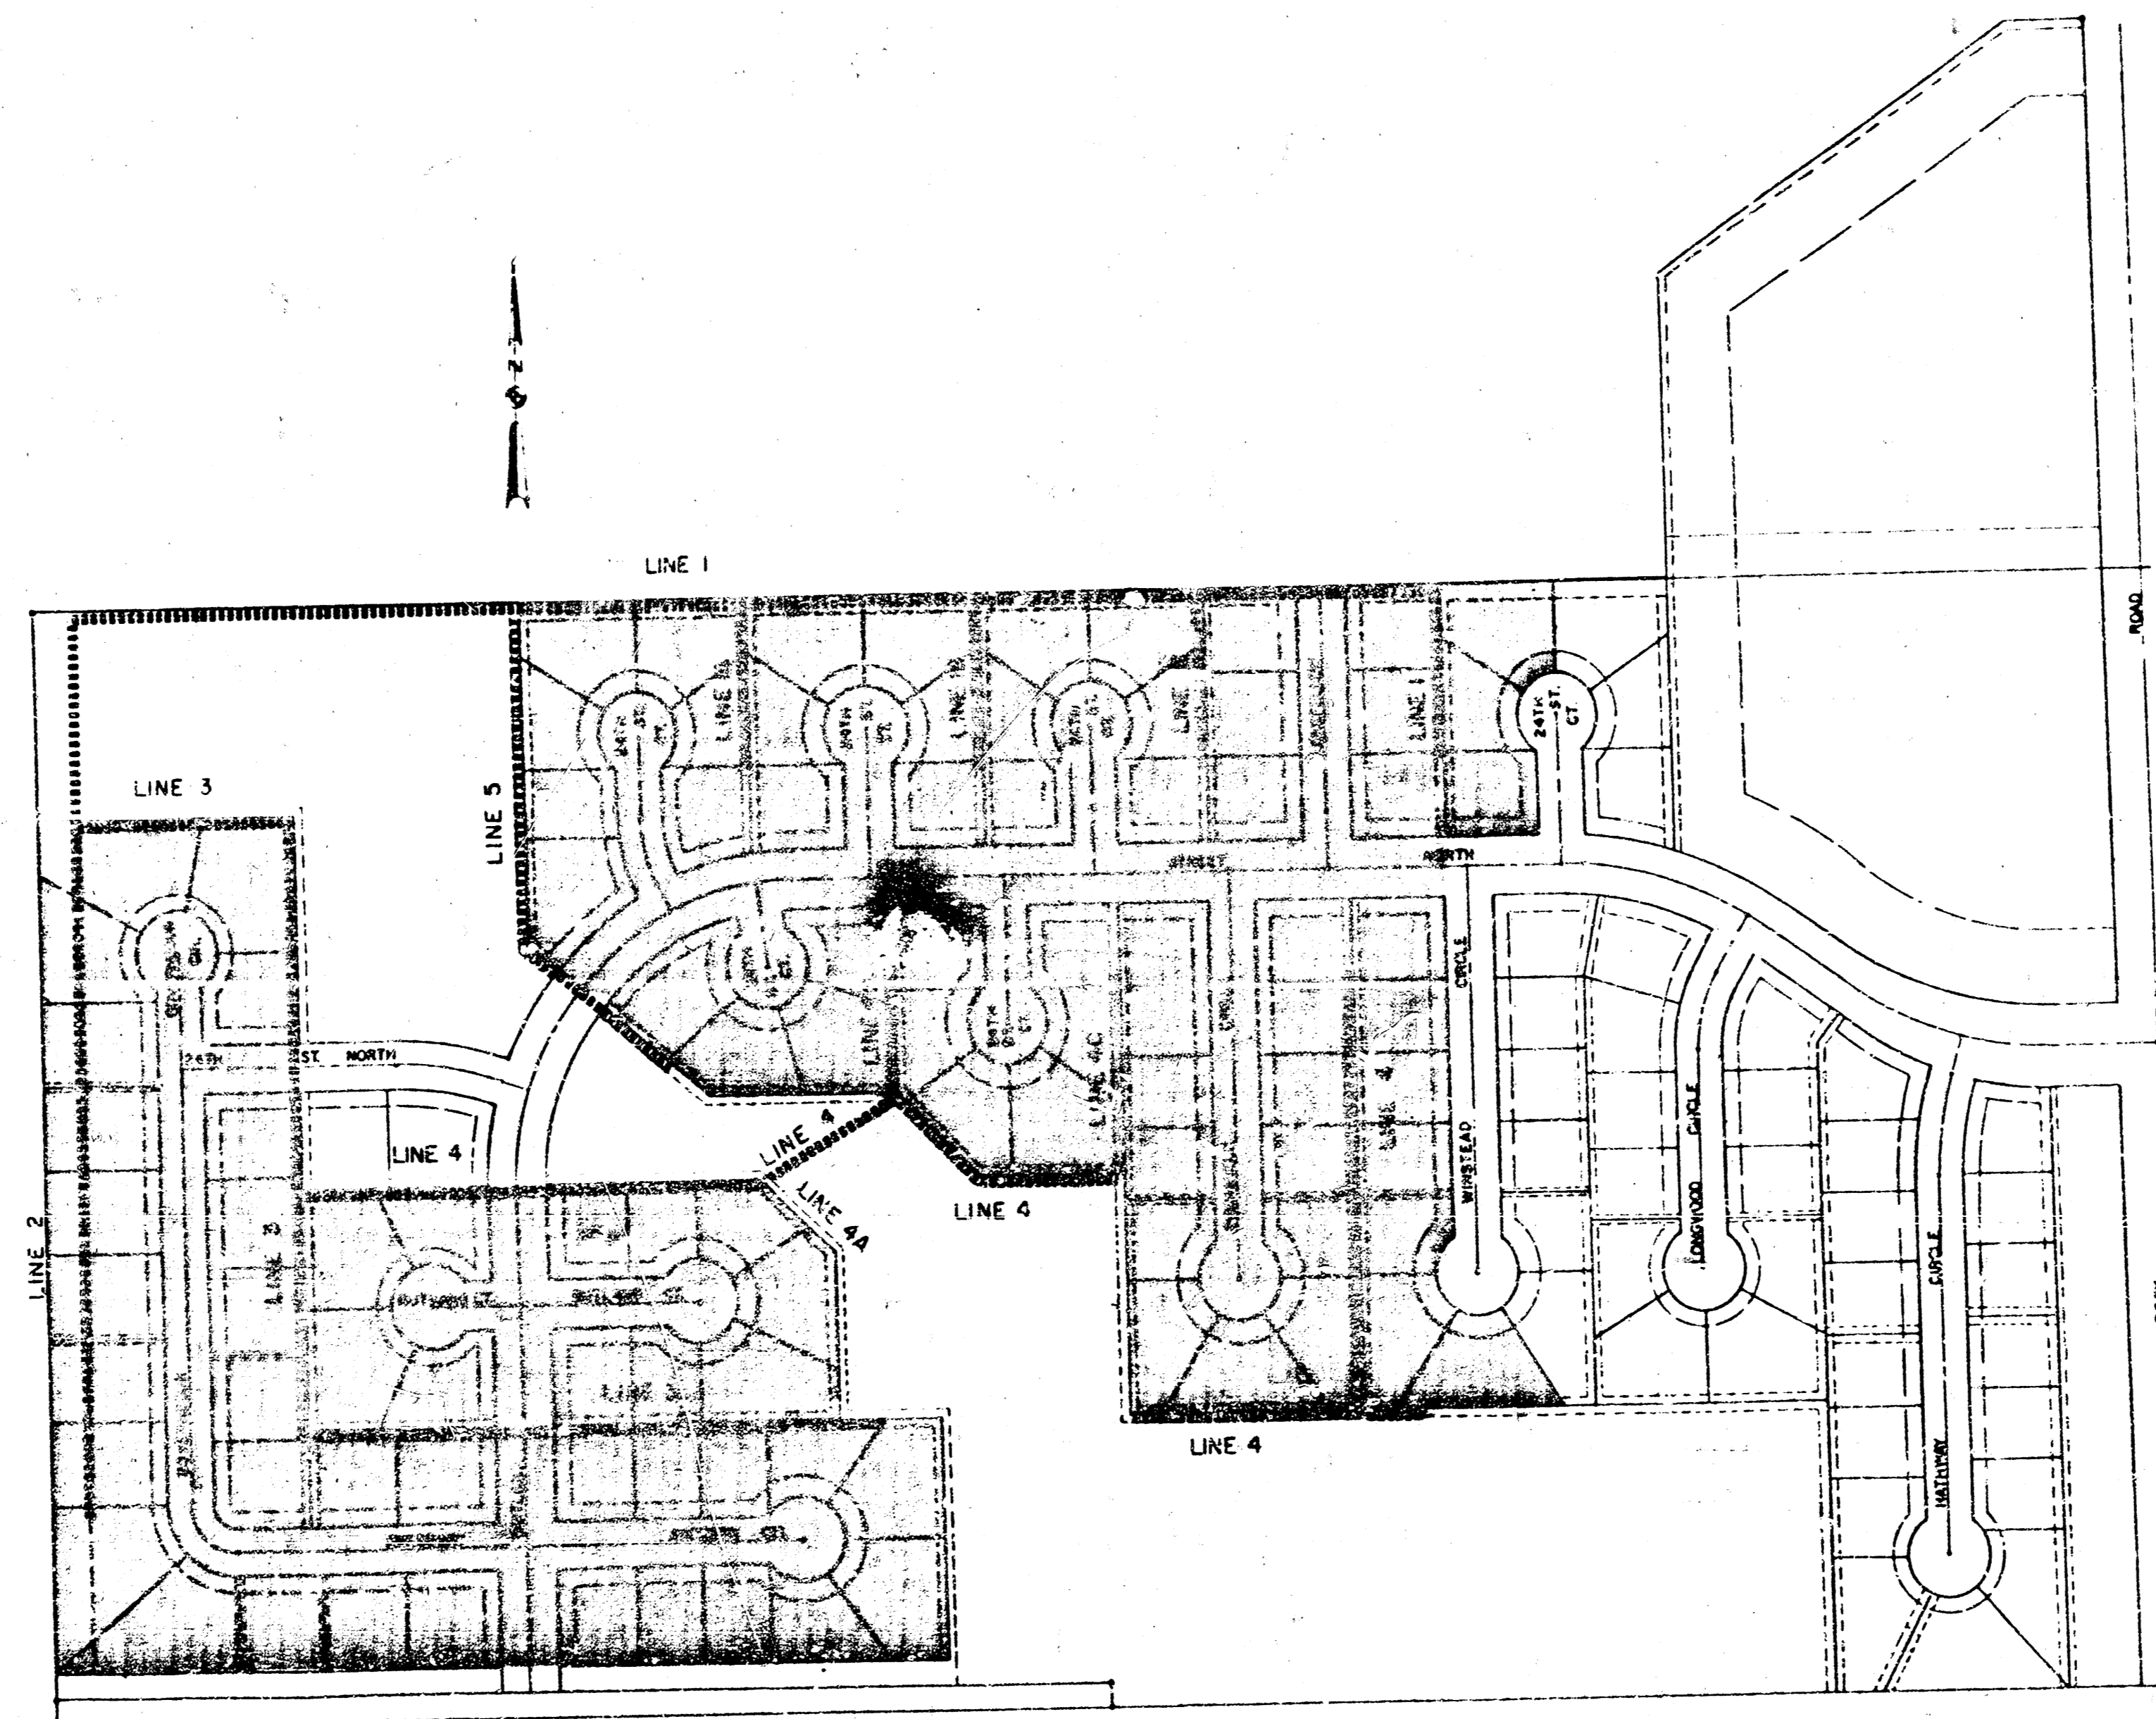

NOTE: WORK ORDER ON THIS PROJECT WILL NOT BE ISSUED UNTIL CONSTRUCTION OF PRIVATE PROJECT NO. 468-76-245-80595-000-000-001 HAS BEEN AUTHORIZED BY THE DEVELOPER.

Kenzie H. P...

*As Built
8/1/79 EJB*

BENEFIT DISTRICT - ALL LOTS IN BLOCKS 1, 2, & 3; LOTS 1 THROUGH 6, BLOCK 4; AND LOTS 1 THROUGH 47, BLOCK 5, ALL IN SYCAMORE VILLAGE THIRD ADDITION.

| | | |
|--|-------|-------------|
| VAN DOREN - HAZARD - STALLINGS ARCHITECTS - ENGINEERS - PLANNERS WICHITA, KANSAS | SHEET | 1 |
| | OF | 5 |
| | DATE | SEP 24 1978 |

14 2 3 5

