
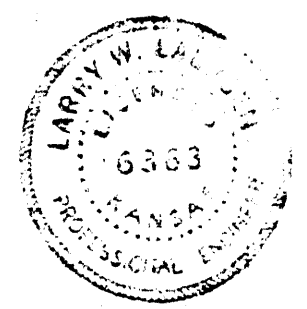


U. H. R. W.

15

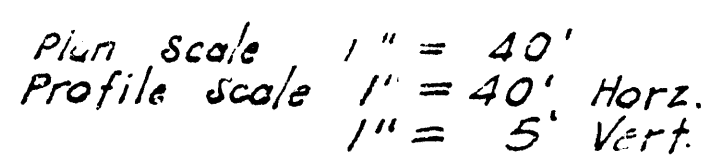

"As Built" Final Meas 11/8/87

LAT. 7, MAIN 1, S. S. NO. 23			
CITY OF WICHITA, KANSAS			
R. W. LINN	—	CITY ENGINEER	
APRIL 1974	PROJECT	NO. DBKL574005	
4	0	3	(15) <i>15</i>