


B.M. 146.93 "M" in Mueller F. H. S.E. cor.
 Pershing & Greenbriar Lane.
 B.M. 158.18 "R" in Ritchie bras const. E-end
 Rad. N.E. cor. 27th & Fountain.
 T.P. 157.21 E. Rim M.H. Sta. 0+00.
 B.M. 159.68 C. of W. B.M. Disc. 39' N. and
 33' E. of & Oliver & 29th St. N.


NOTE: The bid price of Lump Sum
 Clearing of Right-of-way to
 include all costs of removing
 trees, hedge, stumps and any
 other items in the way of
 the construction of the sewer.

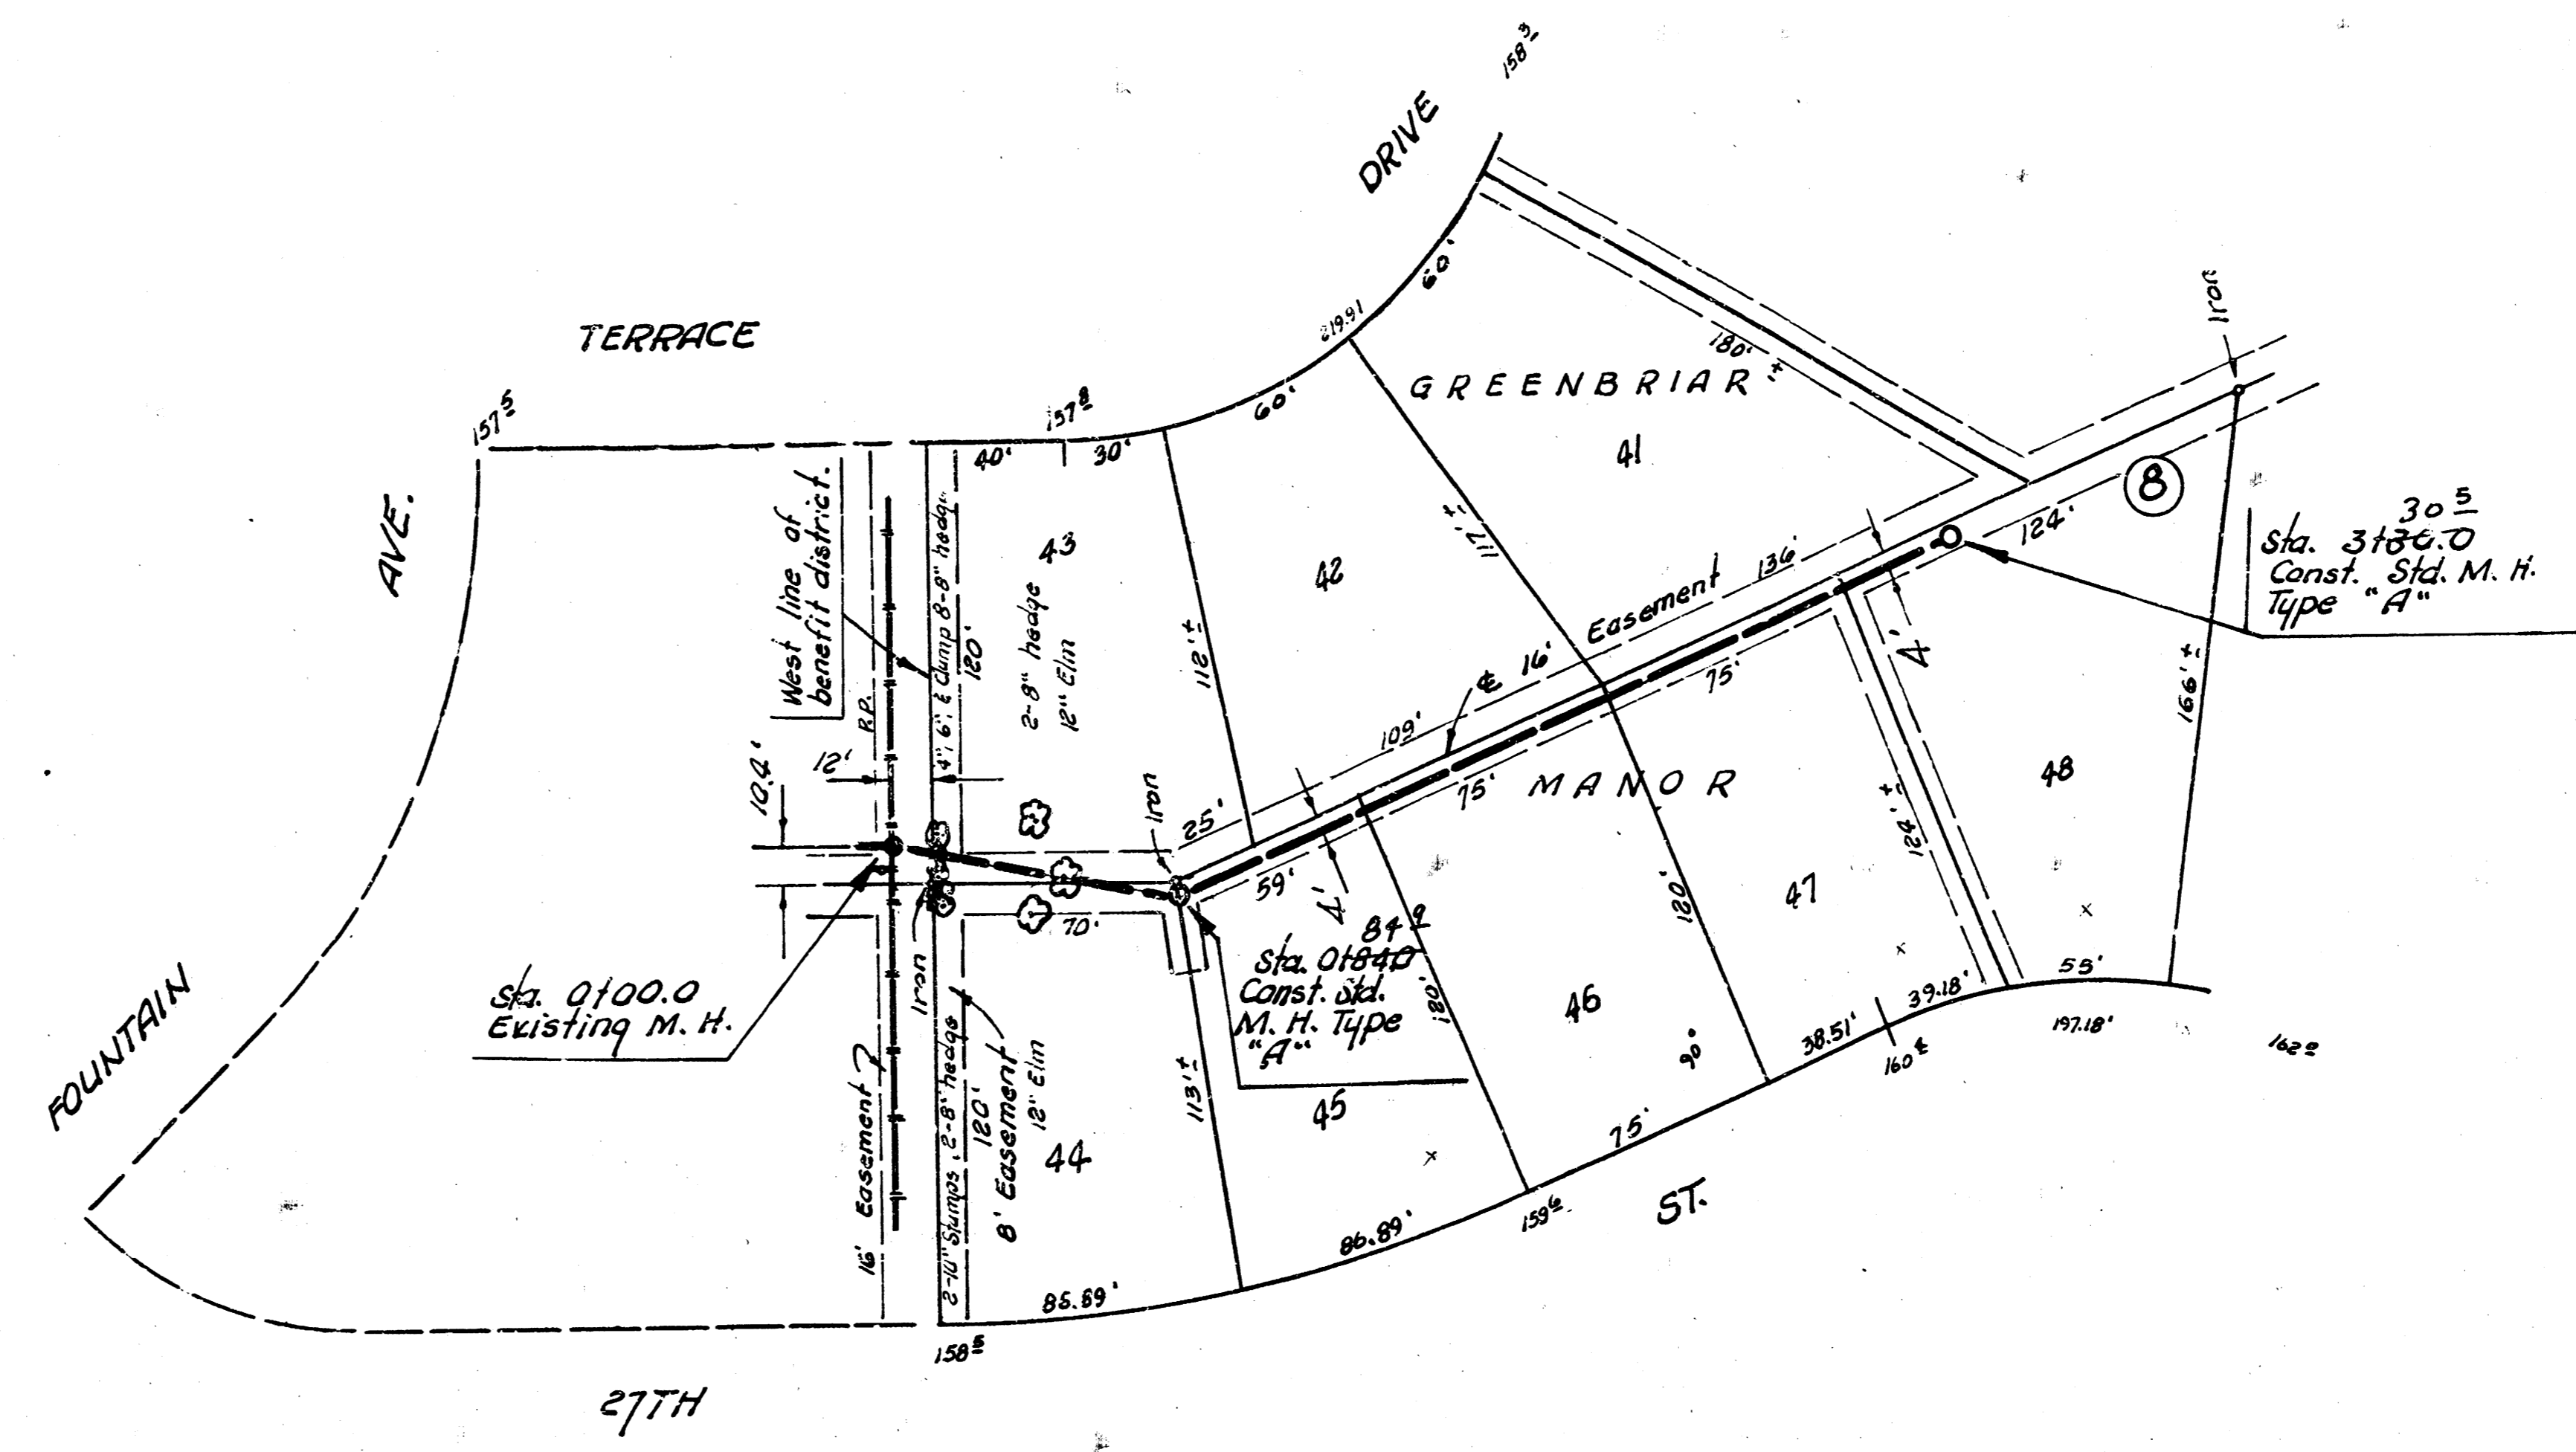

Plan scale 1" = 40'
 Profile scale 1" = 40' Horiz.
 1" = 5' Vert.


u. r. w.

51

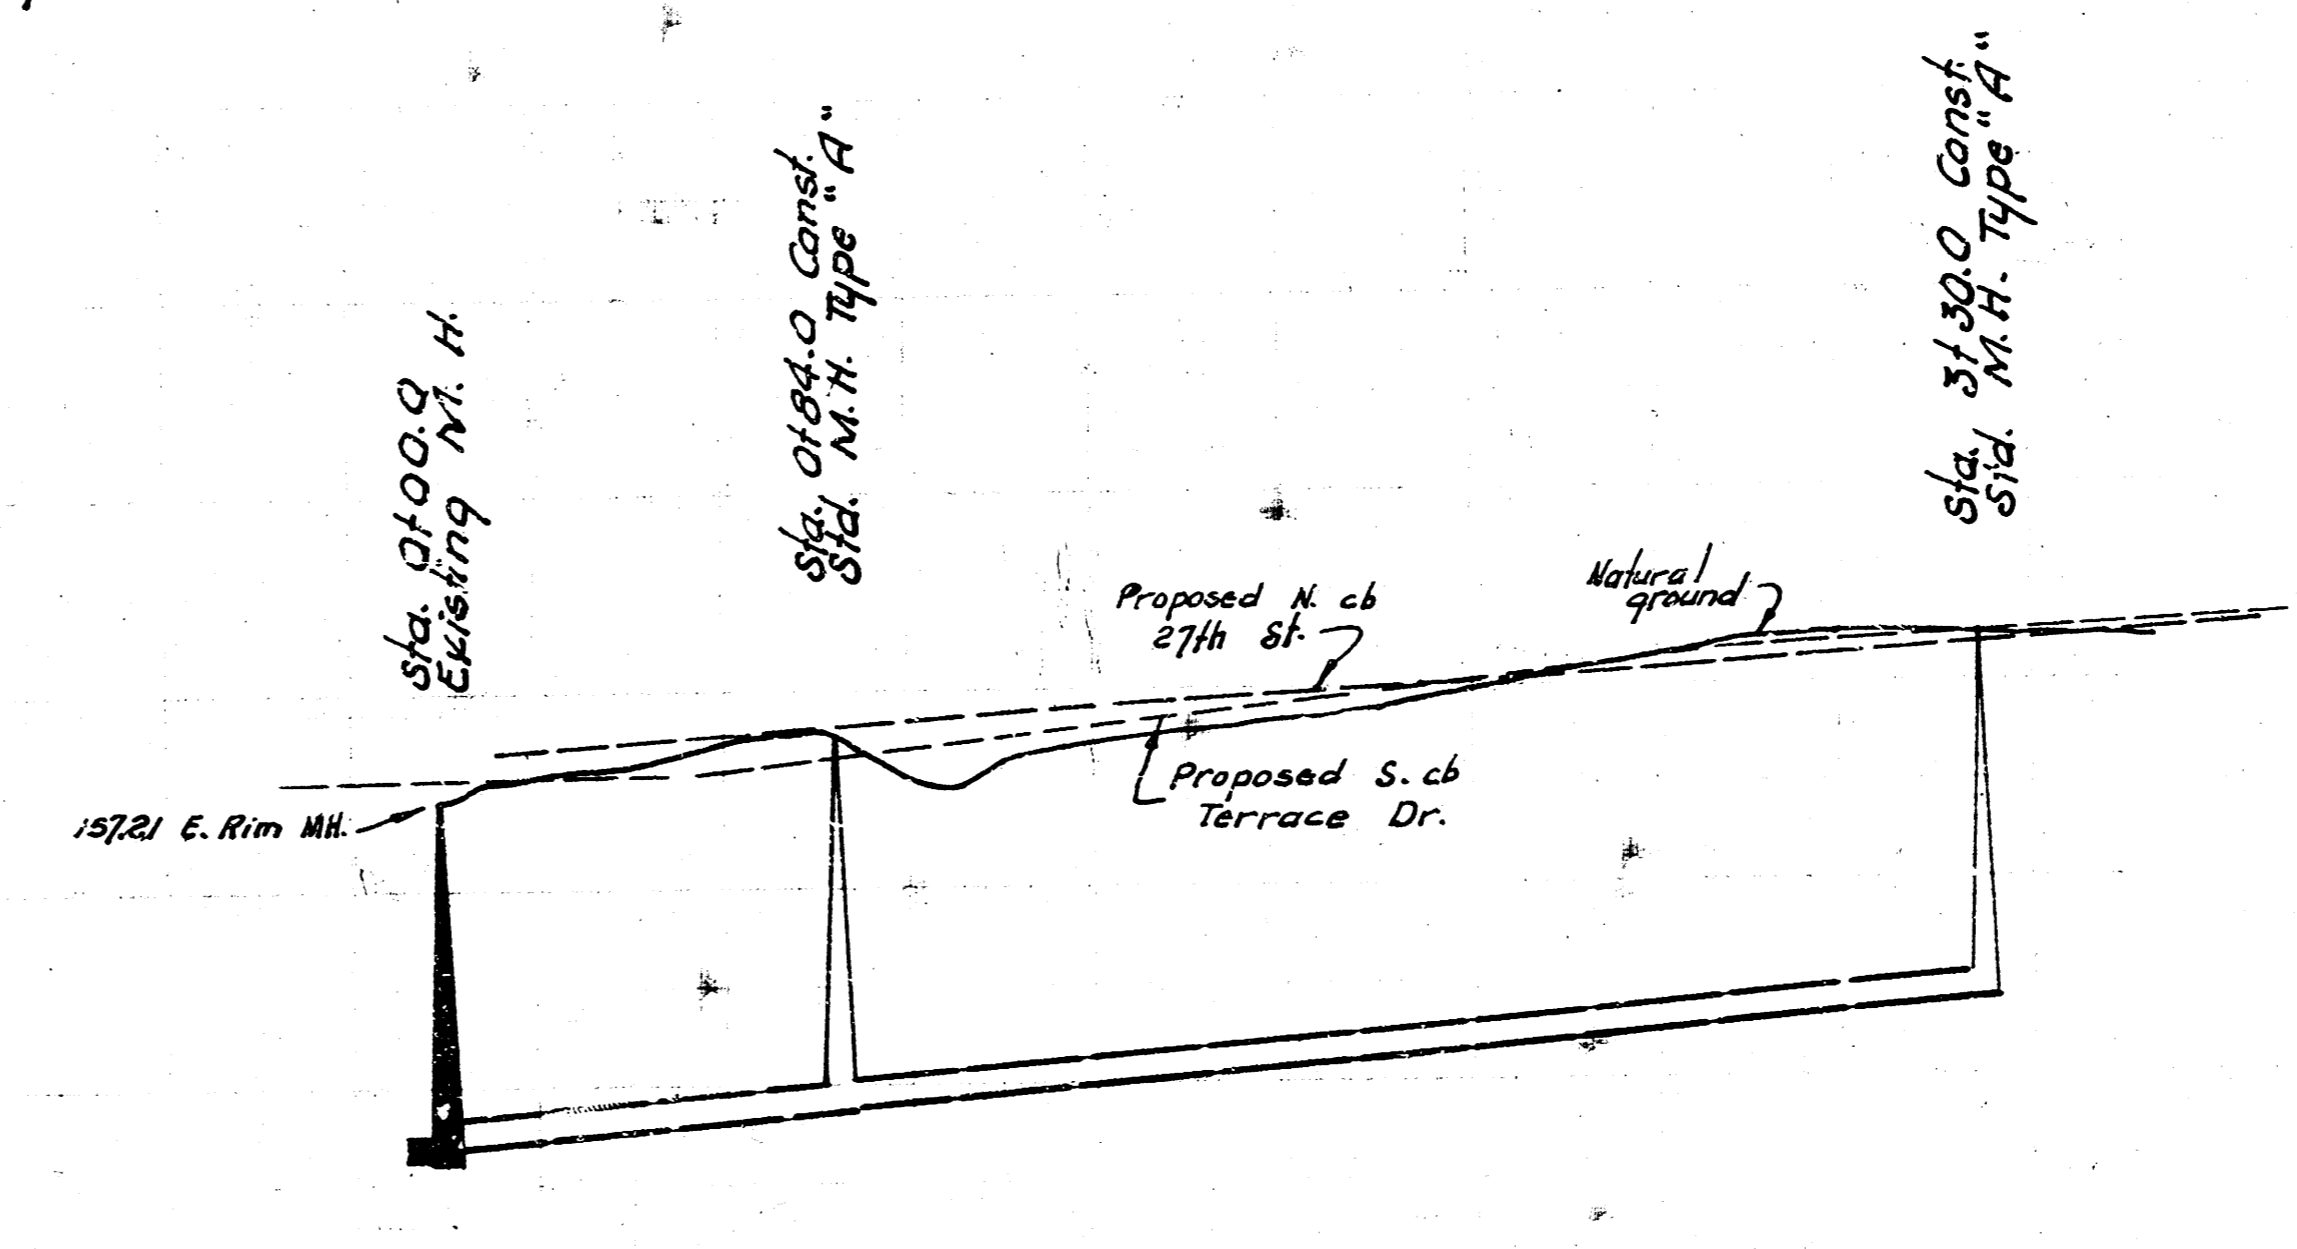

160
 155
 150
 145

160
 155
 150
 145

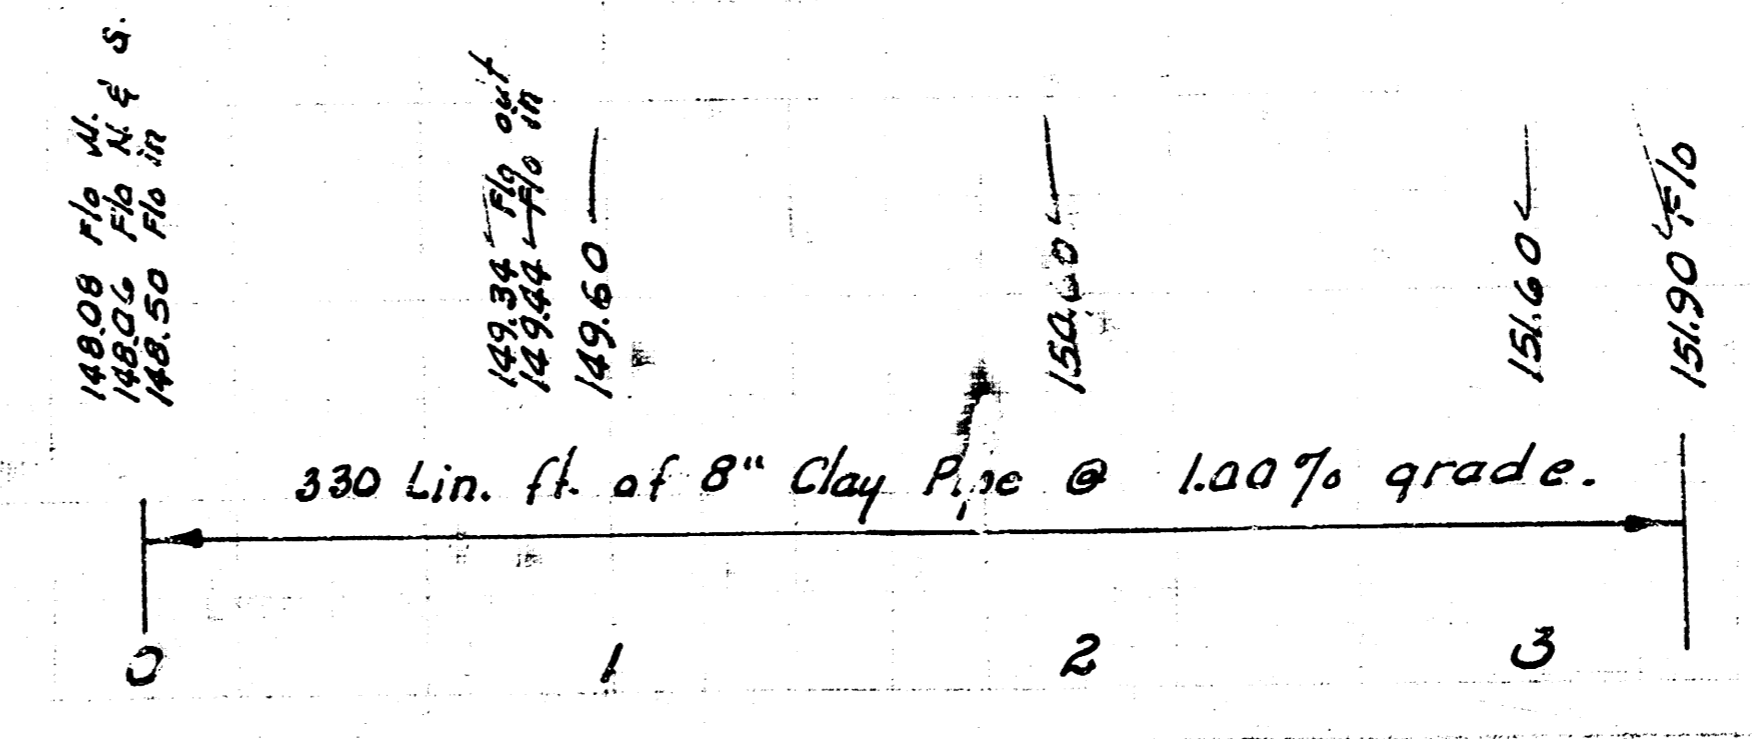

As Built Final Plans 11/84
LAT. 7, MAIN 1, S. S. NO. 23
 CITY OF WICHITA, KANSAS
 R. W. LINN — CITY ENGINEER
 APRIL 1974 PROJECT NO. DBK1574005

FILMED FROM THE BEST
 AVAILABLE COPY