


SURVEYED BY: R. H. 11/27/21
CHECKED BY: C. H. 11/27/21

Grand
Spencer

11/27/21

Grand
Spencer

11/27/21

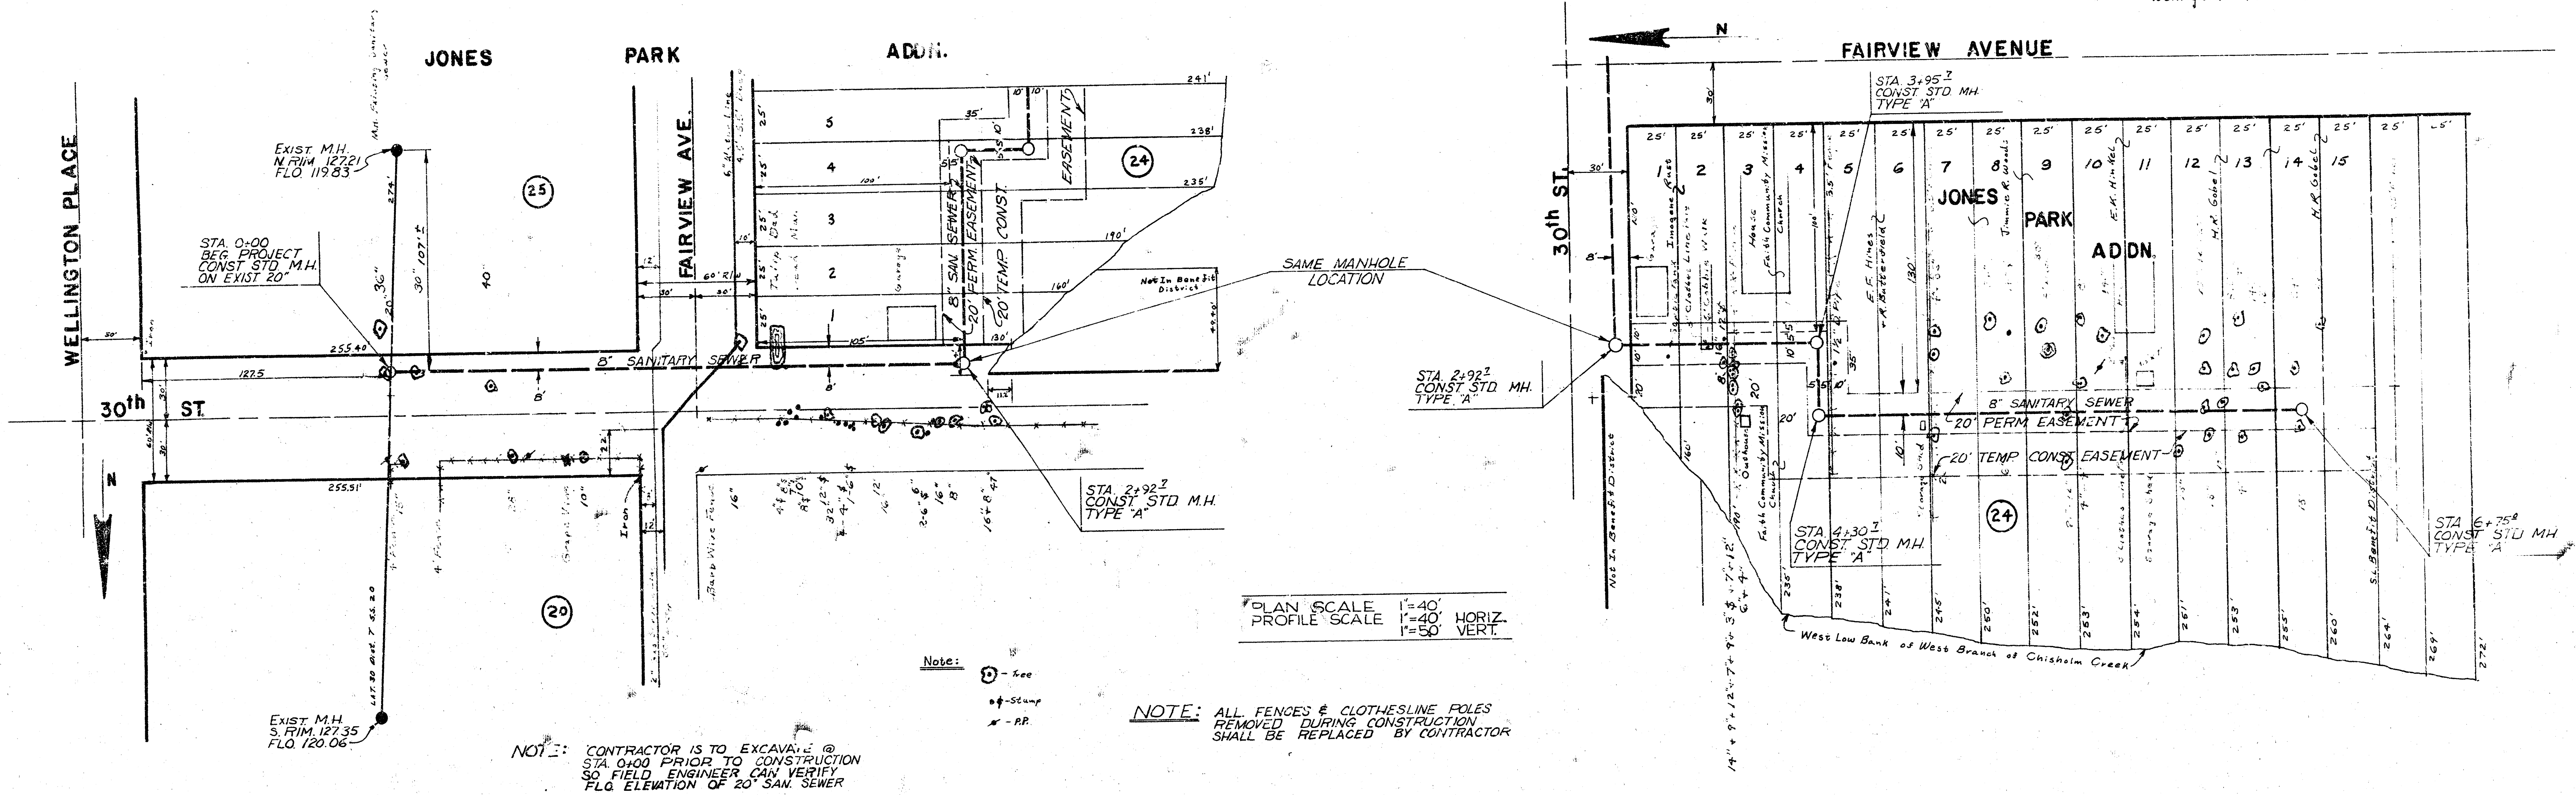


B.M. 124.63 "M" In Muller Fire Hydrant S.W. Corner
Wellington Place & 30th Streets.
B.M. 123.10 "M" In Muller Fire Hydrant S.W. Corner
Wellington Place & 29th Streets.

PLAN SCALE 1"=40'
PROFILE SCALE 1"=40' HORIZ.
1"=50' VERT.

Note:
① - See
+ - Stump
x - PP

NOTE: ALL FENCES & CLOTHESLINE POLES
REMOVED DURING CONSTRUCTION
SHALL BE REPLACED BY CONTRACTOR

NOTE: CONTRACTOR IS TO EXCAVATE @
STA 0+00 PRIOR TO CONSTRUCTION
SO FIELD ENGINEER CAN VERIFY
FLO. ELEVATION OF 20" SAN. SEWER

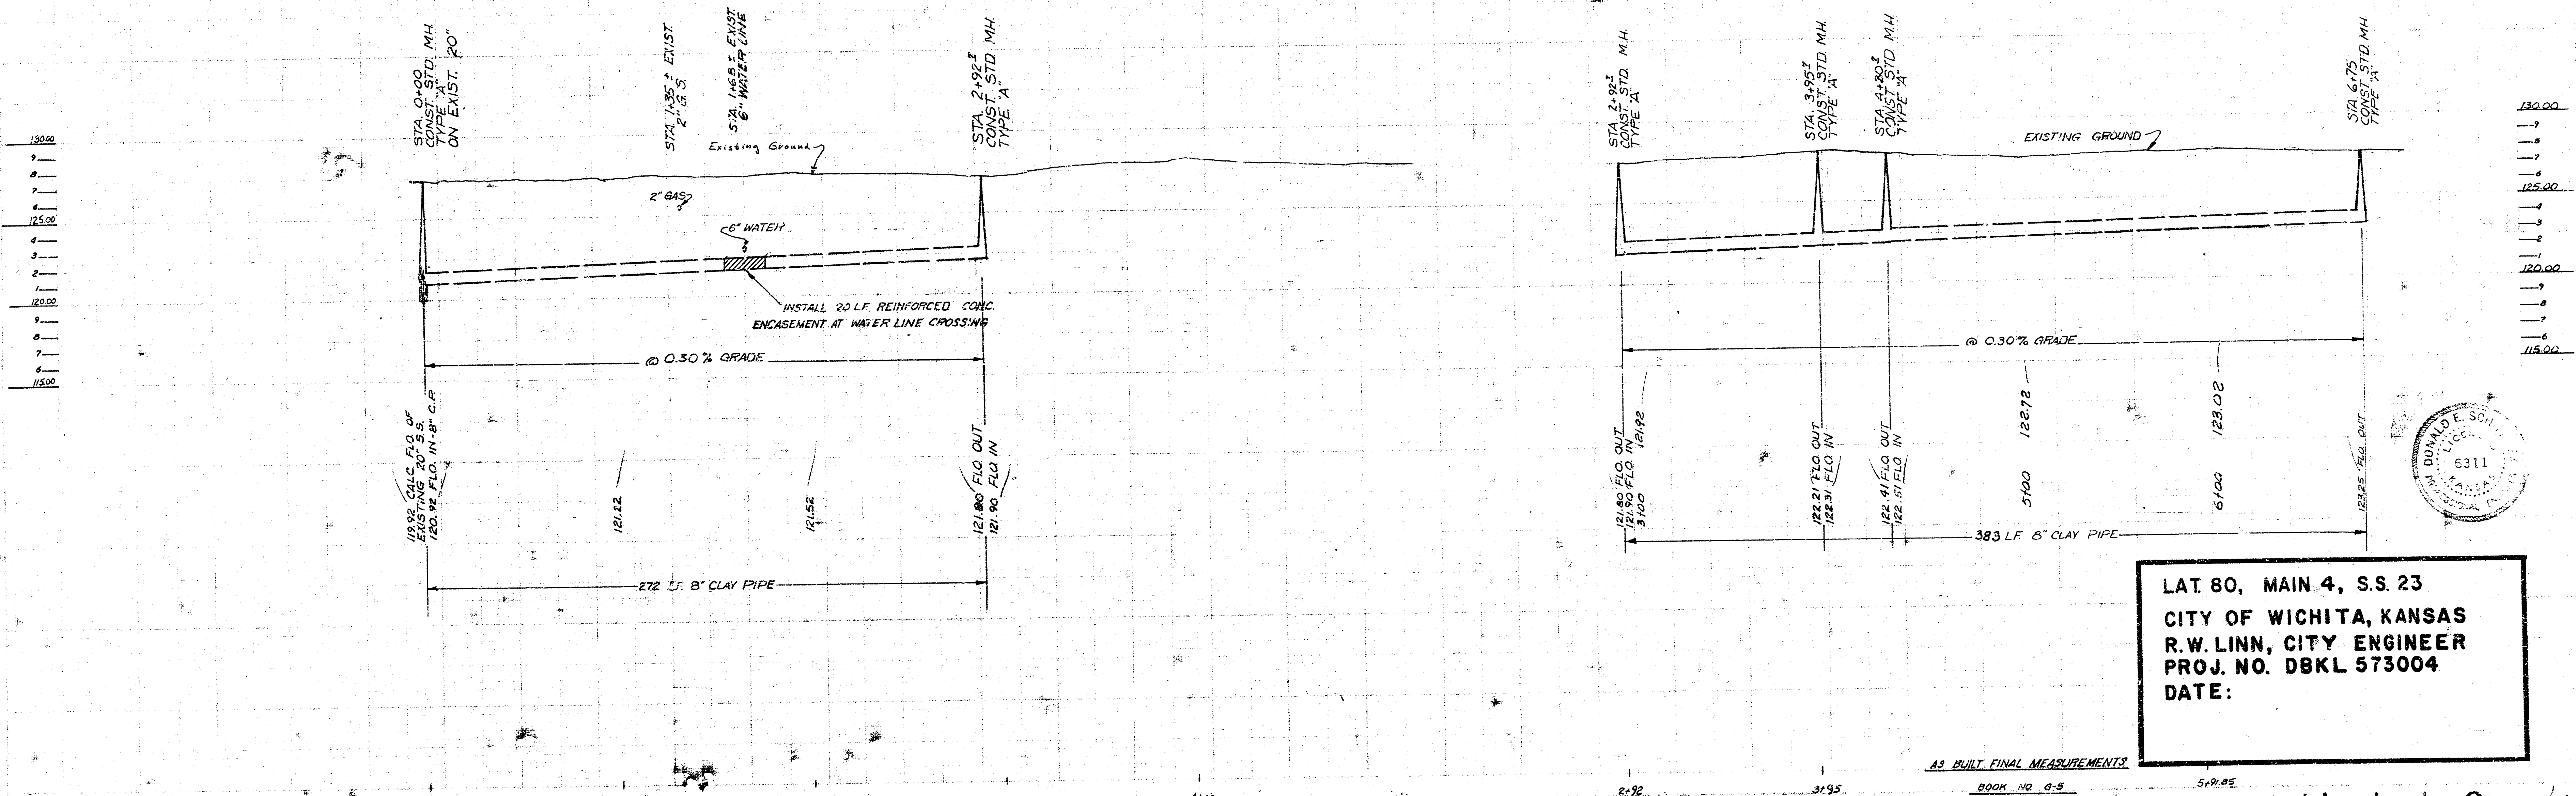

LAT. 80, MAIN 4, S.S. 23
CITY OF WICHITA, KANSAS
R.W. LINN, CITY ENGINEER
PROJ. NO. DBKL 573004
DATE:

AS BUILT FINAL MEASUREMENTS
BOOK NO. 4-5
5/19/05



417 41